
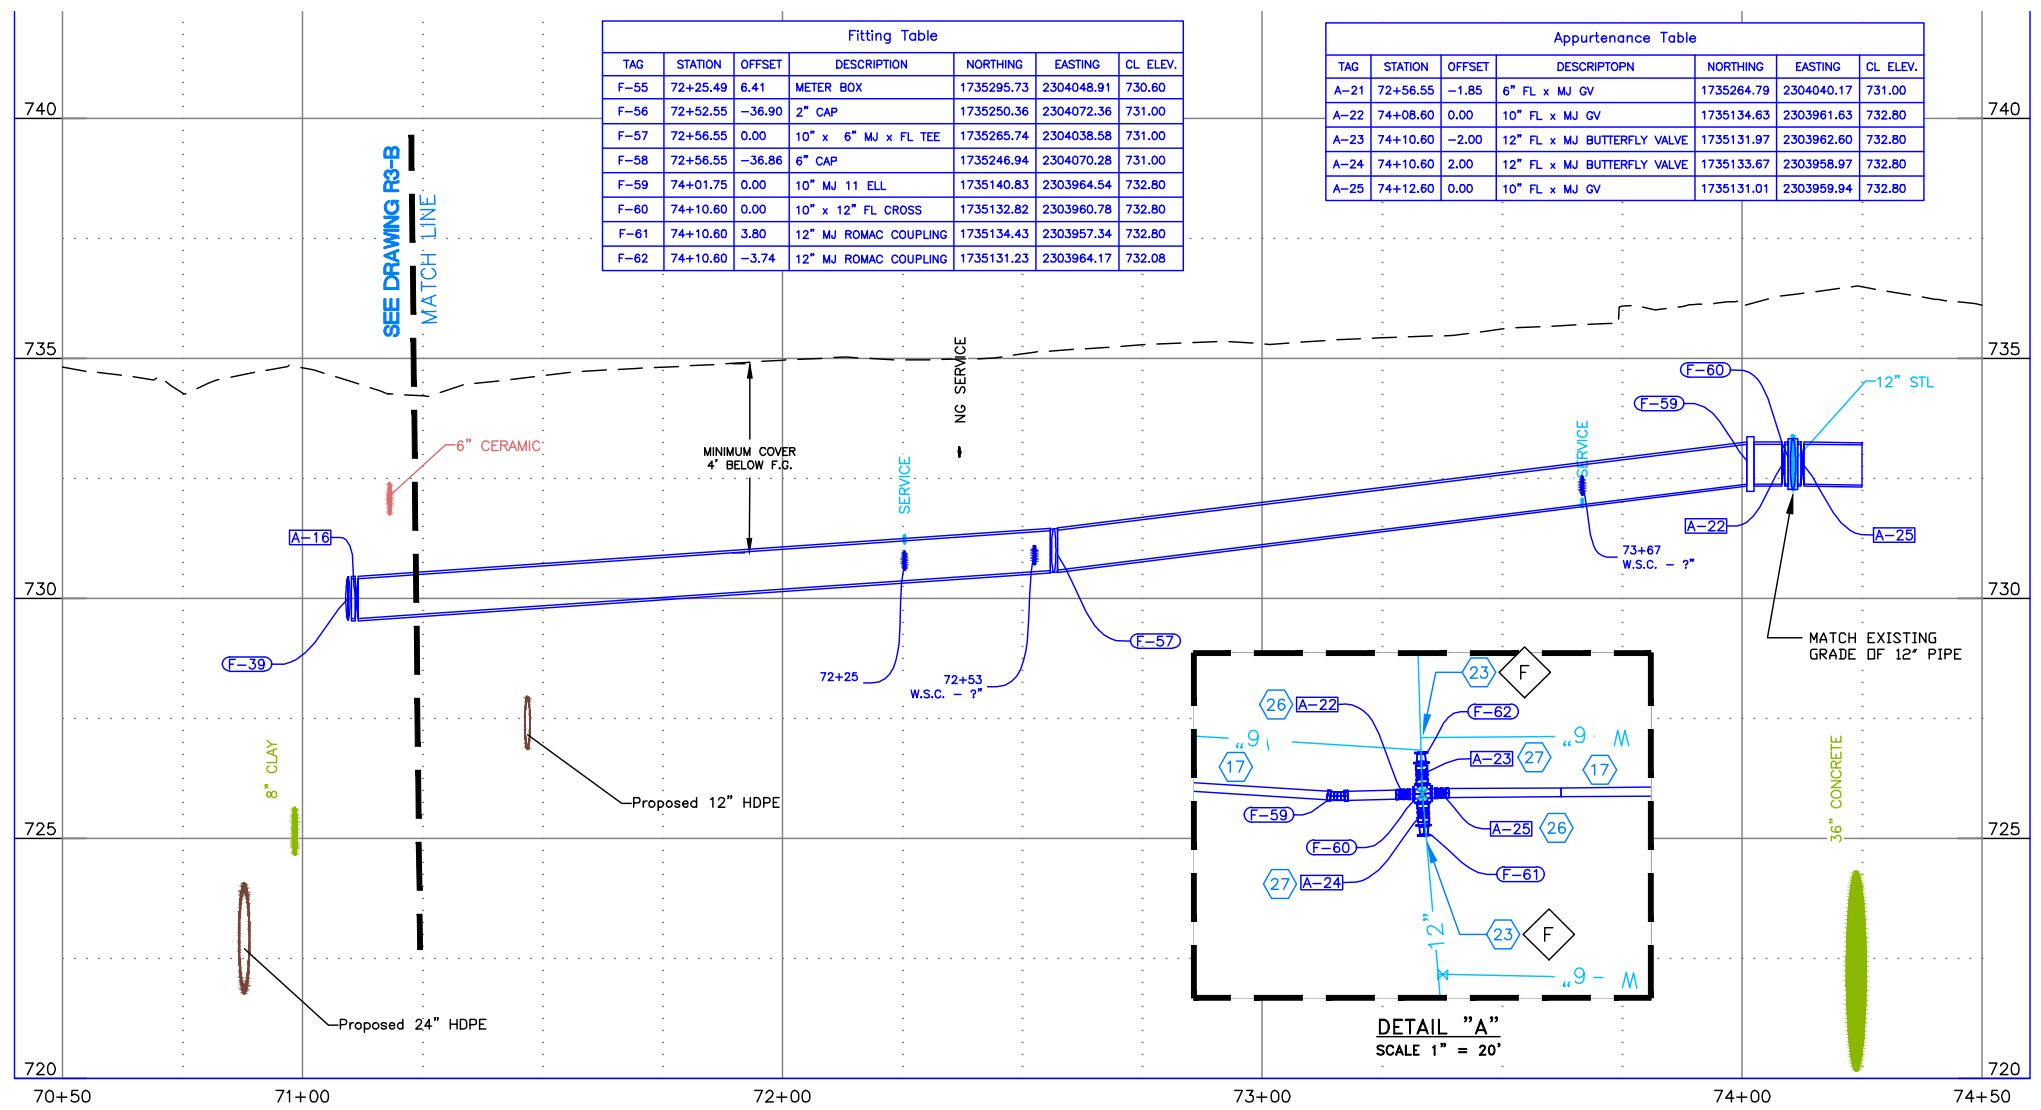


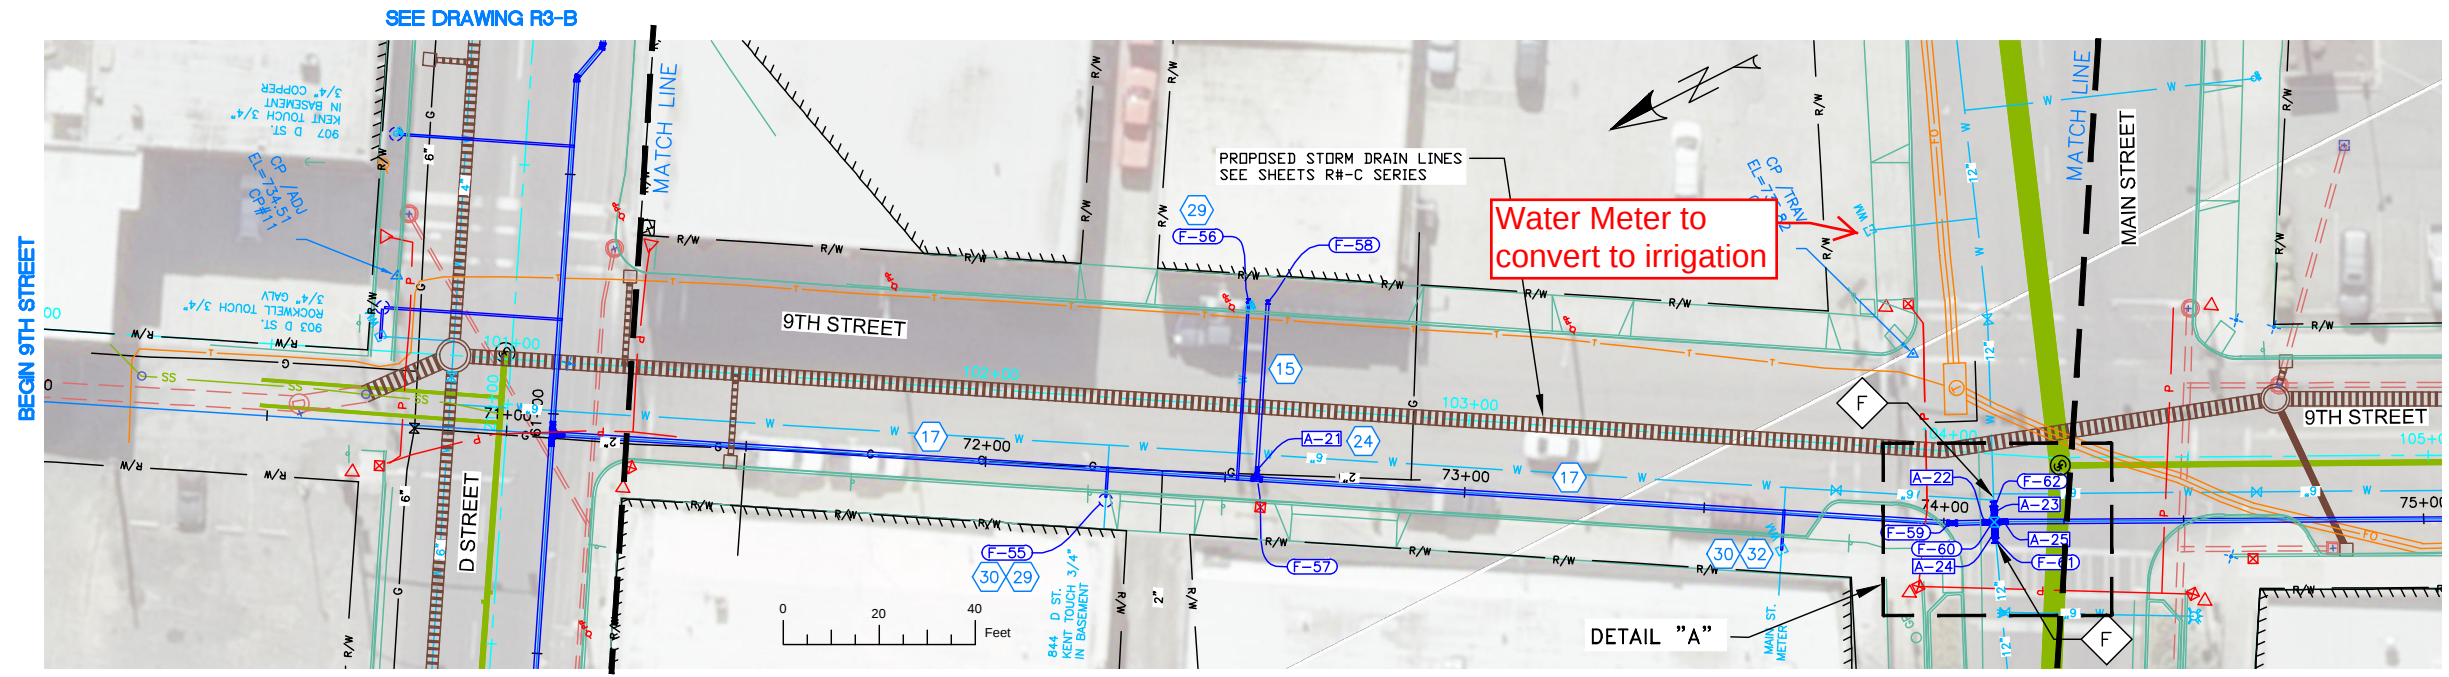

- NOTES**
- REFERENCE APPROPRIATE SHEETS R#-A THRU R#-F FOR WORK TYPE AND BID ITEMS.
 - ALL QUANTITIES ARE PLAN SHEET QUANTITIES BETWEEN MATCHLINES.
 - CURB & GUTTER, SIDEWALK, MANHOLES AND UTILITIES NOT SHOWN TO BE REMOVED OR ABANDONED SHALL BE PRESERVED AND PROTECTED IN PLACE.
- SPECIAL NOTES**
- F Connect to existing main as directed by project engineer.

- PAY ITEMS**
- 15 Water Main Pipe - 6" DI Type , Item 401.4.1.A.1A
 - 17 Water Main Pipe - 10" DI Type , Item 401.4.1.A.1C
 - 18 Water Main Pipe - 12" DI Type , Item 401.4.1.A.1D
 - 19 Water Main Fitting - Size - Type (See Fitting Table this sheet), Item 402.4.1.B.1
 - 23 Connect to Existing Main - 12", Item 401.4.1.C.1D
 - 24 Valve - Size 6", Item 402.4.1.A.1A
 - 26 Valve - Size 10", Item 402.4.1.A.1C
 - 27 Valve - Size 12", Item 402.4.1.A.1D
 - 29 Water Service Connection, Size __", Item 404.4.1.A.1A
 - 30 Temporary Water Service Connection, Size __", Item 404.4.1.A.1B
 - 32 Water Service Connection, No Meter, Item SP 404B

FOR REFERENCE ONLY
NOT OFFICIAL BID DOCUMENTS
10971
CONTACT CITY OF LEWISTON
FOR OFFICIAL BID DOCUMENTS
90% REVIEW