

DEC 1 2015
CITY OF LEWISTON
BUILDING SERVICES


MY ARCHITECT
301 Main Street
Suite 101
Lewiston, Idaho
(208) 743-6902

These documents are intended for informational purposes only. They are not suitable for construction. Design Professionals retain all ownership rights over the documents. The recipient agrees that it will neither use the documents without obtaining Design Professionals' oral or dated, potentially not dated, Design Professionals' identification from and report any claims and losses arising out of the unauthorized use of the documents. Any use of the documents shall constitute acknowledgment and acceptance of this warning.



Site Plan

SCALE: 1" = 40'-0"

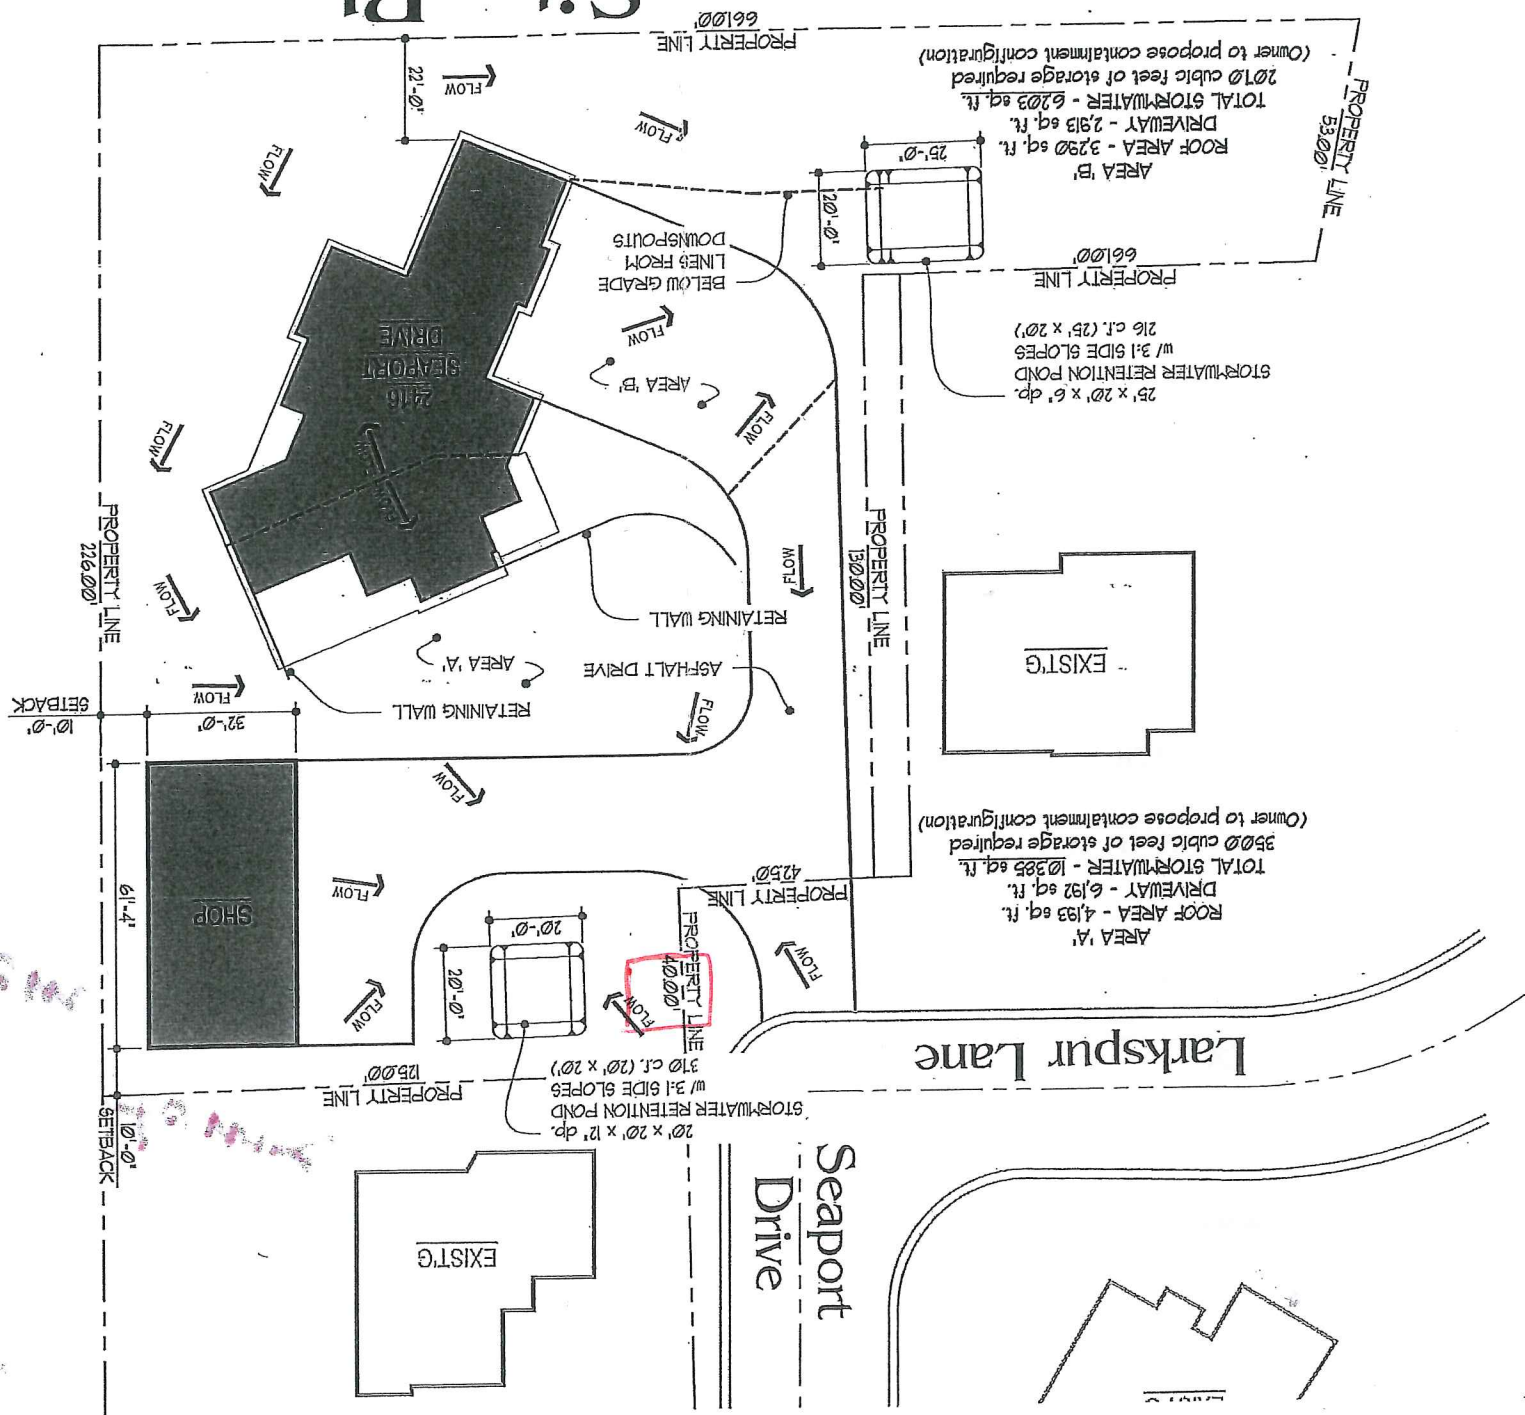

305-4555
Regt