



826 MAIN ST-SKELTON VAULTS  
 NEW 6TH ST VAULT "C"

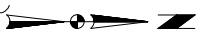

NEW 6TH ST SIDE

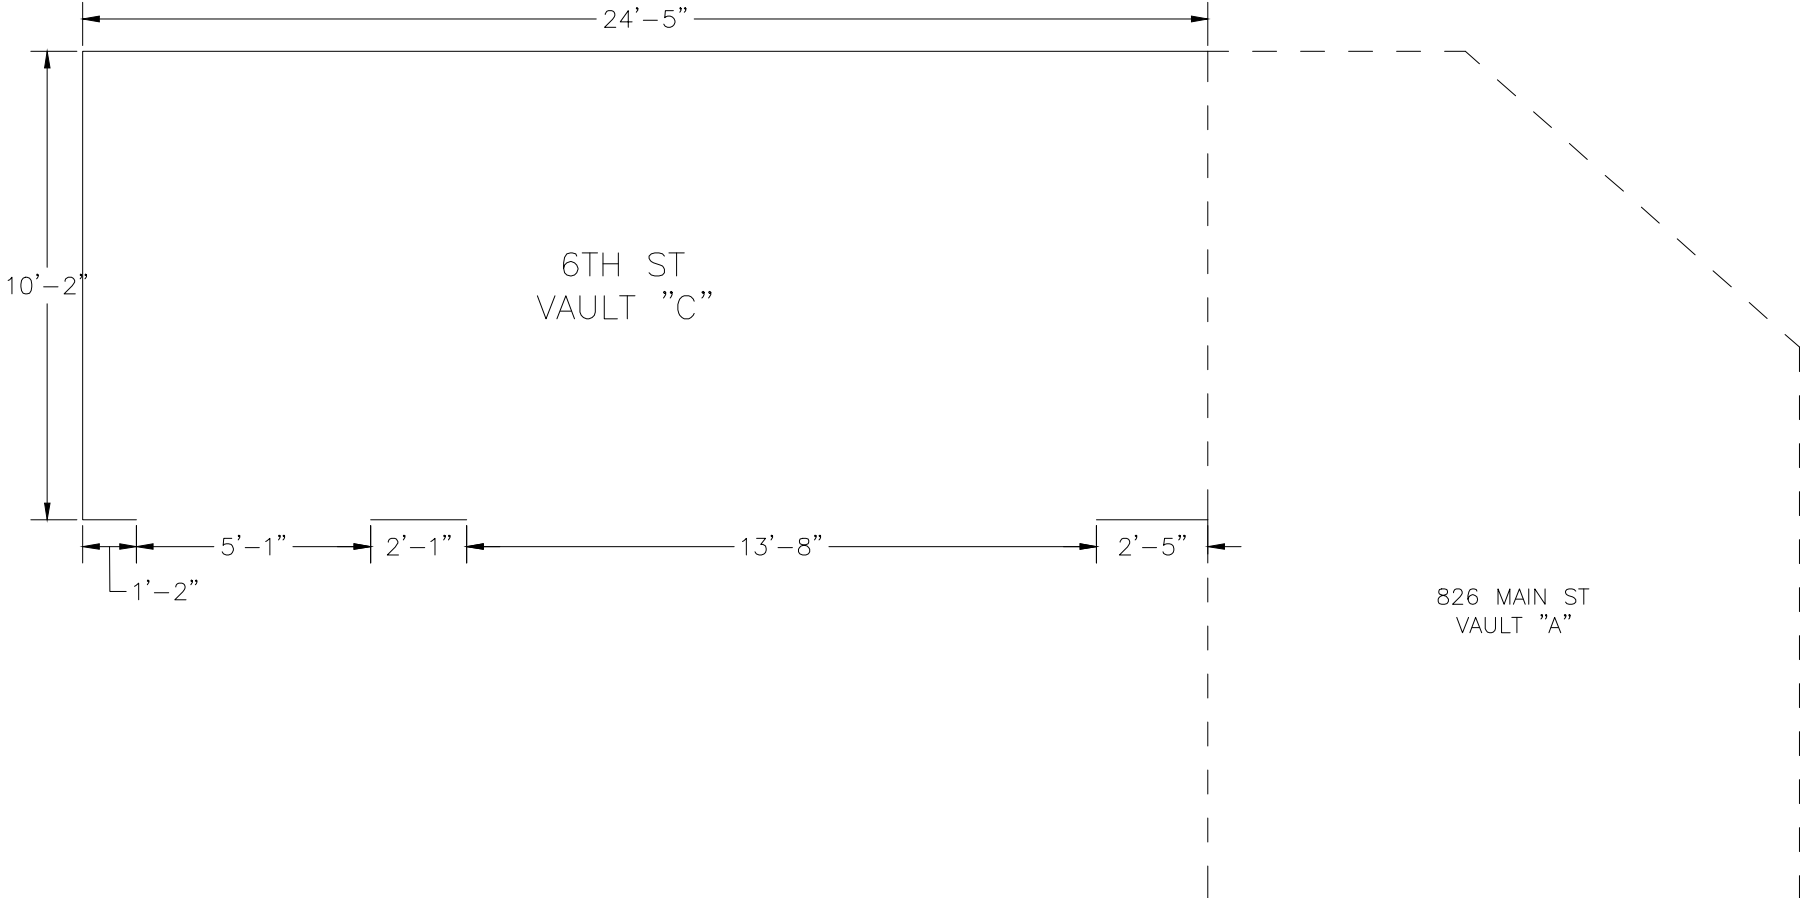

6TH ST  
 VAULT "C"

826 MAIN ST  
 VAULT "A"

\*DIMENSIONS TAKEN ON SITE ARE APPROXIMATE

**LEWISTON DOWNTOWN VAULT INVENTORY**  
 LEWISTON, IDAHO

**VAULT SCHEMATIC**



GREAT FALLS-BOZEMAN-KALISPELL-SHELBY  
 SPOKANE LEWISTON WATFORD CITY  
 MONTANA WASHINGTON IDAHO NORTH DAKOTA

DRAWN BY:	DLR
DESIGNED BY:	
QUALITY CHECK:	JLB
DATE:	08/18/16
JOB NO.	L16-028
CAD NO.	VAULT DRAWING