


NEZ PERCE COUNTY

STATE OF IDAHO


LOCATION MAP

NOT TO SCALE

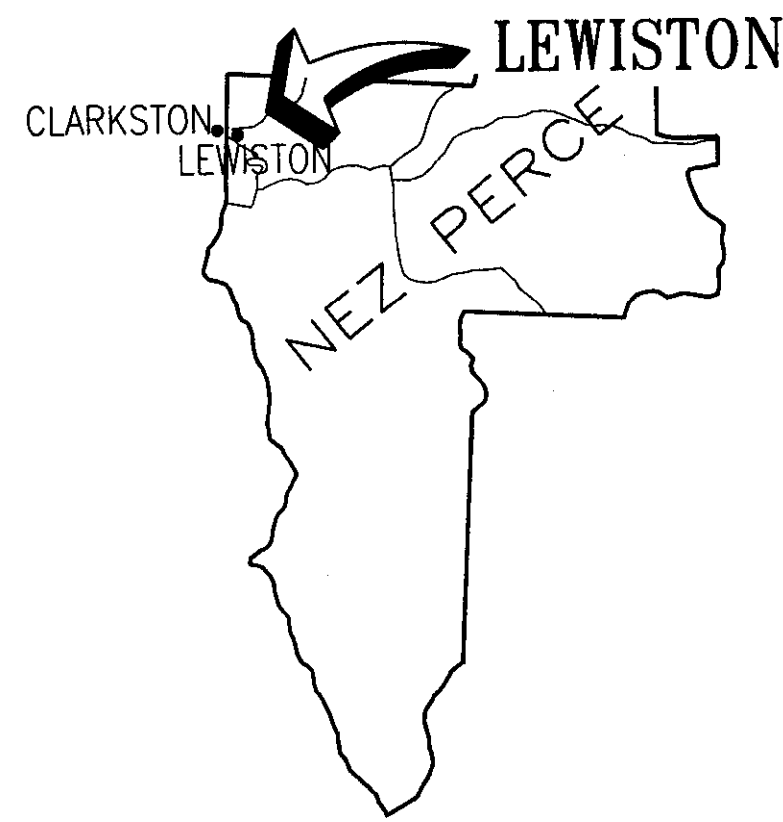

CLARKSTON
LEWISTON


NEZ PERCE

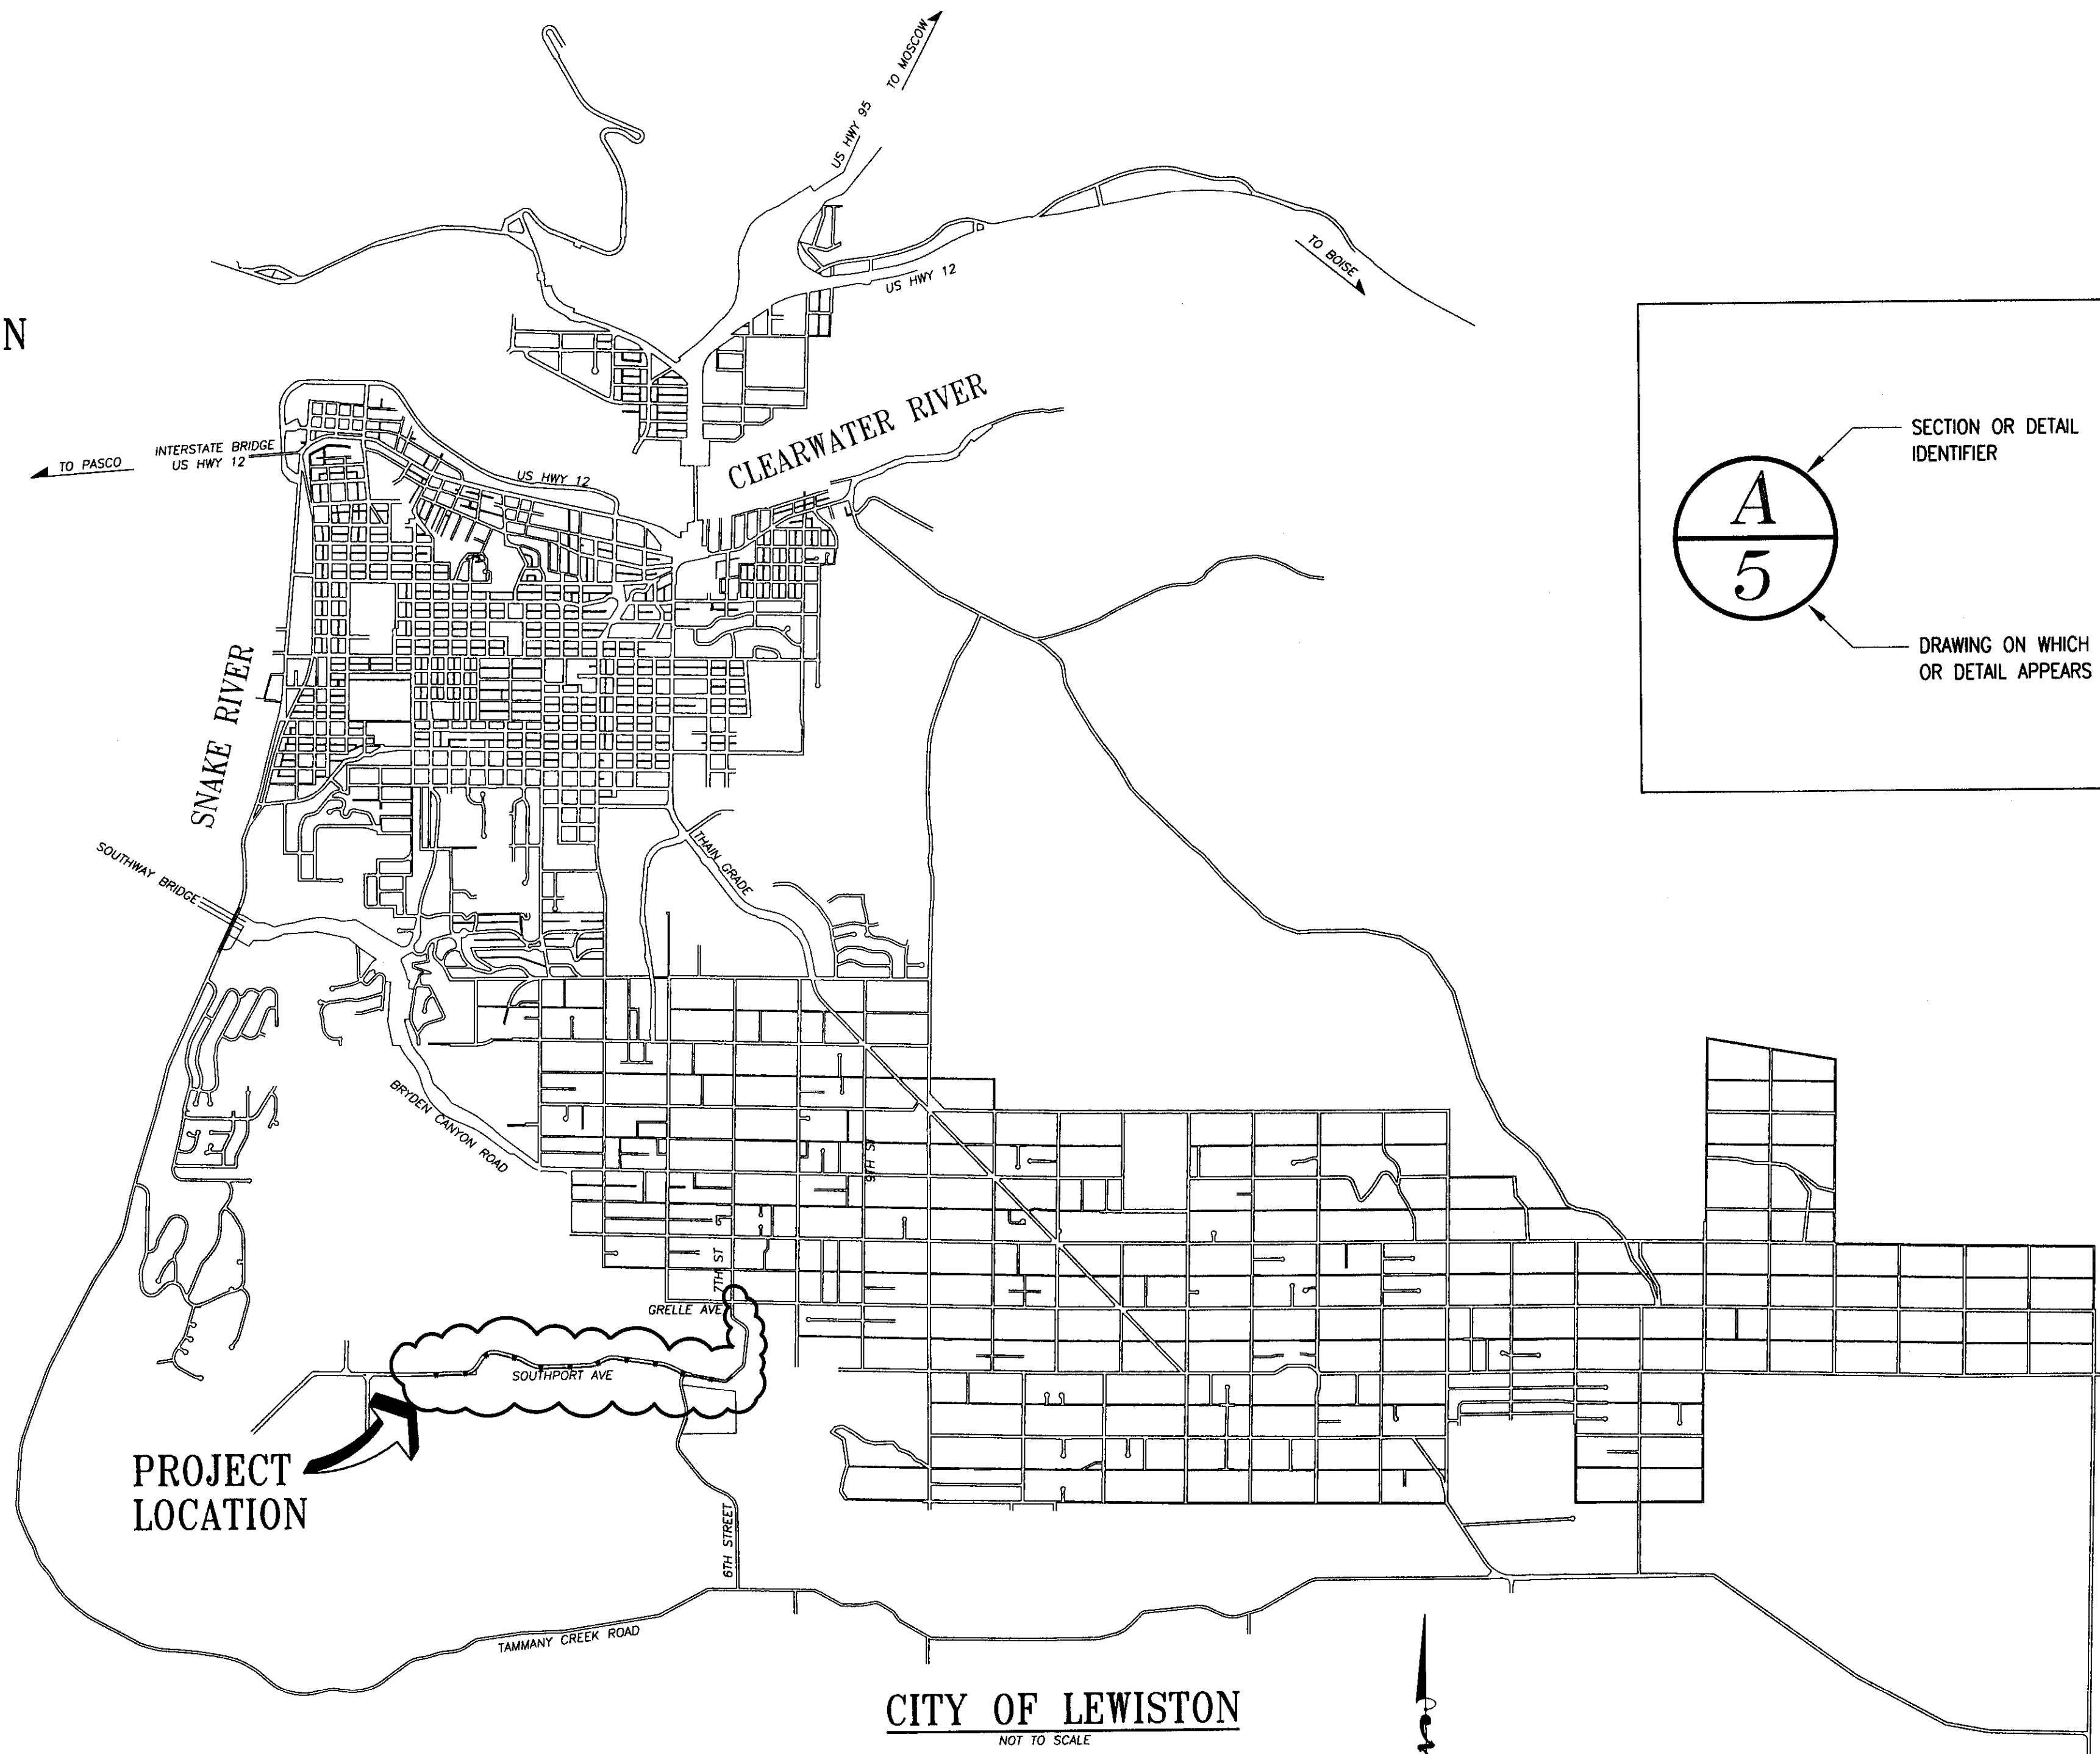

PROJECT LOCATION

CITY OF LEWISTON

NOT TO SCALE

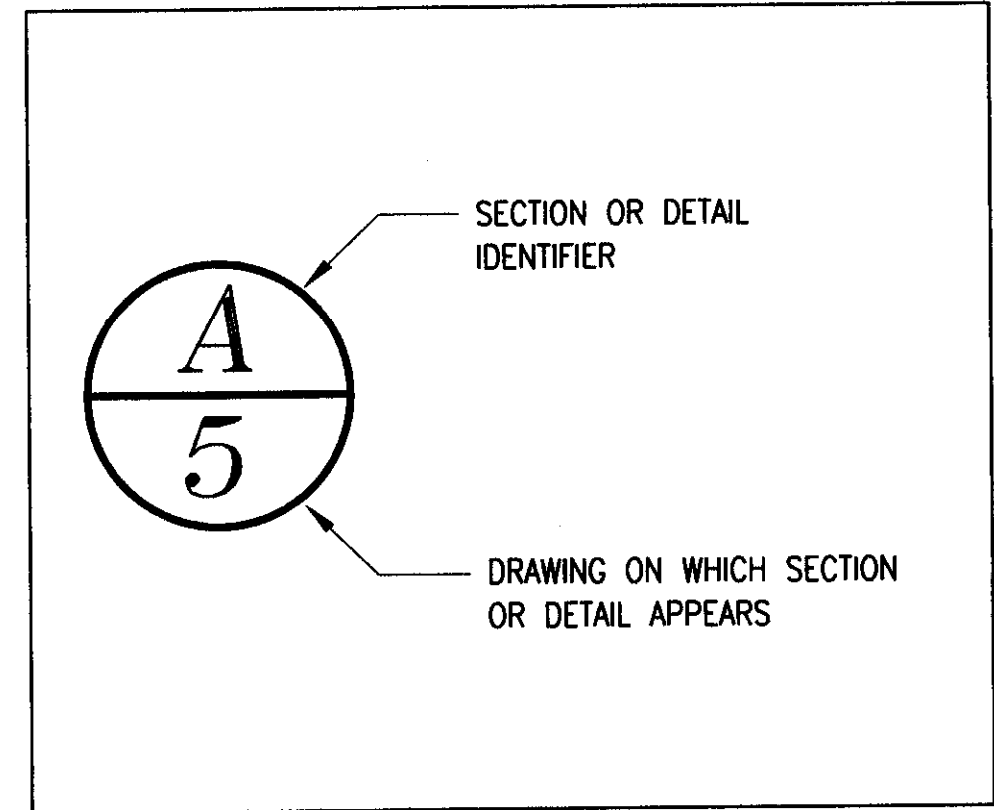

SECTION OR DETAIL IDENTIFIER

DRAWING ON WHICH SECTION OR DETAIL APPEARS

LEGEND

— GAS — GAS —	EXT'G. GAS LINE	○	SANITARY MANHOLE
— E —	EXT'G. UNDERGROUND ELECTRICAL	⊙	WATER MANHOLE
— OHC —	EXT'G. OVERHEAD POWER	▣	CATCH BASIN
— T — T — T —	EXT'G. TELEPHONE	⊗	EXT'G. GATE VALVE
— W — W — W —	EXT'G. WATER MAIN	⊕	PROPOSED GATE VALVE
— SS — SS —	EXT'G. SANITARY SEWER	⊙	WATER METER
— — — — —	EXT'G. EDGE OF ASPHALT	○	TREE
— - - - -	EXT'G. EDGE OF GRAVEL	⊕	EXT'G. FIRE HYDRANT
— - - - -	EXT'G. EASEMENT	⊕	PROPOSED FIRE HYDRANT
— - - - -	EXT'G. RIGHT-OF-WAY	⊕	POWER POLE
— - - - -	EXT'G. CENTER LINE	⊕	POWER POLE W/LIGHT
— x — x — x —	EXT'G. CREEK	⊕	LIGHT POLE
— x — x — x —	EXT'G. WIRE FENCE	⊕	SIGN POST
— o — o — o —	EXT'G. POST FENCE	⊕	TELEPHONE PEDESTAL
— — — — —	PROPOSED WATER MAIN	⊕	MONUMENT
— SS — SS —	PROPOSED SANITARY SEWER	⊕	90° ELBOW W/THRUST BLOCK
— 1800 —	EXT'G. CONTOUR	⊕	45° ELBOW W/THRUST BLOCK
— 1800 —	PROPOSED CONTOUR	⊕	22 1/2° ELBOW W/THRUST BLOCK
— [] —	PROPOSED SAWCUT	⊕	11 1/2° ELBOW W/THRUST BLOCK
— [] —	PROPOSED ASPHALT	⊕	TEE W/THRUST BLOCK
— [] —	PROPOSED CONCRETE	⊕	CONCENTRIC REDUCER
— [] —	PROPOSED ELEVATION		


TABLE OF CONTENTS

SHEET #	DESCRIPTION
A	COVER
1	VICINITY, TABLE OF CONTENTS & LEGEND
2	SHEET LAYOUT
3	WATER MAIN PLAN & PROFILE STA. 0+00 TO STA. 11+05
4	WATER MAIN PLAN & PROFILE STA. 11+05 TO STA. 22+05
5	WATER MAIN PLAN & PROFILE STA. 22+05 TO STA. 31+05
6	WATER MAIN PLAN & PROFILE STA. 31+05 TO STA. 41+05
7	WATER MAIN PLAN & PROFILE STA. 41+05 TO STA. 52+00
8	WATER MAIN PLAN & PROFILE STA. 52+05 TO STA. 58+62
9	WATER MAIN PLAN & PROFILE STA. 0+00 TO STA. 12+04
10	WATER MAIN PLAN & PROFILE STA. 5+89 TO STA. 7+00
11	SEWER MAIN PLAN & PROFILE STA. 19+06 TO STA. 10+89
12	SEWER MAIN PLAN & PROFILE STA. 10+89 TO STA. 0+00
13	AIRPOINTE PLACE GRADING PLAN
14	SOUTHPORT AVE. GRADING PLAN
15	DETAILS
16	DETAILS
17	SIGNAGE & STRIPING PLAN

LOCATION OF UNDERGROUND UTILITIES

THE NUMBER & LOCATIONS OF ALL UNDERGROUND UTILITIES NOTED ON CONTRACT PLANS ARE FOR INFORMATIONAL PURPOSES ONLY. THE CONTRACTORS SHALL MAKE HIS OWN INVESTIGATION TO DETERMINE THE EXACT INFORMATION NECESSARY TO PROTECT ALL UNDERGROUND UTILITIES.

REVISIONS
NO.
DATE
BY

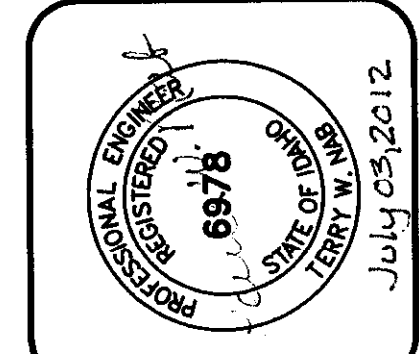

PROGRESSIVE ENGINEERING GROUP, INC.
 DESIGN & CONSTRUCTION MANAGEMENT
 1506 IDAHO STREET, LEWISTON, IDAHO 83501
 PH (208) 748-8408 FAX (208) 748-8732

D 2 J, INC.
 SOUTHPORT WATER MAIN EXTENSION
 AIRPOINTE BUSINESS PARK
 VICINITY, TABLE OF CONTENTS & LEGEND
 LEWISTON, IDAHO 83501

DRAWN BY:	CHECKED BY:
DESIGNED BY:	TWN
DATE:	02/22/11
LAST REV:	
PROJECT NO.:	08-005
SHEET 1	OF 17

RECORD DRAWING 06/21/12