


PLAN VIEW
SCALE: 1" = 40'

CALL
TWO WORKING DAYS
BEFORE YOU DIG
1-800-342-1585
DIG LINE, INC.
3350 AMERICAN TERR., STE. 370
BOISE, IDAHO 83706

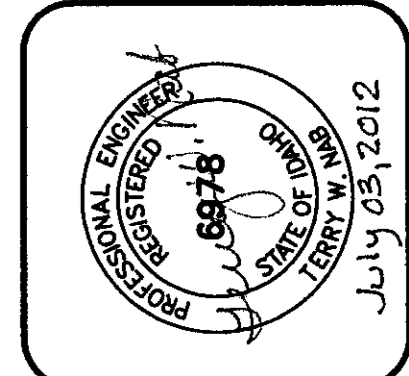


PROGRESSIVE ENGINEERING GROUP, INC.
DESIGN + CONSTRUCTION MANAGEMENT
1208 IDAHO STREET
LEWISTON, IDAHO 83501
PH (208) 746-0406 FAX (208) 746-9782

D 2 J, INC.
SOUTHPORT SEWER MAIN EXTENSION
AIRPOINTE BUSINESS PARK
STA. 19+06 TO STA. 10+89
LEWISTON, IDAHO 83501

DRAWN BY: WRE	CHECKED BY: TWN
DESIGNED BY: TWN	
DATE: 02/24/11	
LAST REV:	
PROJECT NO: 08-005	
SHEET 11 OF 17	

NO.	DATE	BY	REVISIONS

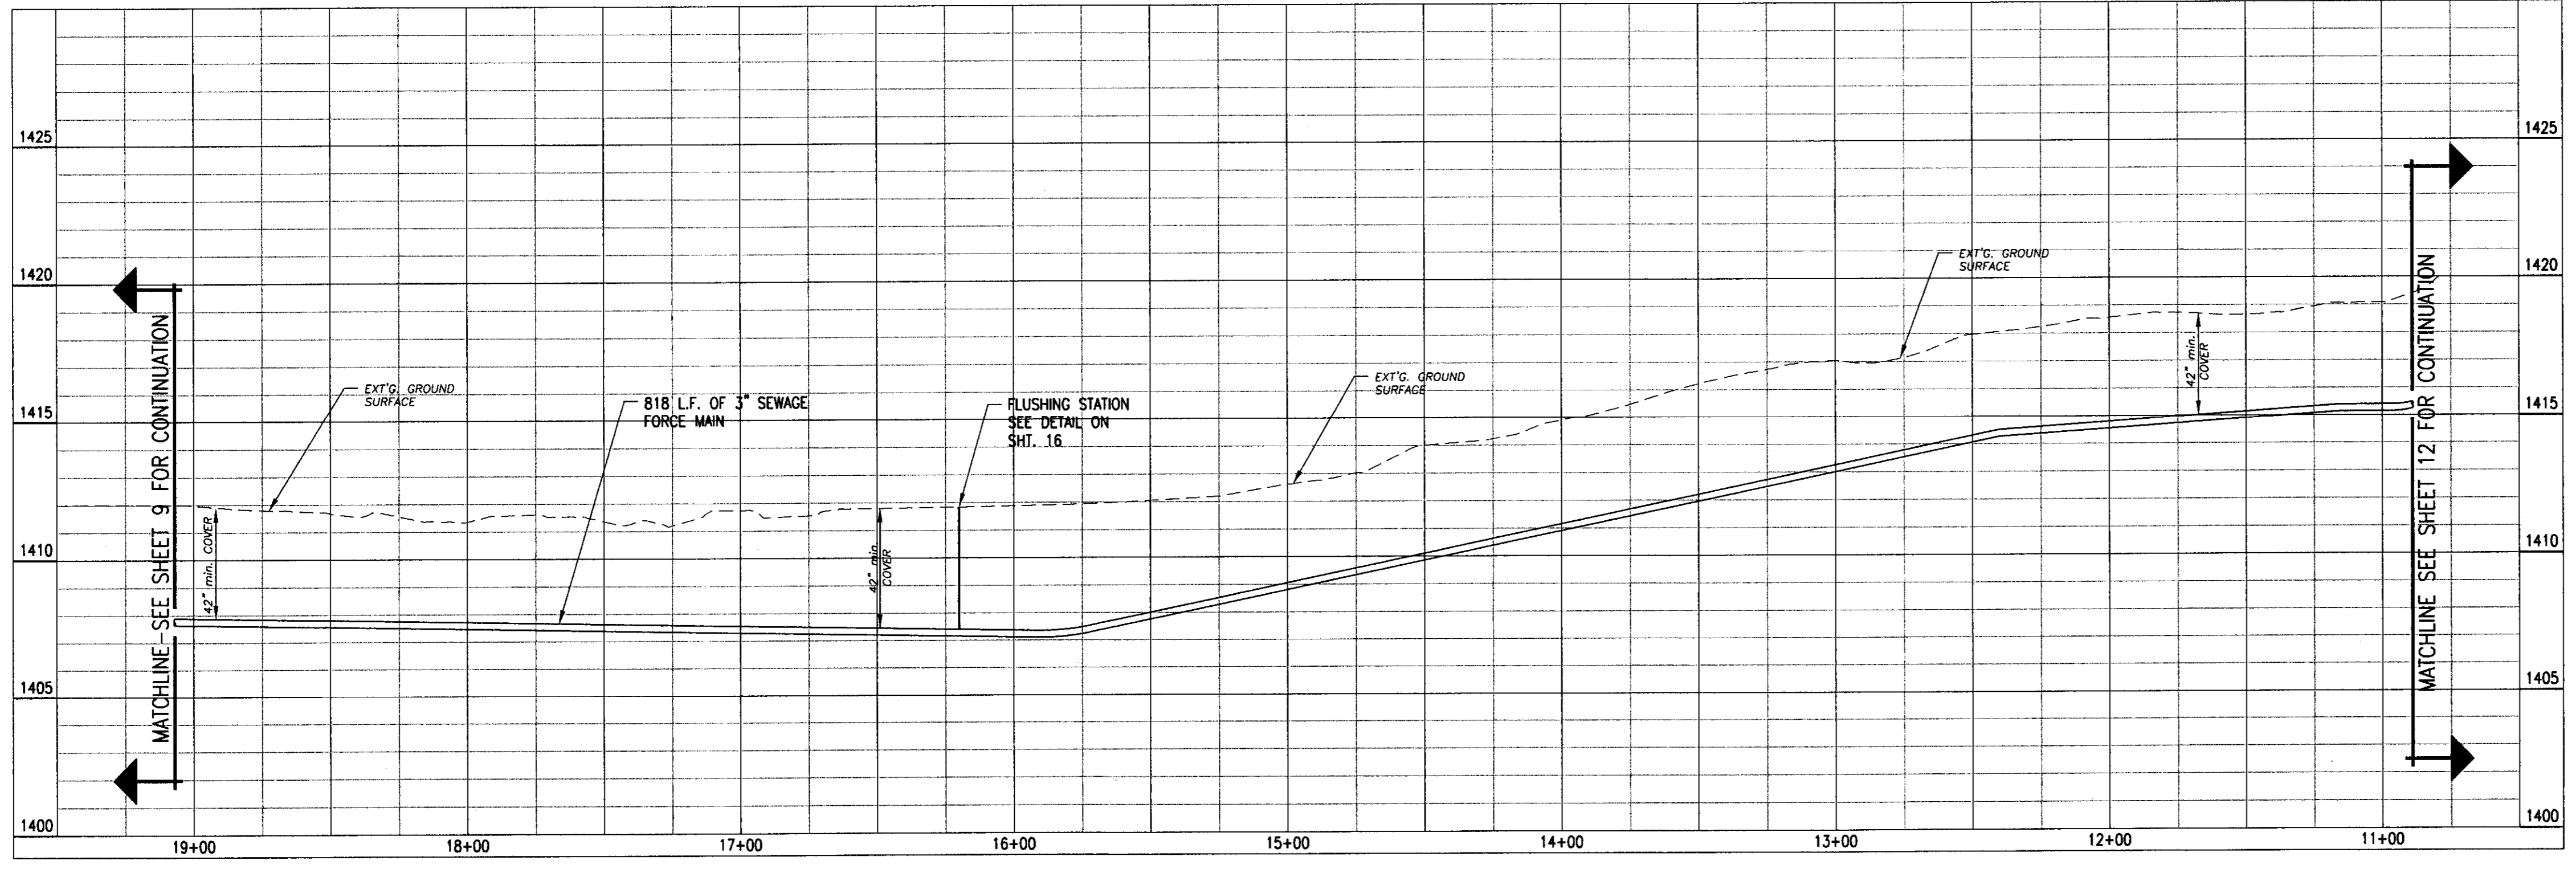

PROFILE VIEW
SCALE: HORIZ. 1" = 40'
VERT. 1" = 4'