


PLAN VIEW
SCALE: 1" = 40'

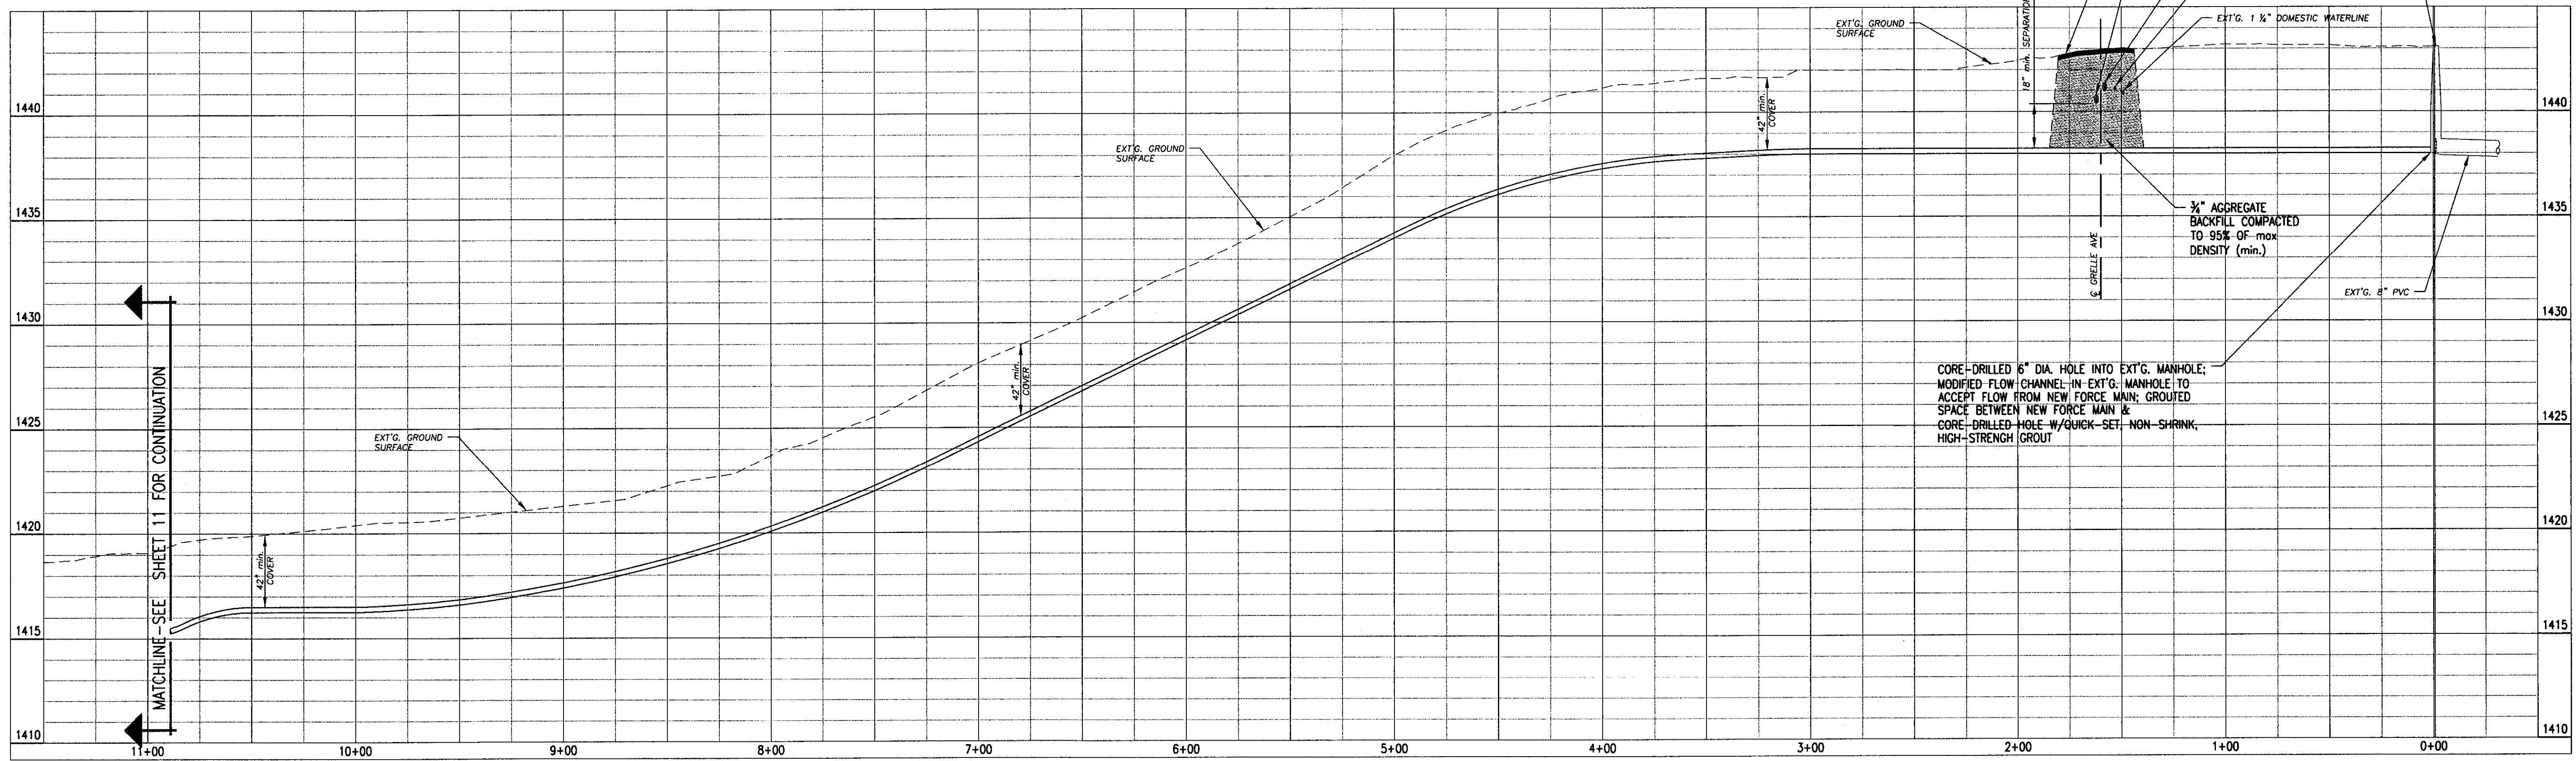


PROFILE VIEW
SCALE: HORIZ. 1" = 40'
VERT. 1" = 4'

CALL
TWO WORKING DAYS
BEFORE YOU DIG
1-800-342-1585
DIG LINE, INC.
3350 AMERICAN TERR. STE. 370
BOISE, IDAHO 83708

EXT'G. SANITARY SEWER MANHOLE
RIM EL. = 1443.13
I.E. OUT [N] = 1437.9
I.E. IN [N] = 1438.0
I.E. IN [S] = 1438.0

CORE-DRILLED 6" DIA. HOLE INTO EXT'G. MANHOLE;
MODIFIED FLOW CHANNEL IN EXT'G. MANHOLE TO
ACCEPT FLOW FROM NEW FORCE MAIN; GROUTED
SPACE BETWEEN NEW FORCE MAIN &
CORE-DRILLED HOLE W/QUICK-SET, NON-SHRINK,
HIGH-STRENGTH GROUT

NO.	DATE	BY	REVISIONS

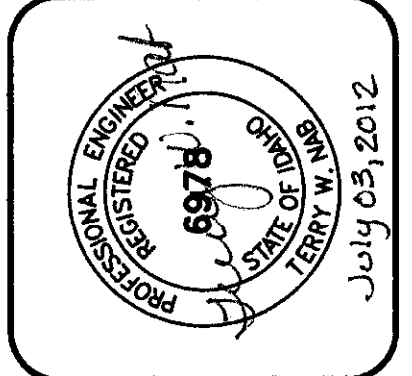

PROGRESSIVE ENGINEERING GROUP, INC.
PLANNING DESIGN & CONSTRUCTION MANAGEMENT
1208 IDAHO STREET
LEWISTON, IDAHO 83501
PH (208) 748-0406 FAX (208) 748-9782

D 2 J, INC.
SOUTHPORT WATER MAIN EXTENSION
AIRPORTE BUSINESS PARK
STA. 10+89 TO 0+00
LEWISTON, IDAHO 83501

DRAWN BY: WRE	CHECKED BY: TWN
DESIGNED BY: TWN	
DATE: 03/01/11	
LAST REV:	
PROJECT NO: 08-005	

Bill: Epson Stylus Pro.pc3, 36x24 horz, WRE