



ROADWAY CROSS SECTION (TYP.)

SCALE: 1" = 5'

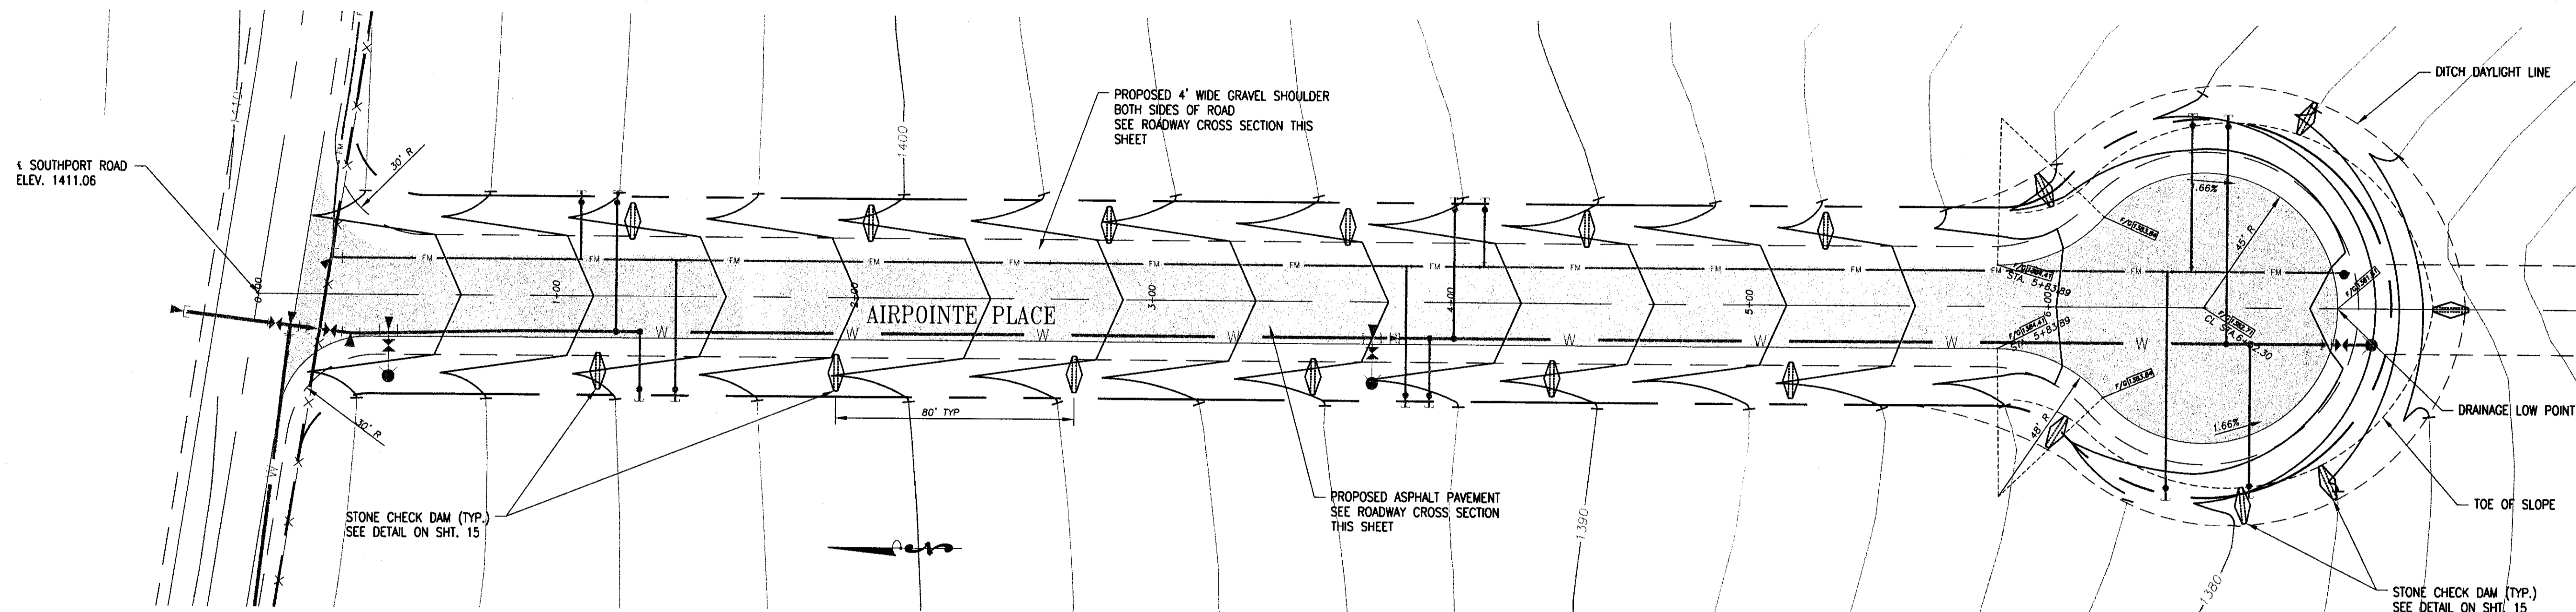

PLAN VIEW

SCALE: 1" = 30'

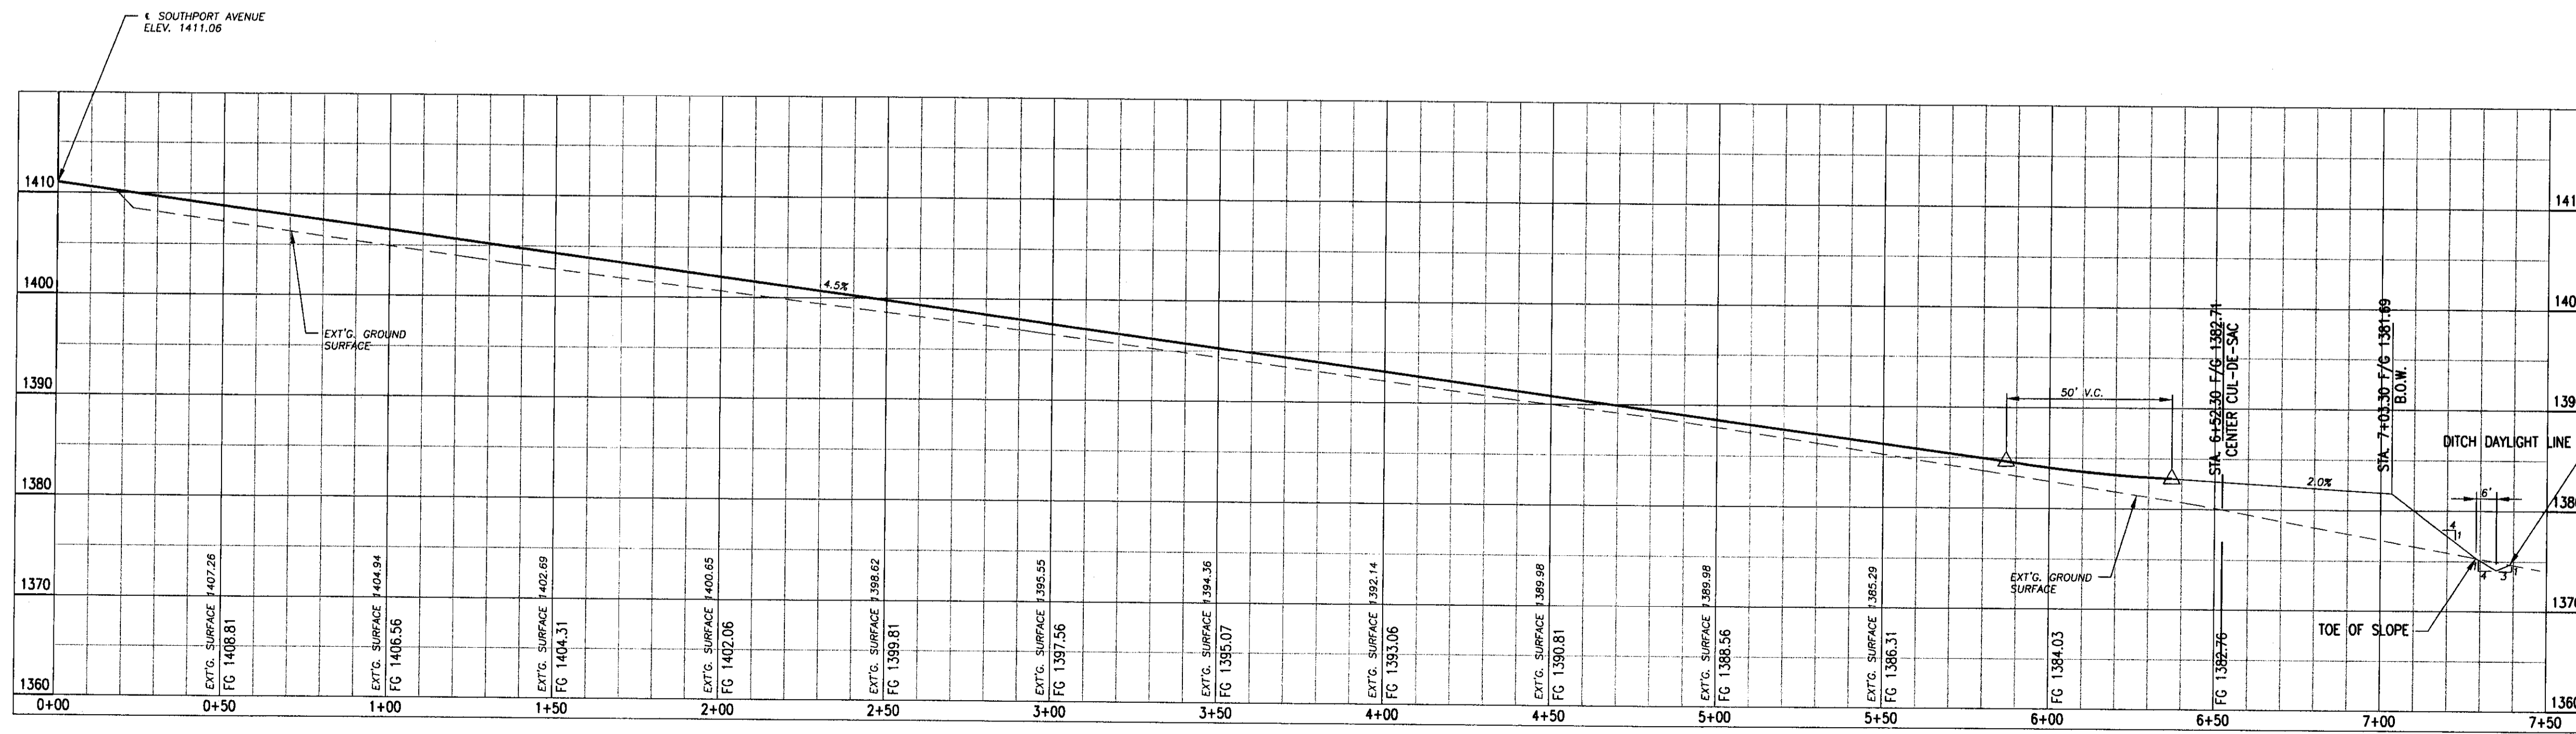


PROFILE VIEW

SCALE: HORIZ. 1" = 30'
VERT. 1" = 10'

RECORD DRAWING 06/21/12

REVISIONS	
DATE	BY

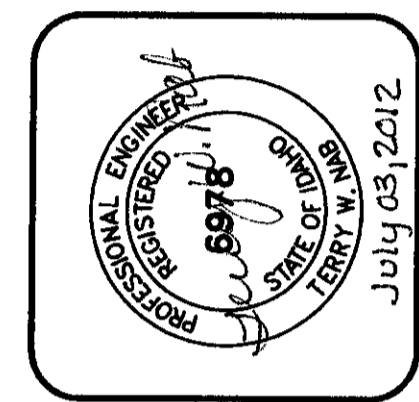

PROGRESSIVE ENGINEERING GROUP, INC.
 DESIGN & CONSTRUCTION MANAGEMENT
 1208 IDAHO STREET, LEWISTON, IDAHO 83501
 PH (208) 746-6408 FAX (208) 746-9732

D 2 J, INC.
 SOUTHPORT WATER MAIN EXTENSION
 AIRPOINTE BUSINESS PARK
 AIRPOINTE PLACE GRADING PLAN
 LEWISTON, IDAHO 83501

DRAWN BY: djb	CHECKED BY: TWN
DESIGNED BY: TWN	
DATE: 02/28/11	
LAST REV:	
PROJECT NO: 08-005	
SHEET 13 OF 17	