



PLAN VIEW
 SCALE: 1" = 40'

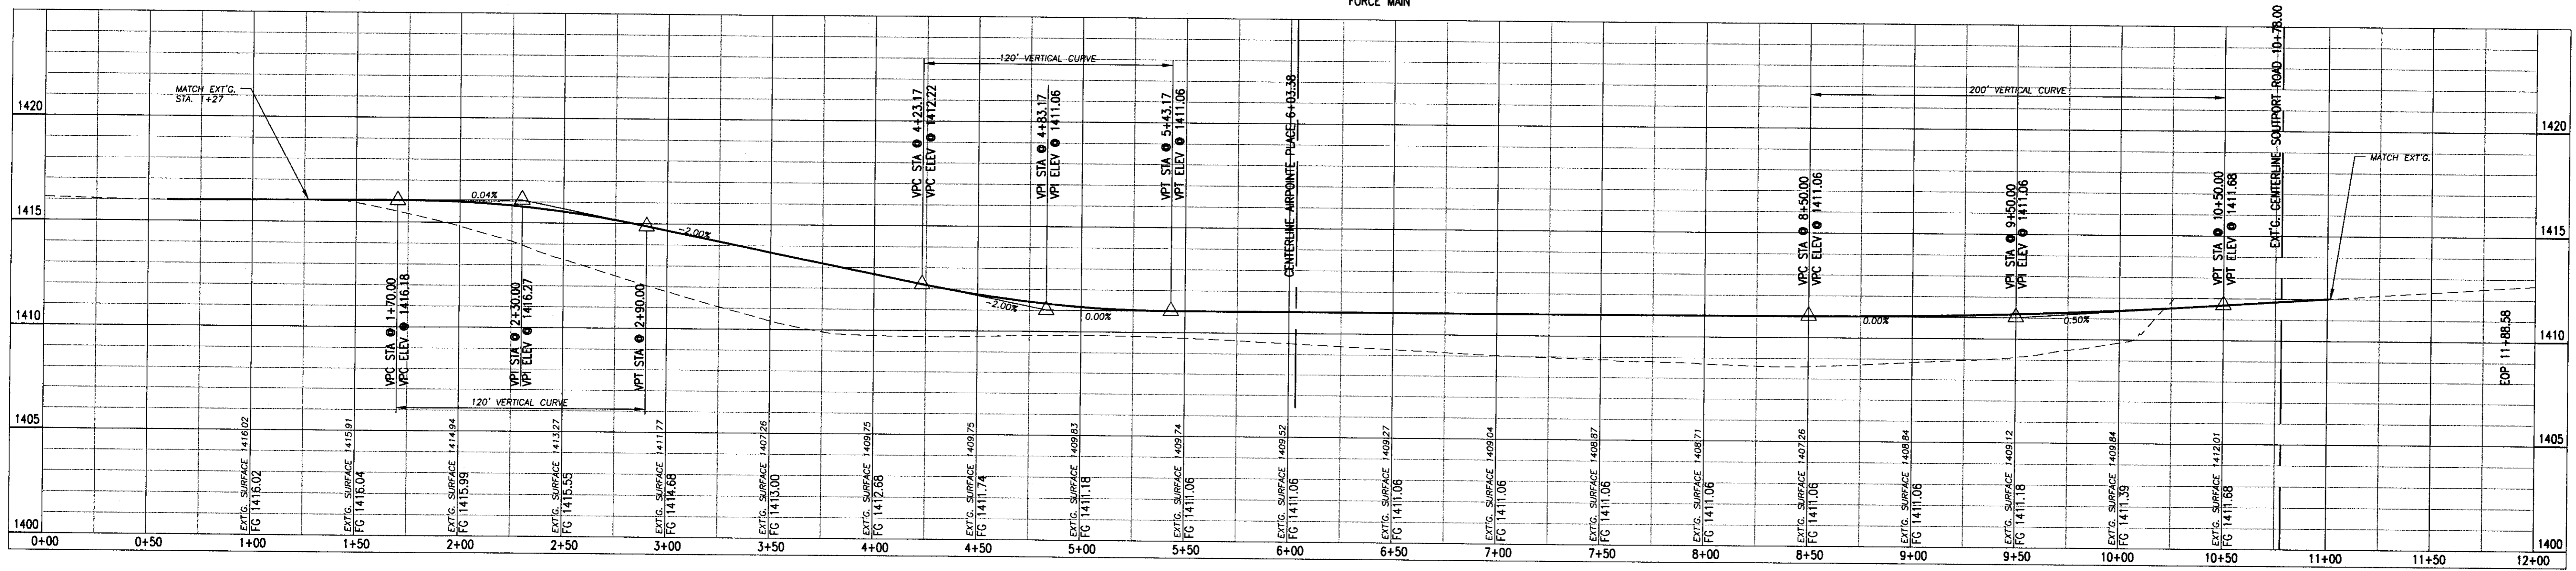


PROFILE VIEW - SOUTHPORT AVENUE
 SCALE: HORIZ. 1" = 40'
 VERT. 1" = 4'

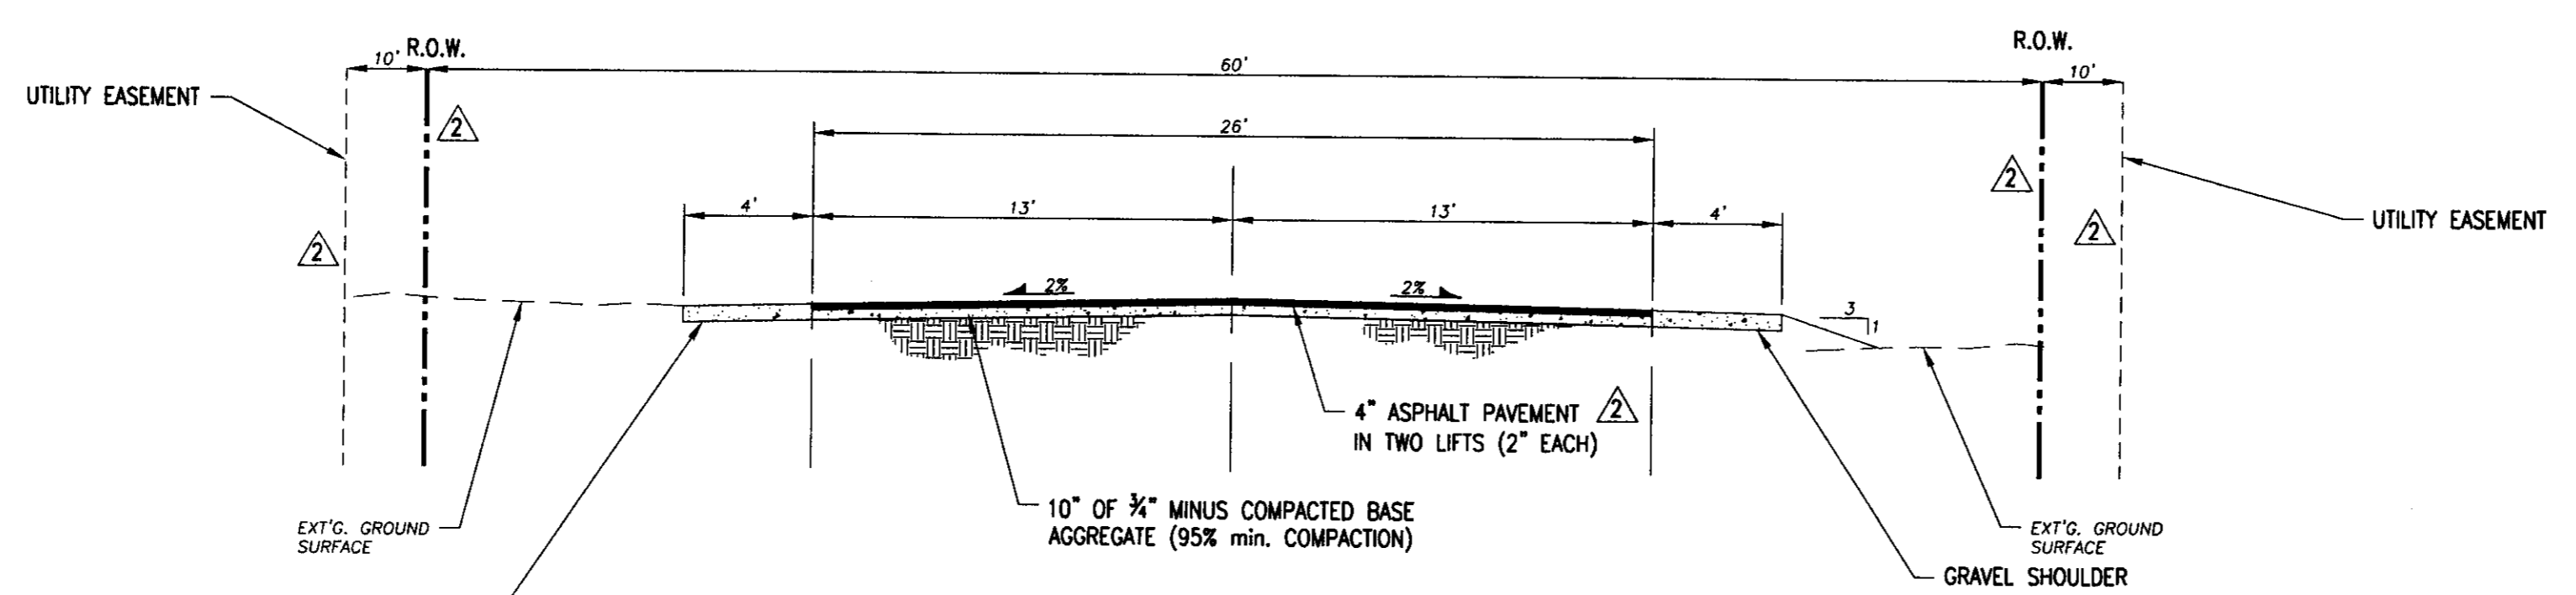

ROADWAY CROSS SECTION (TYP.)
 SCALE: 1" = 5'

RECORD DRAWING 06/21/12

REVISED	BY	DATE

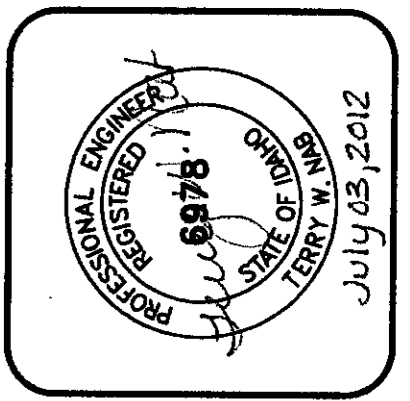

PROGRESSIVE ENGINEERING GROUP, INC
 PLANNING DESIGN & CONSTRUCTION MANAGEMENT
 1208 IDAHO STREET
 LEWISTON, IDAHO 83501
 PH (208) 746-3406 FAX (208) 746-9752

D 2 J, INC.
 SOUTHPORT WATER MAIN EXTENSION
 AIRPOINTE BUSINESS PARK
 SOUTHPORT AVE GRADING PLAN
 LEWISTON, IDAHO 83501

DRAWN BY: WRE	CHECKED BY: TWN
DESIGNED BY: TWN	
DATE: 02/28/11	
LAST REV: 10/12/11	
PROJECT NO.: 08-005	
SHEET 14 OF 17	