



**PLAN VIEW**  
SCALE: 1" = 200'

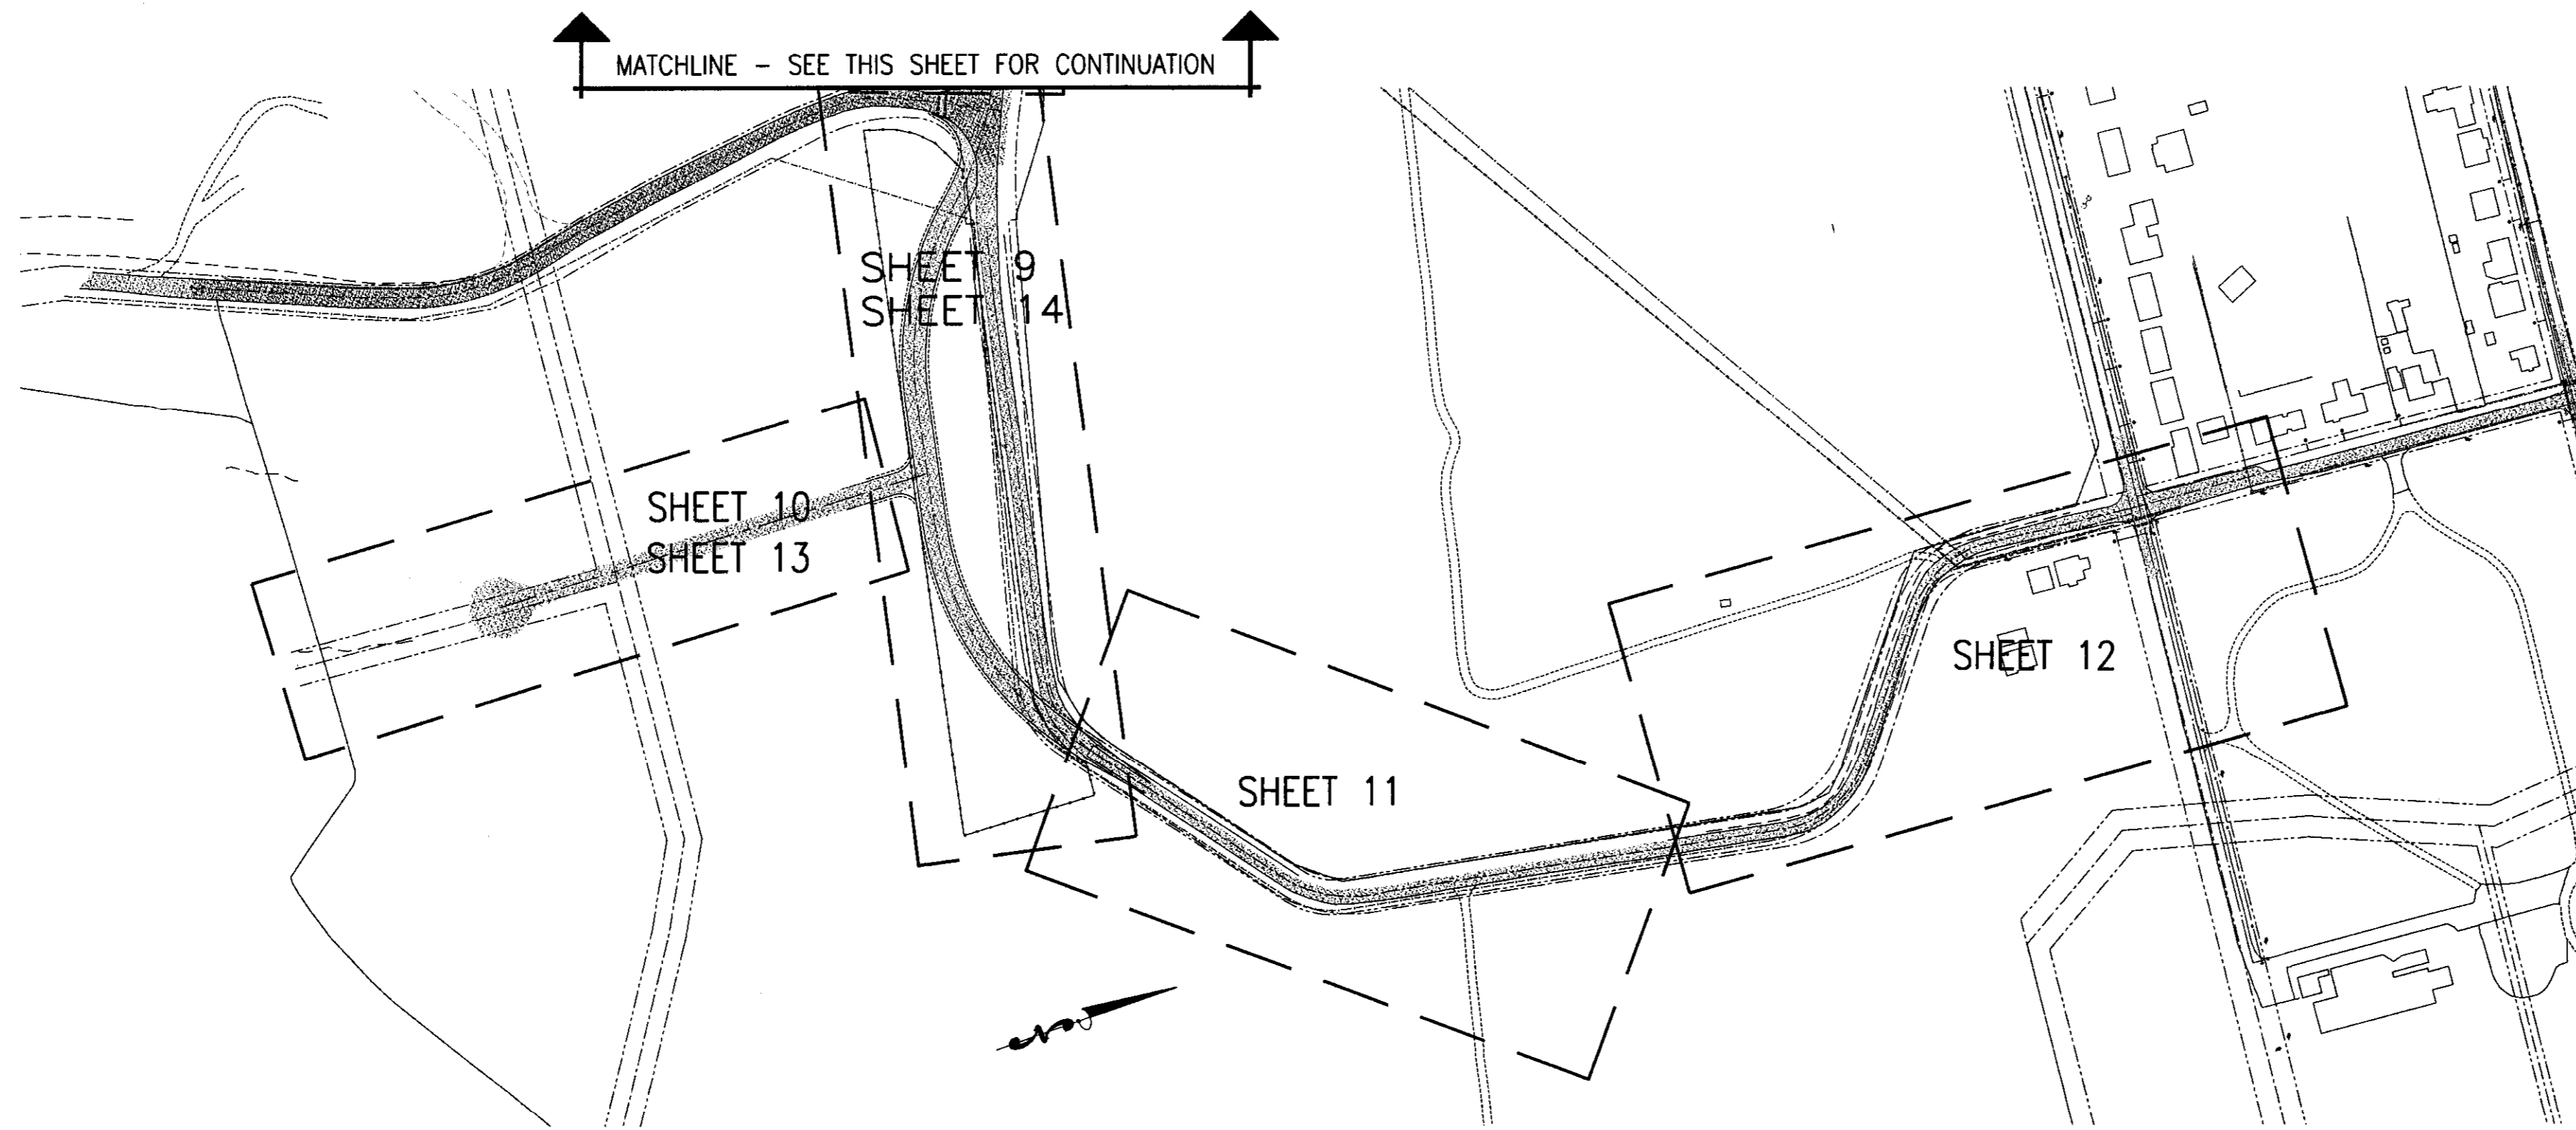

**PLAN VIEW**  
SCALE: 1" = 200'

REVISIONS			
NO.	DATE	BY	

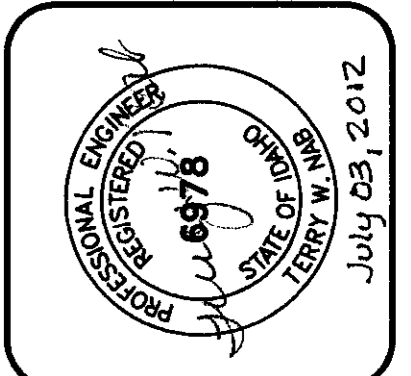

**PROGRESSIVE ENGINEERING GROUP, INC**  
 DESIGN & CONSTRUCTION MANAGEMENT  
 1208 IDAHO STREET  
 LEWISTON, IDAHO 83501  
 PH (208) 746-5406 FAX (208) 746-9732

**D 2 J, INC.**  
 SOUTHPORT WATER MAIN EXTENSION  
 AIRPOINTE BUSINESS PARK  
 SHEET LAYOUT  
 LEWISTON, IDAHO 83501

DRAWN BY:	CHECKED BY:
WRE	TWN
DESIGNED BY:	
DATE:	02/23/11
LAST REV:	
PROJECT NO.:	08-005
SHEET 2	OF 17