



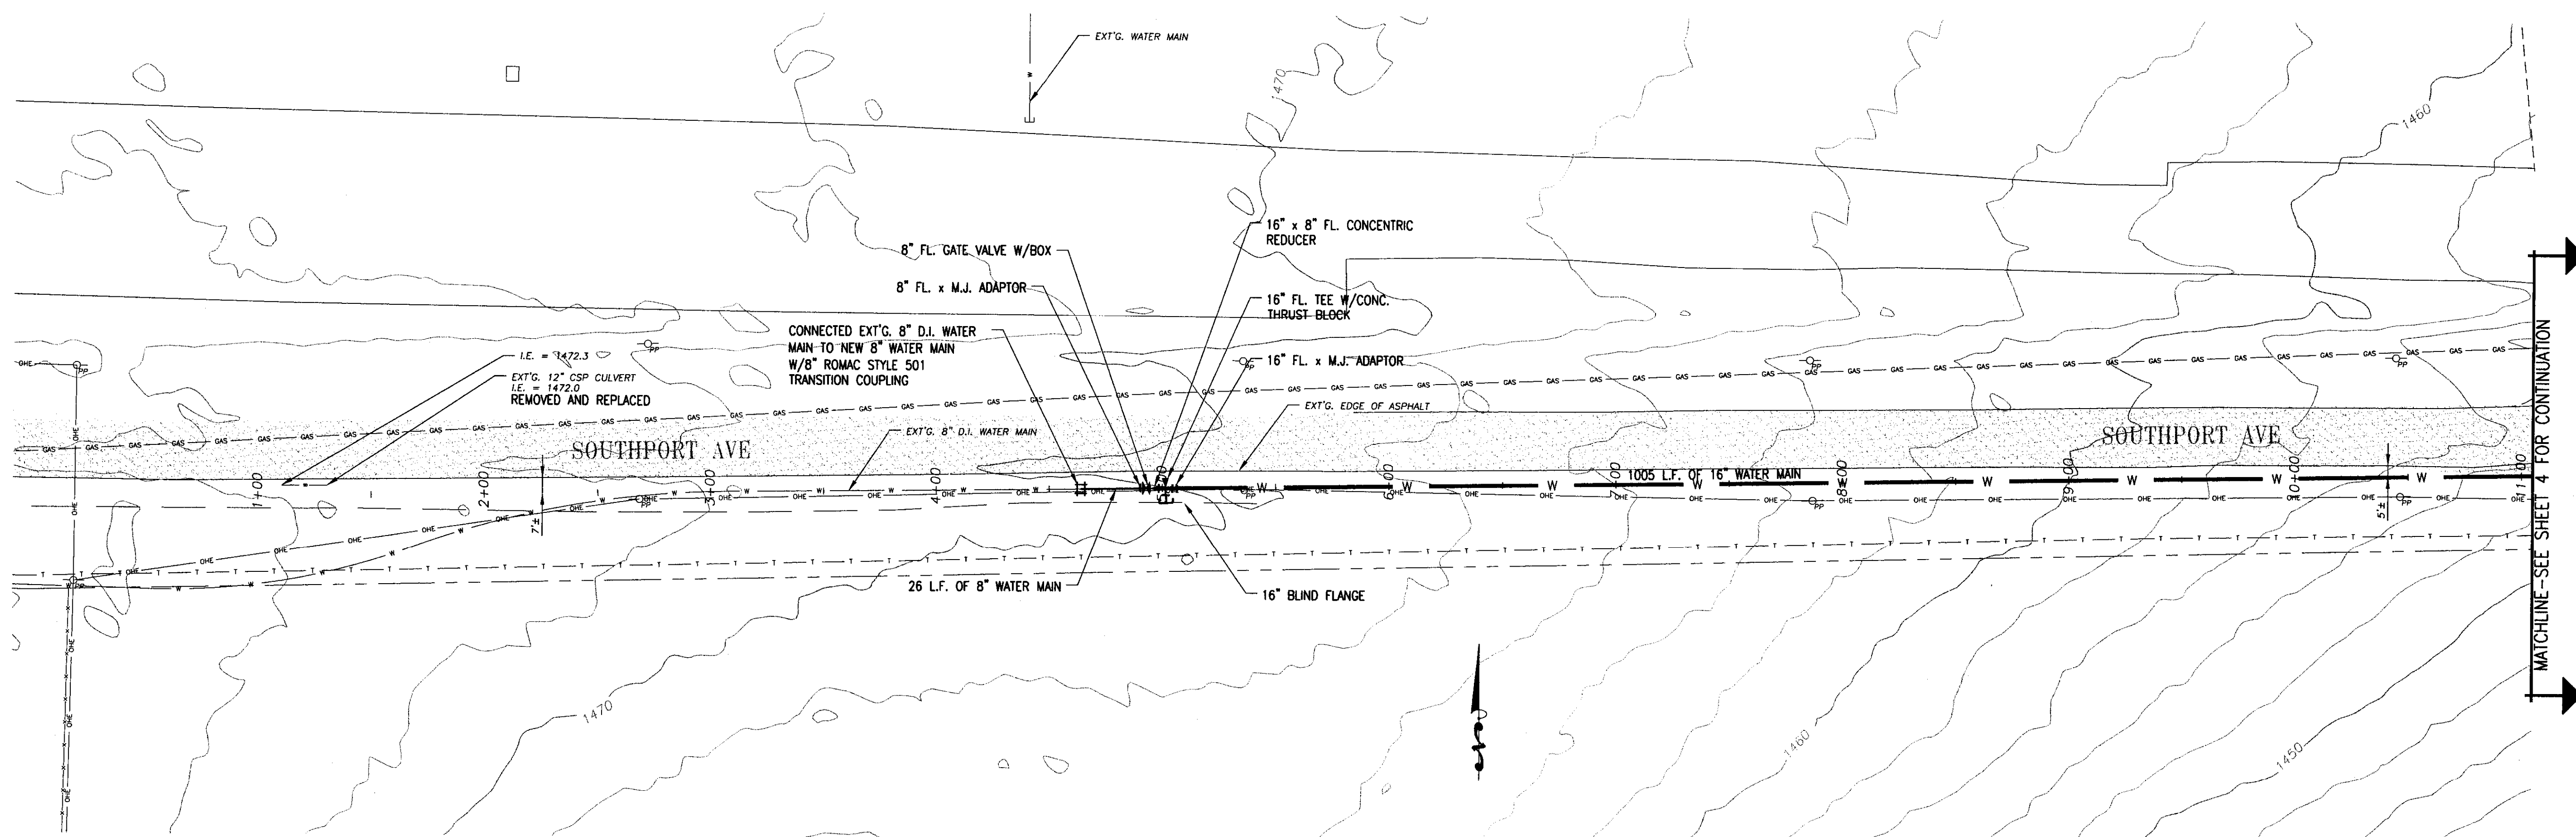


PLAN VIEW
SCALE: 1" = 40'

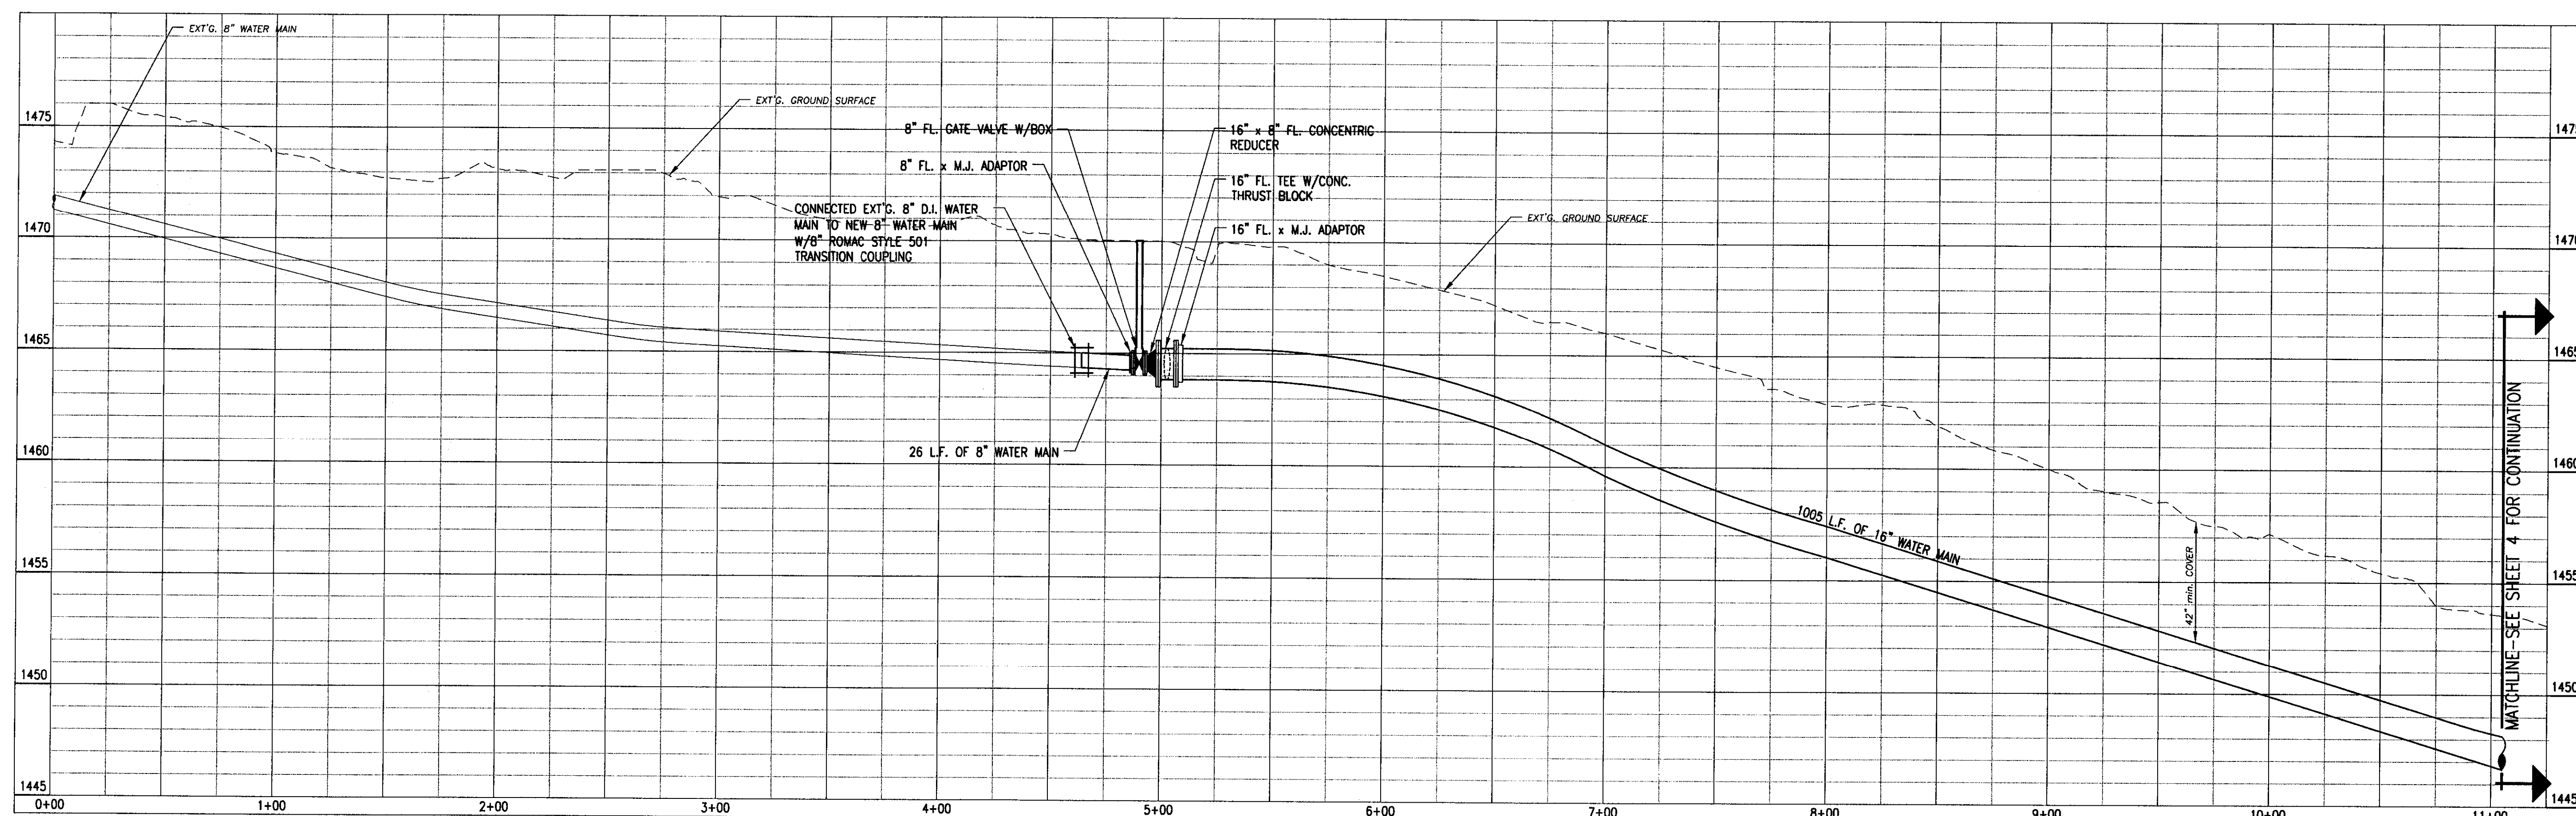

PROFILE VIEW
SCALE: HORIZ. 1" = 40'
VERT. 1" = 4'

RECORD DRAWING 06/21/12

REVISIONS	
NO.	DATE

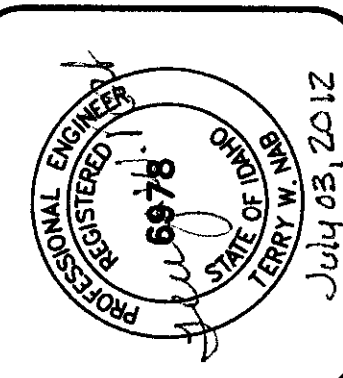

PROGRESSIVE ENGINEERING GROUP, INC.
DESIGN & CONSTRUCTION MANAGEMENT
1008 IDAHO STREET
LEWISTON, IDAHO 83501
PH (208) 748-8400 FAX (208) 748-8732

D 2 J, INC.
SOUTHPORT WATER MAIN EXTENSION
AIRPOINTE BUSINESS PARK.
STA. 0+00 TO STA. 11+05
LEWISTON, IDAHO 83501

DESIGNED BY: MSR	CHECKED BY: TWN
DATE: 06/21/12	LAST REV:
PROJECT NO.: 08-005	SHEET 3 OF 17