



PLAN VIEW
SCALE: 1" = 40'

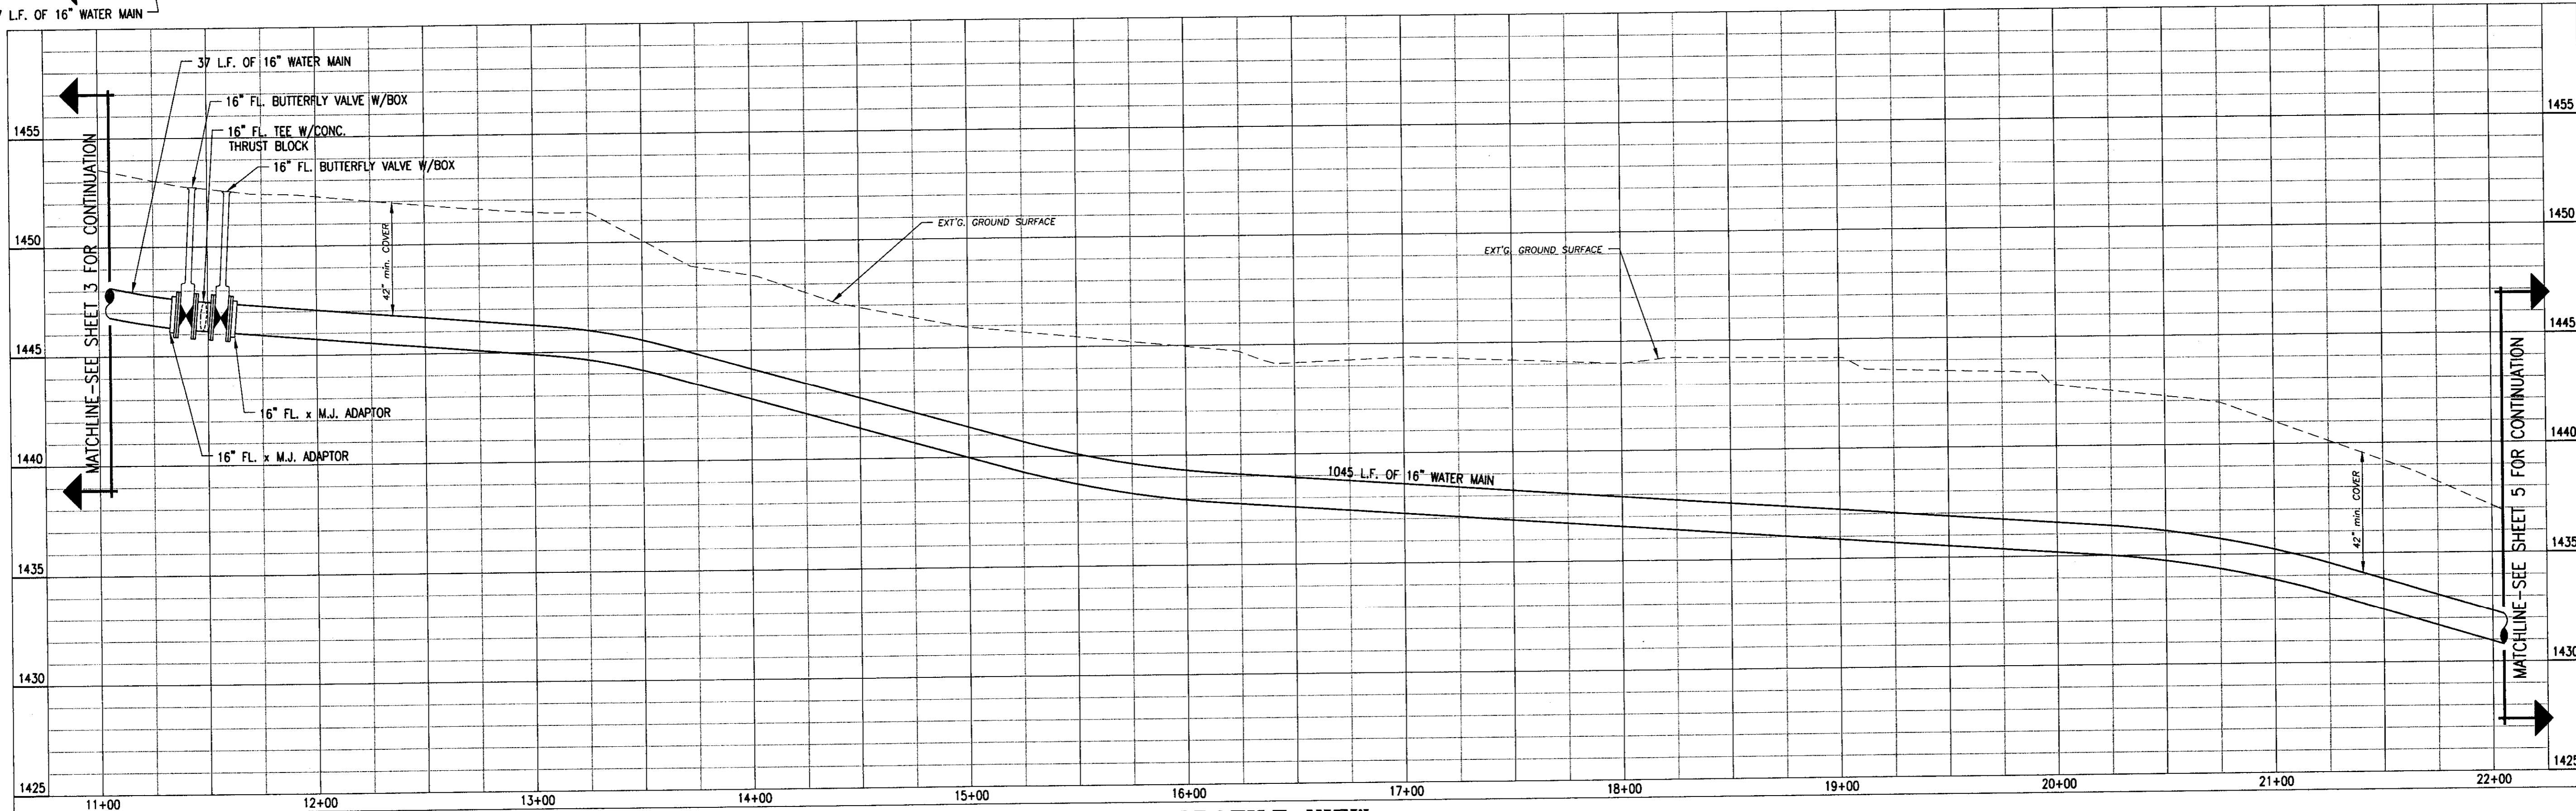

PROFILE VIEW
SCALE: HORIZ. 1" = 40'
VERT. 1" = 4'

RECORD DRAWING 06/21/12

REVISIONS		
NO.	DATE	BY

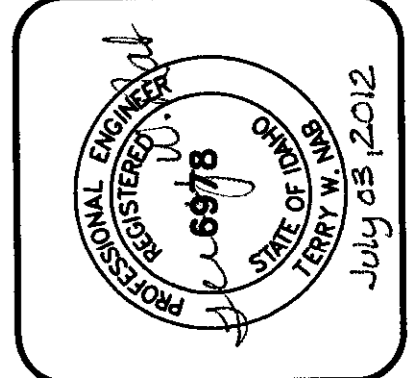

PROGRESSIVE ENGINEERING GROUP, INC.
 PLANNING DESIGN & CONSTRUCTION MANAGEMENT
 1808 IDAHO STREET
 LEWISTON, IDAHO 83501
 PH (208) 748-5406 FAX (208) 748-9732

D 2 J, INC.
 SOUTHPORT WATER MAIN EXTENSION
 AIRPOINTE BUSINESS PARK
 STA. 11+05 TO STA. 22+05
 LEWISTON, IDAHO 83501

DRAWN BY: MSR	CHECKED BY: TWN
DESIGNED BY: TWN	
DATE: 06/21/12	
LAST REV:	
PROJECT NO: 08-005	
SHEET 4 OF 17	