


**PLAN VIEW**  
SCALE: 1" = 40'


**CALL**  
TWO WORKING DAYS  
**BEFORE YOU DIG**  
1-800-342-1585  
DIG LINE, INC.  
3350 AMERICAN TERR., STE. 370  
BOISE, IDAHO 83708

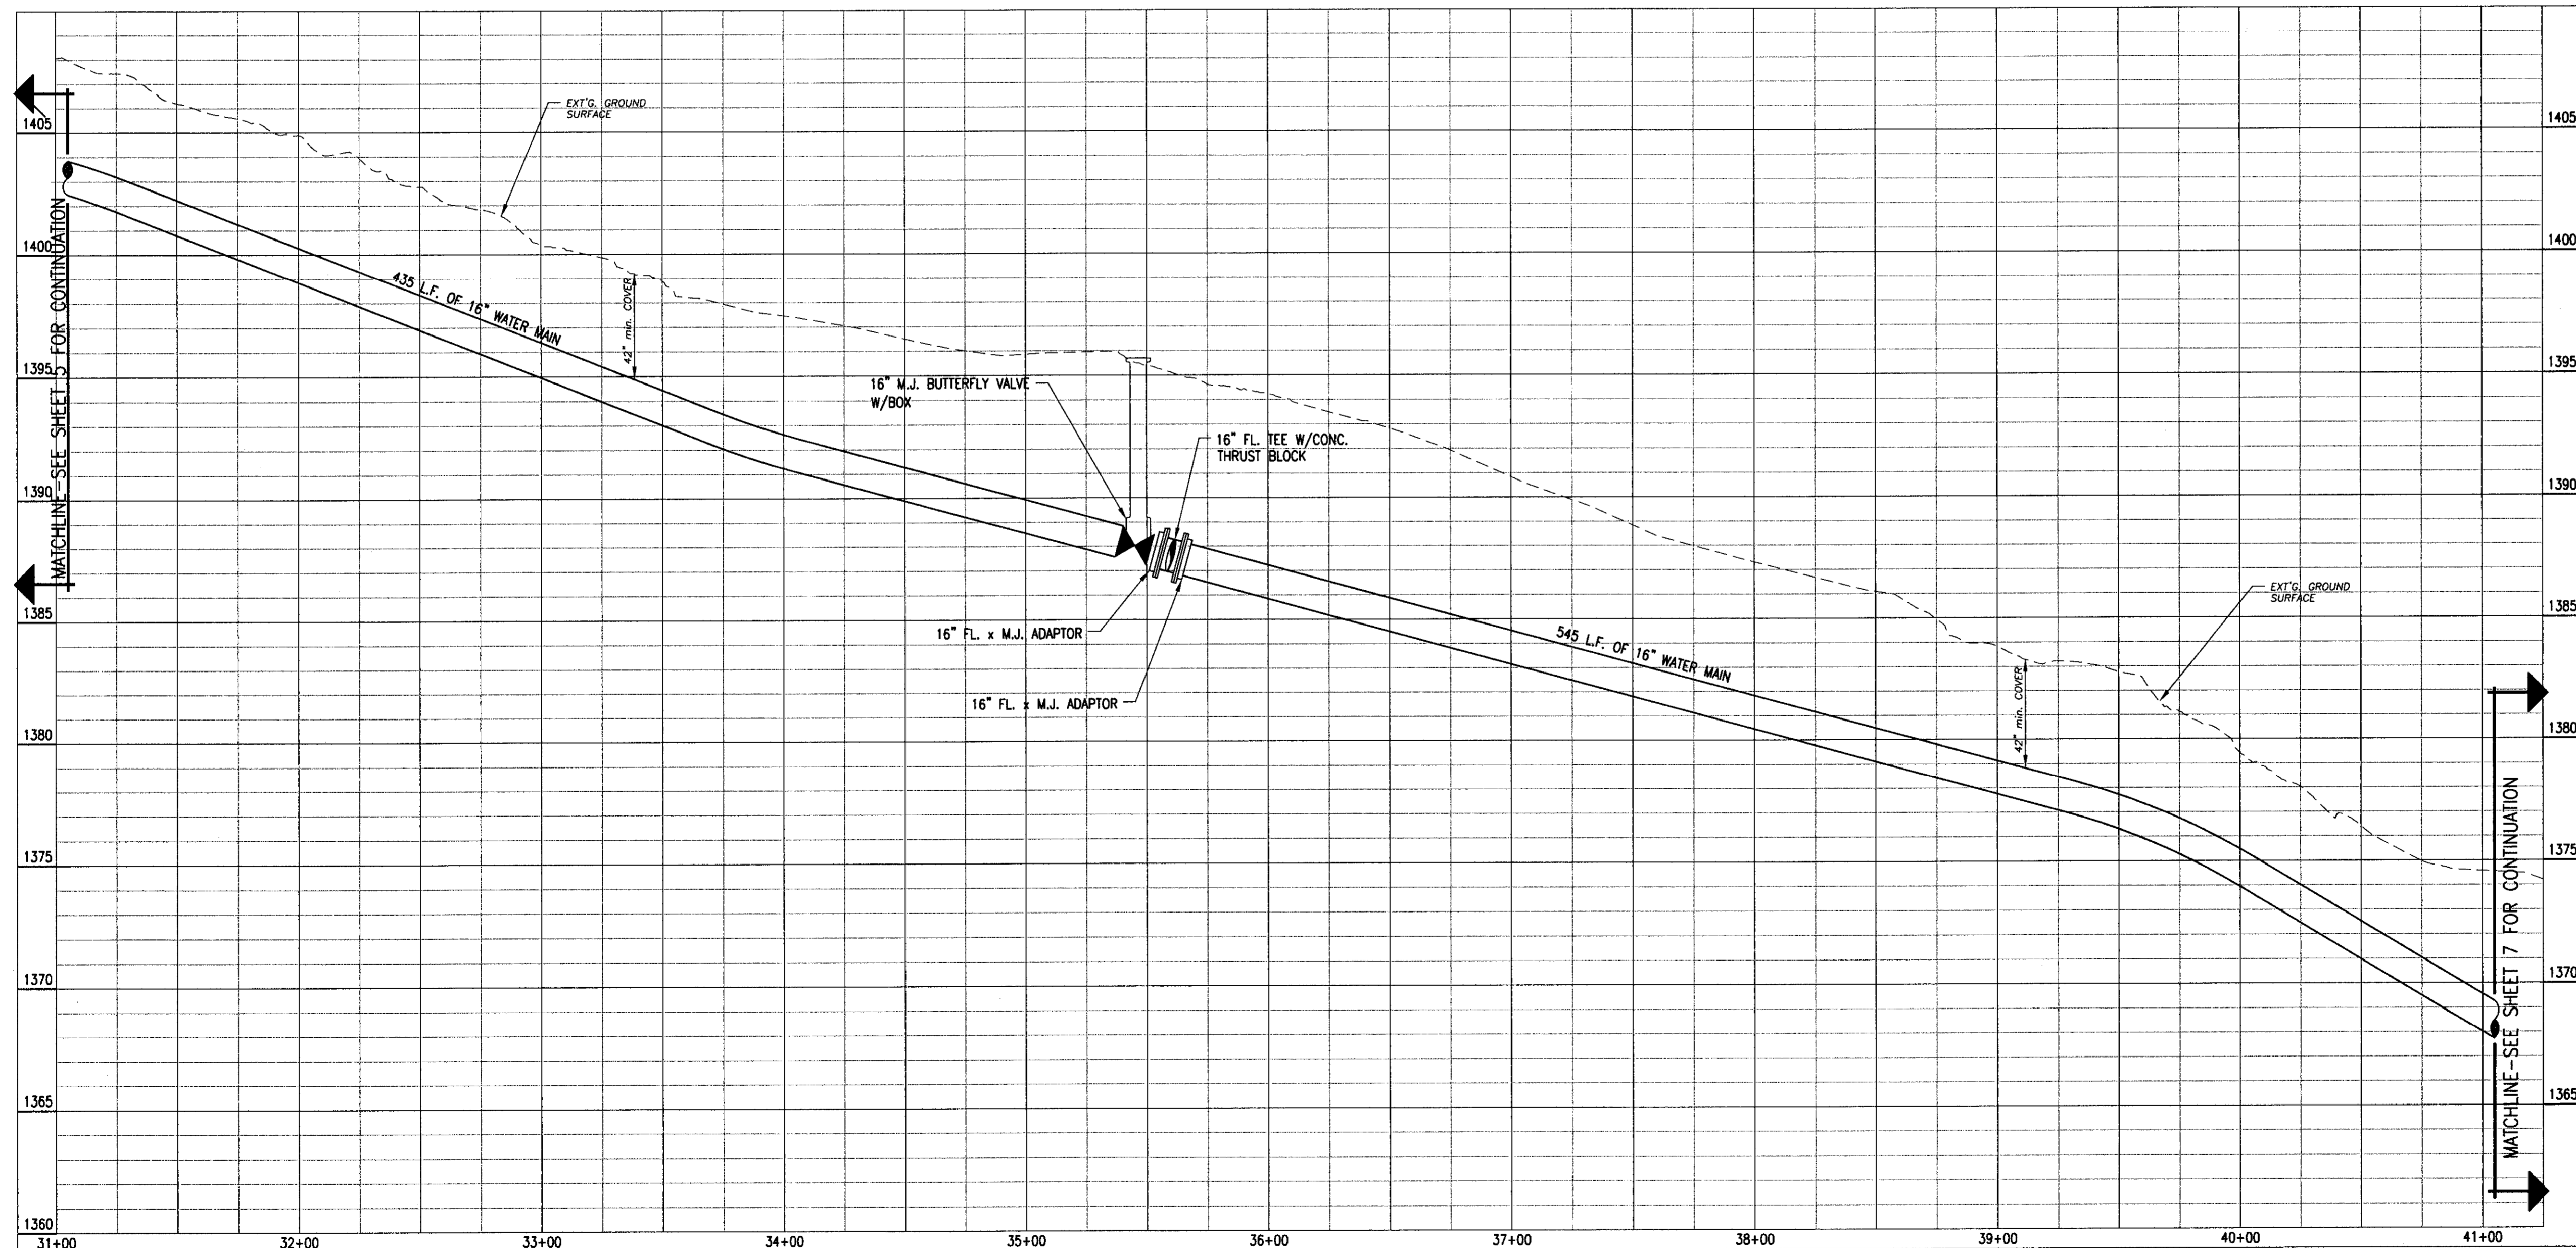

**PROFILE VIEW**  
SCALE: HORZ. 1" = 40'  
VERT. 1" = 4'

**RECORD DRAWING 06/21/12**

NO.	DATE	BY	REVISIONS

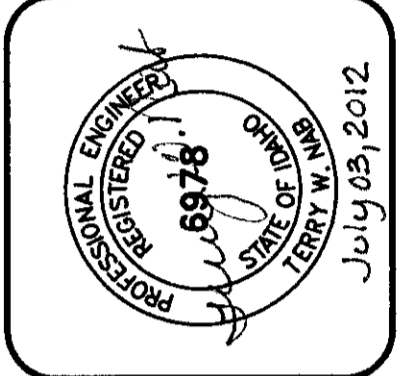

**PROGRESSIVE ENGINEERING GROUP, INC.**  
DESIGN + CONSTRUCTION MANAGEMENT  
1208 IDAHO STREET  
LEWISTON, IDAHO 83501  
PH (208) 746-6406 FAX (208) 746-9782

**D 2 J, INC.**  
SOUTHPORT WATER MAIN EXTENSION  
AIRPORTE BUSINESS PARK  
STA. 31+05 TO STA. 41+05  
LEWISTON, IDAHO 83501

DRAWN BY: MSR	CHECKED BY: TWN
DESIGNED BY: TWN	
DATE: 06/21/12	
LAST REV:	
PROJECT NO: 08-005	
SHEET 6	OF 17