



PLAN VIEW
SCALE: 1" = 40'

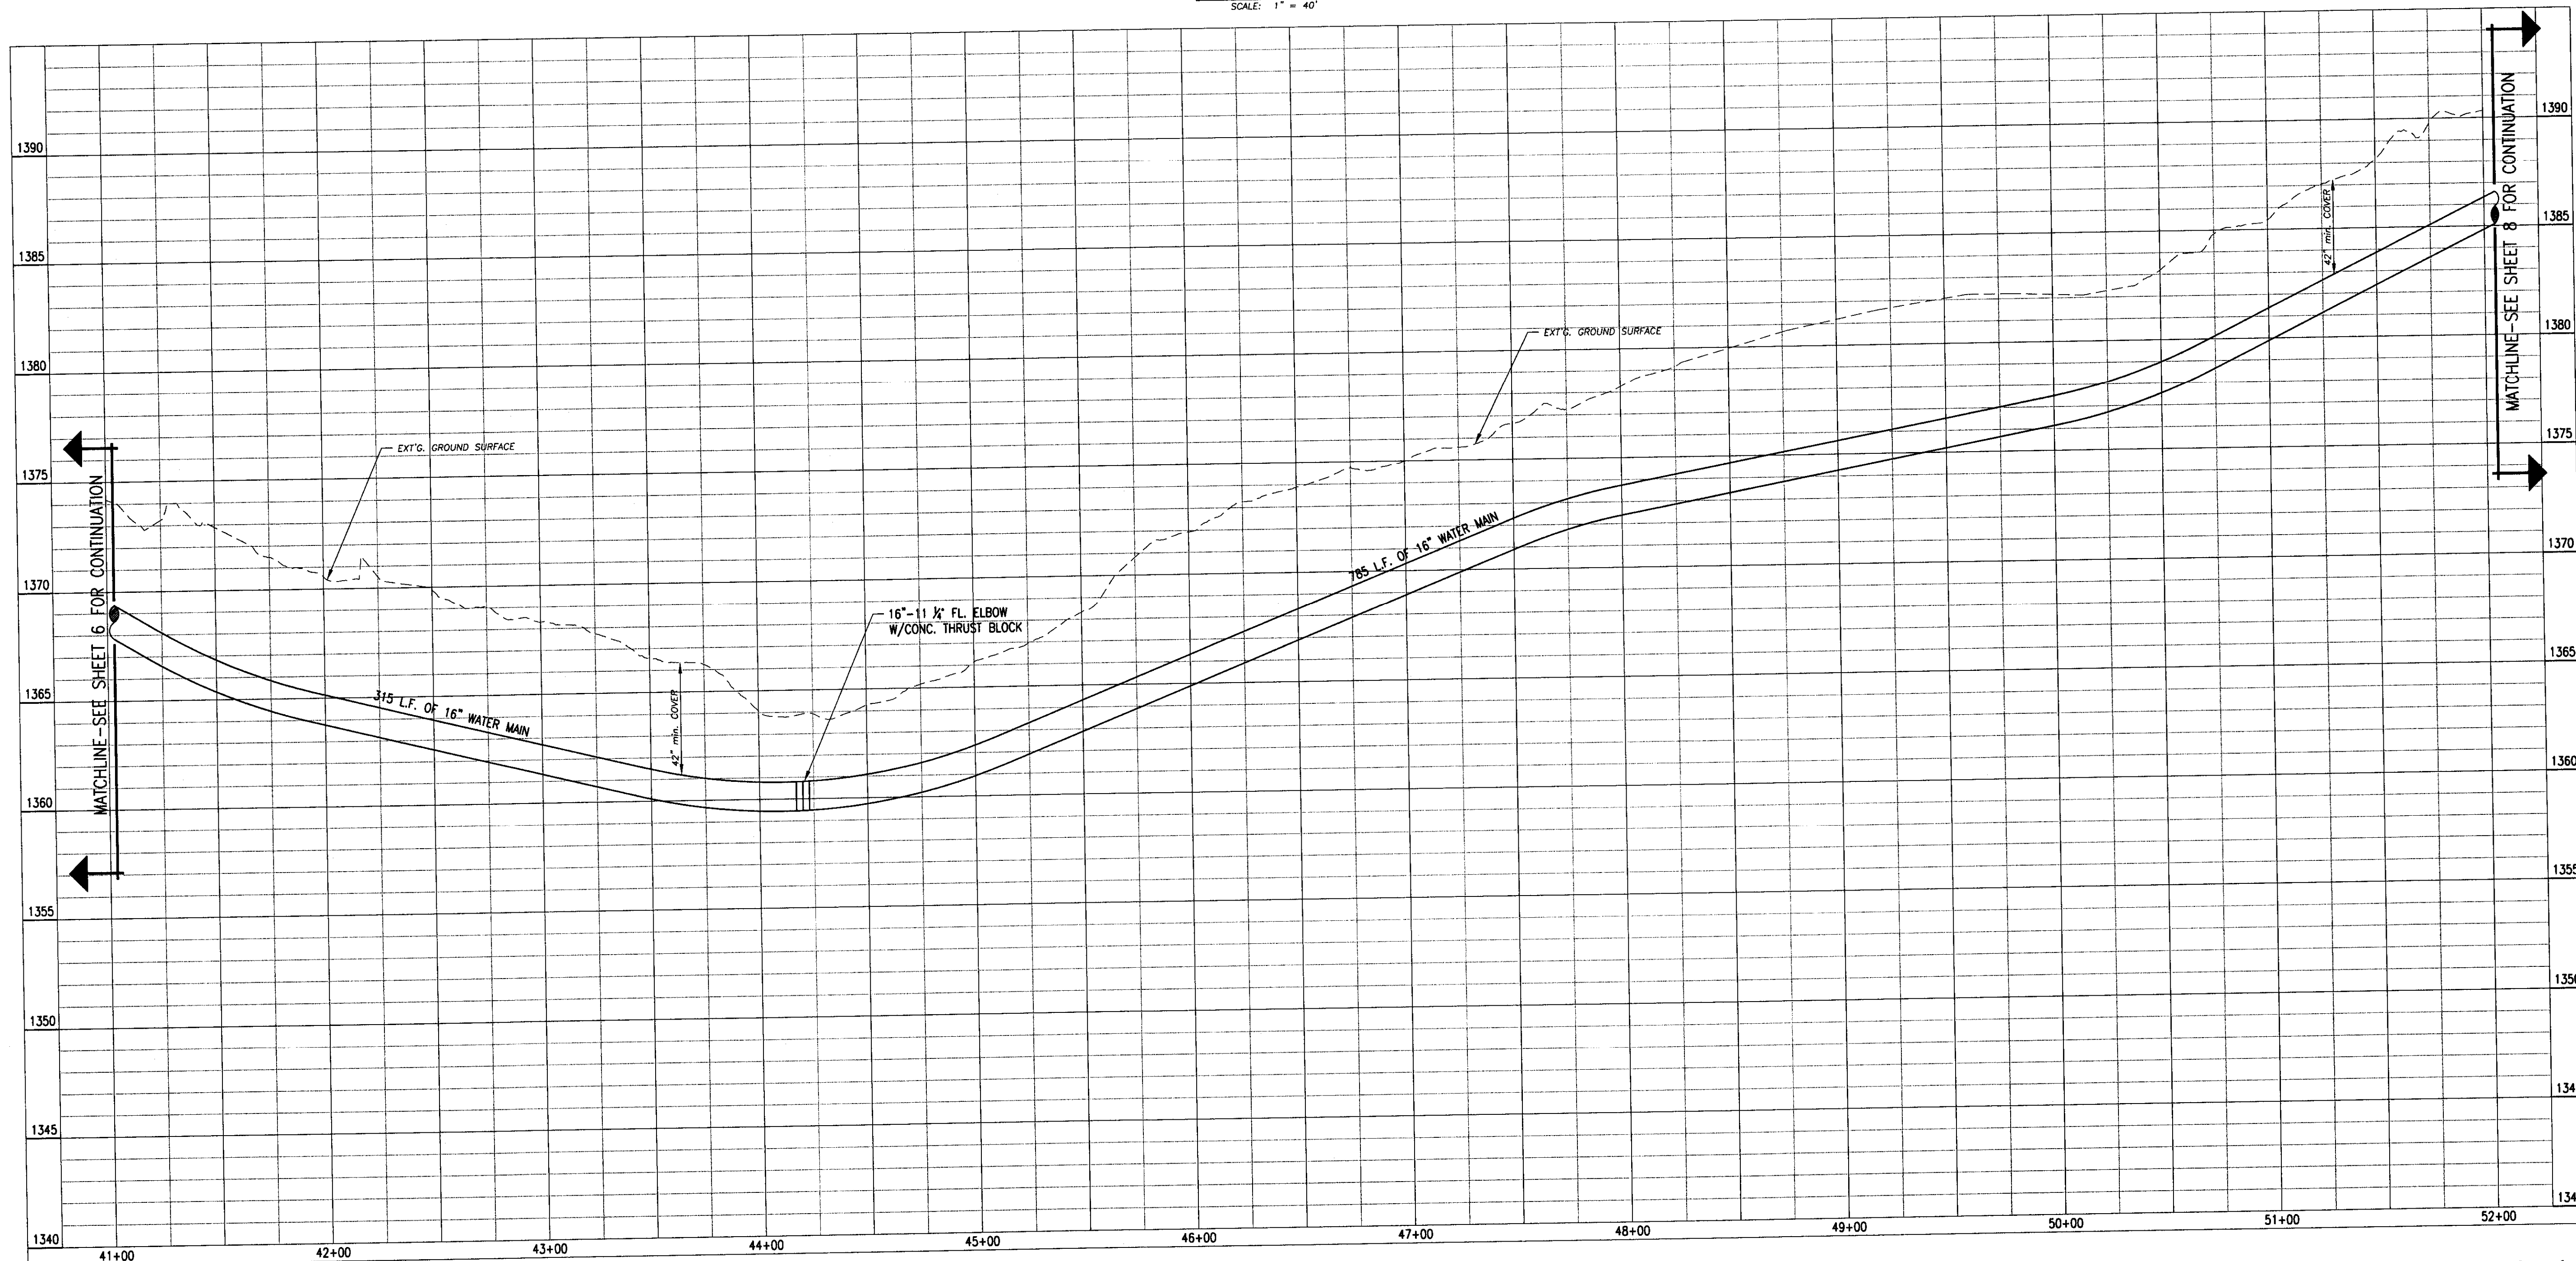

PROFILE VIEW
SCALE: HORIZ. 1" = 40'
VERT. 1" = 4'

RECORD DRAWING 06/21/12

NO.	DATE	BY	REVISIONS

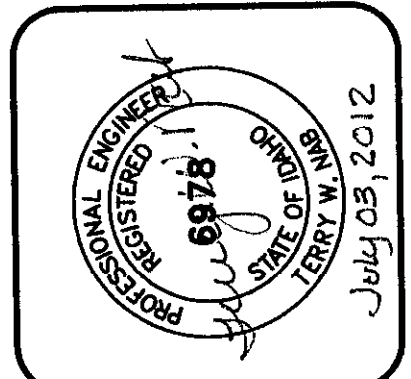

PROGRESSIVE ENGINEERING GROUP, INC.
 PLANNING DESIGN & CONSTRUCTION MANAGEMENT
 1208 IDAHO STREET
 LEWISTON, IDAHO 83501
 PH (208) 746-3406 FAX (208) 746-8728

D 2 J, INC.
 SOUTHPORT WATER MAIN EXTENSION
 AIRPOINTE BUSINESS PARK
 STA. 41+05 TO STA. 52+05
 LEWISTON, IDAHO 83501

DRAWN BY: MSR	CHECKED BY: TWN
DESIGNED BY: TWN	DATE: 06/21/12
LAST REV:	PROJECT NO.: 08-005
SHEET 7 OF 17	