




PLAN VIEW
SCALE: 1" = 40'

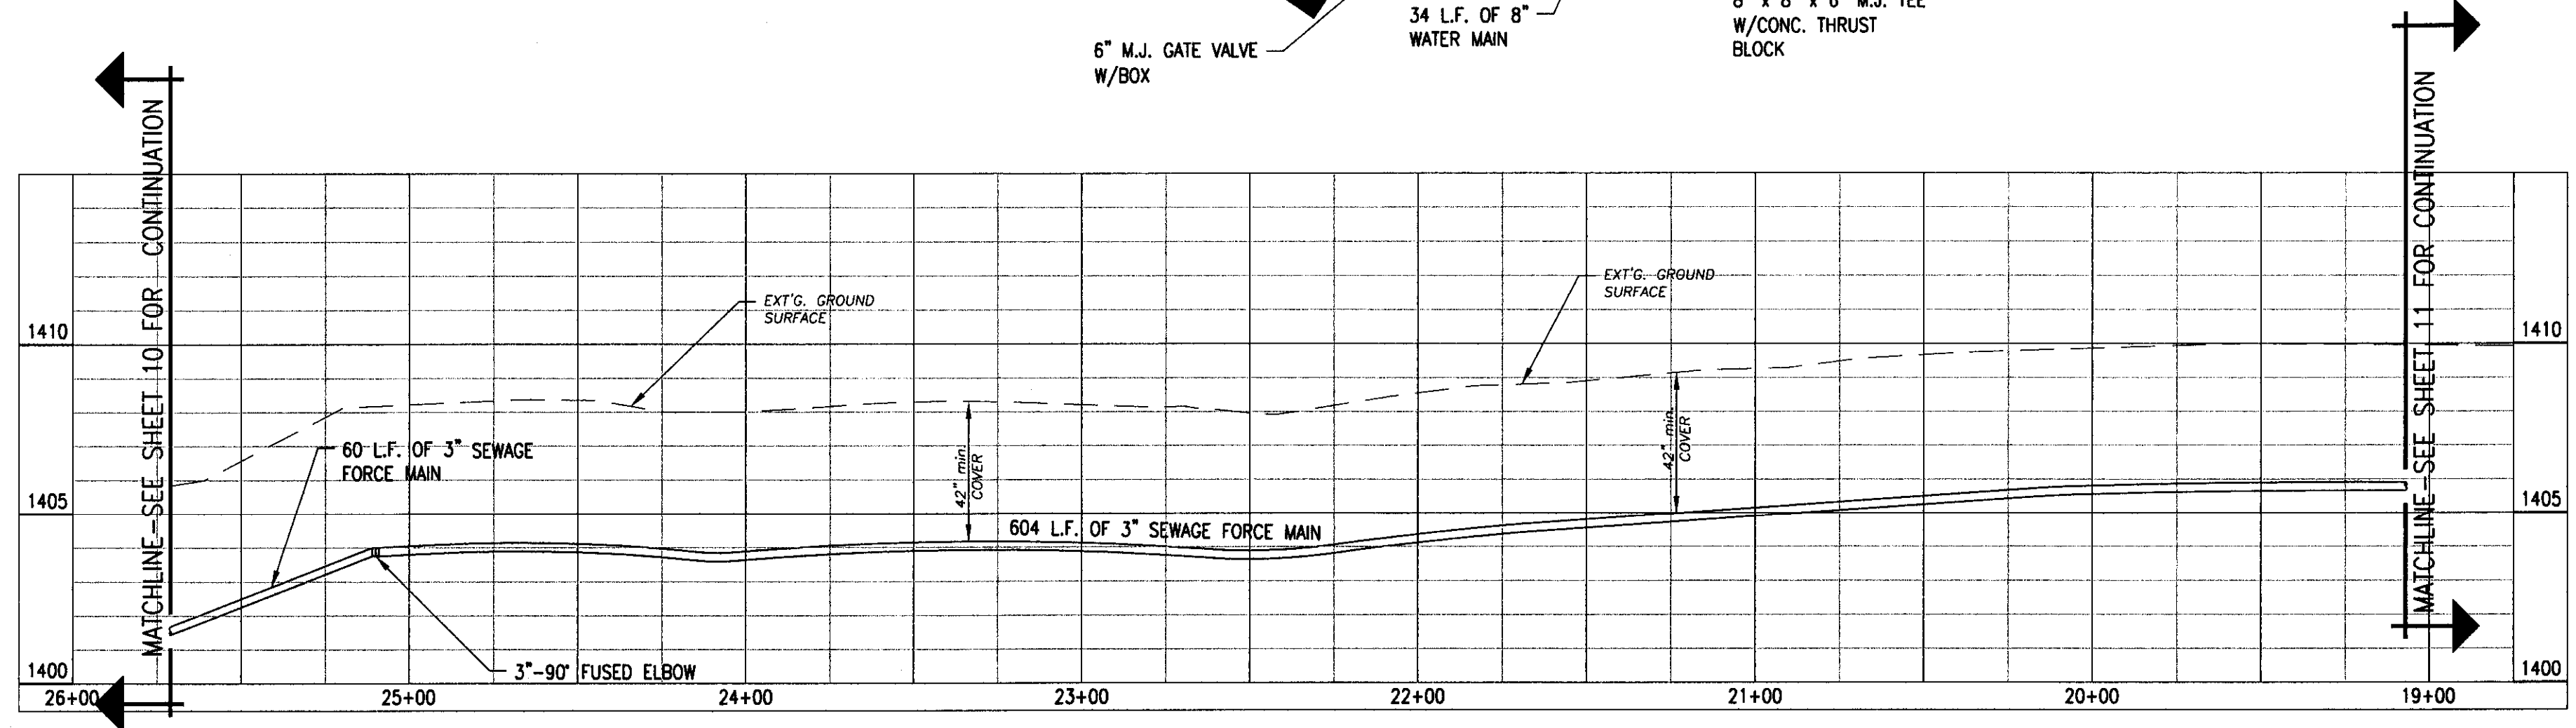


PROFILE VIEW - SEWAGE FORCE MAIN
SCALE: HORIZ. 1" = 40' VERT. 1" = 4'

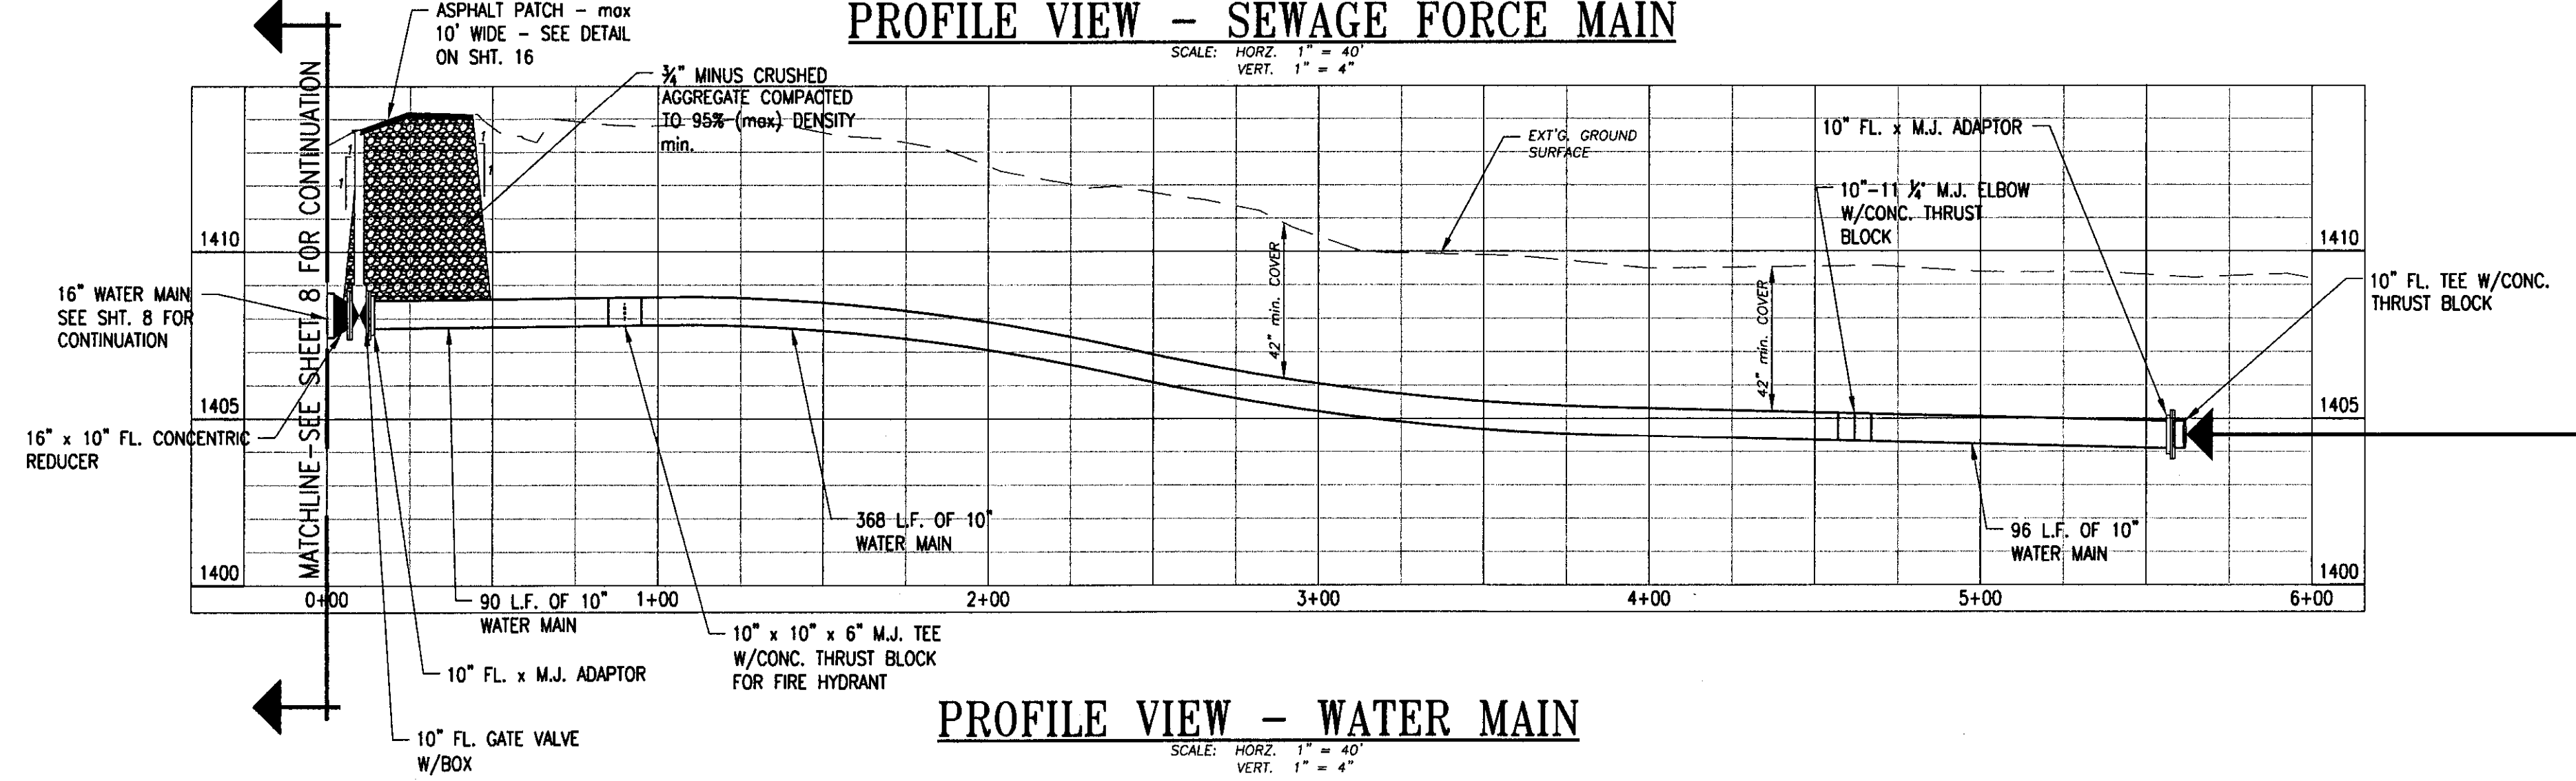

PROFILE VIEW - WATER MAIN
SCALE: HORIZ. 1" = 40' VERT. 1" = 4'

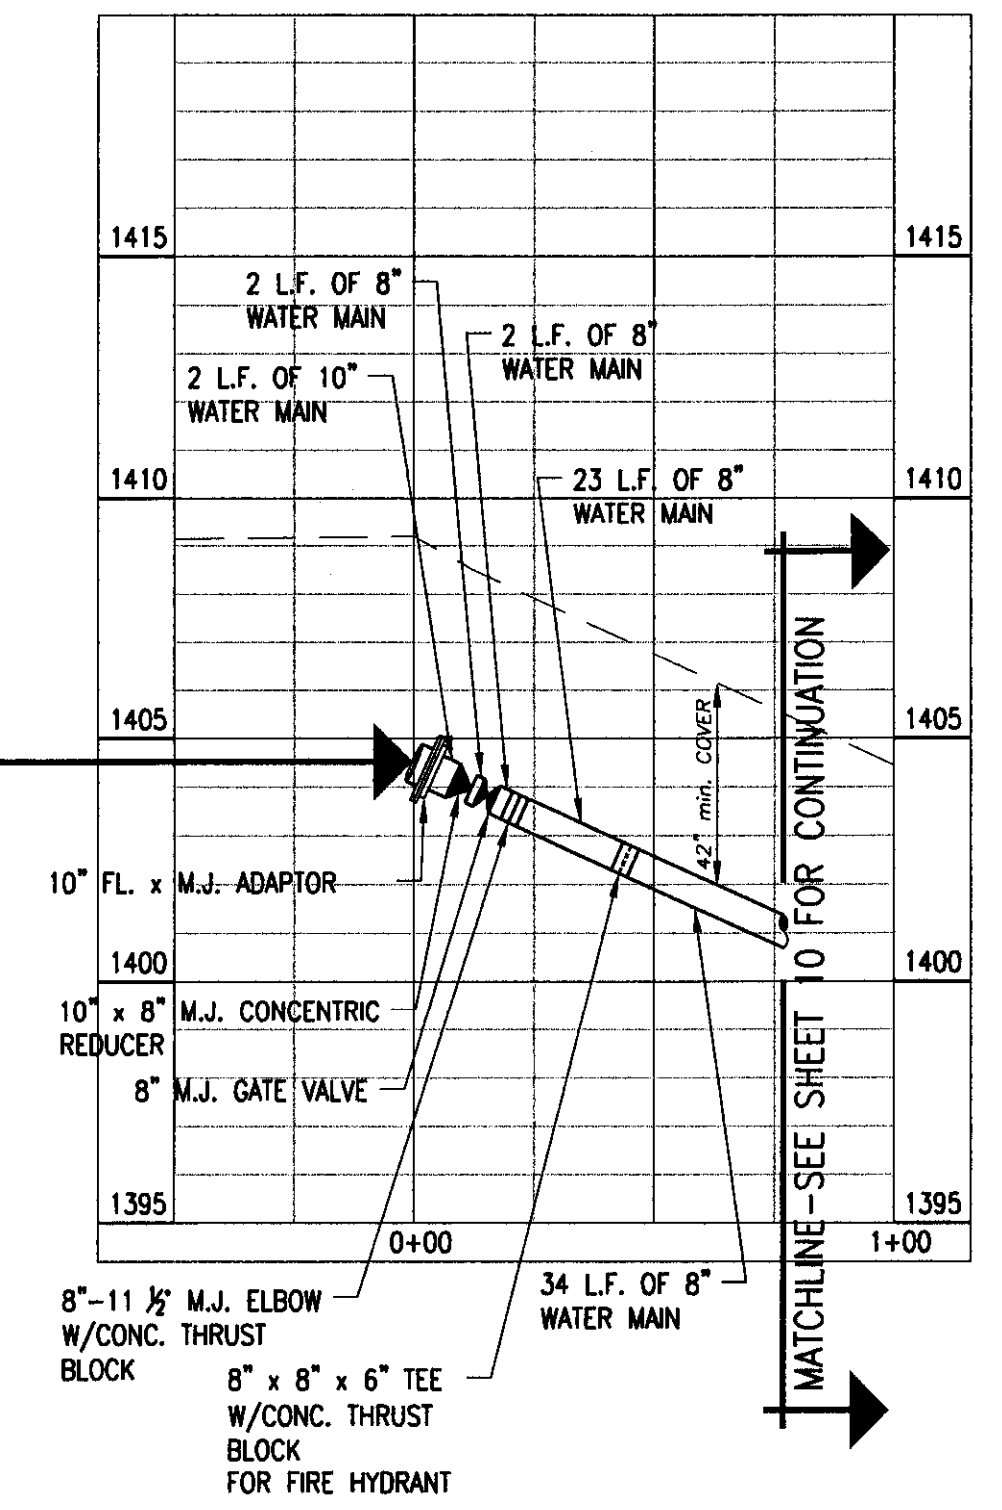

REVISIONS	
No.	DATE

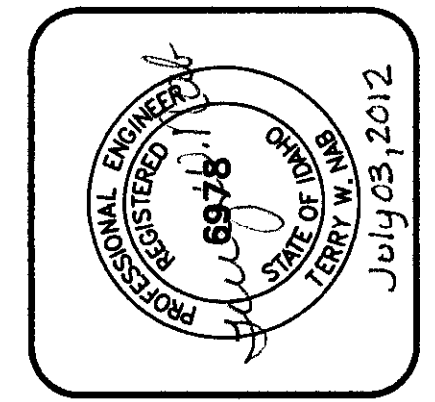

PROGRESSIVE ENGINEERING GROUP, INC
 DESIGN + CONSTRUCTION MANAGEMENT
 1508 IDAHO STREET, 85601
 LEWISTON, IDAHO FAX (208) 746-0406
 PH (208) 746-0406

D 2 J, INC.
 SOUTHPORT WATER MAIN EXTENSION
 AIRPOINTE BUSINESS PARK
 STA. 0+00 TO STA. 12+04
 LEWISTON, IDAHO 83501

DRAWN BY: WRE	CHECKED BY: TWN
DESIGNED BY: TWN	
DATE: 06/21/12	
LAST REV:	
PROJECT NO.: 08-005	
SHEET 9 OF 17	

RECORD DRAWING 06/21/12