

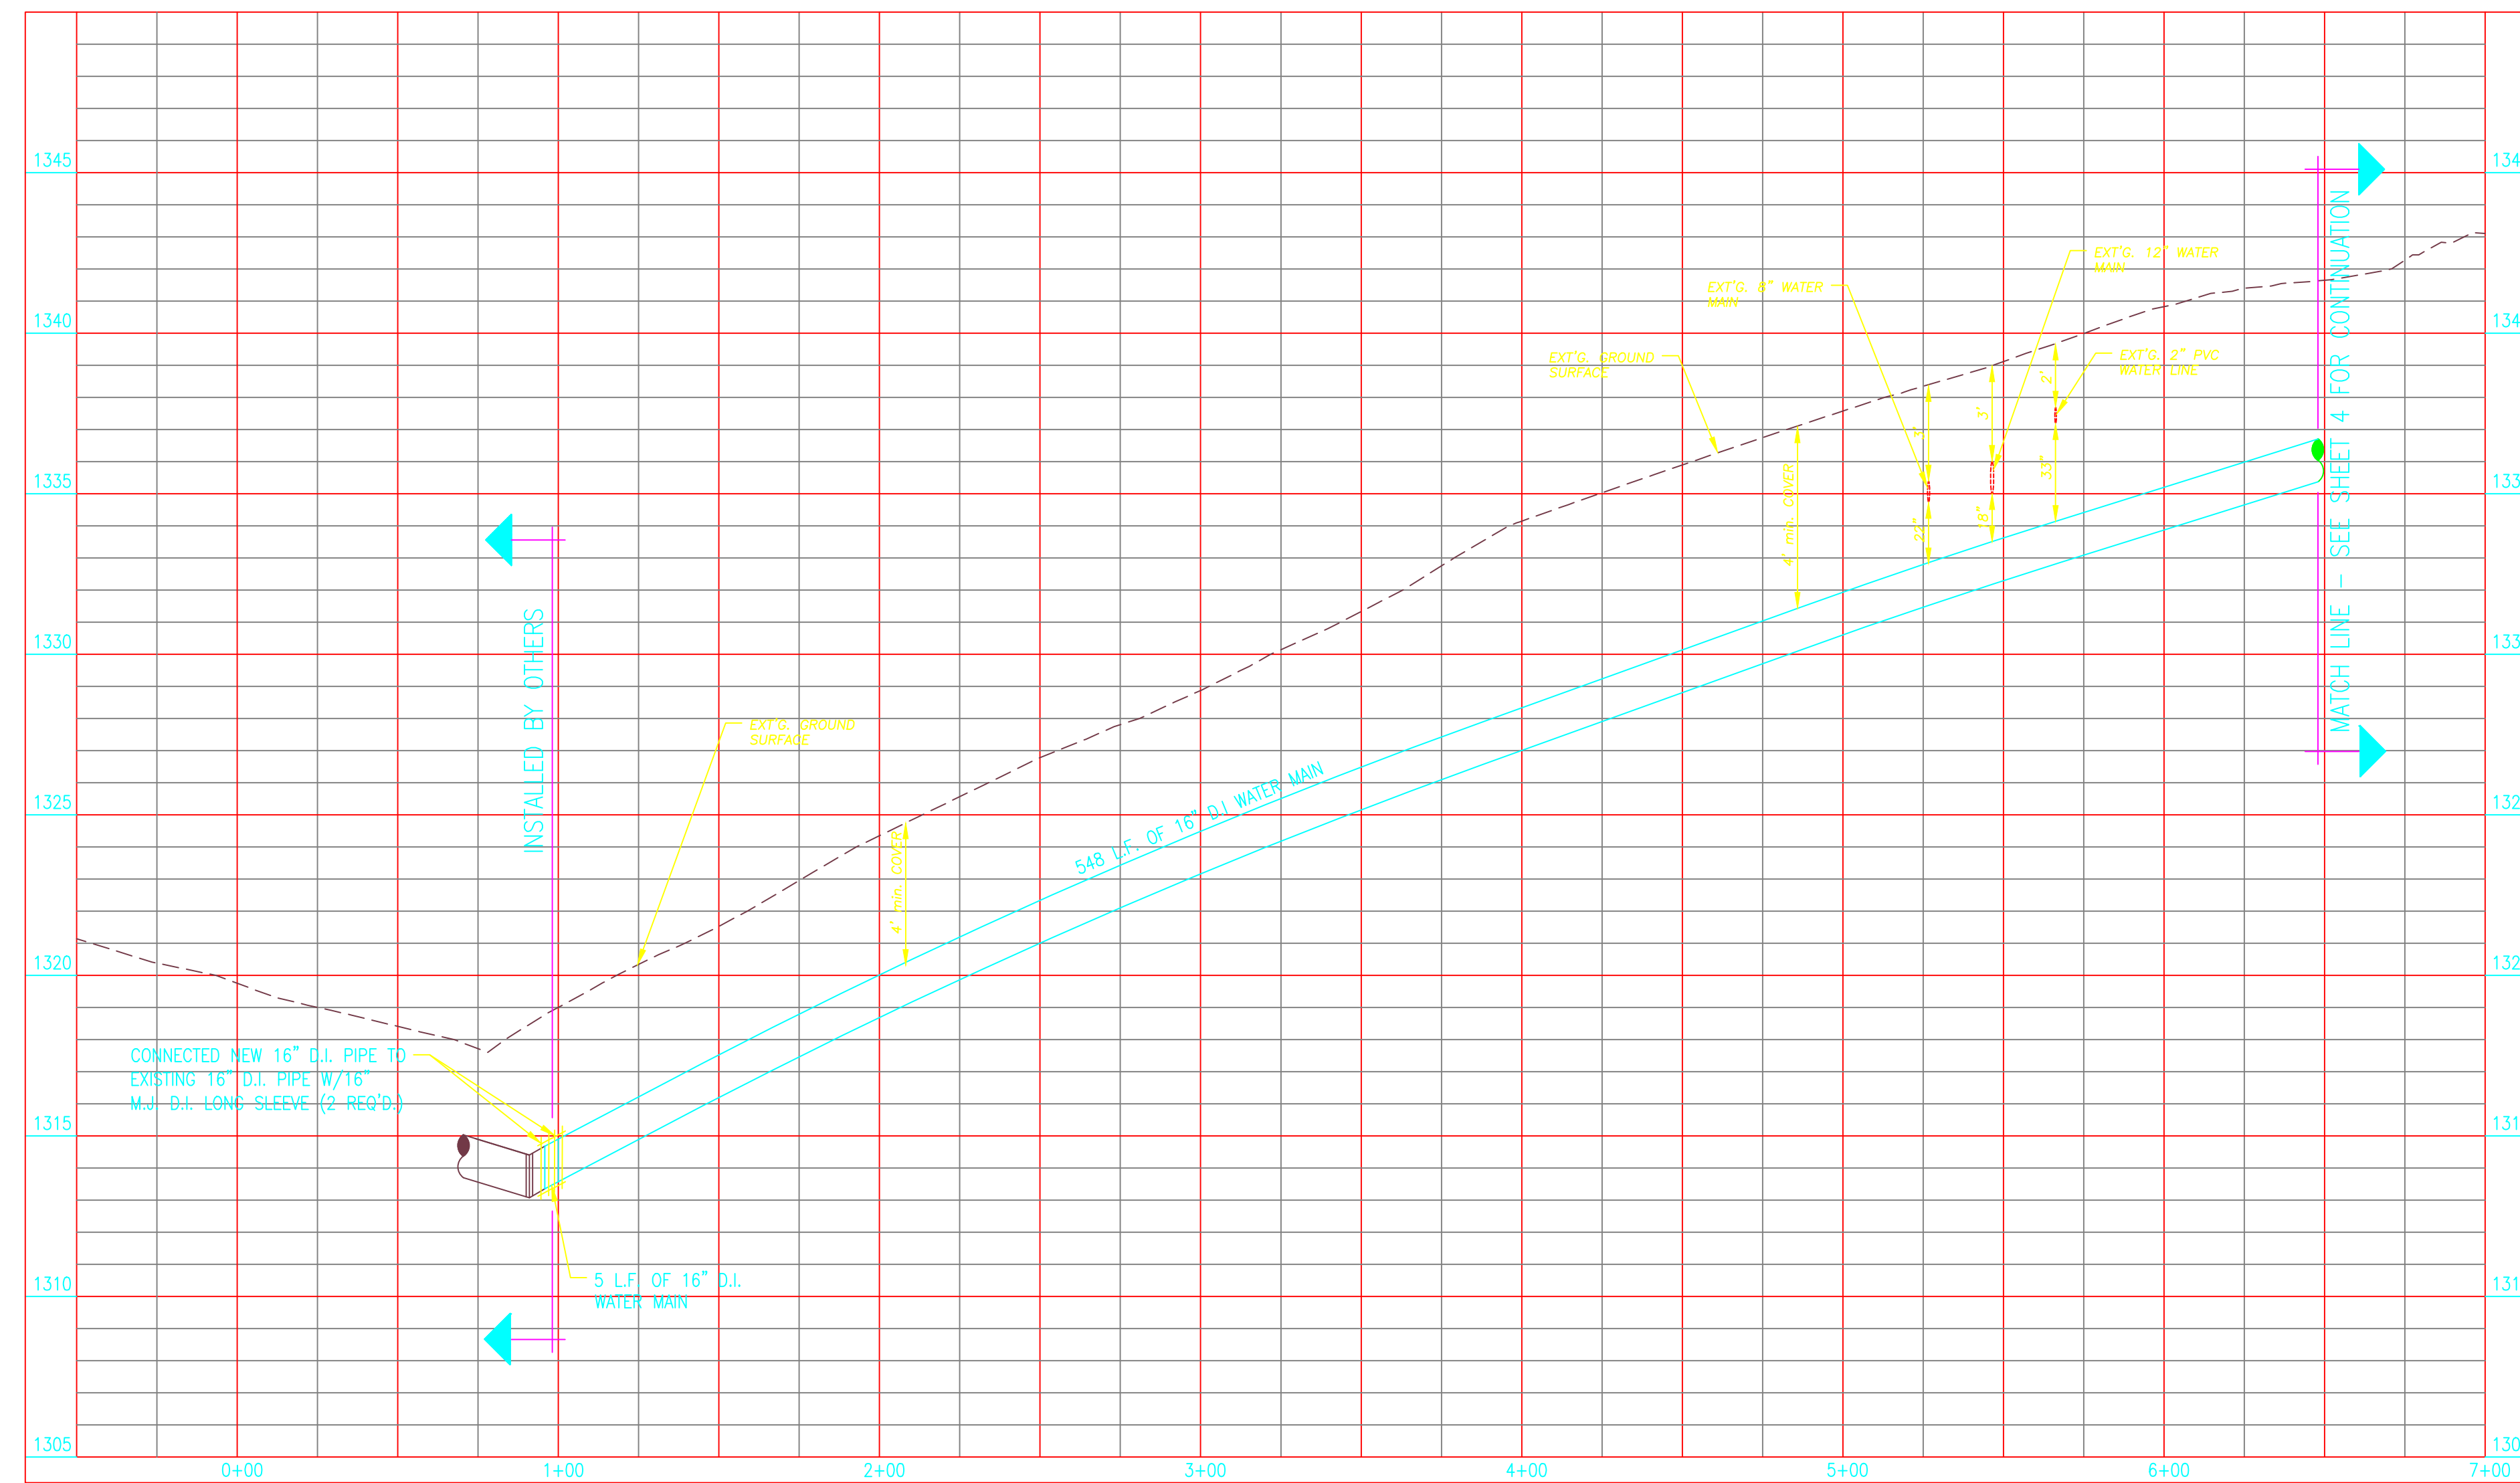


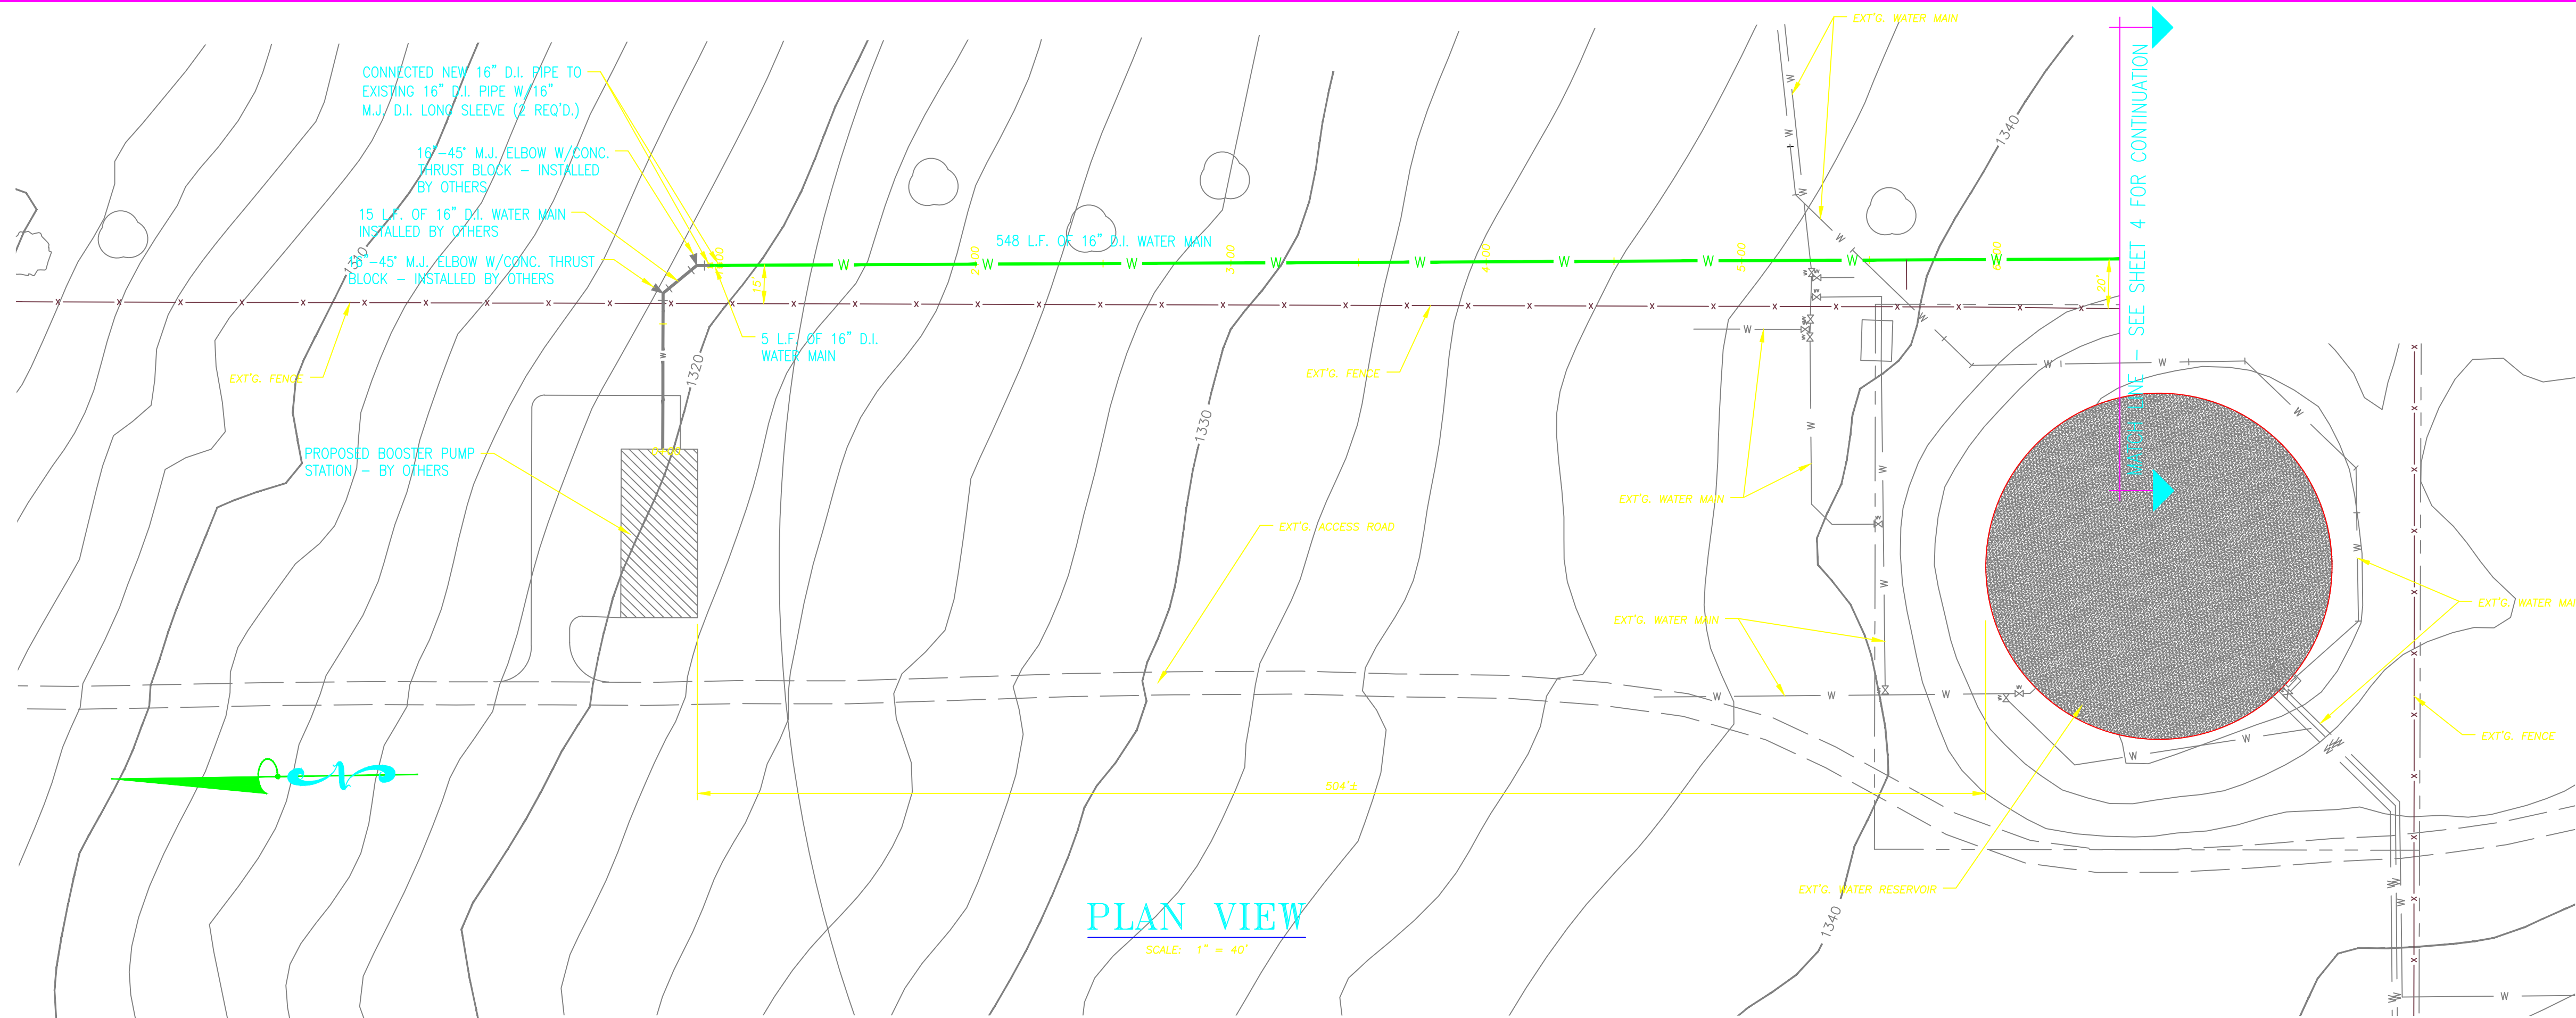

PROFILE VIEW
SCALE: HORIZONTAL 1" = 40'
VERTICAL 1" = 4'

RECORD DRAWING 01/12/12

REVISIONS		
NO.	DATE	BY

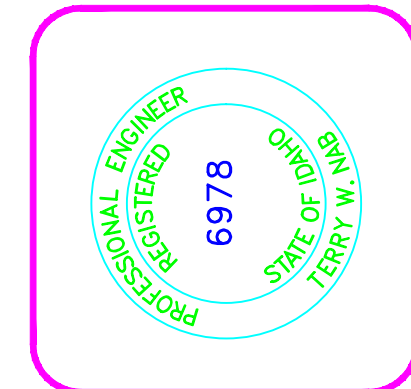

PROGRESSIVE
ENGINEERING GROUP, INC


PLANNING DESIGN CONSTRUCTION MANAGEMENT

1208 IDAHO STREET
LEWISTON, IDAHO 83501
PH (208) 746-5406 FAX (208) 746-8732


CITY OF LEWISTON

O'CONNOR ROAD WATER MAIN
PLAN AND PROFILE
STA. 0+58 TO STA. 6+48

DRAWN BY: VSR	CHECKED BY: TWN
DESIGNED BY: TWN	
DATE: 01/12/12	
LAST REV:	
PROJECT NO.: 09-025	
SHEET 3	OF 12

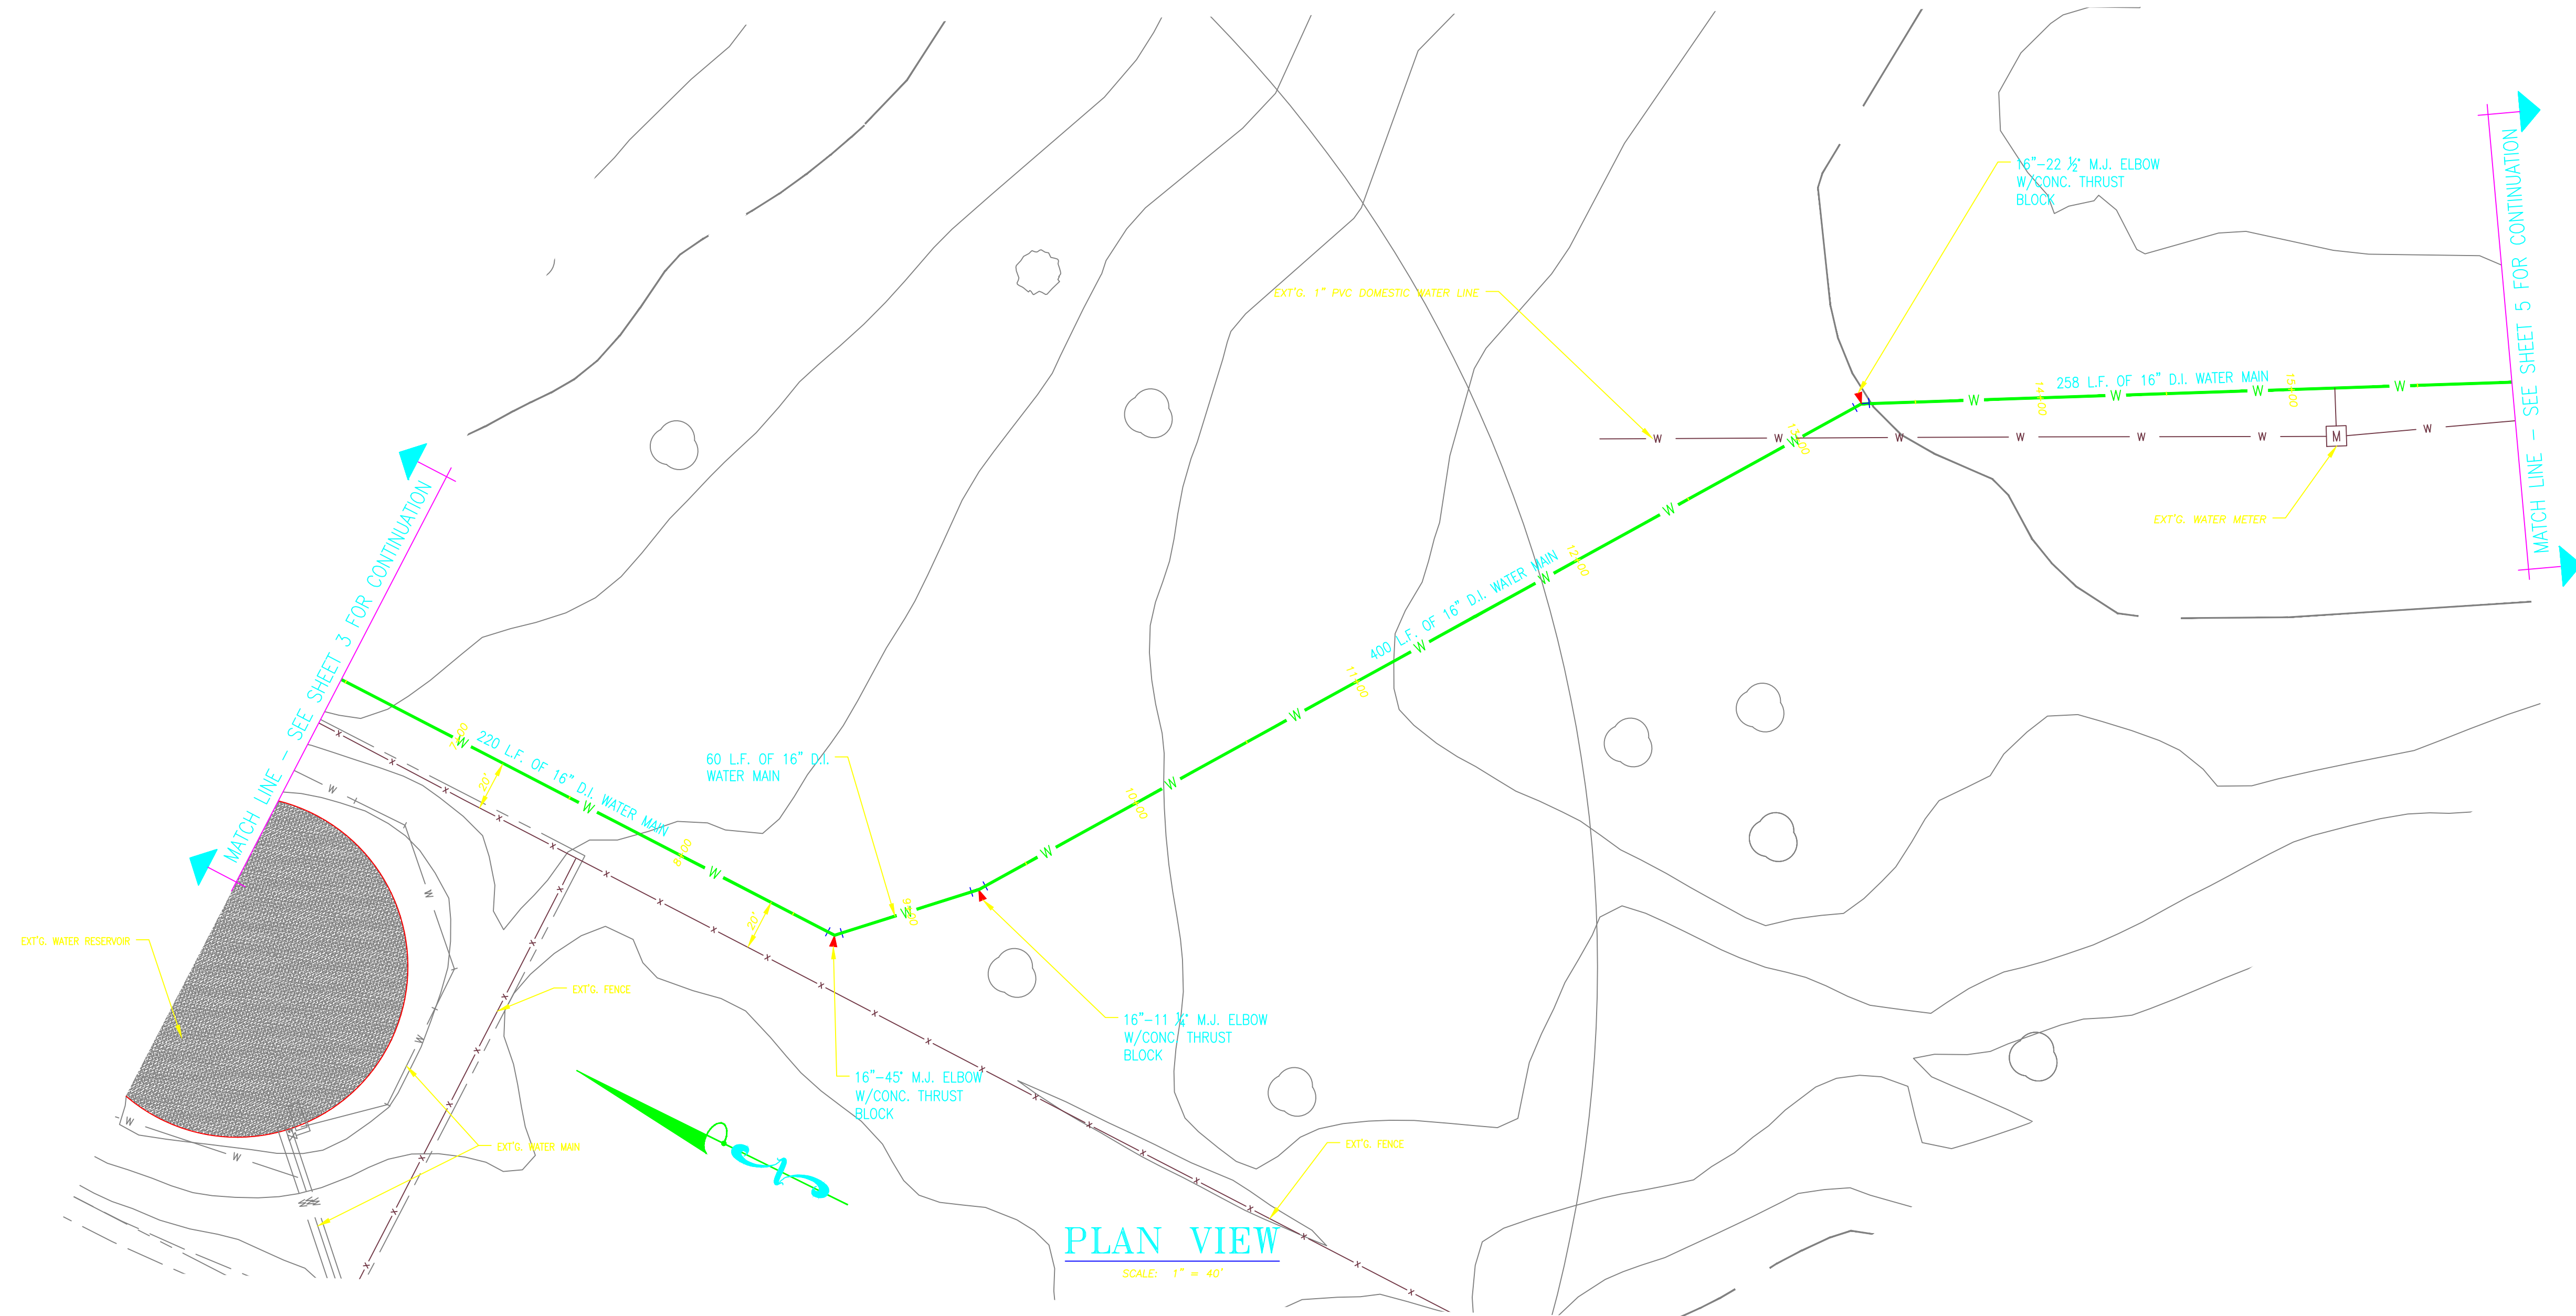


PLAN VIEW
SCALE: 1" = 40'

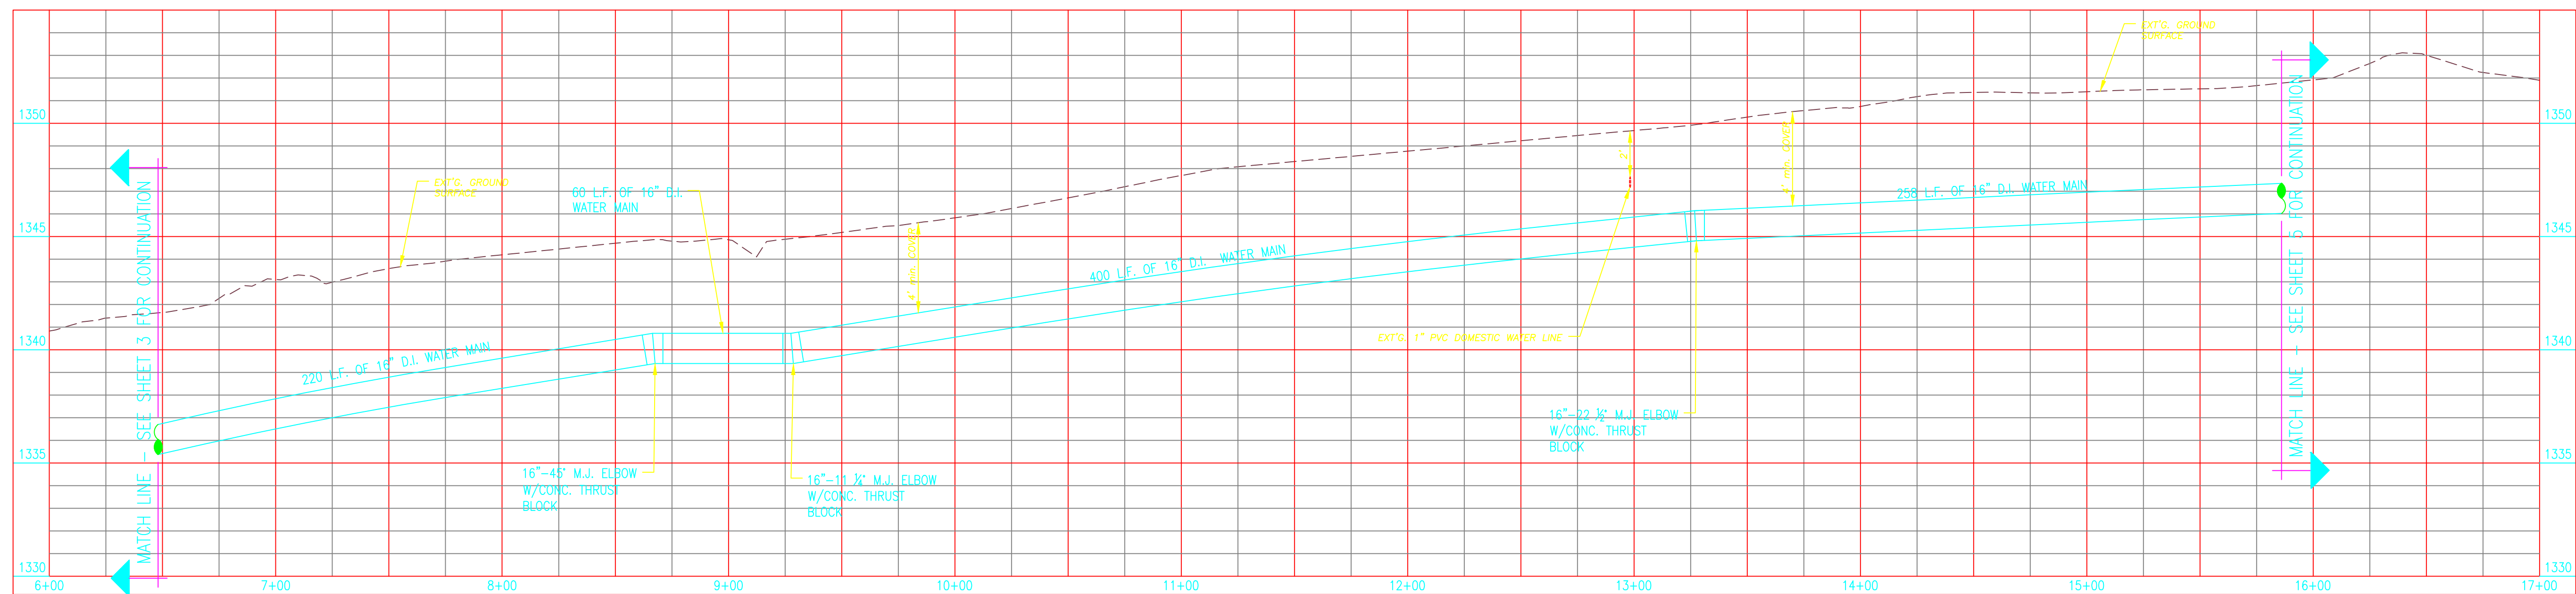

PROFILE VIEW
SCALE: HORIZONTAL 1" = 40'
VERTICAL 1" = 4'

RECORD DRAWING 01/12/12

REVISIONS	
NO.	DATE BY

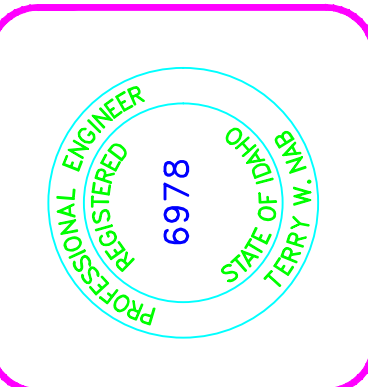



PROGRESSIVE
ENGINEERING GROUP, INC

PLANNING DESIGN + CONSTRUCTION MANAGEMENT

1208 IDAHO STREET
LEWISTON, IDAHO 83501
P/E (208) 746-5406 FAX (208) 746-9732

CITY OF LEWISTON
O'CONNOR ROAD WATER MAIN
PLAN AND PROFILE
STA. 6+48 TO STA. 15+86

DRAWN BY: MSR	CHECKED BY: TWN
DESIGNED BY: TWN	DATE: 01/12/12
LAST REV:	PROJECT NO: 09-025
SHEET 4	OF 12

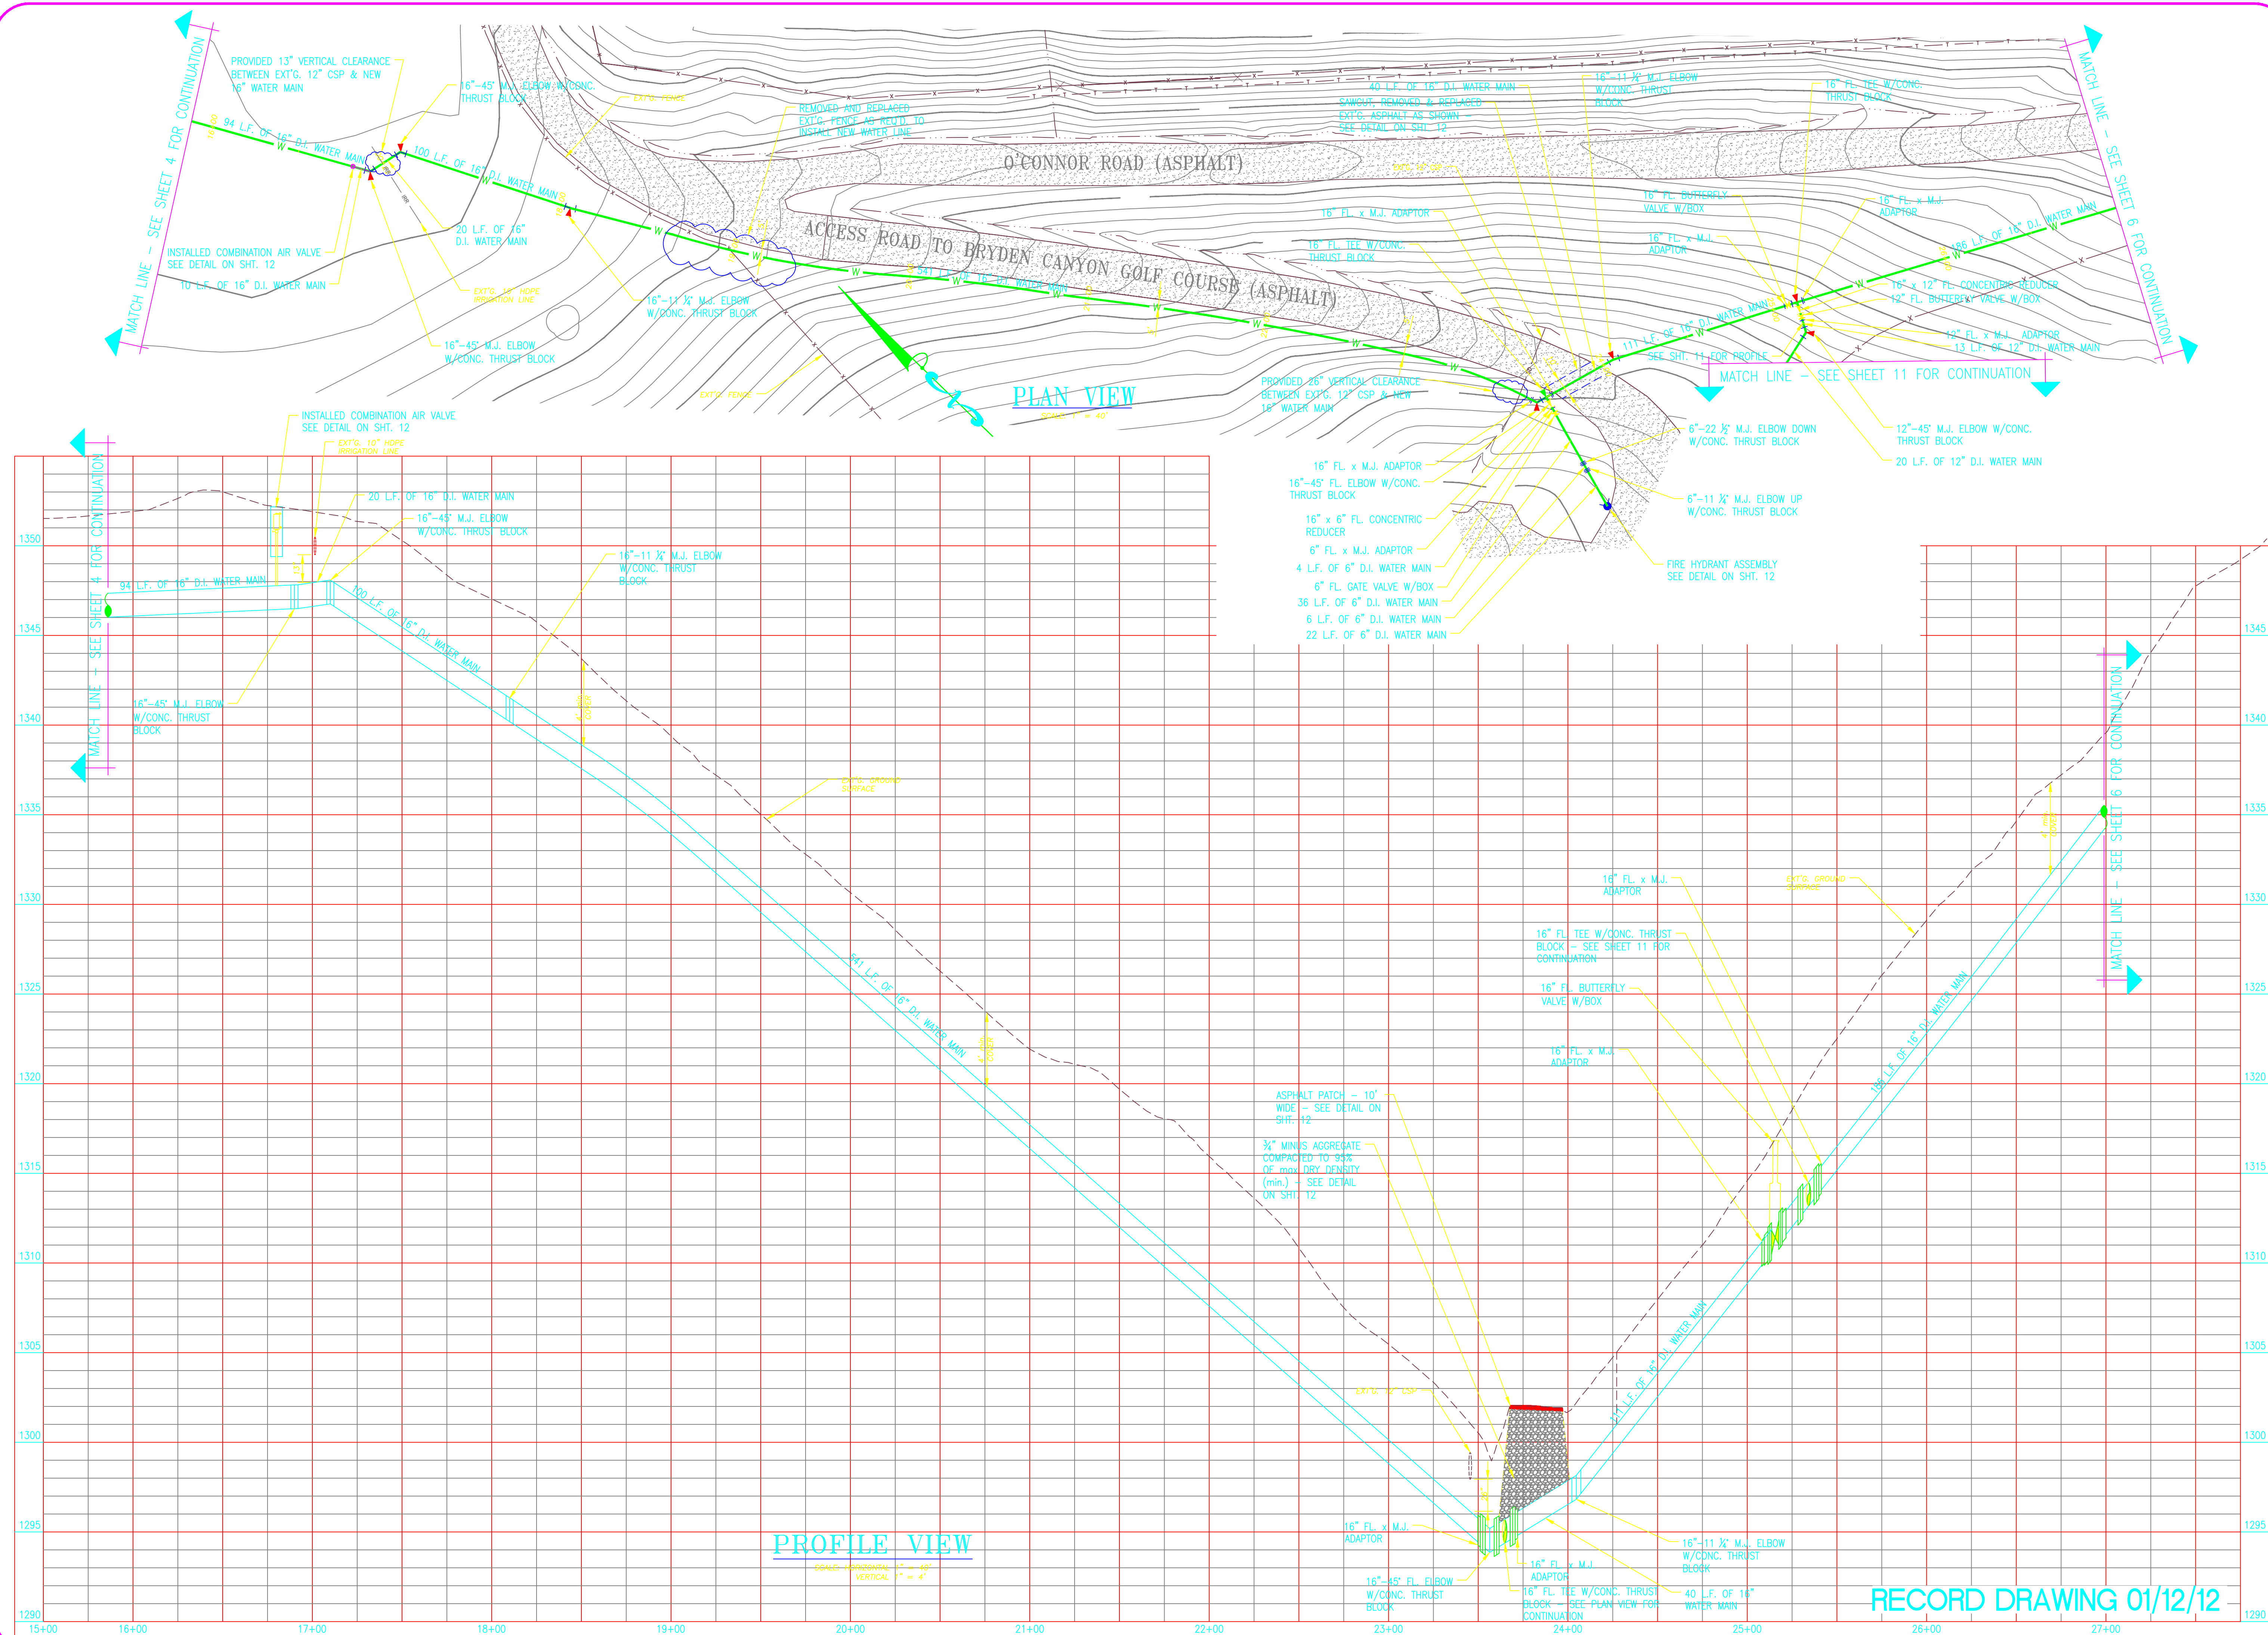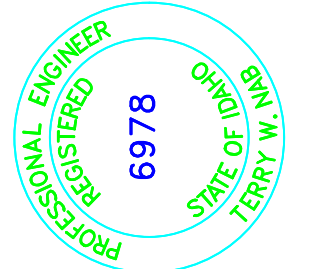[illegible]

**PROGRESSIVE
ENGINEERING GROUP, INC.**



 **PLANNING**  **DESIGN**  **CONSTRUCTION MANAGEMENT**

1208 IDAHO STREET
LEWISTON, IDAHO 83501
PH (208) 746-5406 FAX (208) 746-9732

 **Small logo**

CITY OF LEWISTON
O'CONNOR ROAD WATER MAIN
PLAN AND PROFILE
STA. 15+86 TO STA. 26+99

DRAWN BY: MSR	CHECKED BY: TWN
DESIGNED BY: TWN	
DATE: 01/12/12	
LAST REV:	
PROJECT NO.: 09-025	
SHEET 5 OF 12	

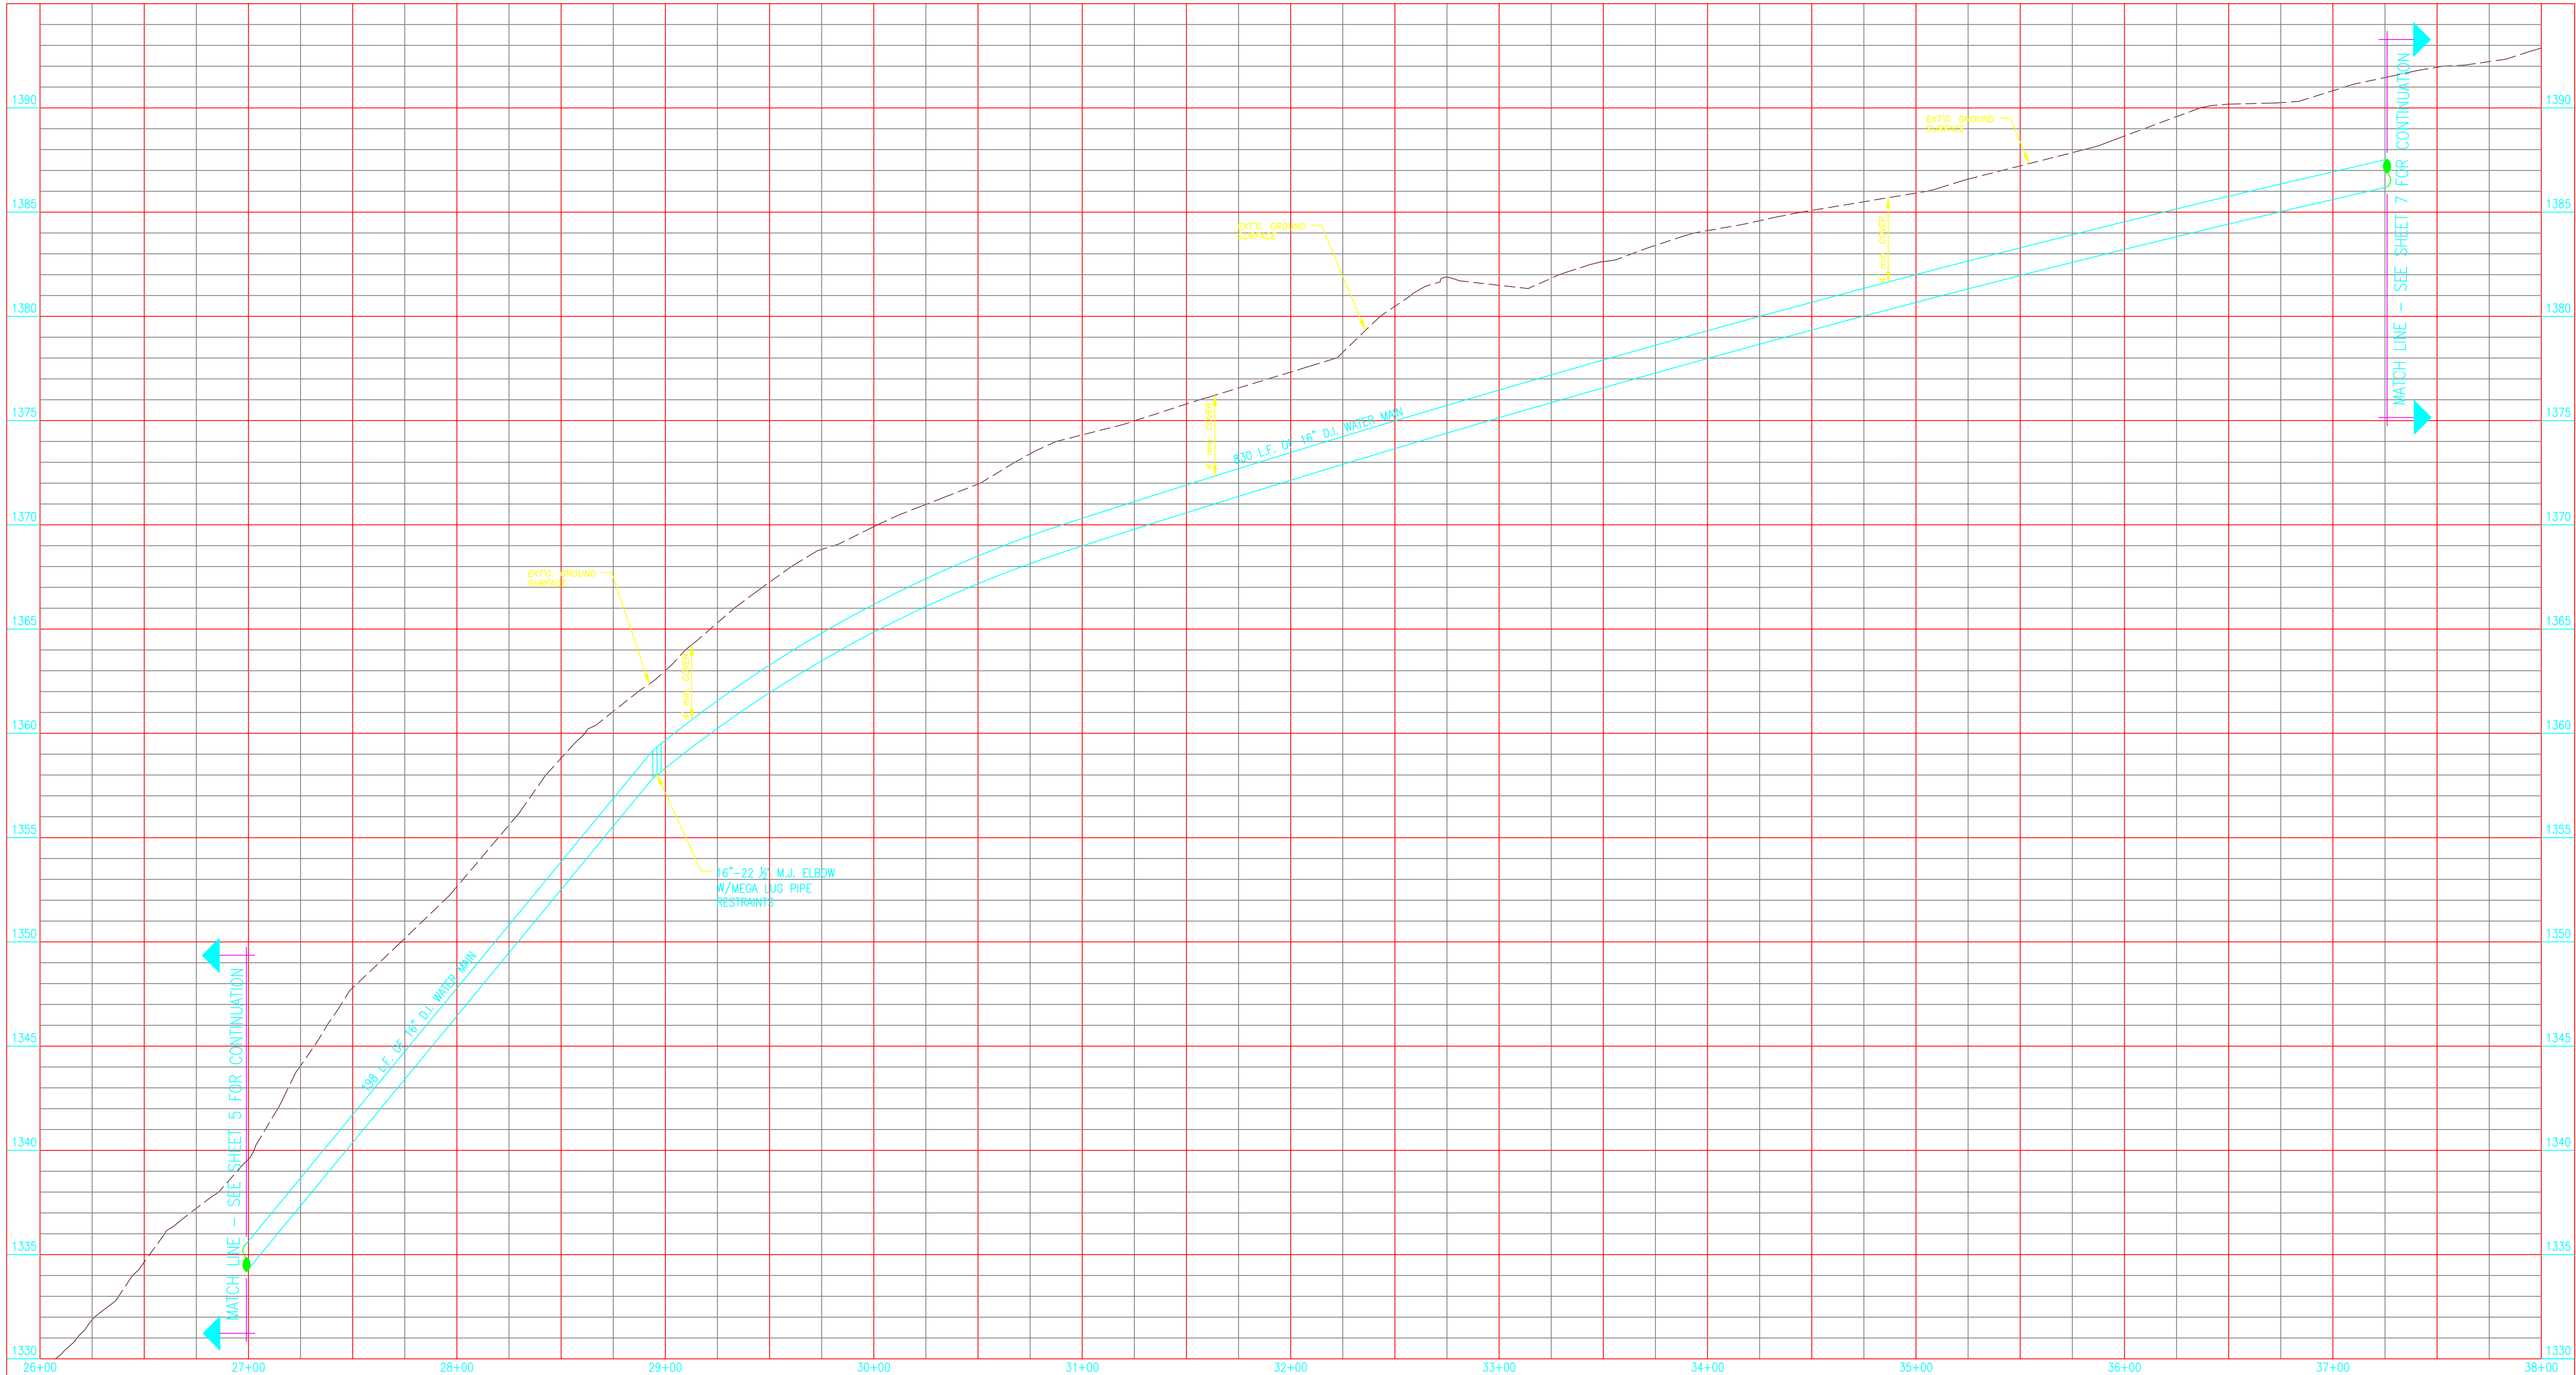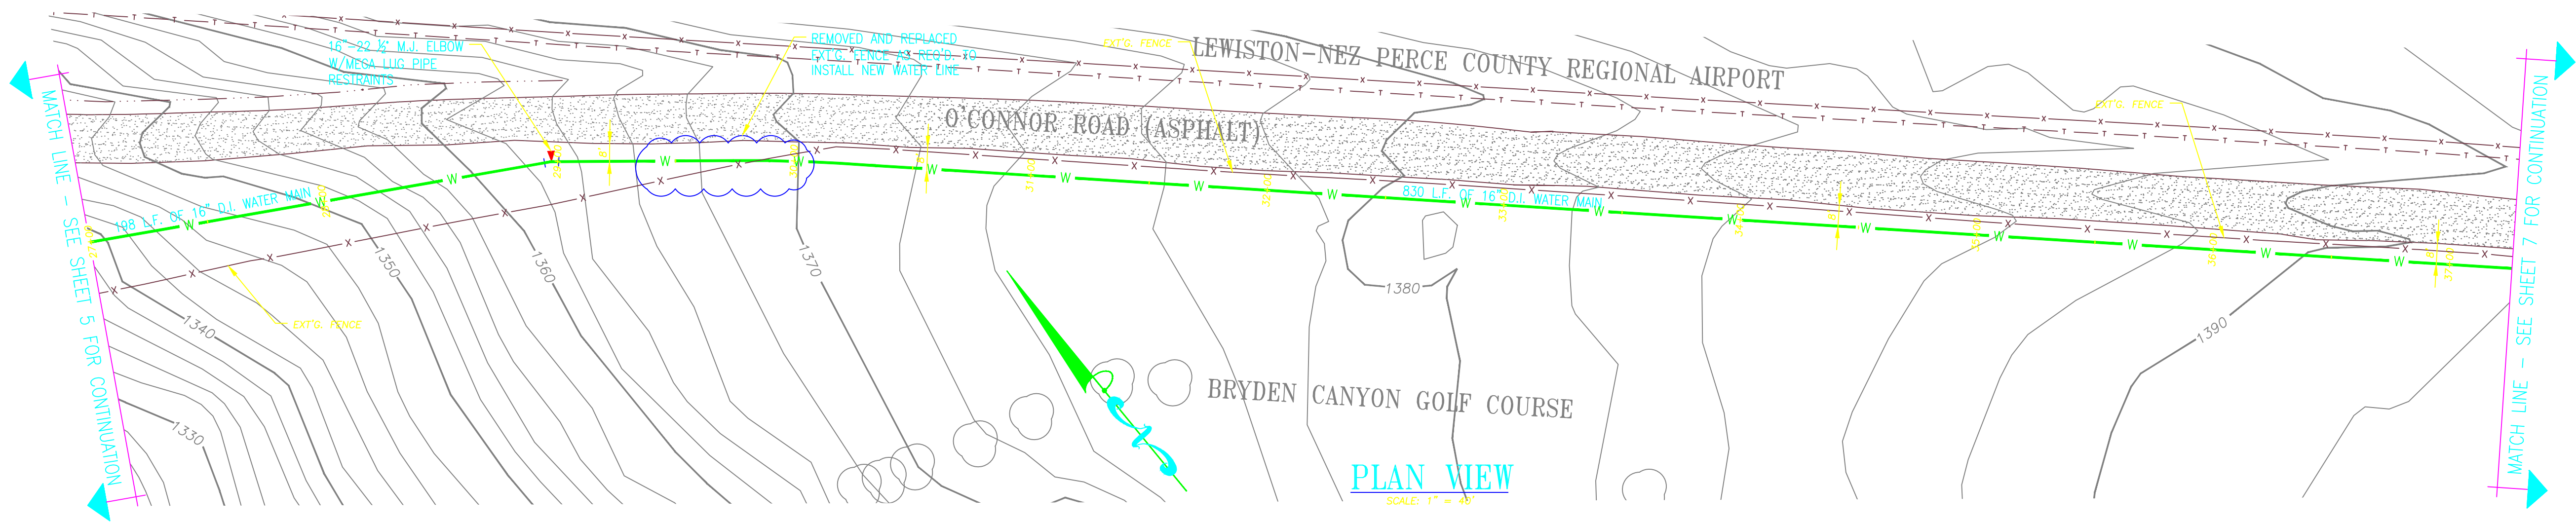


PROFILE VIEW

SCALE: HORIZONTAL 1" = 40'
VERTICAL 1" = 4'

RECORD DRAWING 01/12/12

REVISIONS		
NO.	DATE	BY

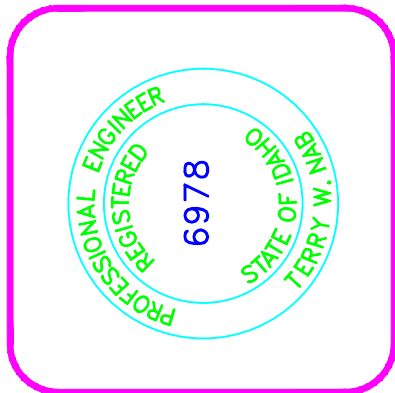

PROGRESSIVE
ENGINEERING GROUP, INC

PLANNING DESIGN CONSTRUCTION MANAGEMENT



1208 IDAHO STREET
LEWISTON, IDAHO 83501
PH (208) 746-5406 FAX (208) 746-8732

CITY OF LEWISTON

O'CONNOR ROAD WATER MAIN
PLAN AND PROFILE

STA. 26+99 TO STA. 37+26

DRAWN BY: VSR	CHECKED BY: TWN
DESIGNED BY: TWN	
DATE: 01/12/12	
LAST REV:	
PROJECT NO.: 09-025	
SHEET 6	OF 12

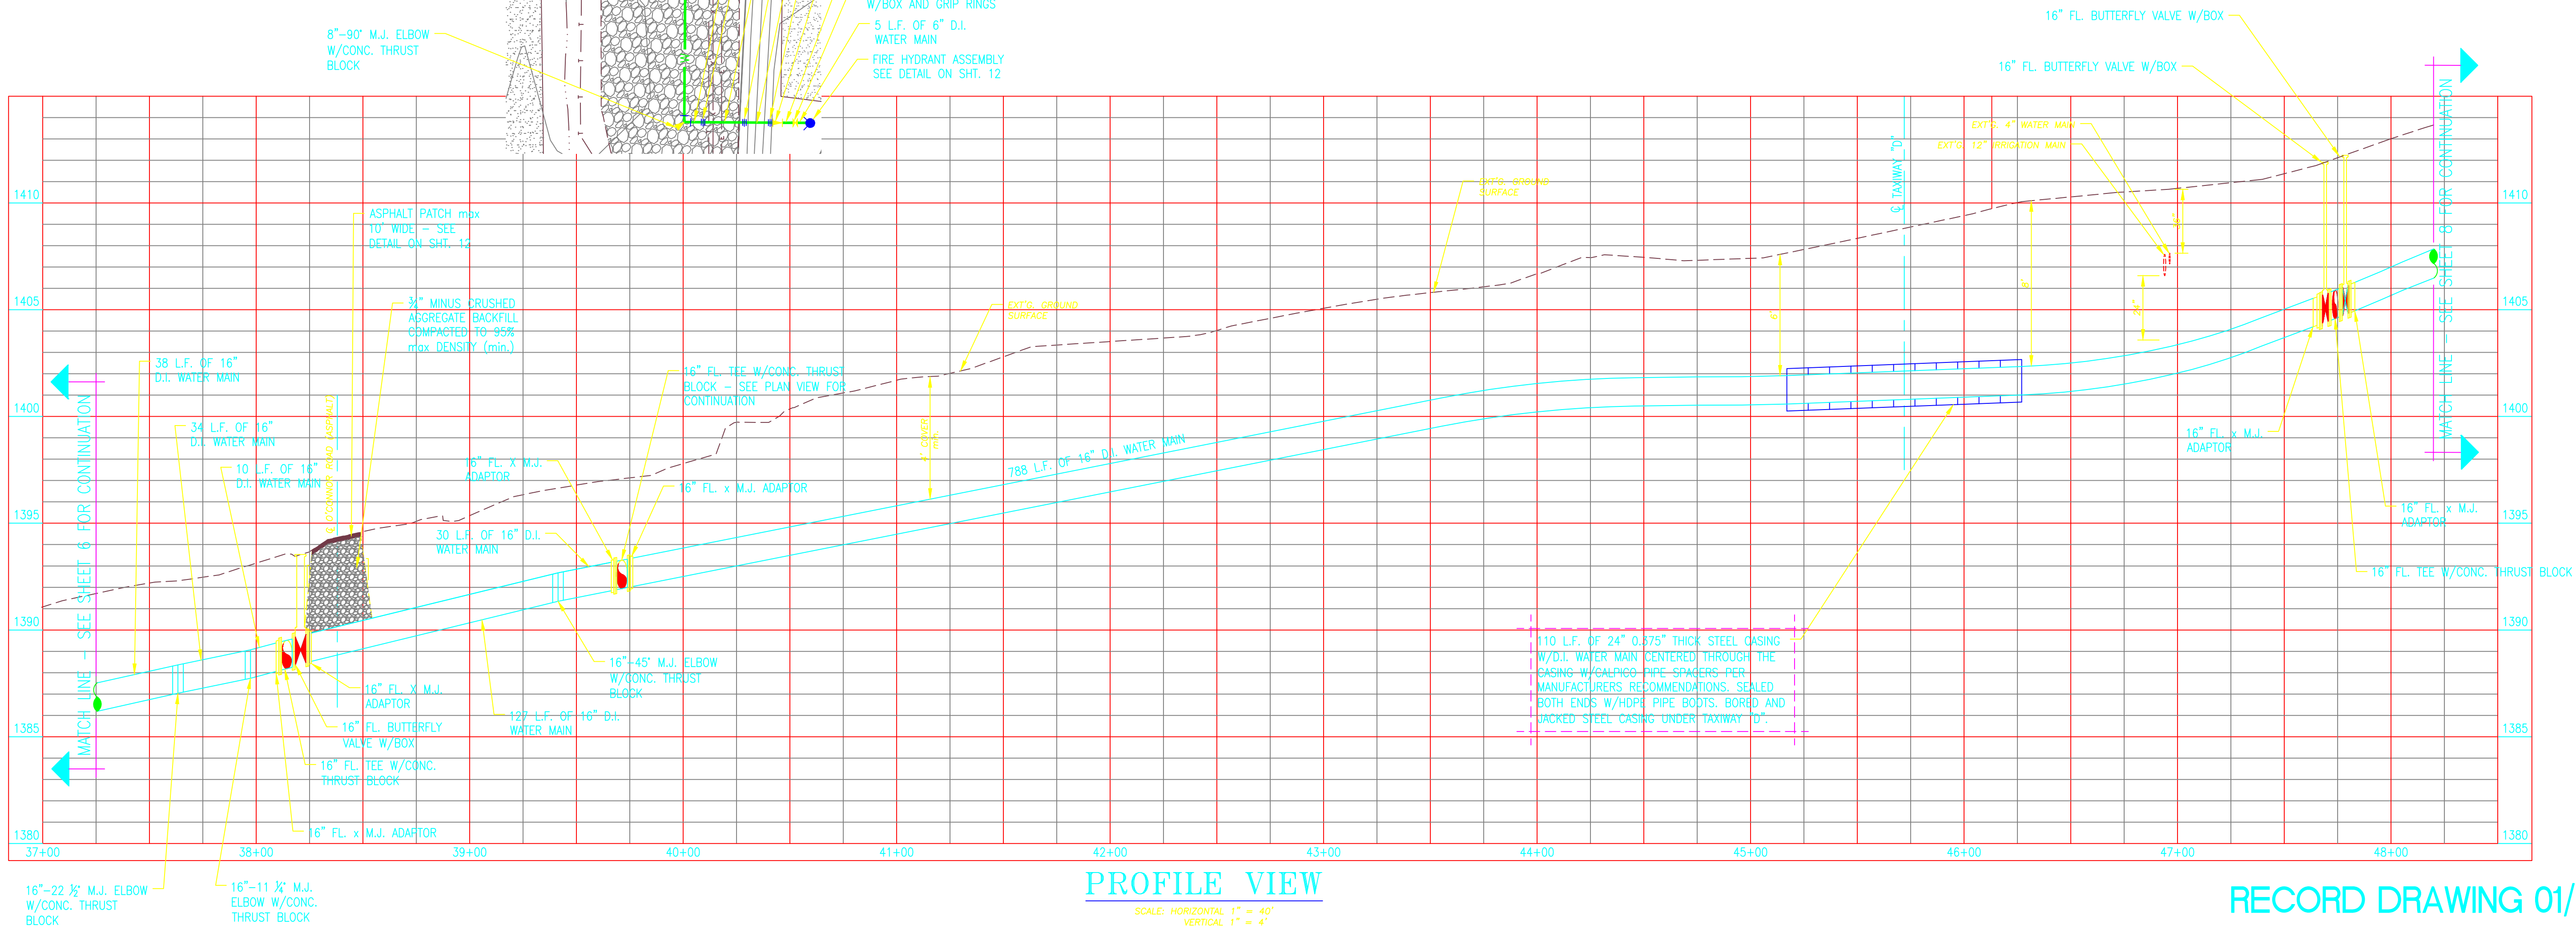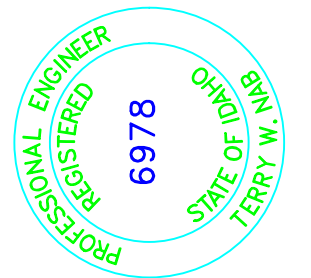[illegible]






PROGRESSIVE
ENGINEERING GROUP, INC.

1208 IDAHO STREET
LEWISTON, IDAHO 83501
PH (208) 746-5406 FAX (208) 746-9732

CITY OF LEWISTON
O'CONNOR ROAD WATER MAIN
PLAN AND PROFILE
STA. 37+26 TO STA. 47+57

DRAWN BY: MSR	CHECKED BY: TWN
DESIGNED BY: TWN	
DATE: 01/12/12	
LAST REV:	
PROJECT NO.: 09-025	
SHEET 7 OF 12	

RECORD DRAWING 01/12/12

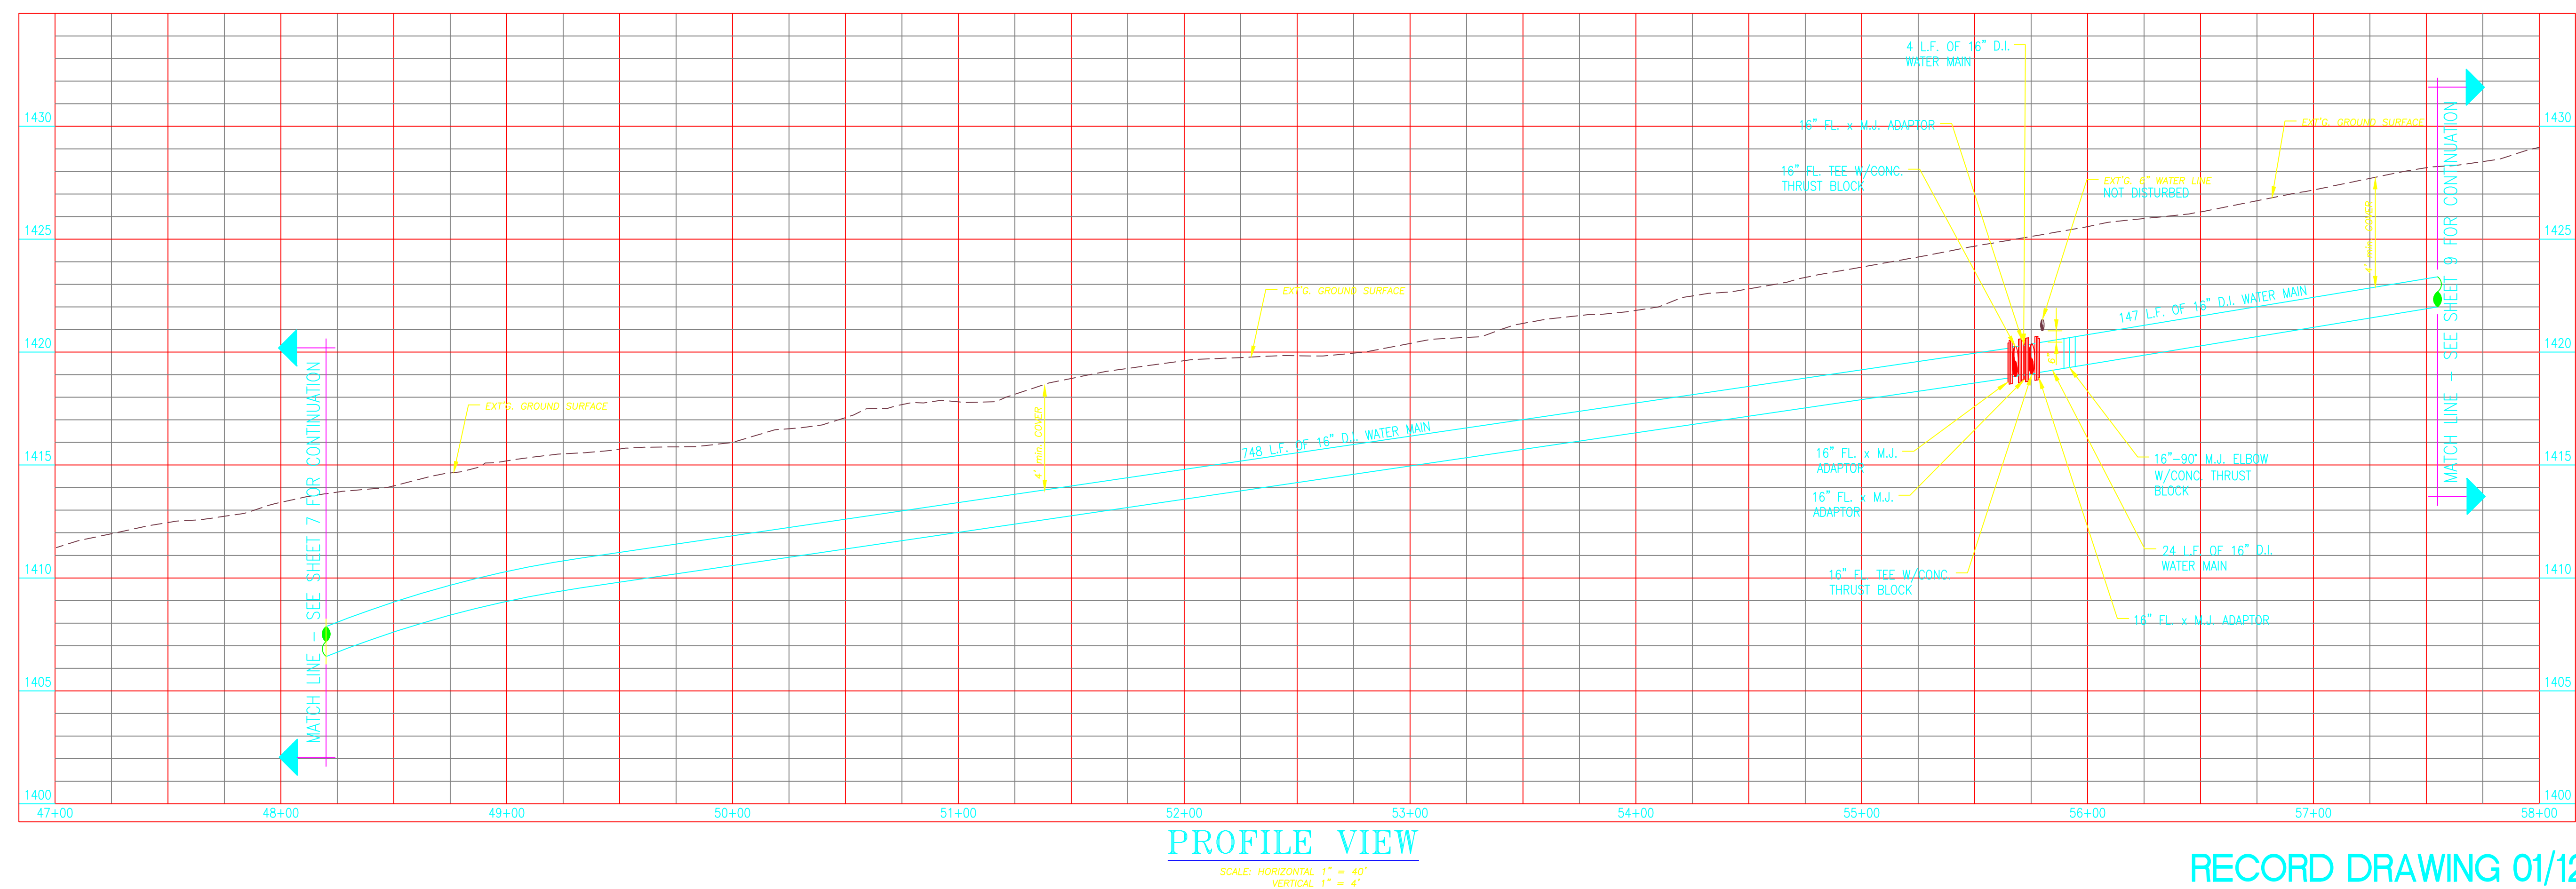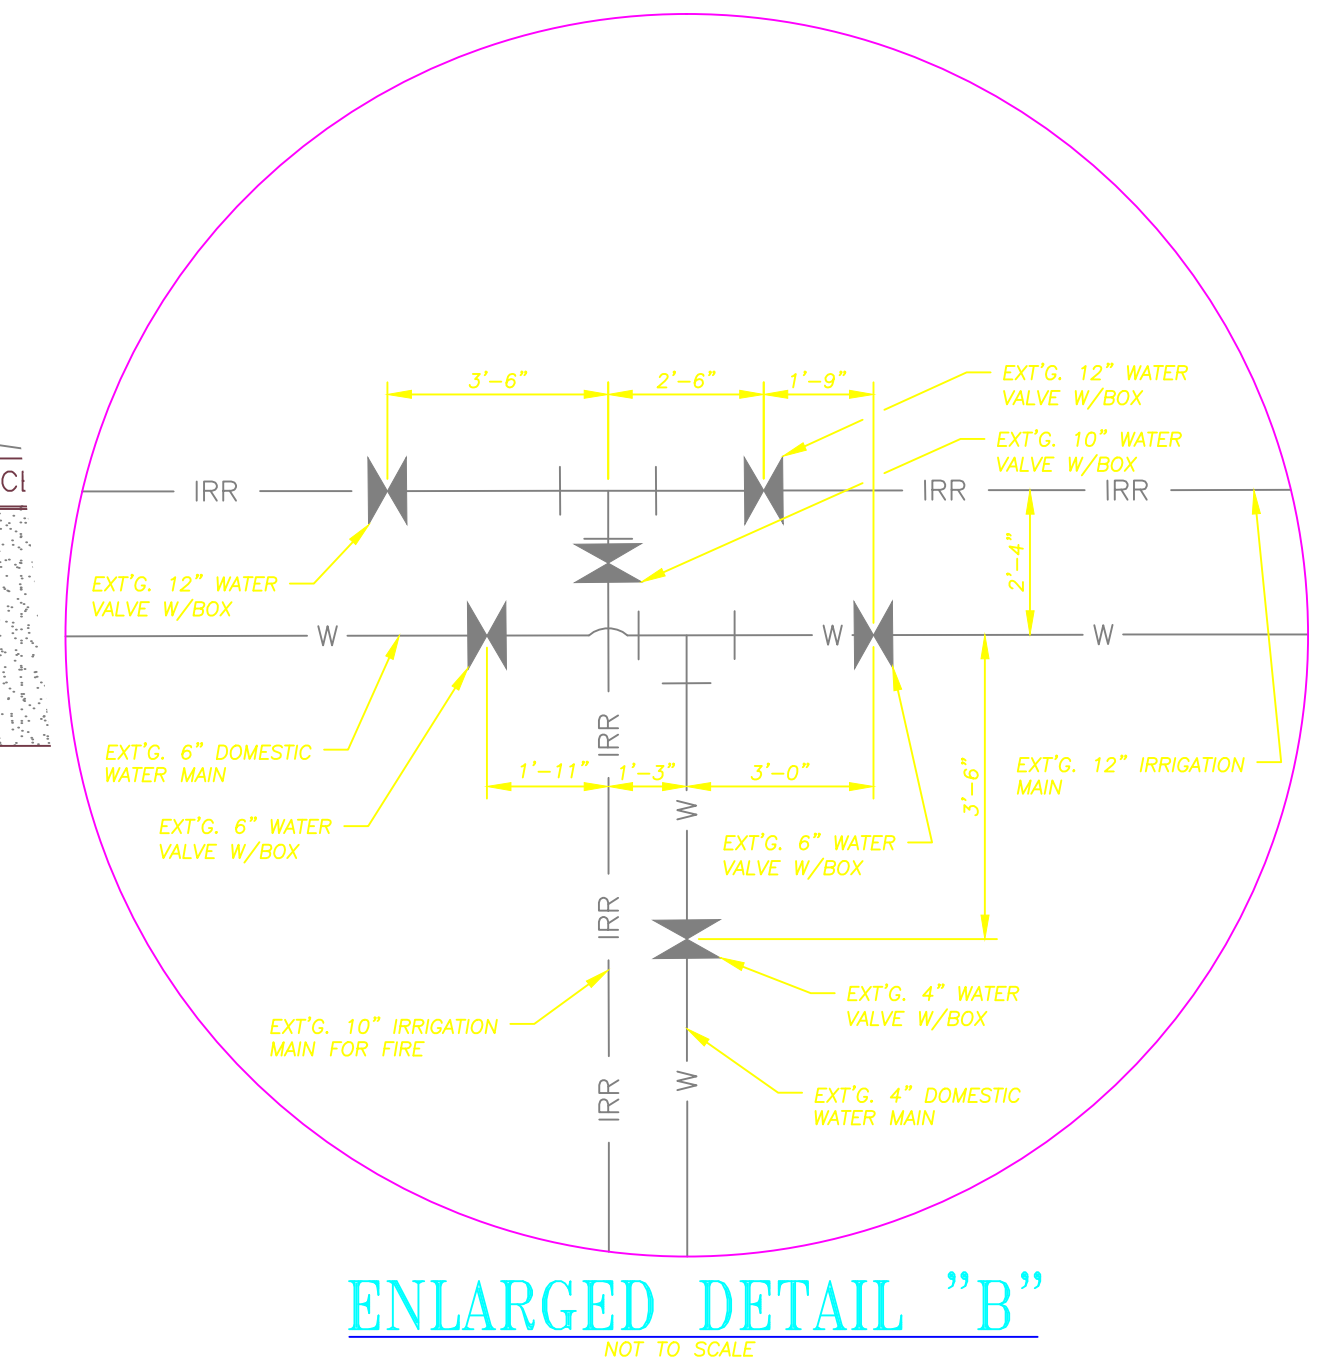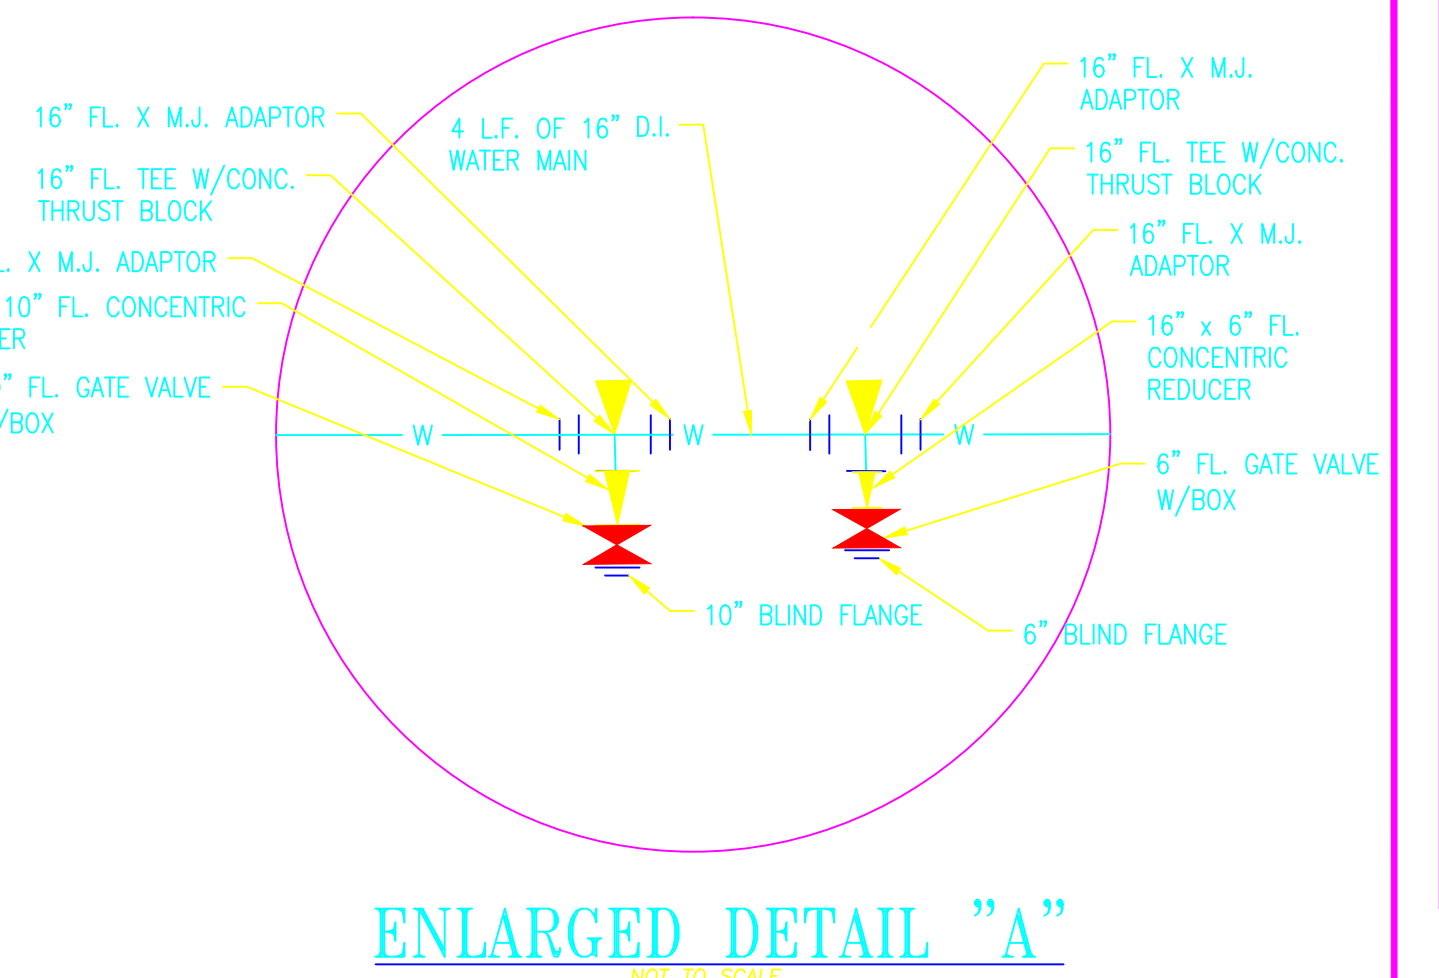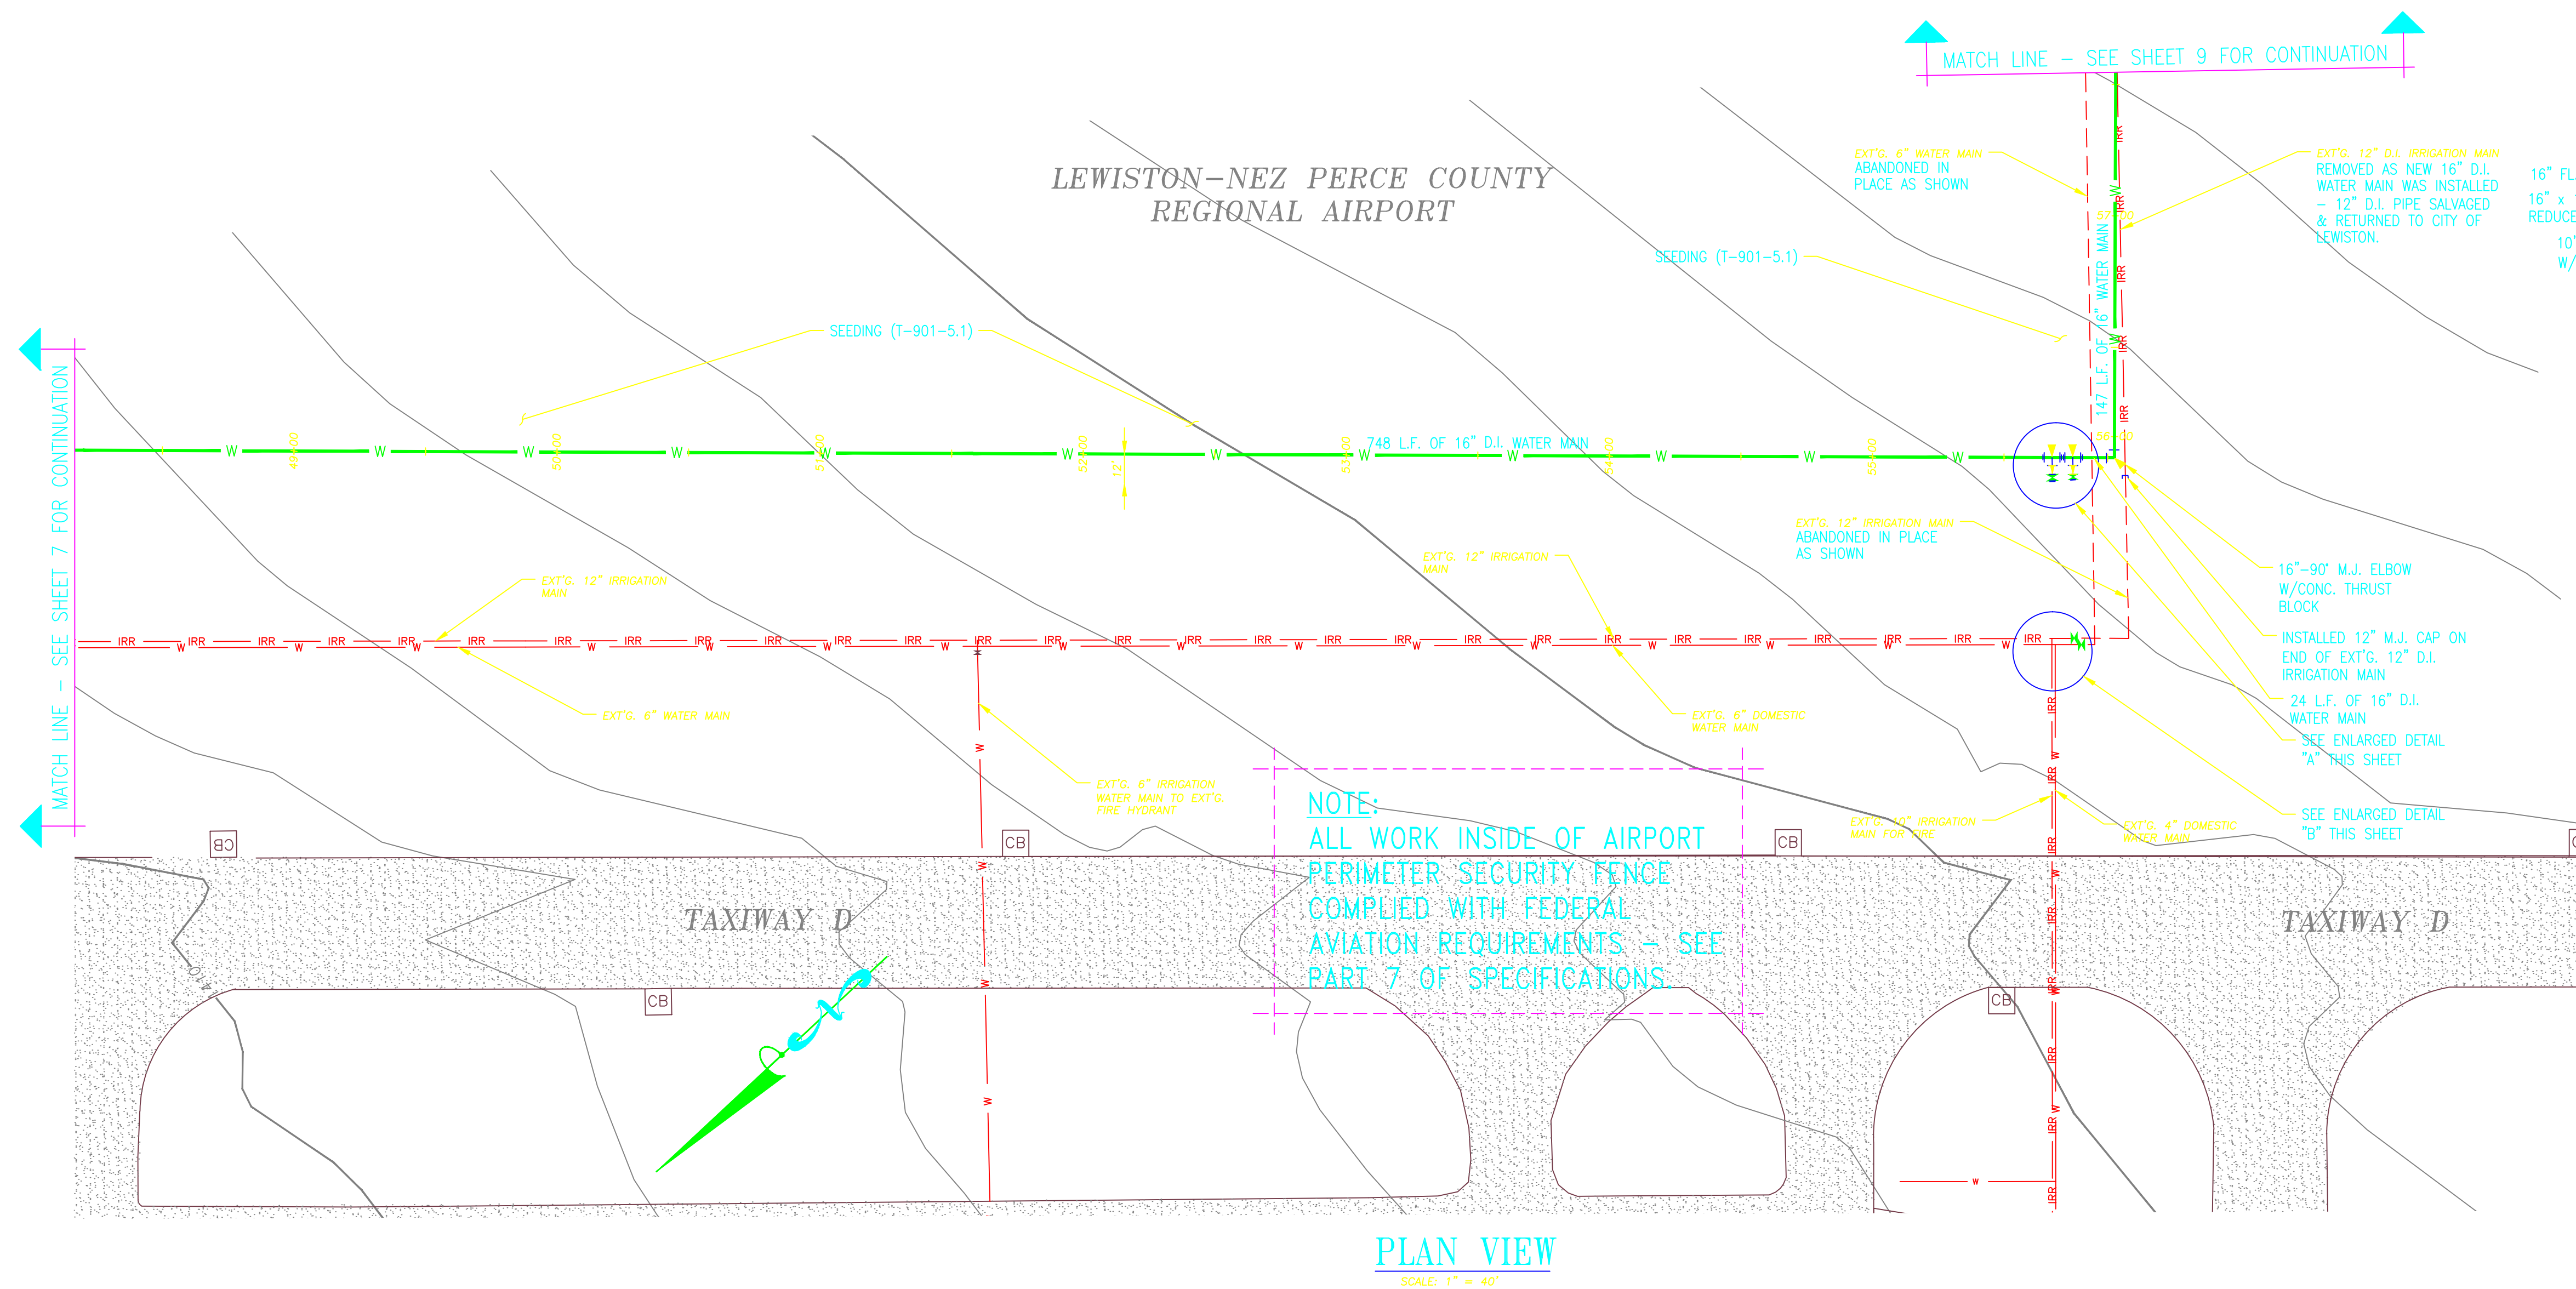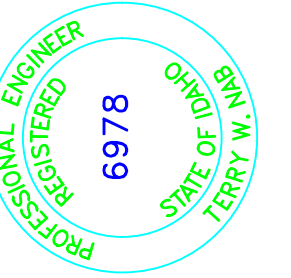[illegible]

PROGRESSIVE
ENGINEERING GROUP, INC


PLANNING DESIGN + CONSTRUCTION MANAGEMENT

1000 ITALIC COMPANY


1208 IDAHO STREET
LEWISTON, IDAHO 83501
PH (208) 746-5406 FAX (208) 746-9732

O'CONNOR ROAD WATER MAIN
PLAN AND PROFILE
STA. 47+57 TO STA. 57+57

OWN BY: MSR	CHECKED BY: TWN
DESIGNED BY: TWN	
DATE: 01/12/12	
REVIEW:	
PROJECT NO.: 09-025	
SHEET 8 OF 12	

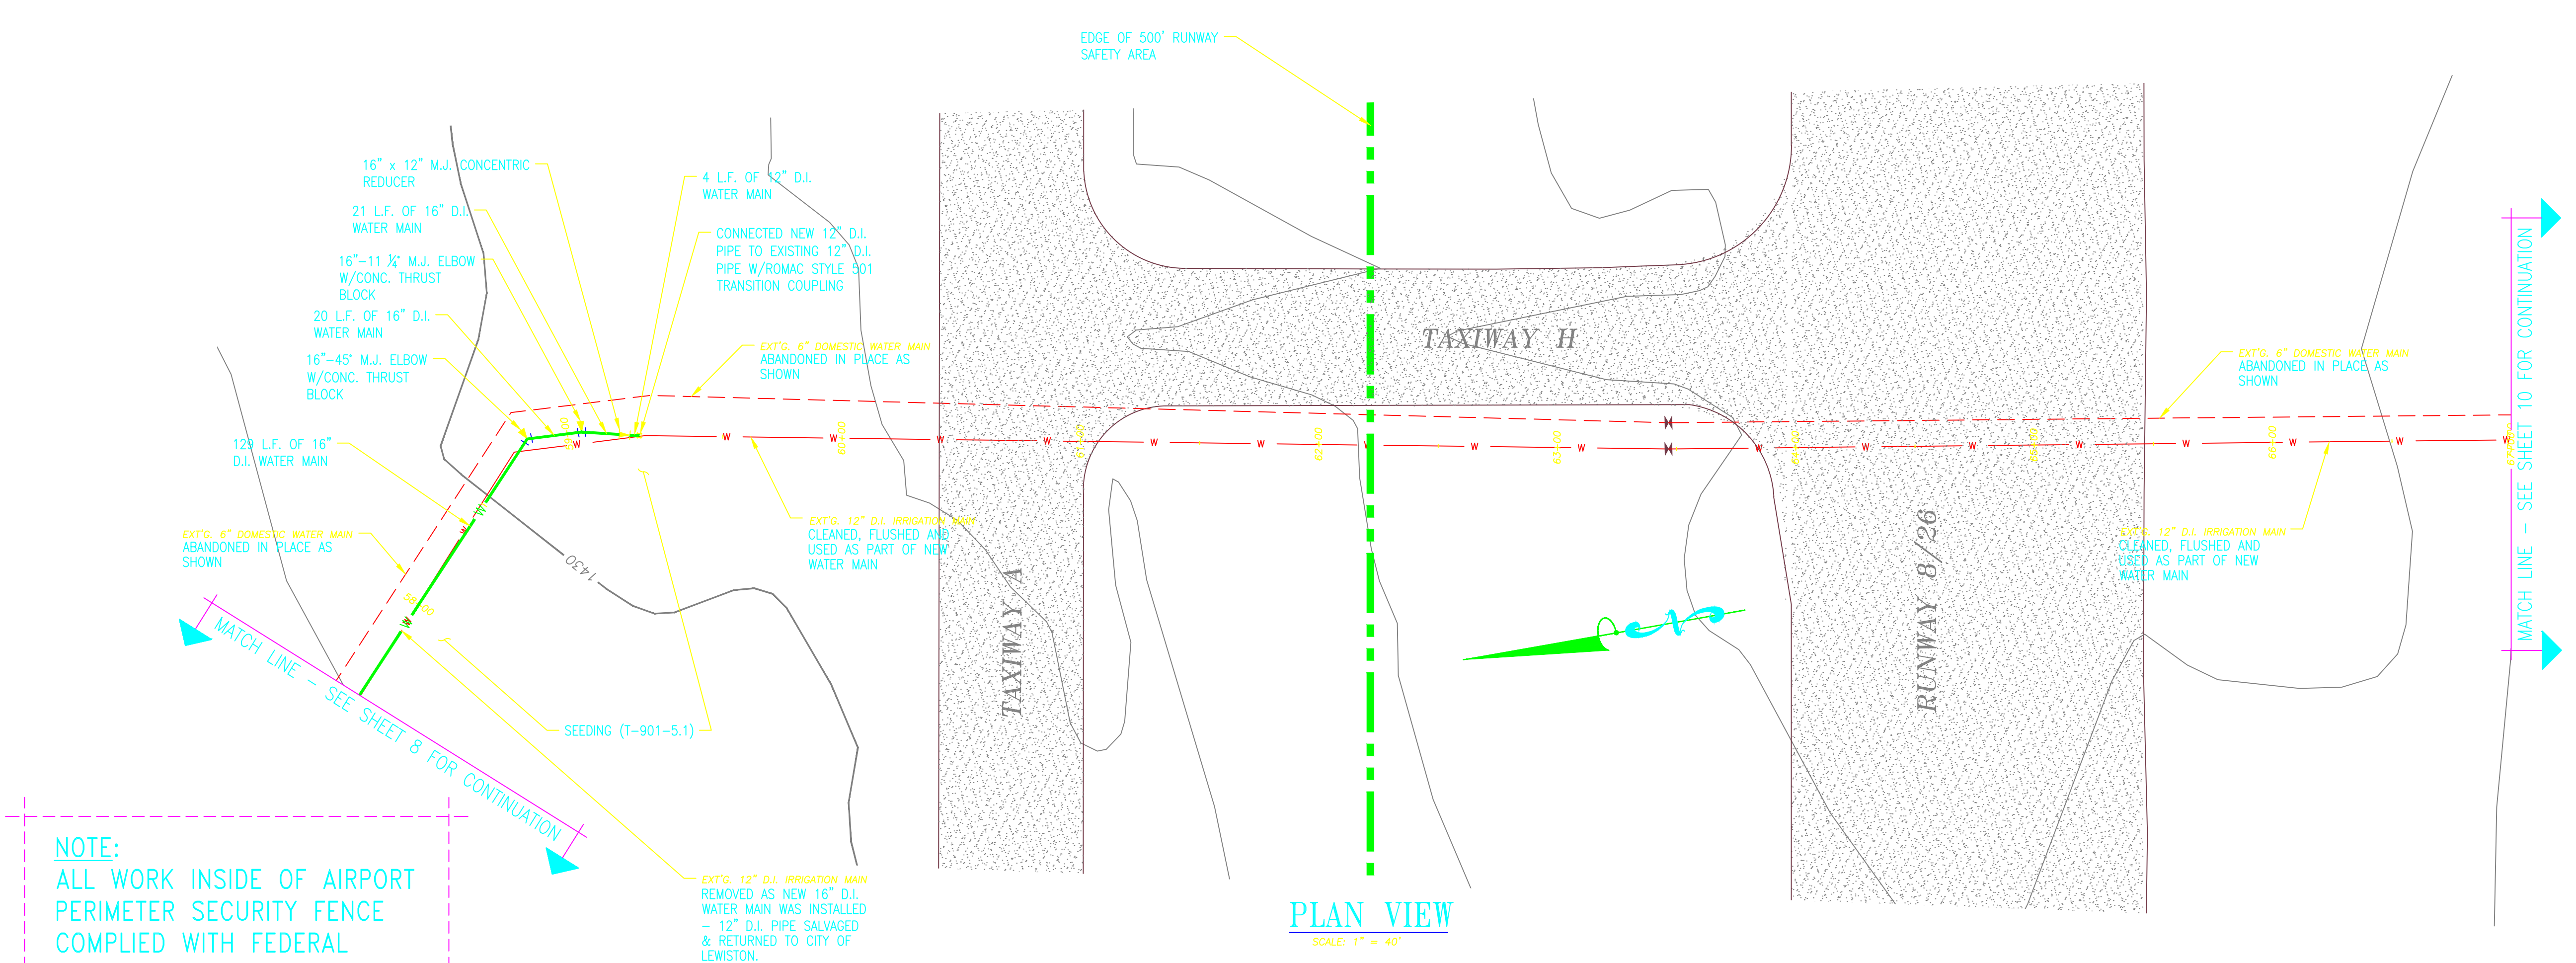


NOTE:
ALL WORK INSIDE OF AIRPORT
PERIMETER SECURITY FENCE
COMPLIED WITH FEDERAL
AVIATION REQUIREMENTS – SEE
PART 7 OF SPECIFICATIONS.

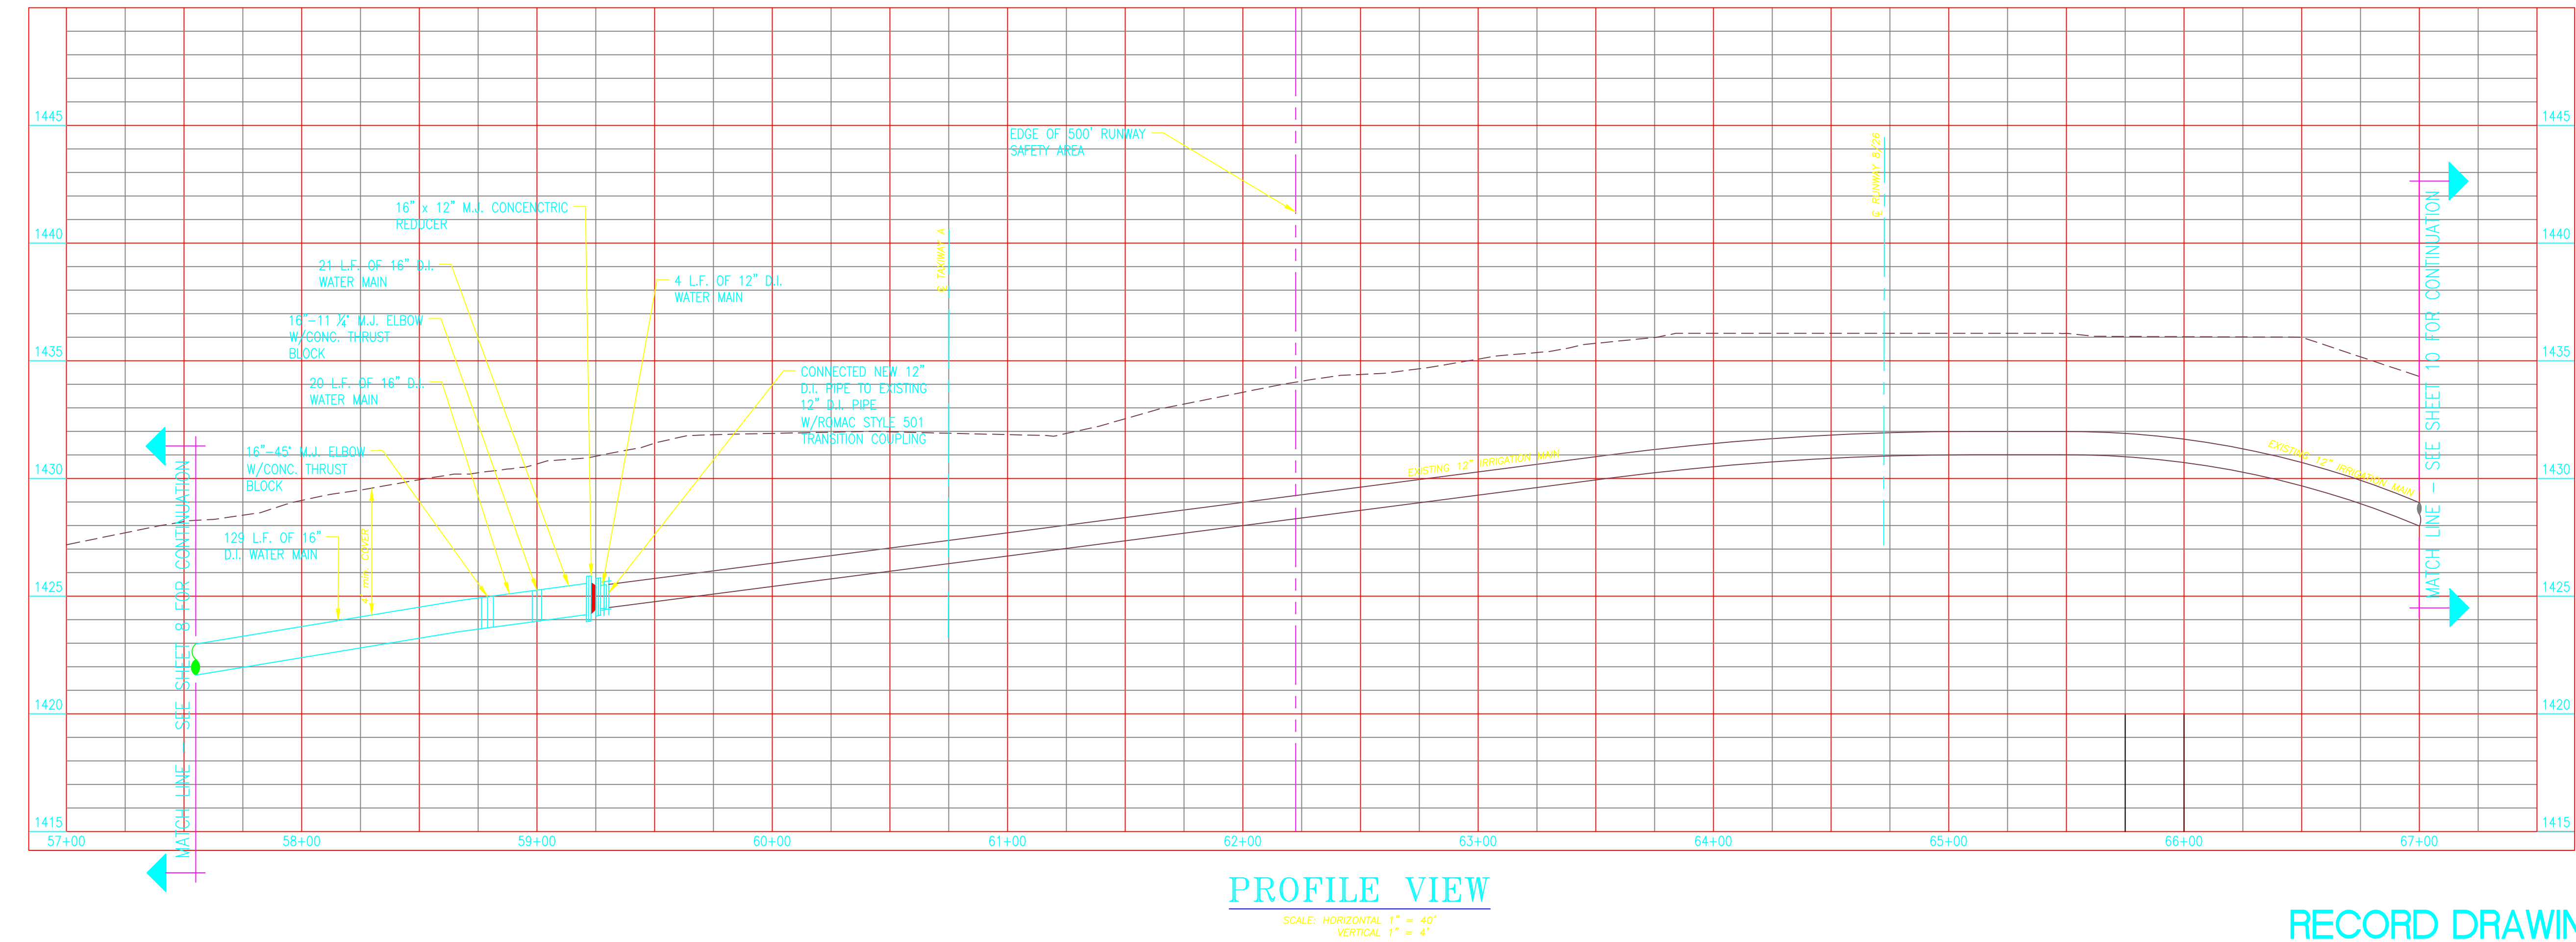

RECORD DRAWING 01/12/12

REVISIONS		
NO.	DATE	BY

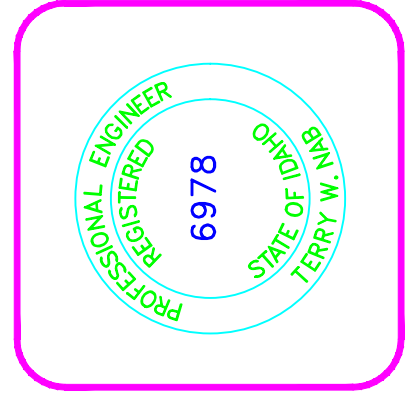

PROGRESSIVE
ENGINEERING GROUP, INC



PLANNING DESIGN CONSTRUCTION MANAGEMENT

1208 IDAHO STREET
LEWISTON, IDAHO 83501
PH (208) 746-5406 FAX (208) 746-8732


CITY OF LEWISTON

O'CONNOR ROAD WATER MAIN
PLAN AND PROFILE
STA. 57+57 TO STA. 67+00

DRAWN BY: VSR	CHECKED BY: TWN
DESIGNED BY: TWN	
DATE: 01/12/12	
LAST REV:	
PROJECT NO.: 09-025	
SHEET 9	OF 12

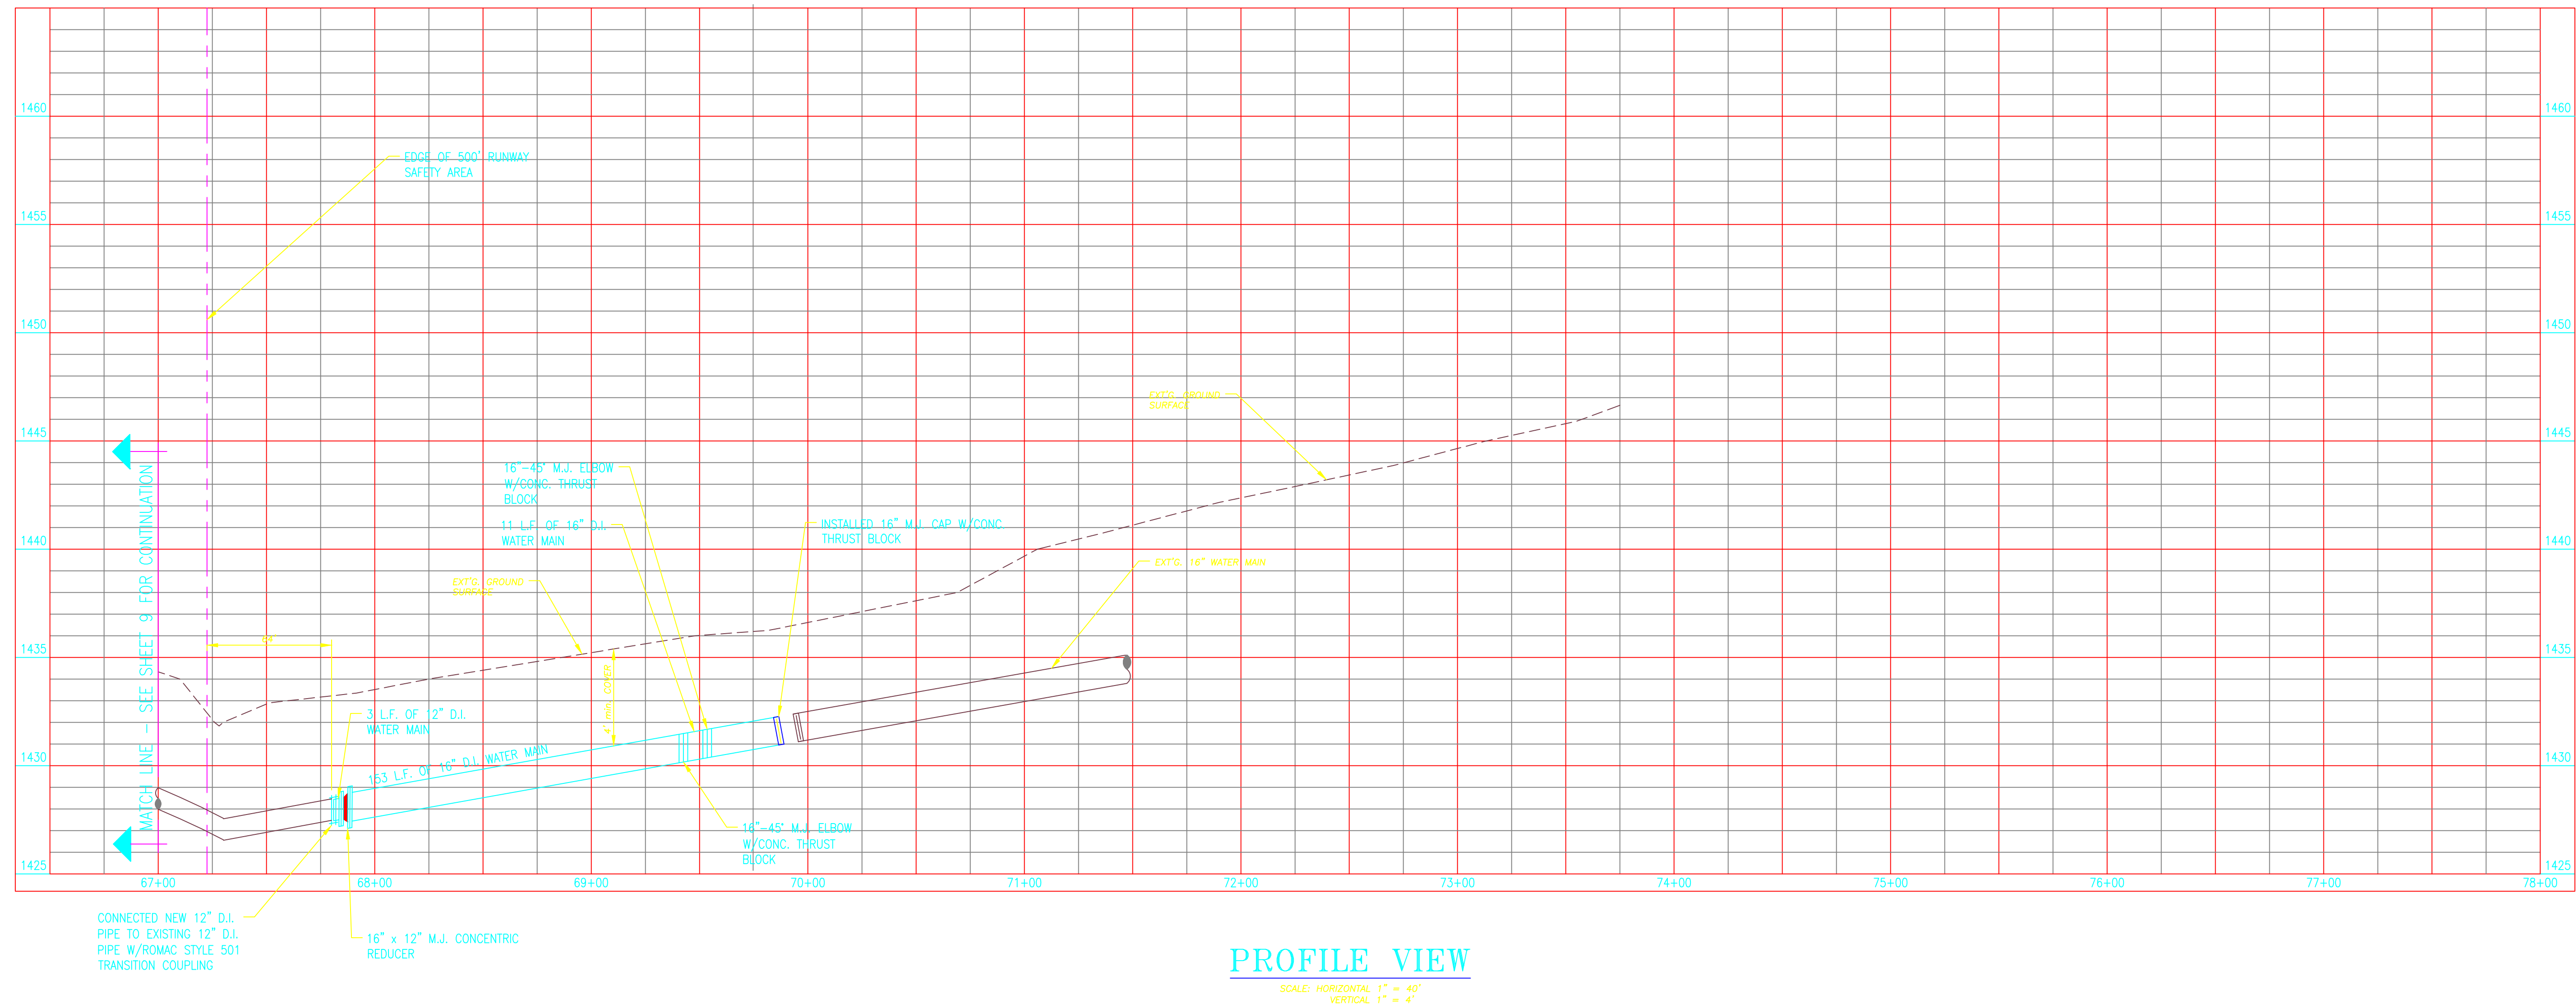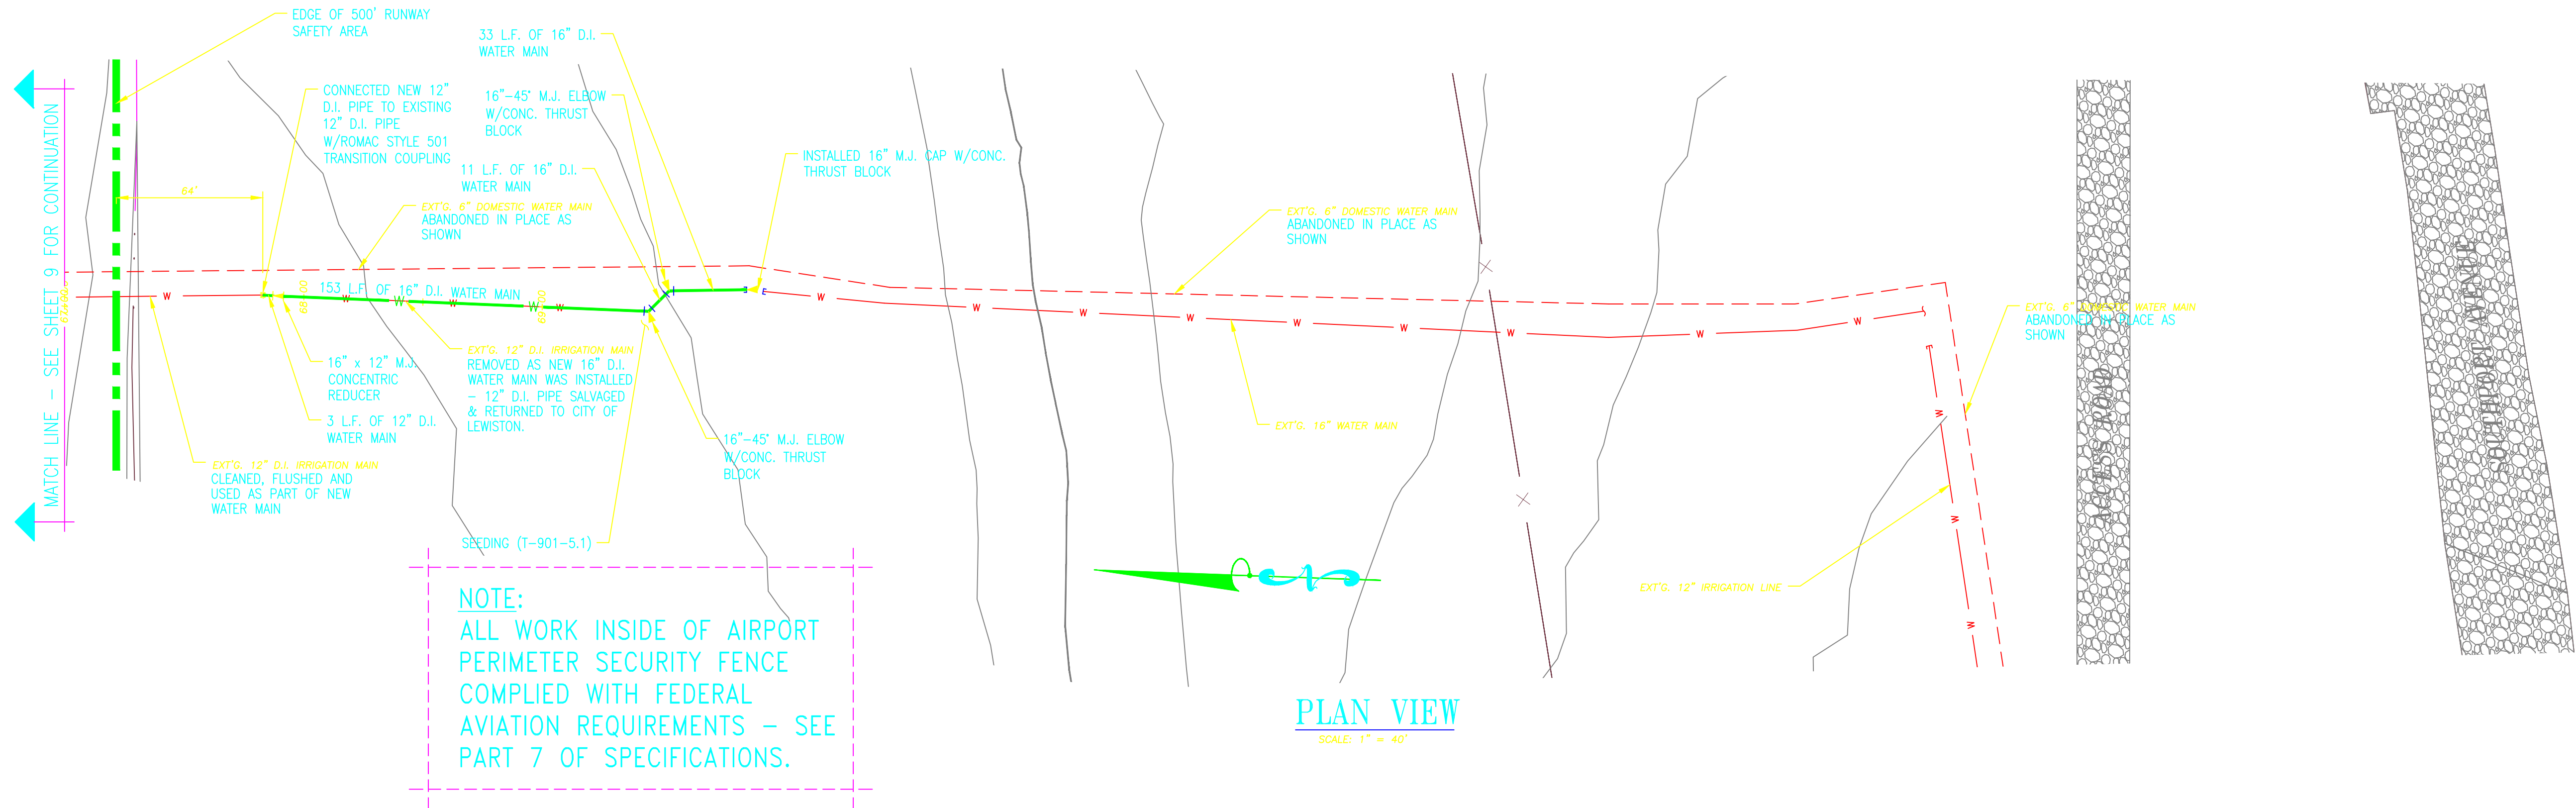

REVISIONS	
NO.	DATE BY

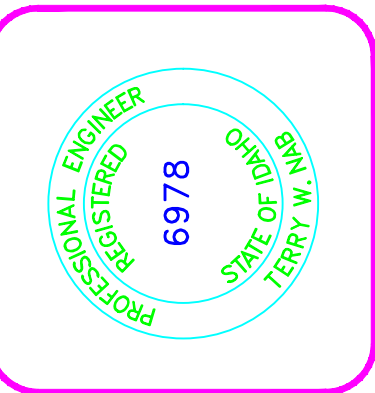

PROGRESSIVE
ENGINEERING GROUP, INC

PLANNING DESIGN CONSTRUCTION MANAGEMENT


1208 IDAHO STREET
LEWISTON, IDAHO 83501
PH (208) 746-5406 FAX (208) 746-8732

CITY OF LEWISTON


O'CONNOR ROAD WATER MAIN
PLAN AND PROFILE

STA. 67+00 TO END OF PROJECT

DRAWN BY: VSR	CHECKED BY: TWN
DESIGNED BY: TWN	
DATE: 01/12/12	
LAST REV:	
PROJECT NO.: 09-025	
SHEET 10	OF 12

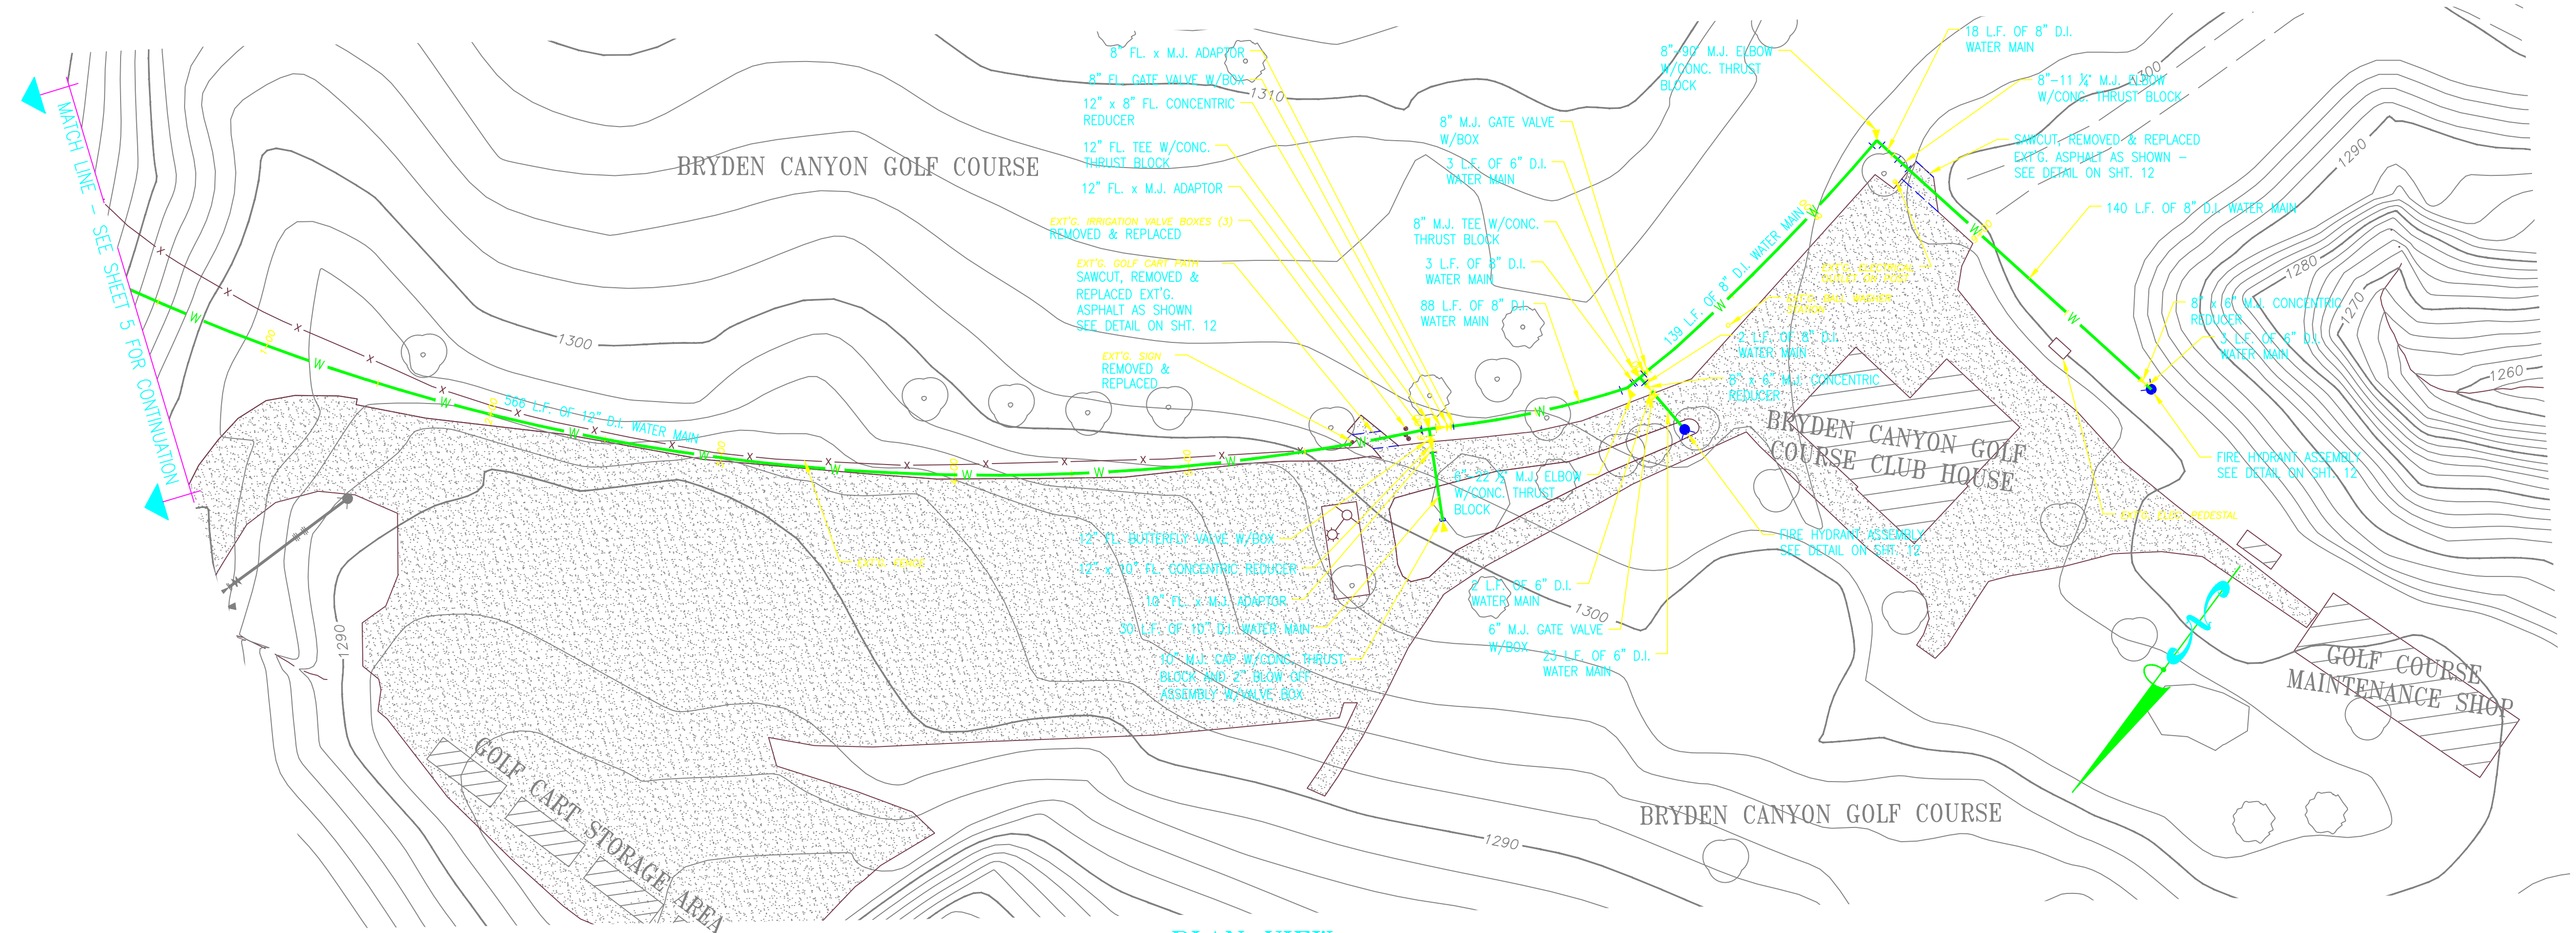


PLAN VIEW
SCALE: 1" = 40'

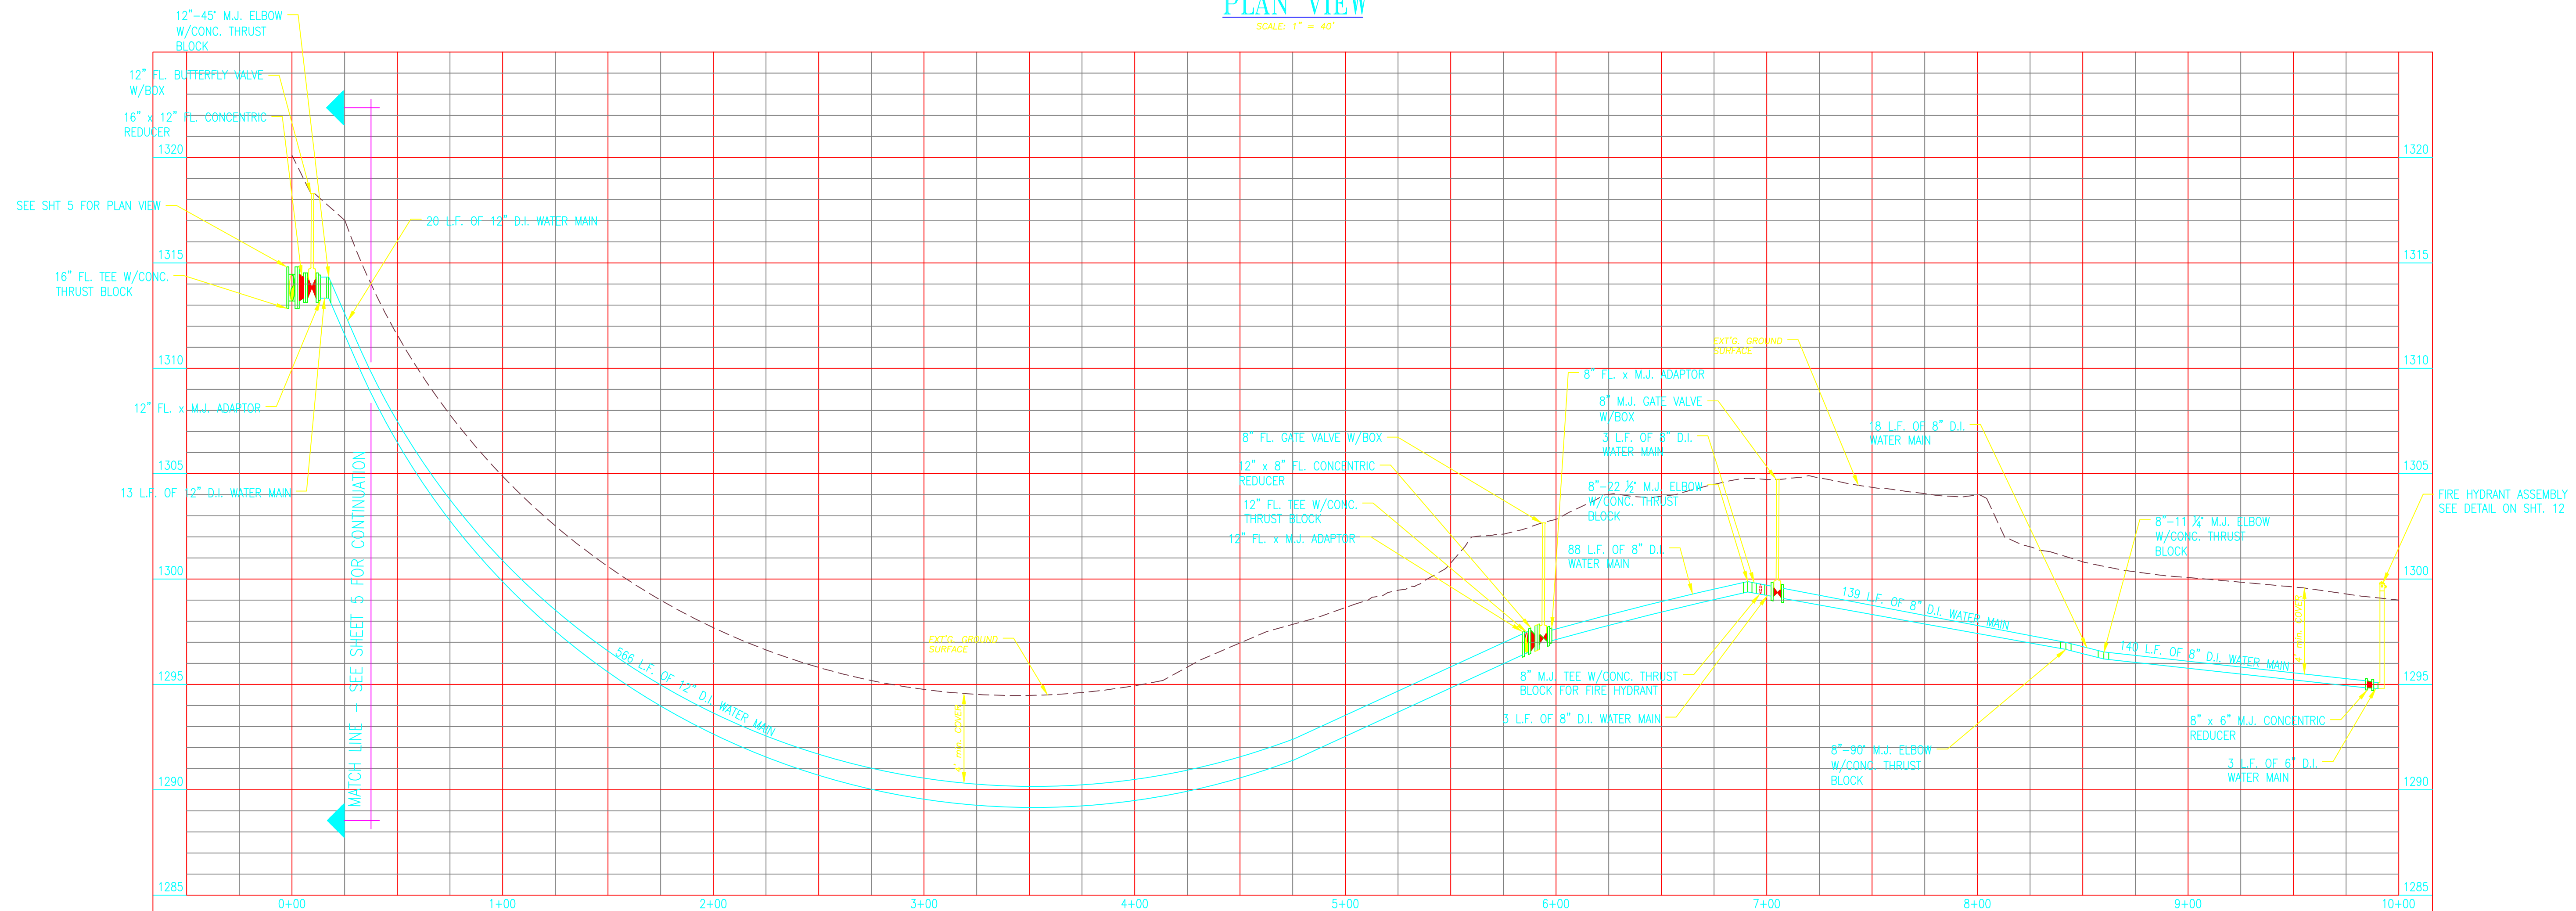

PROFILE VIEW
SCALE: HORIZONTAL 1" = 40'
VERTICAL 1" = 4'

RECORD DRAWING 01/12/12

REVISIONS		
NO.	DATE	BY

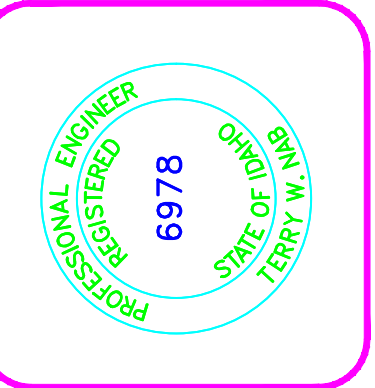

**PROGRESSIVE
ENGINEERING GROUP, INC.**

PLANNING DESIGN CONSTRUCTION MANAGEMENT

1208 IDAHO STREET
LEWISTON, IDAHO 83501
PH (208) 746-5406 FAX (208) 746-8732

CITY OF LEWISTON

**O'CONNOR ROAD WATER MAIN
PLAN AND PROFILE**

STA. 0+38 TO STA. 9+90

DRAWN BY: VSR	CHECKED BY: TWN
DESIGNED BY: TWN	
DATE: 01/12/12	
LAST REV:	
PROJECT NO.: 09-025	
SHEET 11	OF 12