




CITY OF LEWISTON
ENGINEERING DEPARTMENT
1134 W STREET, LEWISTON, IDAHO 83501
208-746-1398

CITY OF LEWISTON
1861

2001 STREET
MAINTENANCE PROJECT
COUNTRY CLUB DRIVE
RECONSTRUCTION
ADD ALTERNATE #3

NO. DATE REVISION
1 11/10/01
2 11/10/01
3 11/10/01
DESIGNED BY: S.M.
CHECKED BY: D.S.
DATE: APR 2001
SHEET 3 OF 4

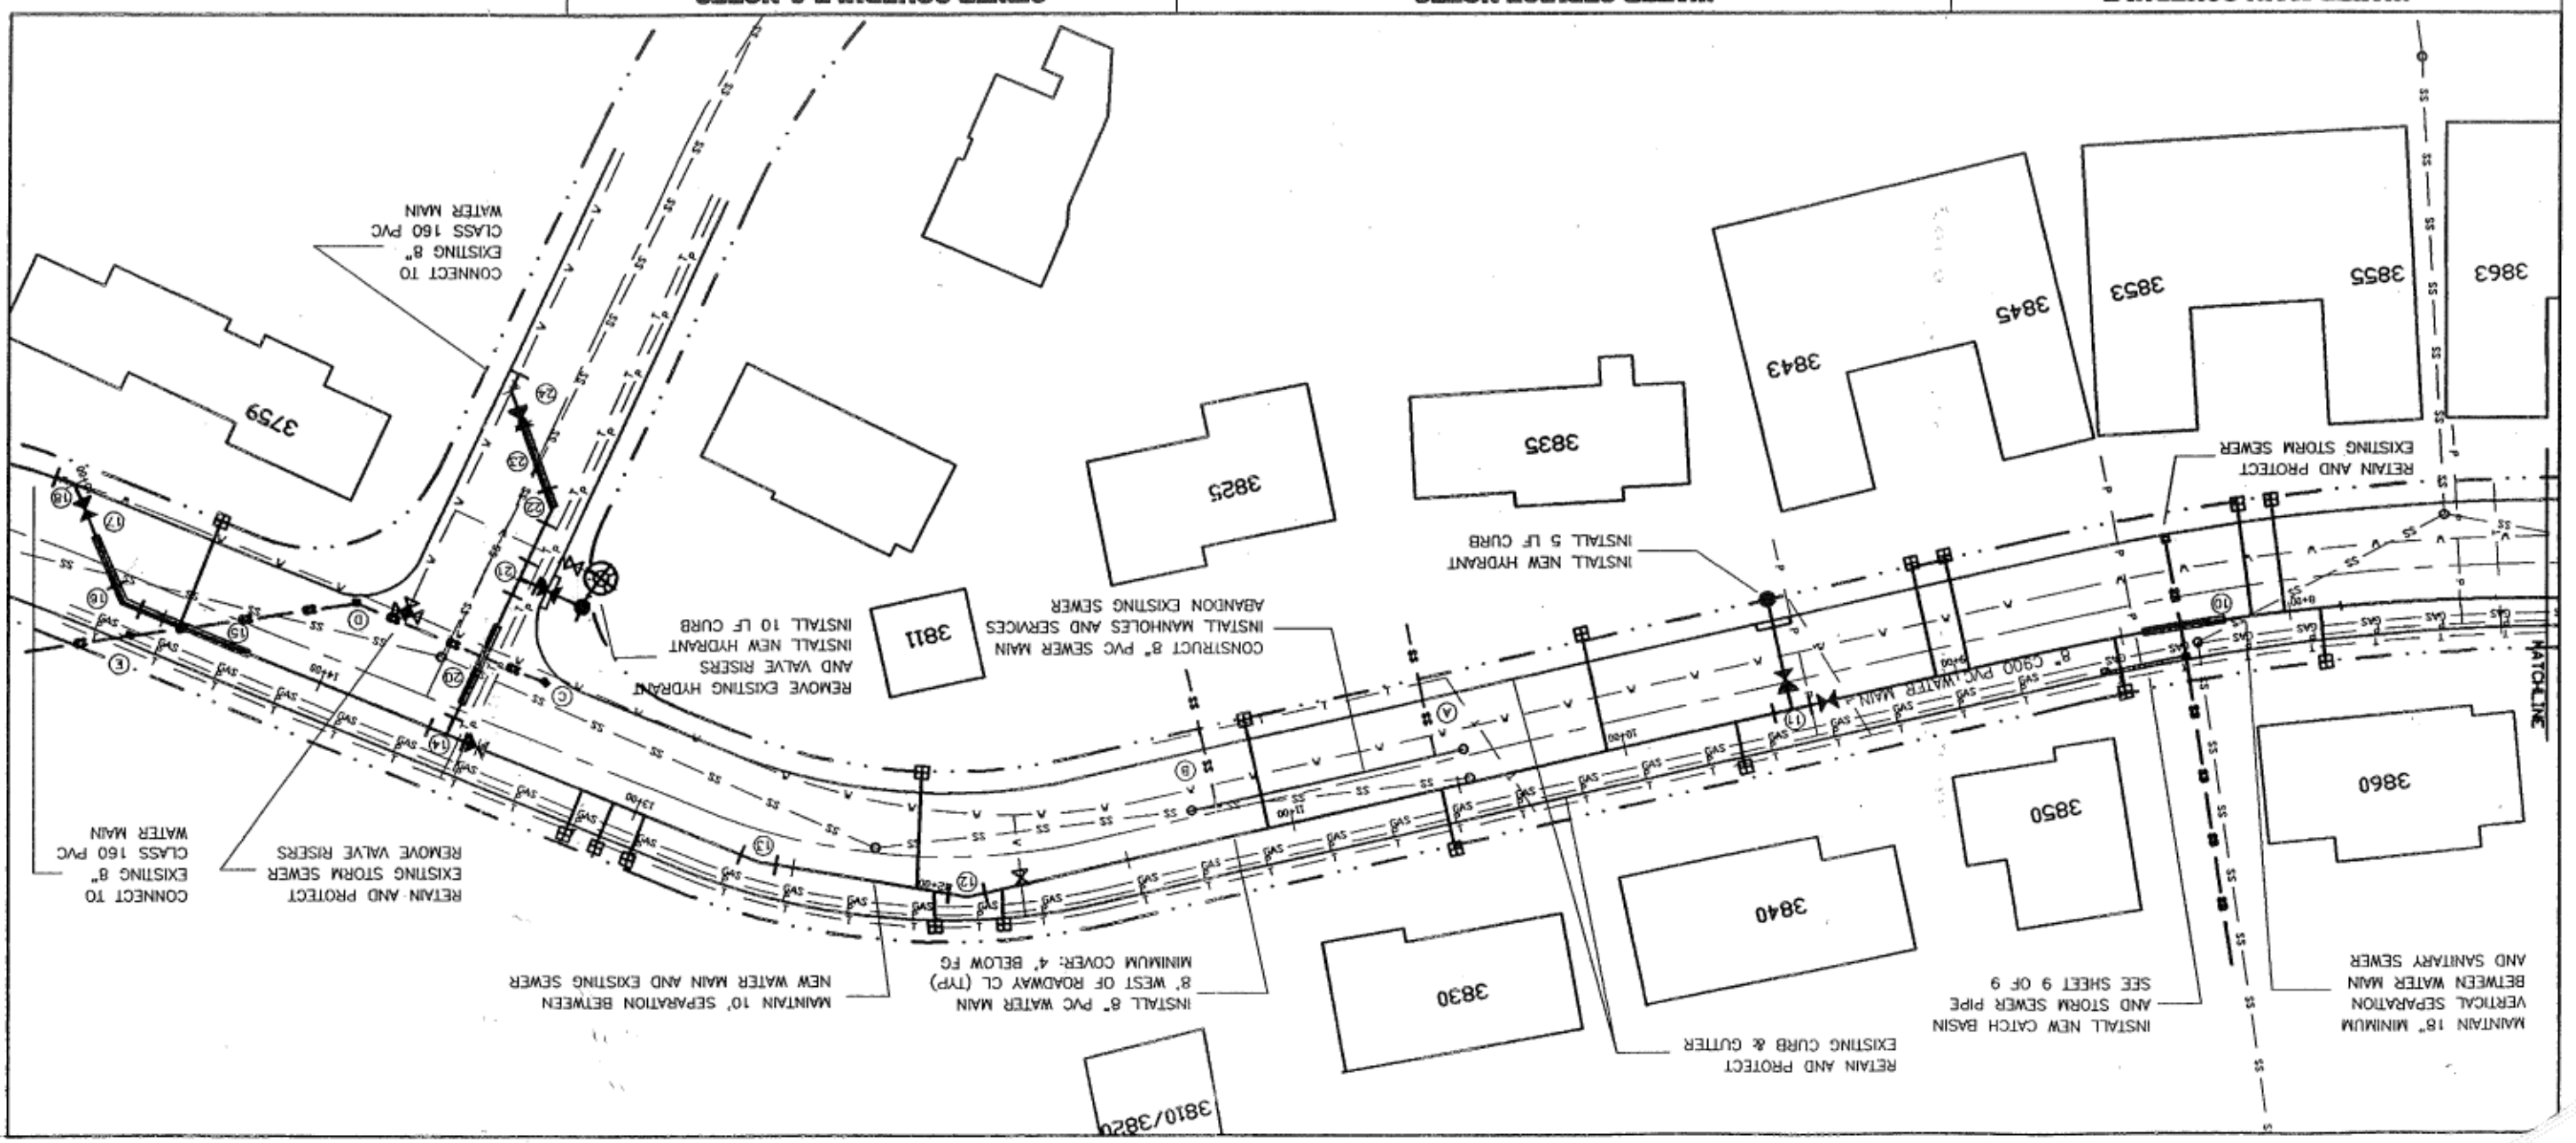

WATER MAIN SCHEDULE									
NO. LINE	STATION	OFFSET	NOTES	LINE	ADDRESS	SIDE	SERVICE SIZE	EXISTING LENGTH	REPLACE LENGTH
10	A		CONCRETE ENCASEMENT - 25 LF	A	3865	RT.	1"	35.2	22'
11	A	9+48	8" GATE VALVE	A	3863	RT.	1"	35.0	22'
12	A	11+99	8" 22.5" ELBOW	A	3855	RT.	1"	33.2	20'
13	A	12+60	8" 11.25" ELBOW	A	3853	RT.	1"	33.0	20'
14	A	13+58	8" GATE VALVE	A	3850	LT.	1"	16.3	3'
15	A	13+60	8"x8" TEE	A	3845	RT.	1"	34.1	19'
16	A	14+62	8" 45" ELBOW	A	3843	RT.	1"	34.1	19'
17	A	14+95	8" GATE VALVE	A	3835	RT.	1"	35.1	19'
18		15+00	8" 45" ELBOW	A	3830	LT.	1"	18.1	3'
19		15+00	CONNECT TO EXISTING 8" MAIN	A	3825	RT.	1"	32.6	19'
20	B		CONCRETE ENCASEMENT - 25 LF	A	3820	LT.	1"	10.2	3'
21	B	0+51	FIRE HYDRANT ASSEMBLY	A	3811	RT.	1"	33.8	34'
22	B	0+74	8" 45" ELBOW	A	3810	LT.	1"	10.1	3'
23	B		CONCRETE ENCASEMENT - 27 LF	A	3762	LT.	1"	14.1	3'
24	B	1+05	8" GATE VALVE	A	3760	LT.	1"	14.1	3'
			8" 45" ELBOW	A	3759	RT.	1"	33.1	33'
			CONNECT TO EXISTING 6" MAIN	A	3758	LT.	1"	14.1	3'
			REPLACE TO METER						

WATER SERVICE NOTES									
ID.	ITEM OF WORK	NOTES							
A	SEWER MANHOLE	INVERT DEPTH : 8.0' FROM FG							
B	SEWER MANHOLE	INVERT DEPTH : 8.0' FROM FG							
	CONNECT TO EXISTING								
SEWER SCHEDULE & NOTES									
NO. LINE	STATION	OFFSET	NOTES	LINE	ADDRESS	SIDE	SERVICE SIZE	EXISTING LENGTH	REPLACE LENGTH
10	A		CONCRETE ENCASEMENT - 25 LF	A	3865	RT.	1"	35.2	22'
11	A	9+48	8" GATE VALVE	A	3863	RT.	1"	35.0	22'
12	A	11+99	8" 22.5" ELBOW	A	3855	RT.	1"	33.2	20'
13	A	12+60	8" 11.25" ELBOW	A	3853	RT.	1"	33.0	20'
14	A	13+58	8" GATE VALVE	A	3850	LT.	1"	16.3	3'
15	A	13+60	8"x8" TEE	A	3845	RT.	1"	34.1	19'
16	A	14+62	8" 45" ELBOW	A	3843	RT.	1"	34.1	19'
17	A	14+95	8" GATE VALVE	A	3835	RT.	1"	35.1	19'
18		15+00	8" 45" ELBOW	A	3830	LT.	1"	18.1	3'
19		15+00	CONNECT TO EXISTING 8" MAIN	A	3825	RT.	1"	32.6	19'
20	B		CONCRETE ENCASEMENT - 25 LF	A	3820	LT.	1"	10.2	3'
21	B	0+51	FIRE HYDRANT ASSEMBLY	A	3811	RT.	1"	33.8	34'
22	B	0+74	8" 45" ELBOW	A	3810	LT.	1"	10.1	3'
23	B		CONCRETE ENCASEMENT - 27 LF	A	3762	LT.	1"	14.1	3'
24	B	1+05	8" GATE VALVE	A	3760	LT.	1"	14.1	3'
			8" 45" ELBOW	A	3759	RT.	1"	33.1	33'
			CONNECT TO EXISTING 6" MAIN	A	3758	LT.	1"	14.1	3'
			REPLACE TO METER						