

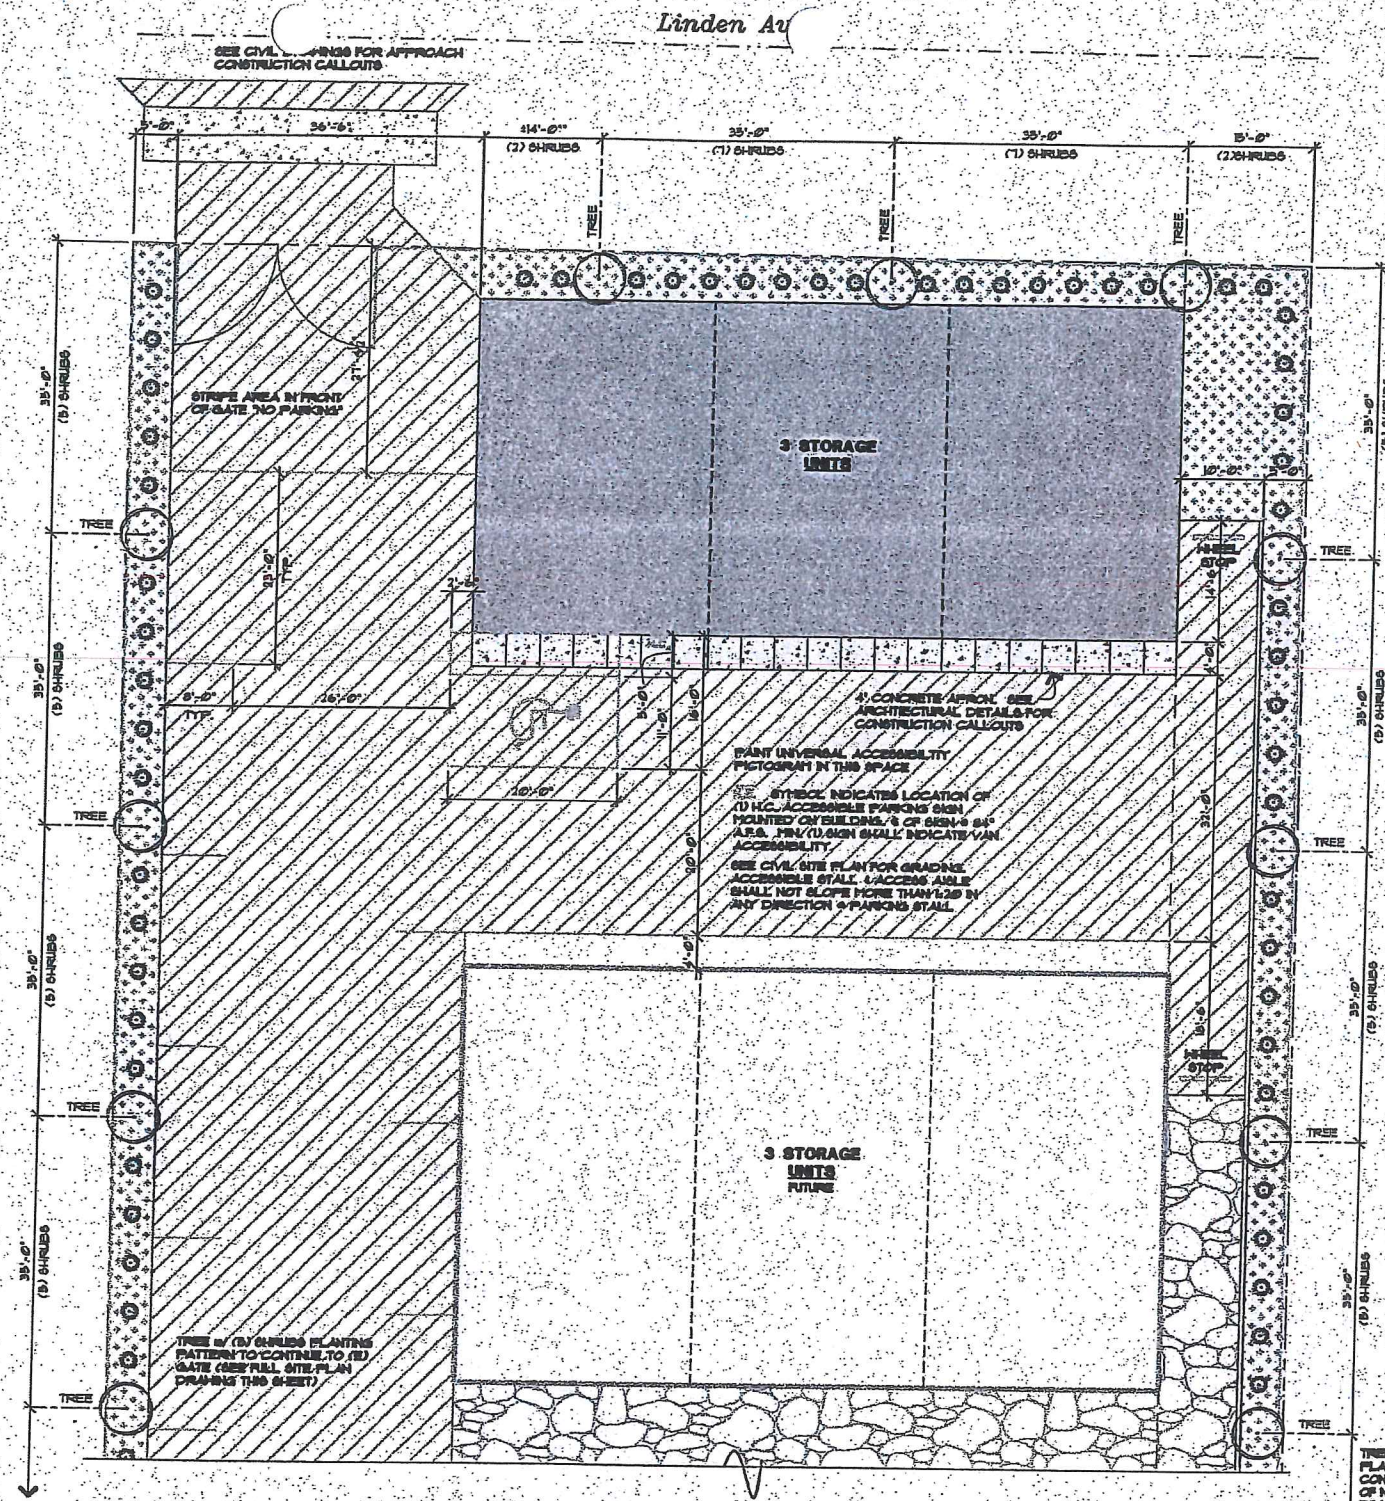


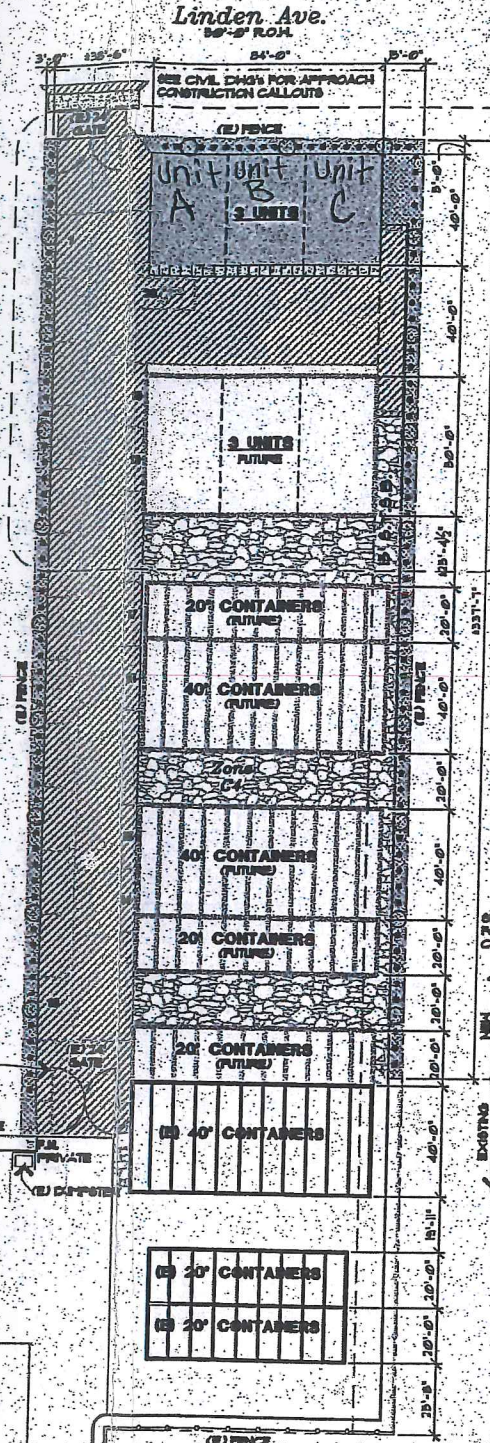

SITE PLAN

1. (FH) SYMBOL INDICATES FIRE HYDRANT.
2. ALL PARKING STALLS SHOWN ARE TO BE 8' x 23' PER CITY OF LEWISTON STANDARD FOR PARALLEL PARKING.
3. (E) = EXISTING

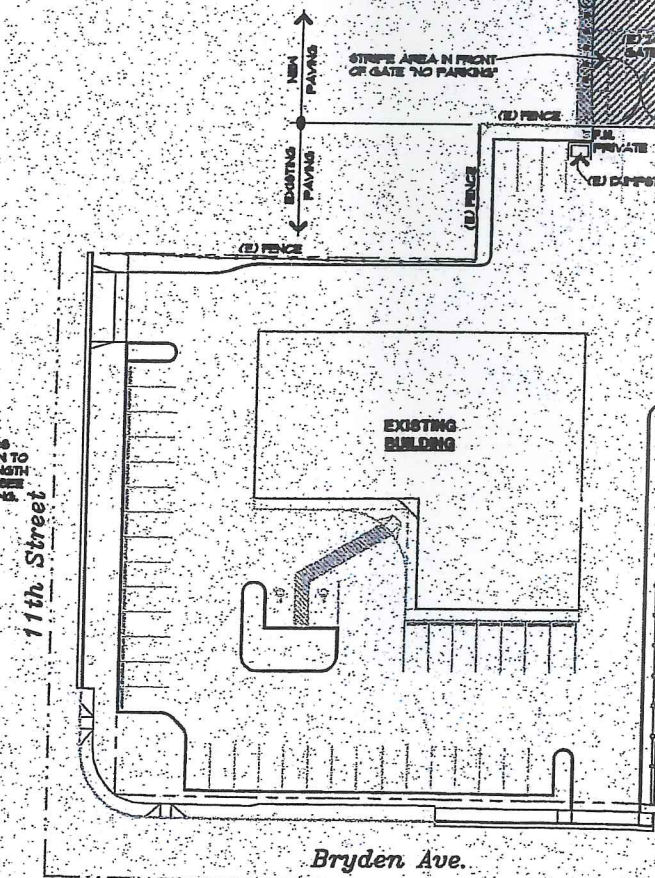

SITE LEGEND

NEW BUILDING	LANDSCAPE
CONCRETE	GRAVEL
ASPHALT	

PROPERTY LINE INFORMATION PROVIDED BY OTHERS. THE CONTRACTOR SHALL VERIFY LOCATION OF ALL PROPERTY LINE SETBACKS, EASEMENTS, & THE LOCATION OF THE BUILDING ON THE SITE.

Units A-C

1100 Linden Ave

B11-000004/11-00004

CARLTON DEVELOPMENT

Bott & Associates

LEWISTON

A1