


DETAIL A - AS CONSTRUCTED



DETAIL B - AS CONSTRUCTED

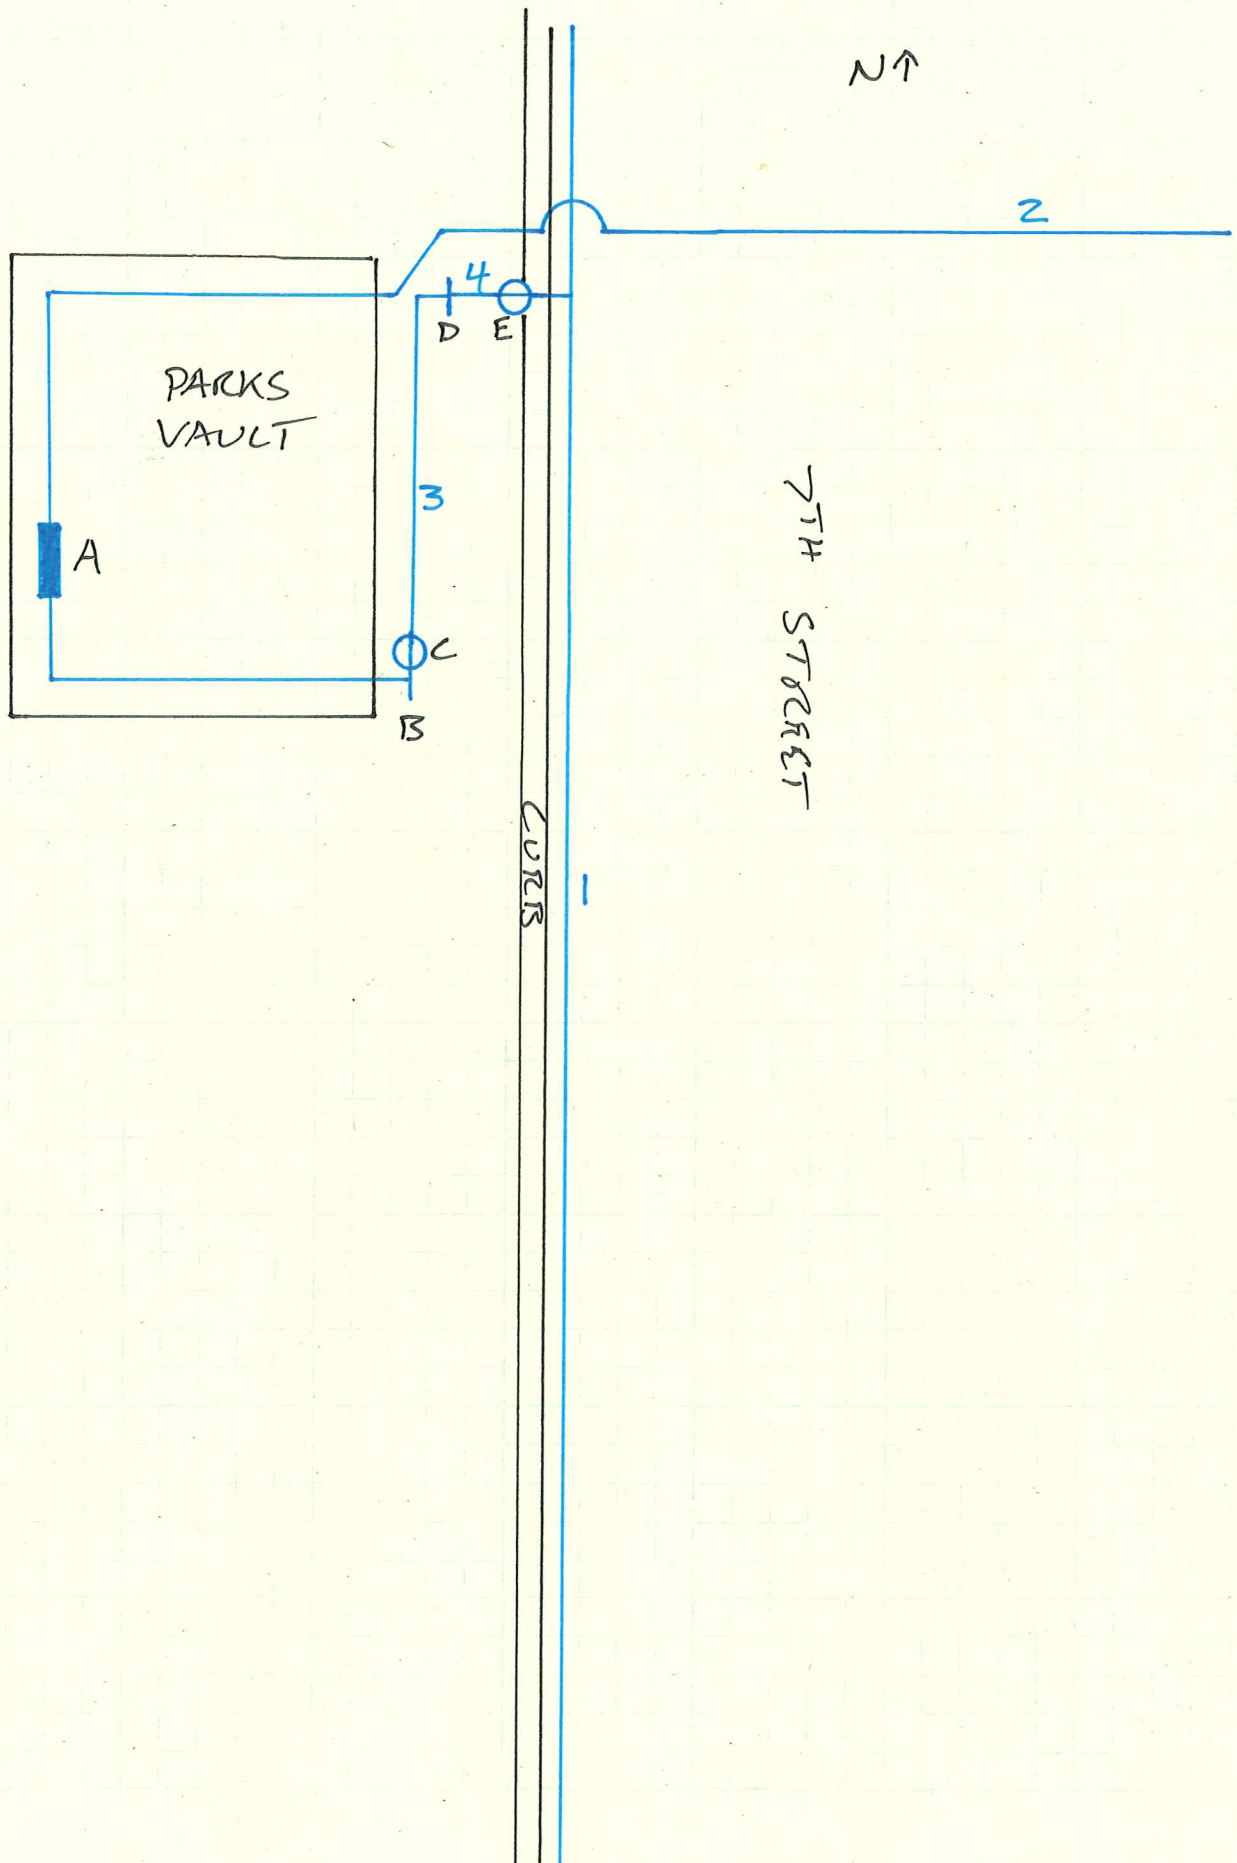