


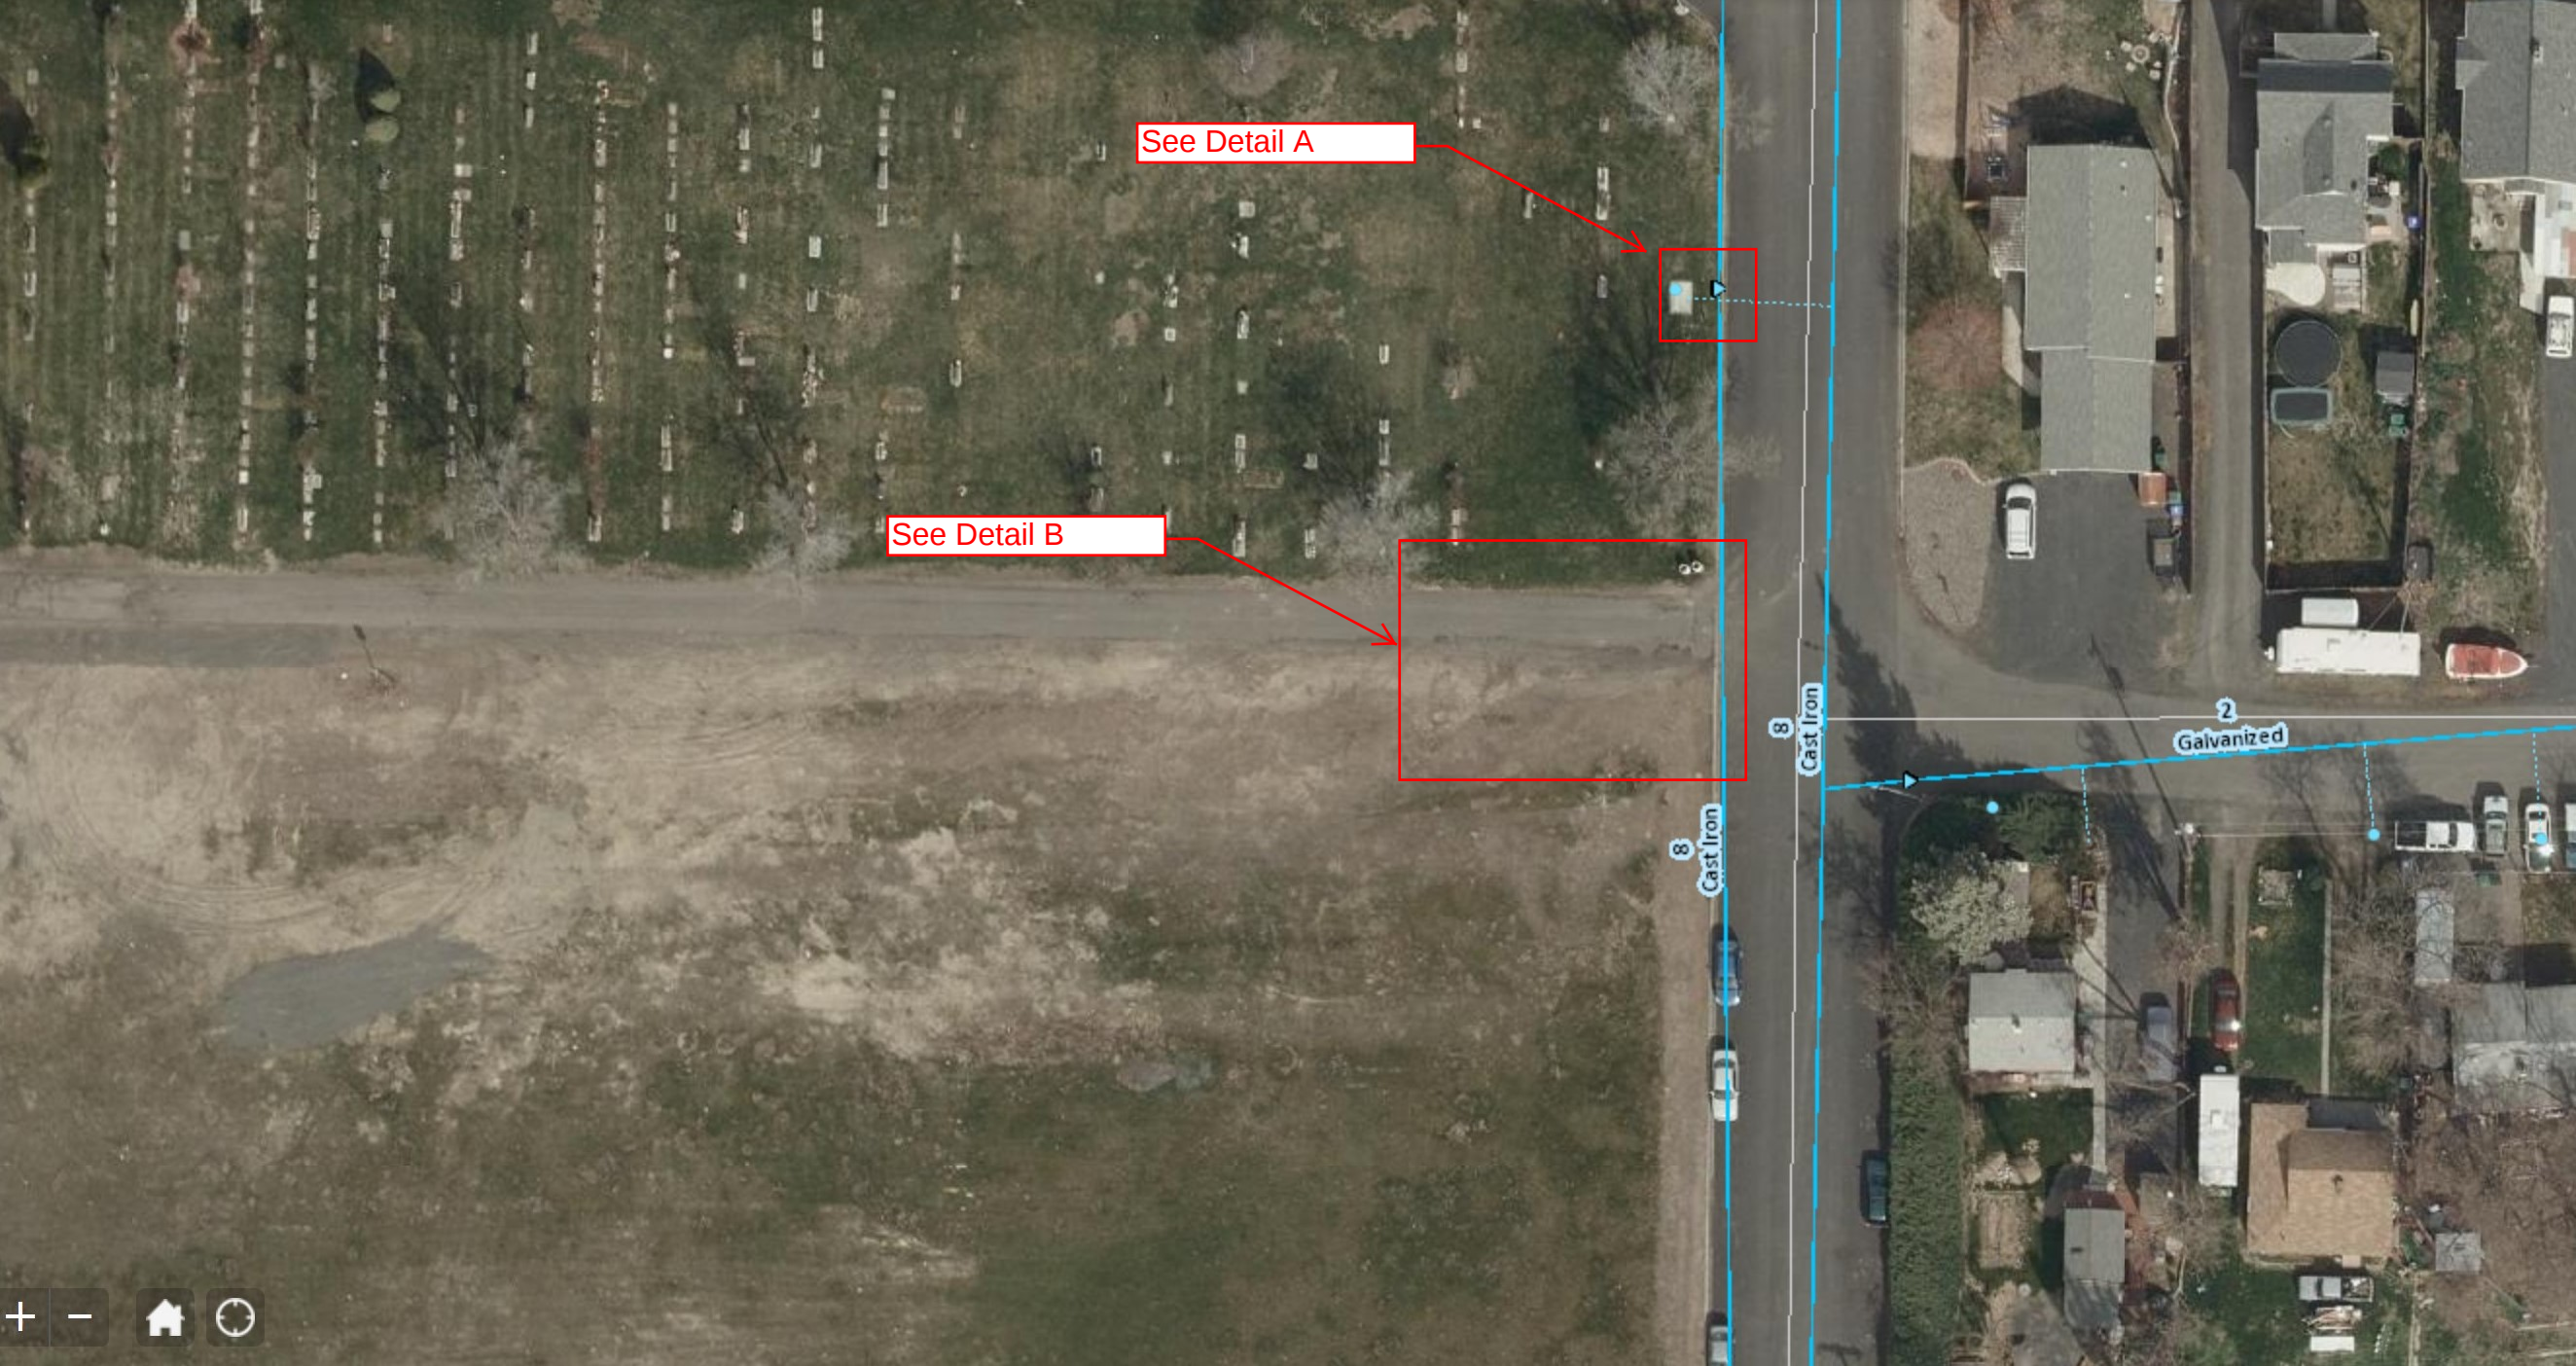

See Detail A

See Detail B

8
Cast Iron

2
Galvanized