

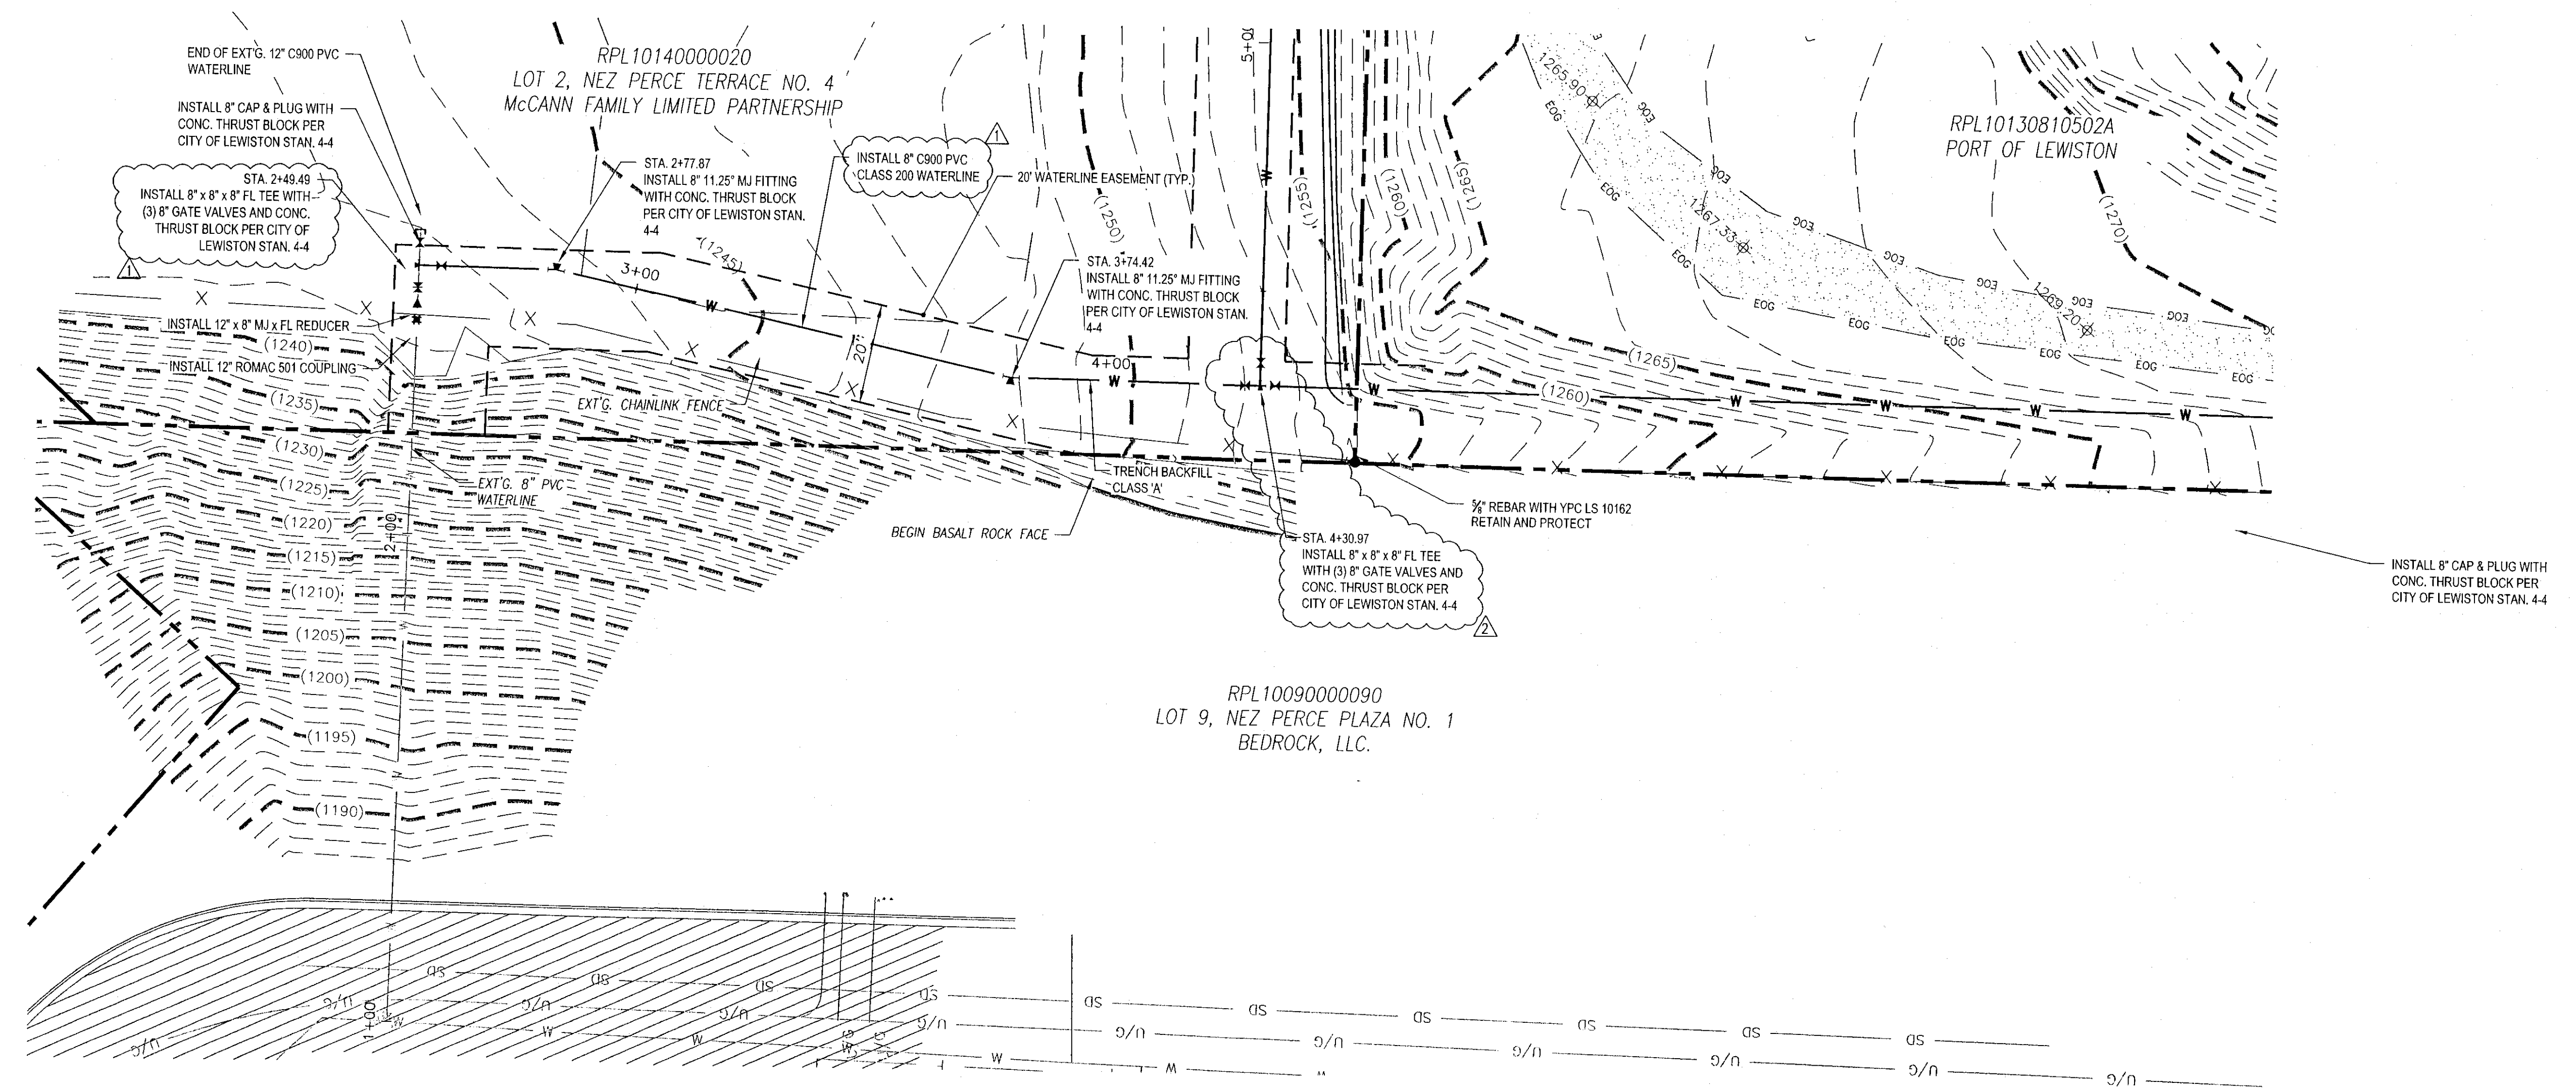
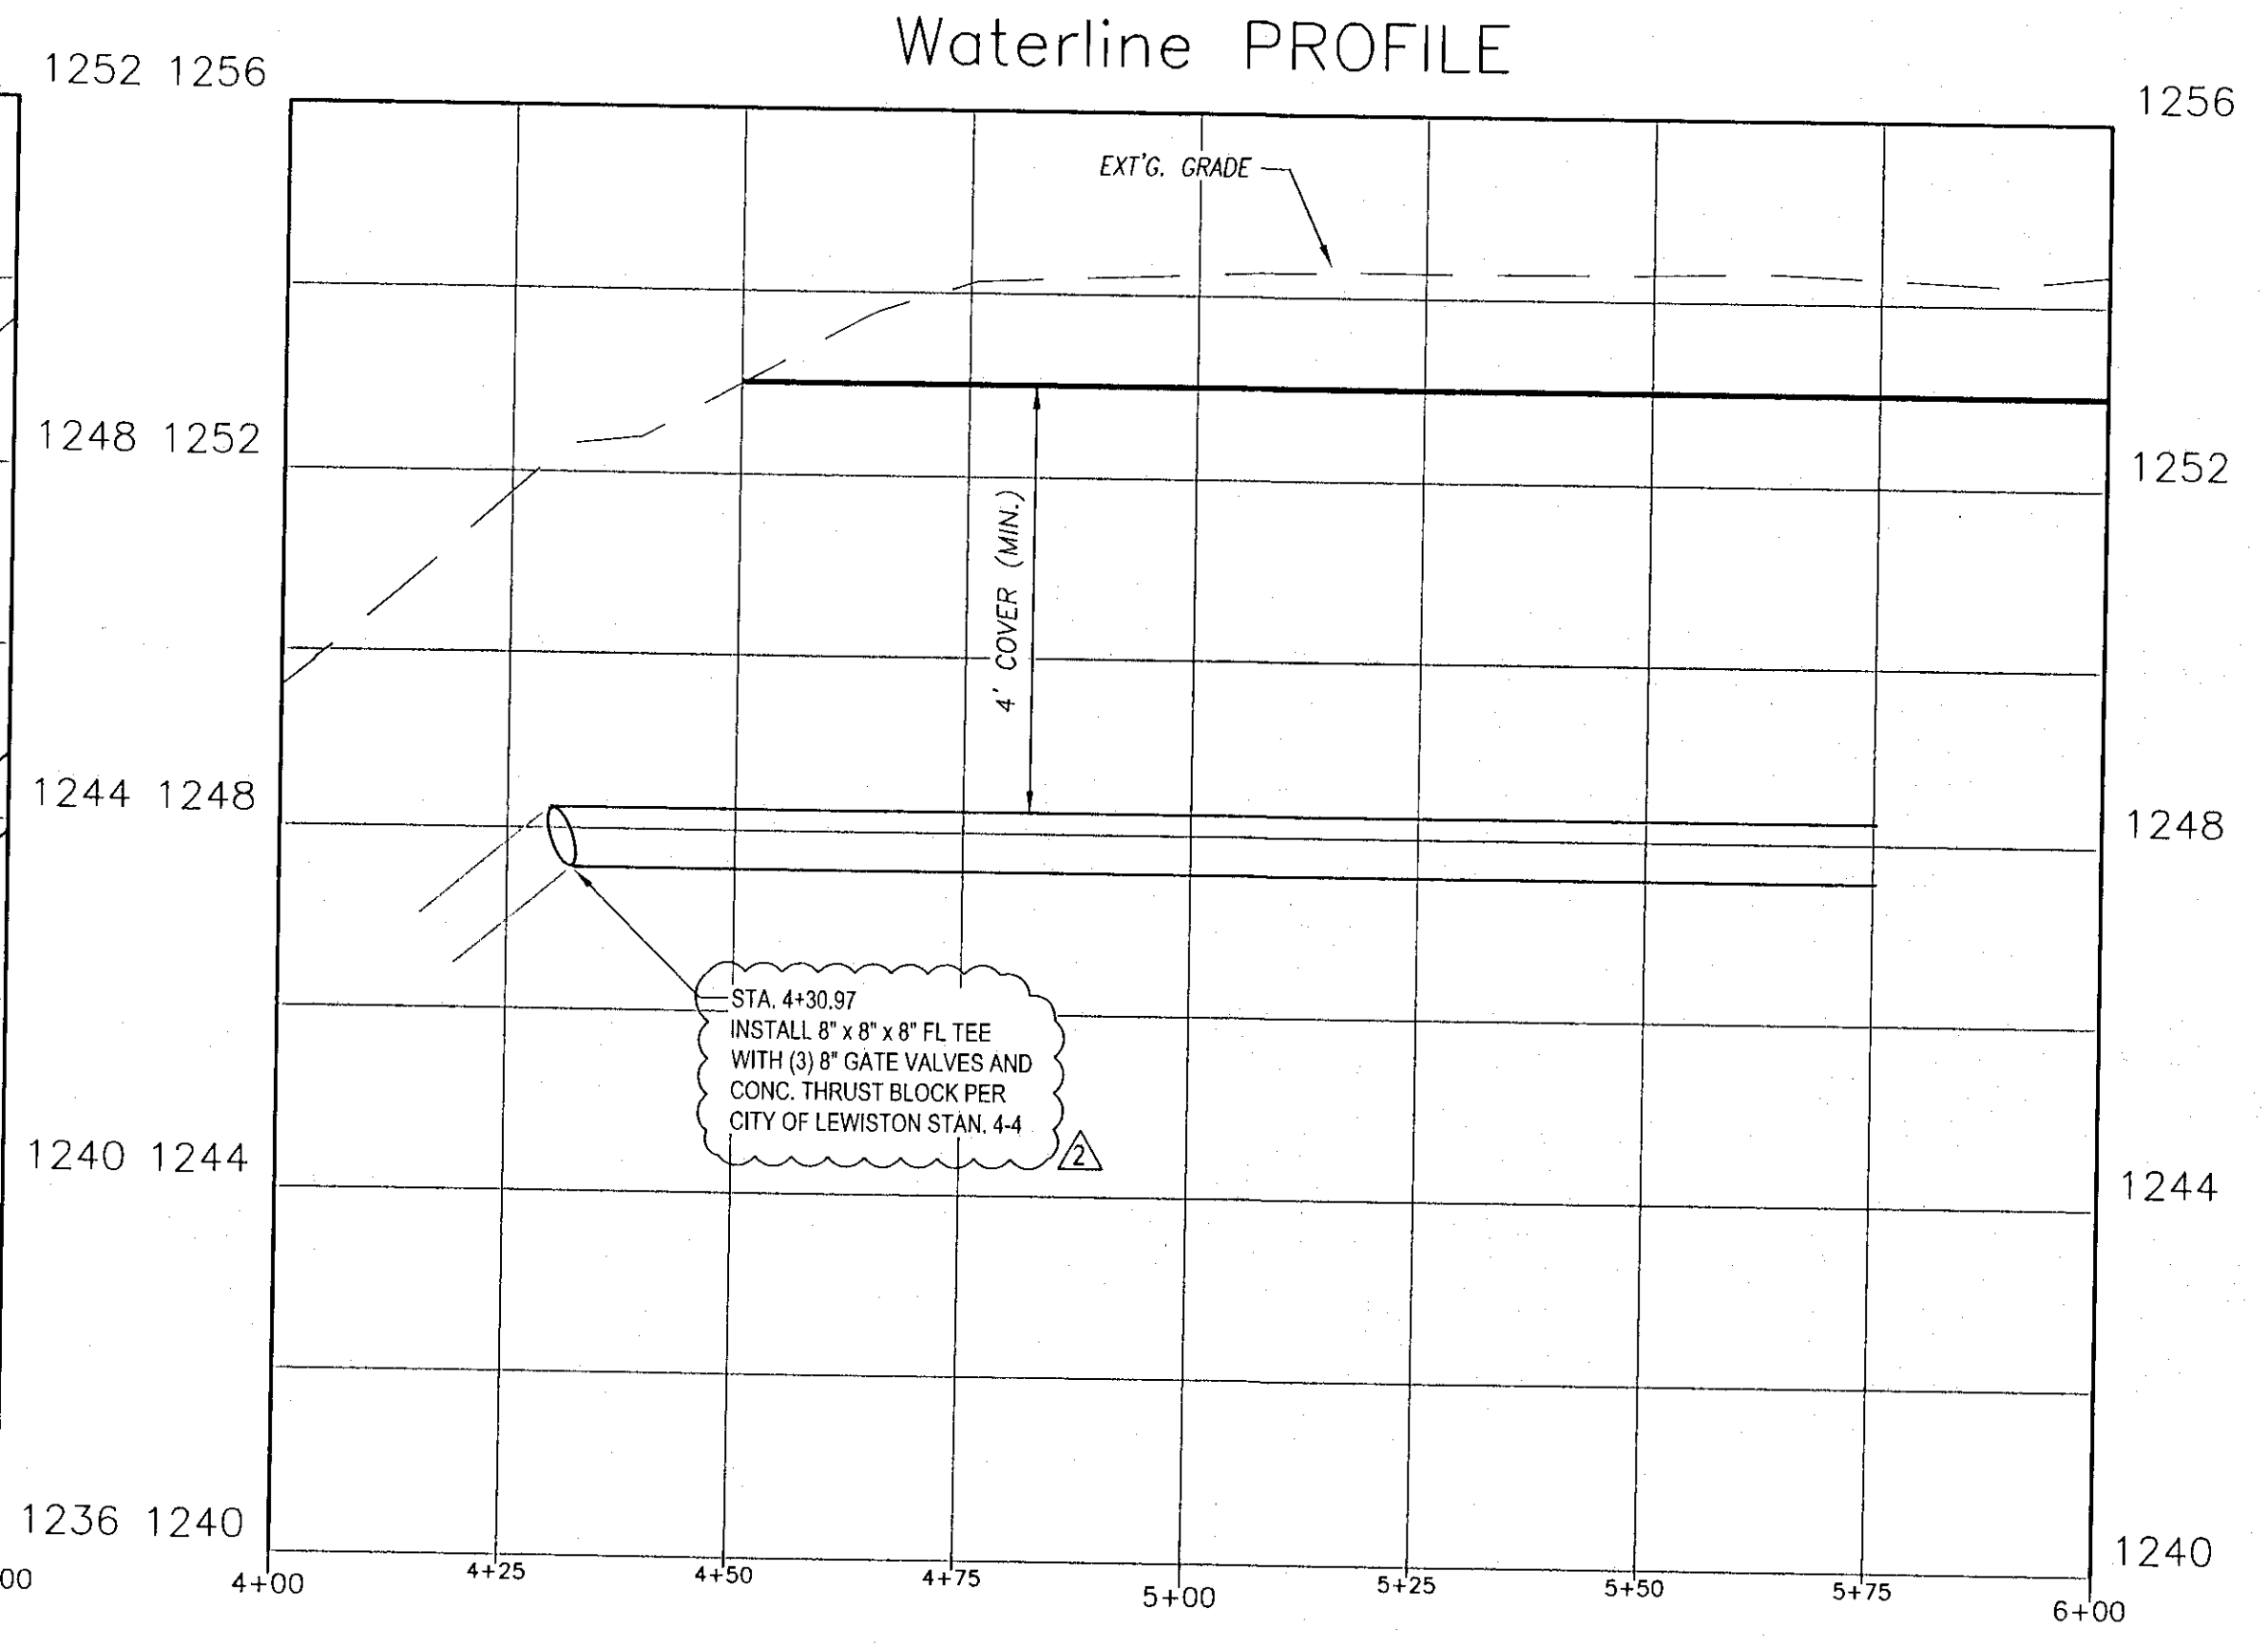


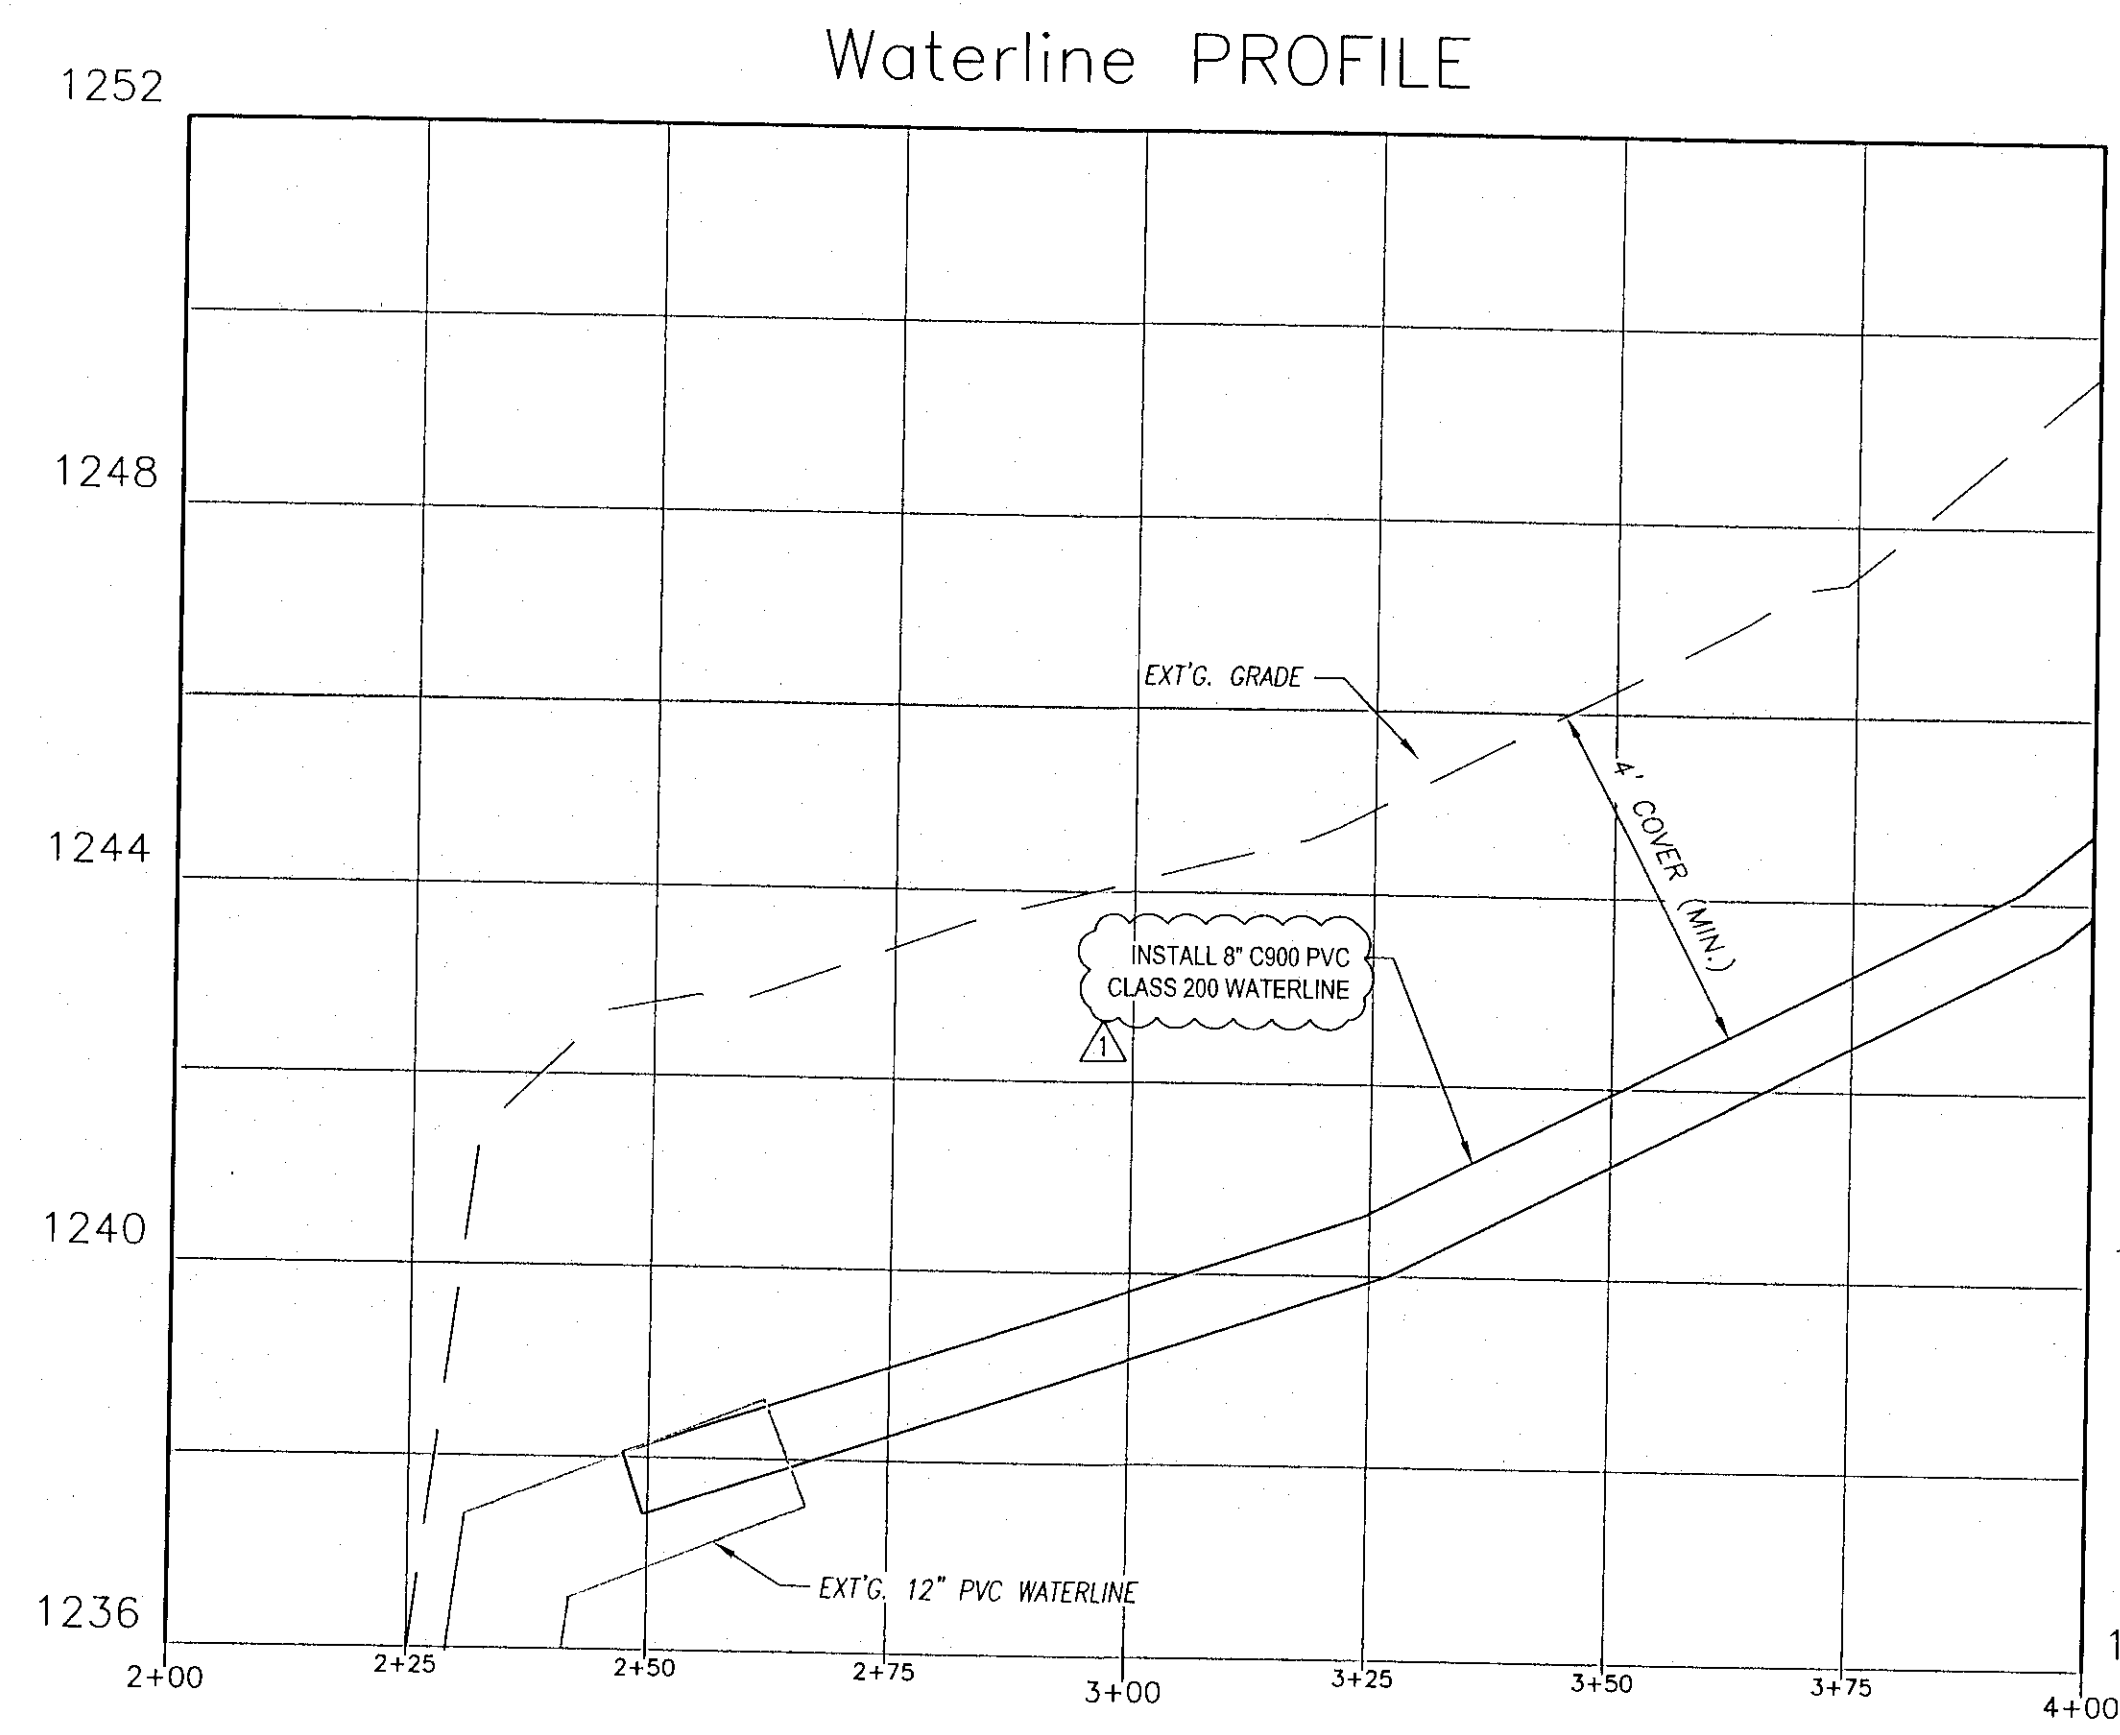

WATERLINE STA. 2+00 TO 5+50

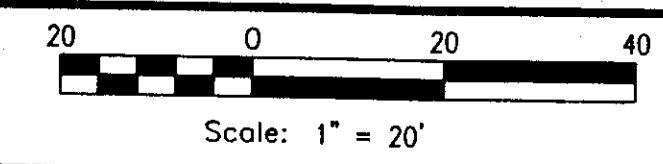

No.	DATE	BY	DESCRIPTION
1	6/19/12	RGW	CITY OF LEWISTON COMMENTS, 06-12-12
2	12/17/14	EFH	OWNER CHANGE

WATERLINE PLAN & PROFILE
NPP WATERLINE CONNECTION
BEDROCK, LLC.
LEWISTON, ID. 83501

KELTIC ENGINEERING, INC.

315 Adams Lane • Lewiston, Idaho 83501 • (208) 743-2135 • (208) 743-2136 fax
 9425 North Nevada Street, Ste 204 • Spokane, WA 99218 • (509) 464-3000 • (509) 464-3005 fax
 • Development • Planning • Design • Construction Management

DRAWN BY: RGW	CHECKED BY: EFH
DESIGNED BY: EFH	
DATE: 12-19-14	
LAST REV: 06-28-13 (RGW)	
PROJECT NO: 11-0091	
SHEET NO: 3	OF 5