


Waterline PROFILE

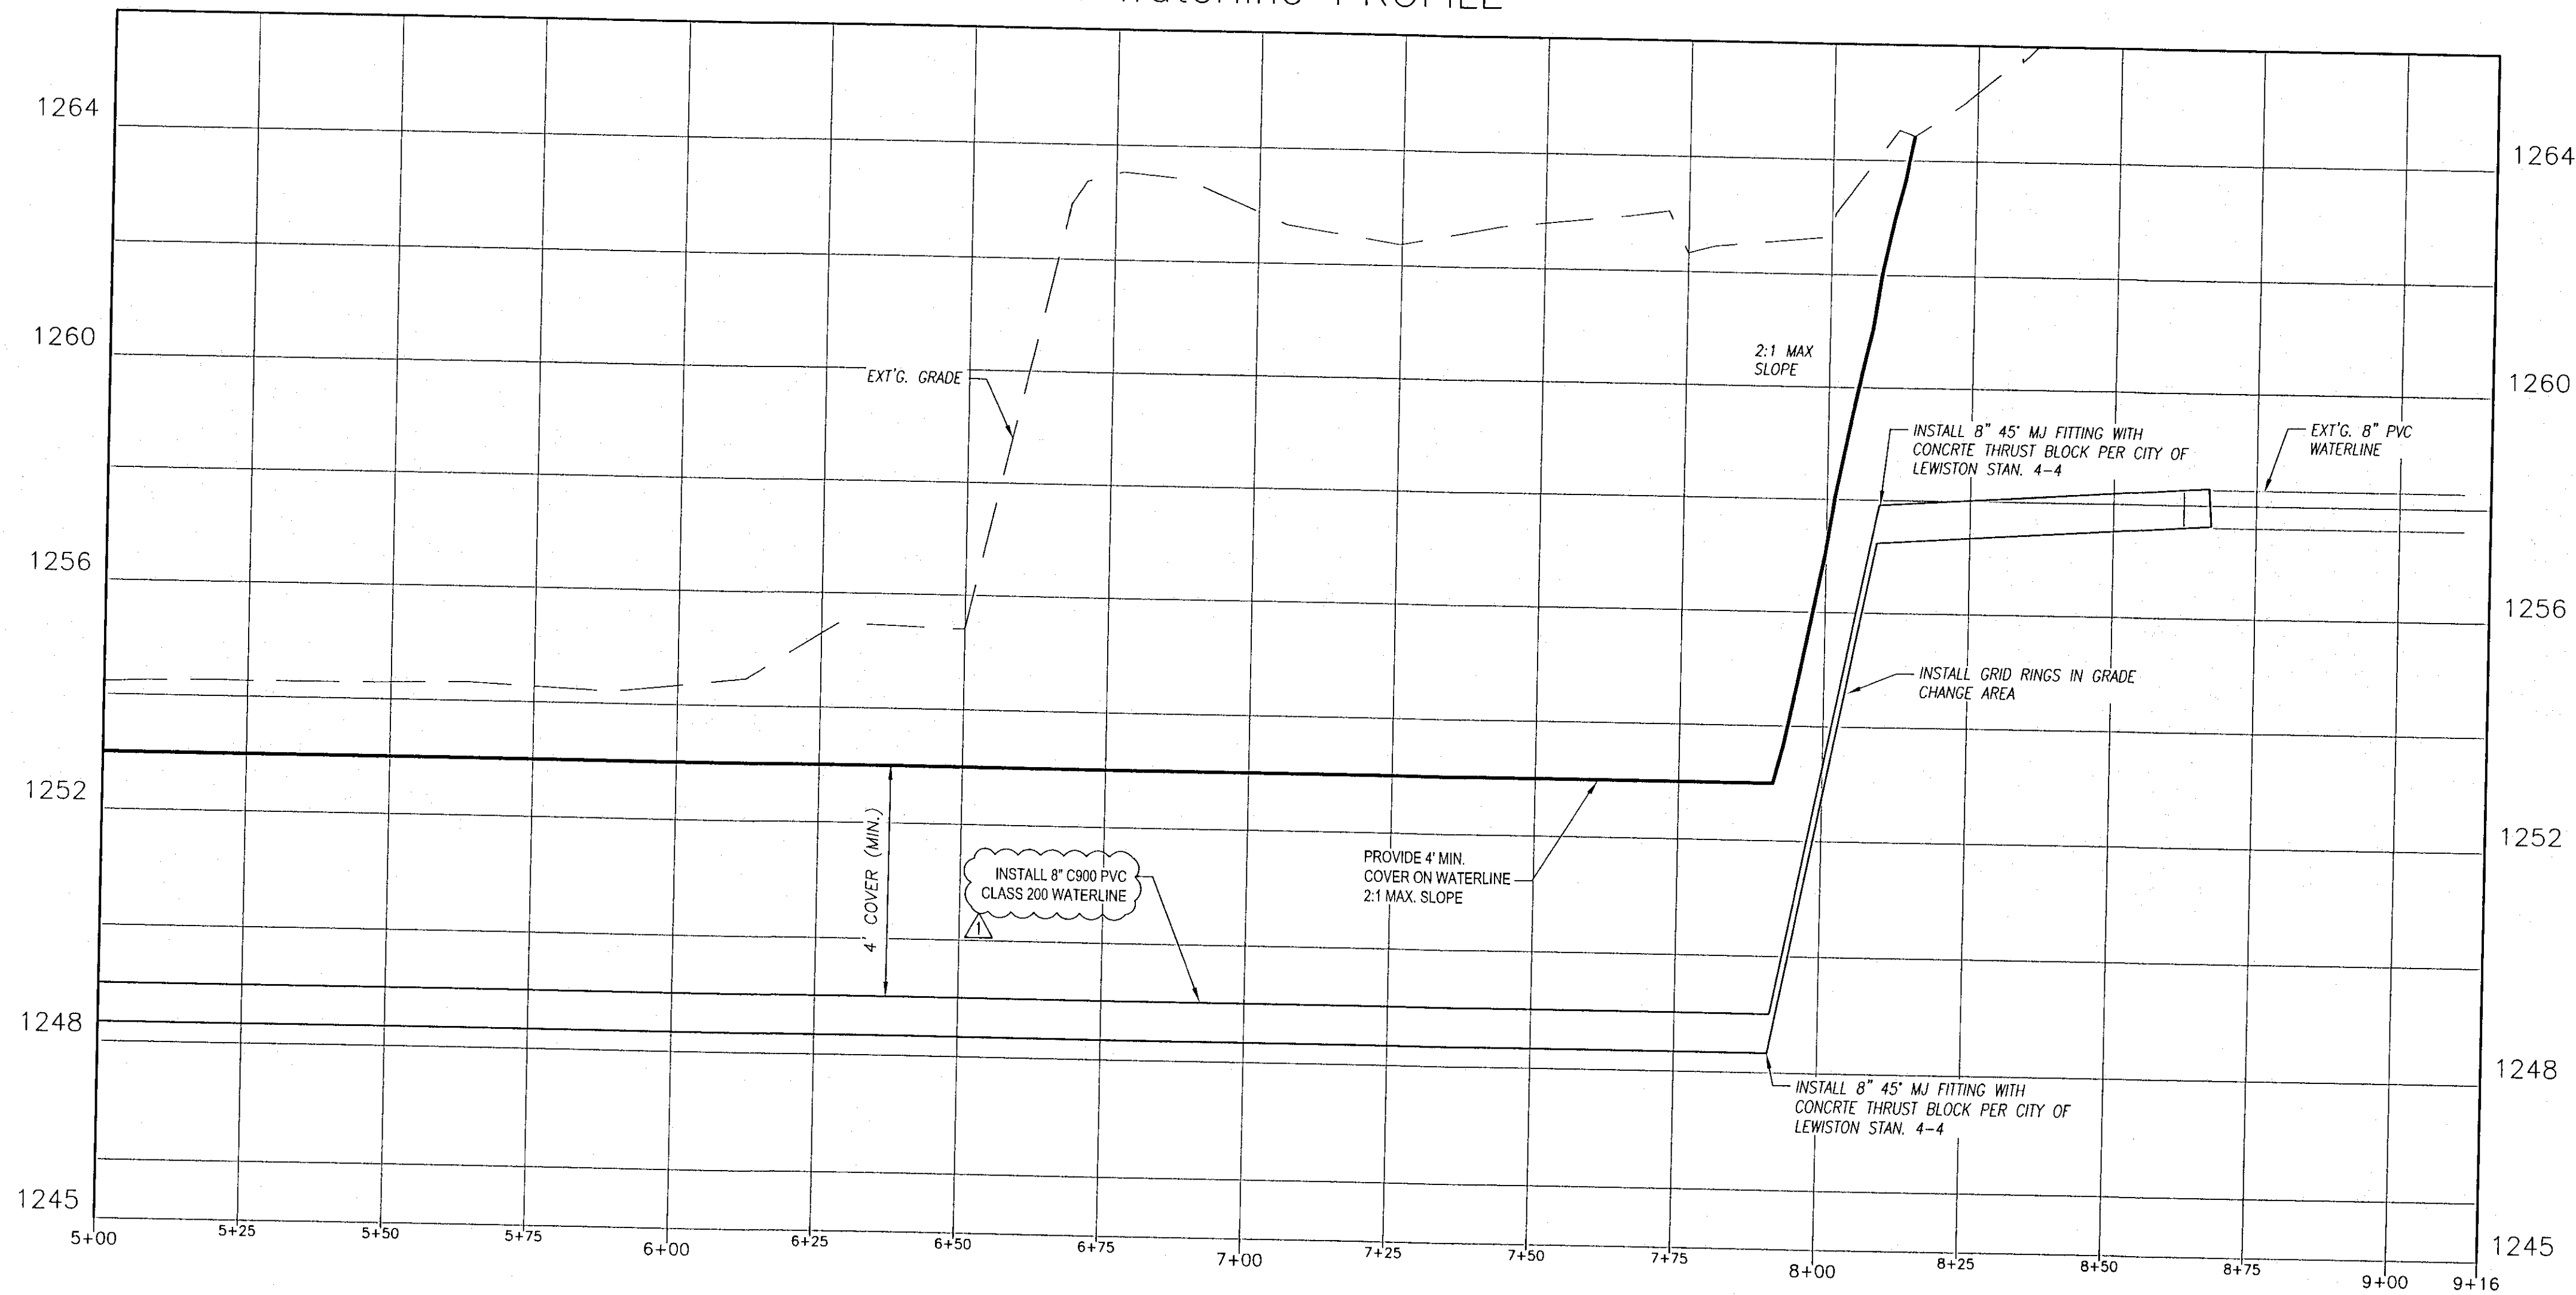


NOTE:



1. TRENCH BACKFILL ALONG THE EXISTING PATH SHALL CONFORM TO CITY STANDARD DWG 1-5, WITH THE EXCEPTION OF THE TOP SURFACE LAYER WHICH SHALL MATCH THE EXISTING GRAVEL TYPE & DEPTH.

DATE	BY	DESCRIPTION
6/18/12	RGW	CITY OF LEWISTON COMMENTS, 06-12-12
12/17/14	EFH	OWNER CHANGE

WATERLINE PLAN & PROFILE
NPP WATERLINE CONNECTION
BEDROCK, LLC.
LEWISTON, ID. 83501

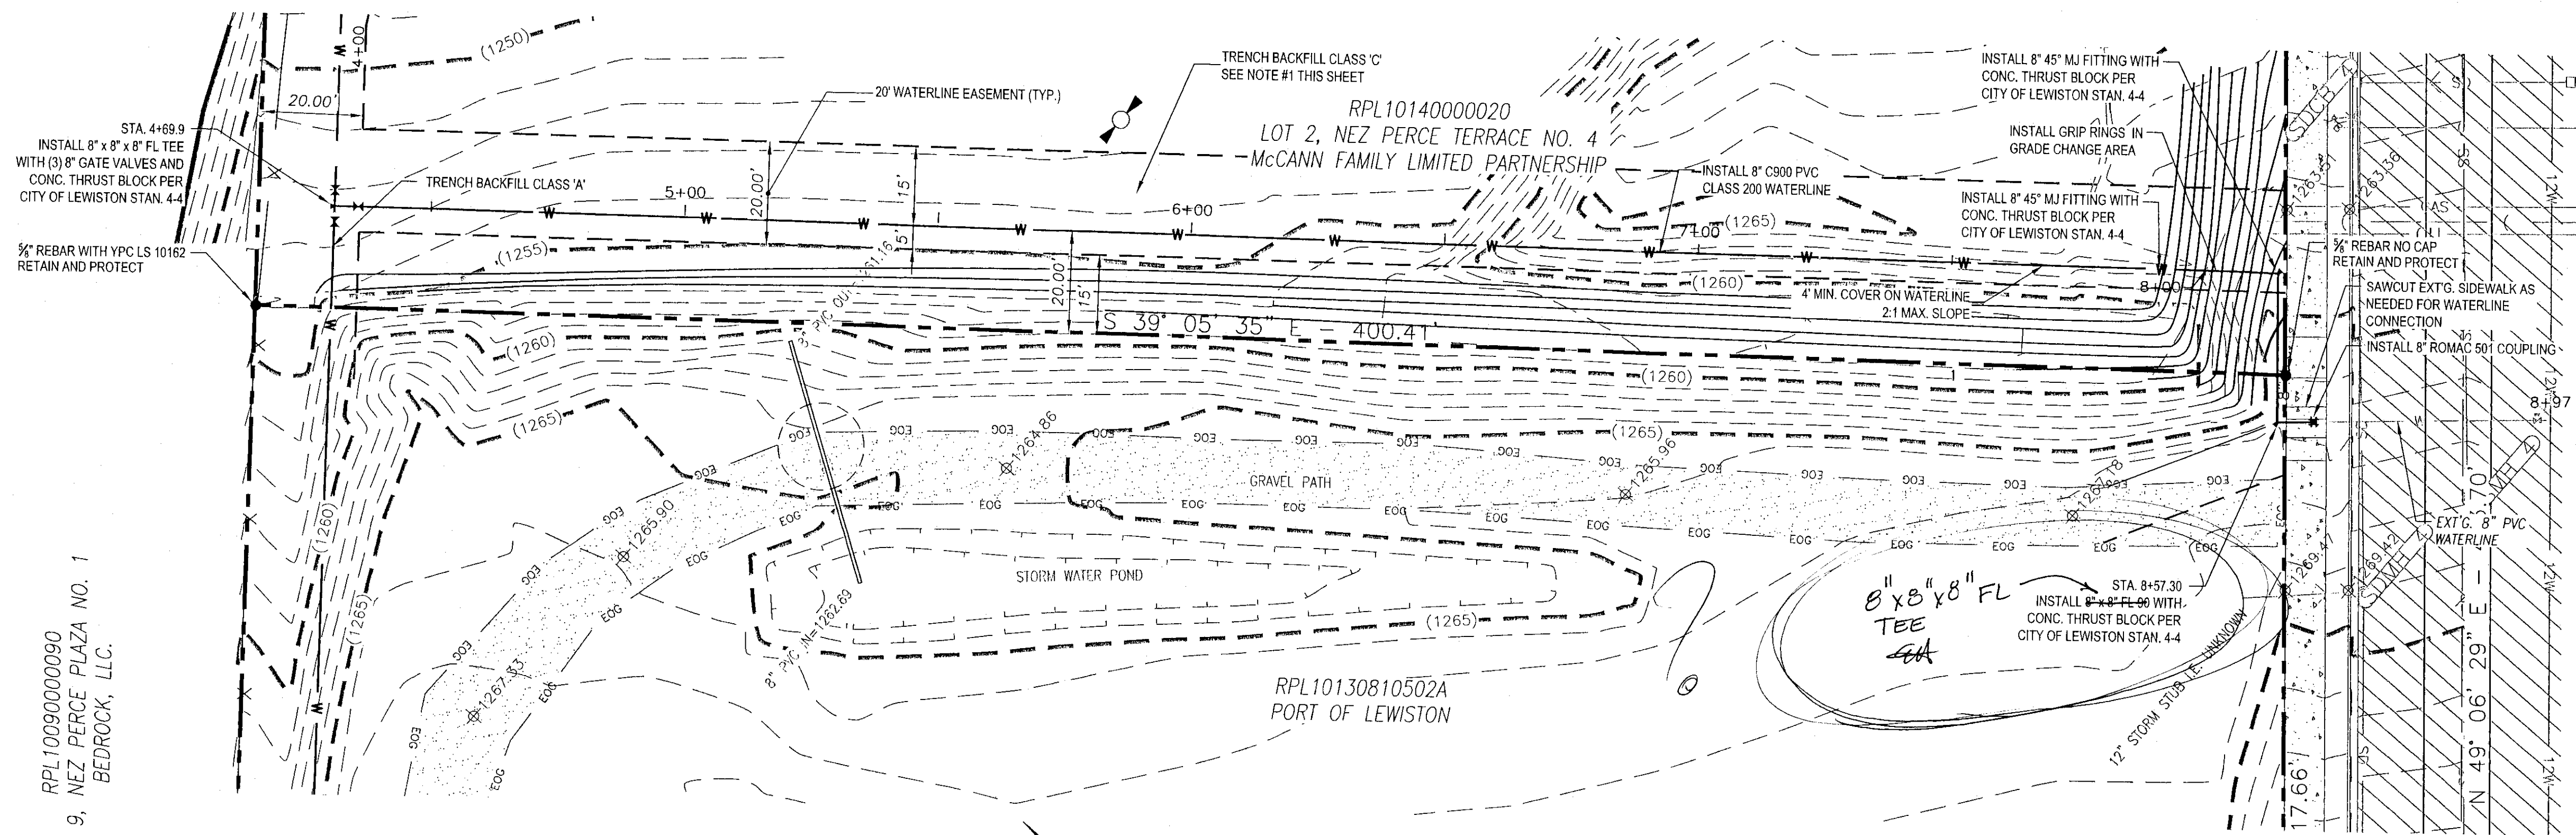


WATERLINE STA. 5+50 TO 9+16

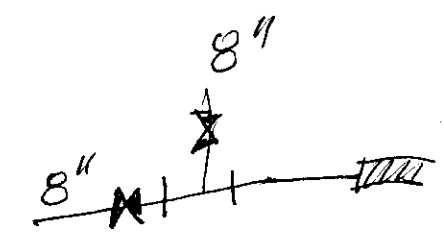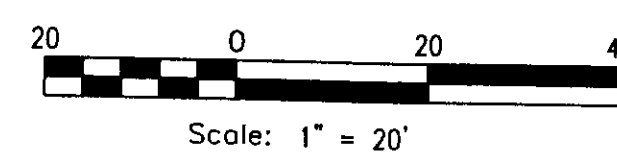

RPL100900000090
 LOT 9, NEZ PERCE PLAZA NO. 1
 BEDROCK, LLC.

KELTIC ENGINEERING, INC.
 315 Adams Lane • Lewiston, Idaho 83501 • (208) 743-2135 • (208) 743-2136 fax
 9425 North Nevada Street, Ste 204 • Spokane, WA 99218 • (509) 464-3000 • (509) 464-3005 fax
 • Development • Planning • Design • Construction Management

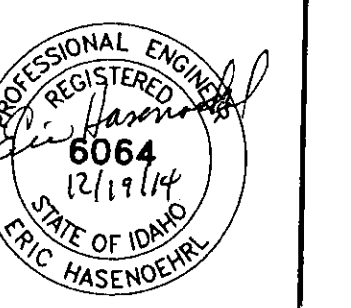

DRAWN BY:	RGW	CHECKED BY:	EFH
DESIGNED BY:	EFH		
DATE:	12-17-14		
LAST REV:	08-28-13 (RGW)		
PROJECT NO.	11-0091		
SHEET NO.	4	OF	5