



LEFT LIP OF GUTTER PROFILE

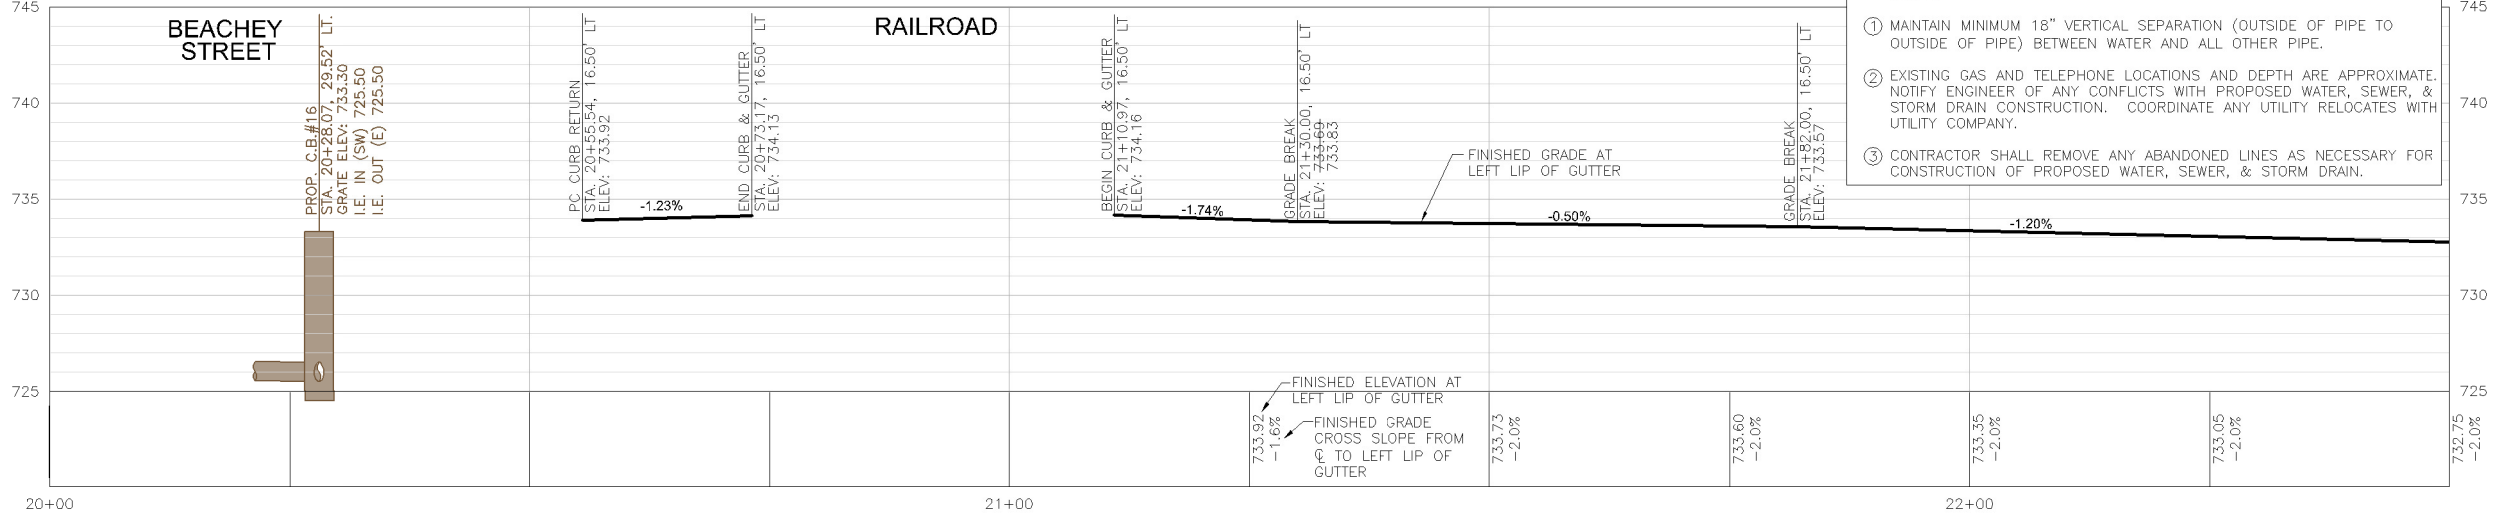

- NOTES:
- ① MAINTAIN MINIMUM 18" VERTICAL SEPARATION (OUTSIDE OF PIPE TO OUTSIDE OF PIPE) BETWEEN WATER AND ALL OTHER PIPE.
 - ② EXISTING GAS AND TELEPHONE LOCATIONS AND DEPTH ARE APPROXIMATE. NOTIFY ENGINEER OF ANY CONFLICTS WITH PROPOSED WATER, SEWER, & STORM DRAIN CONSTRUCTION. COORDINATE ANY UTILITY RELOCATES WITH UTILITY COMPANY.
 - ③ CONTRACTOR SHALL REMOVE ANY ABANDONED LINES AS NECESSARY FOR CONSTRUCTION OF PROPOSED WATER, SEWER, & STORM DRAIN.

CENTERLINE PROFILE

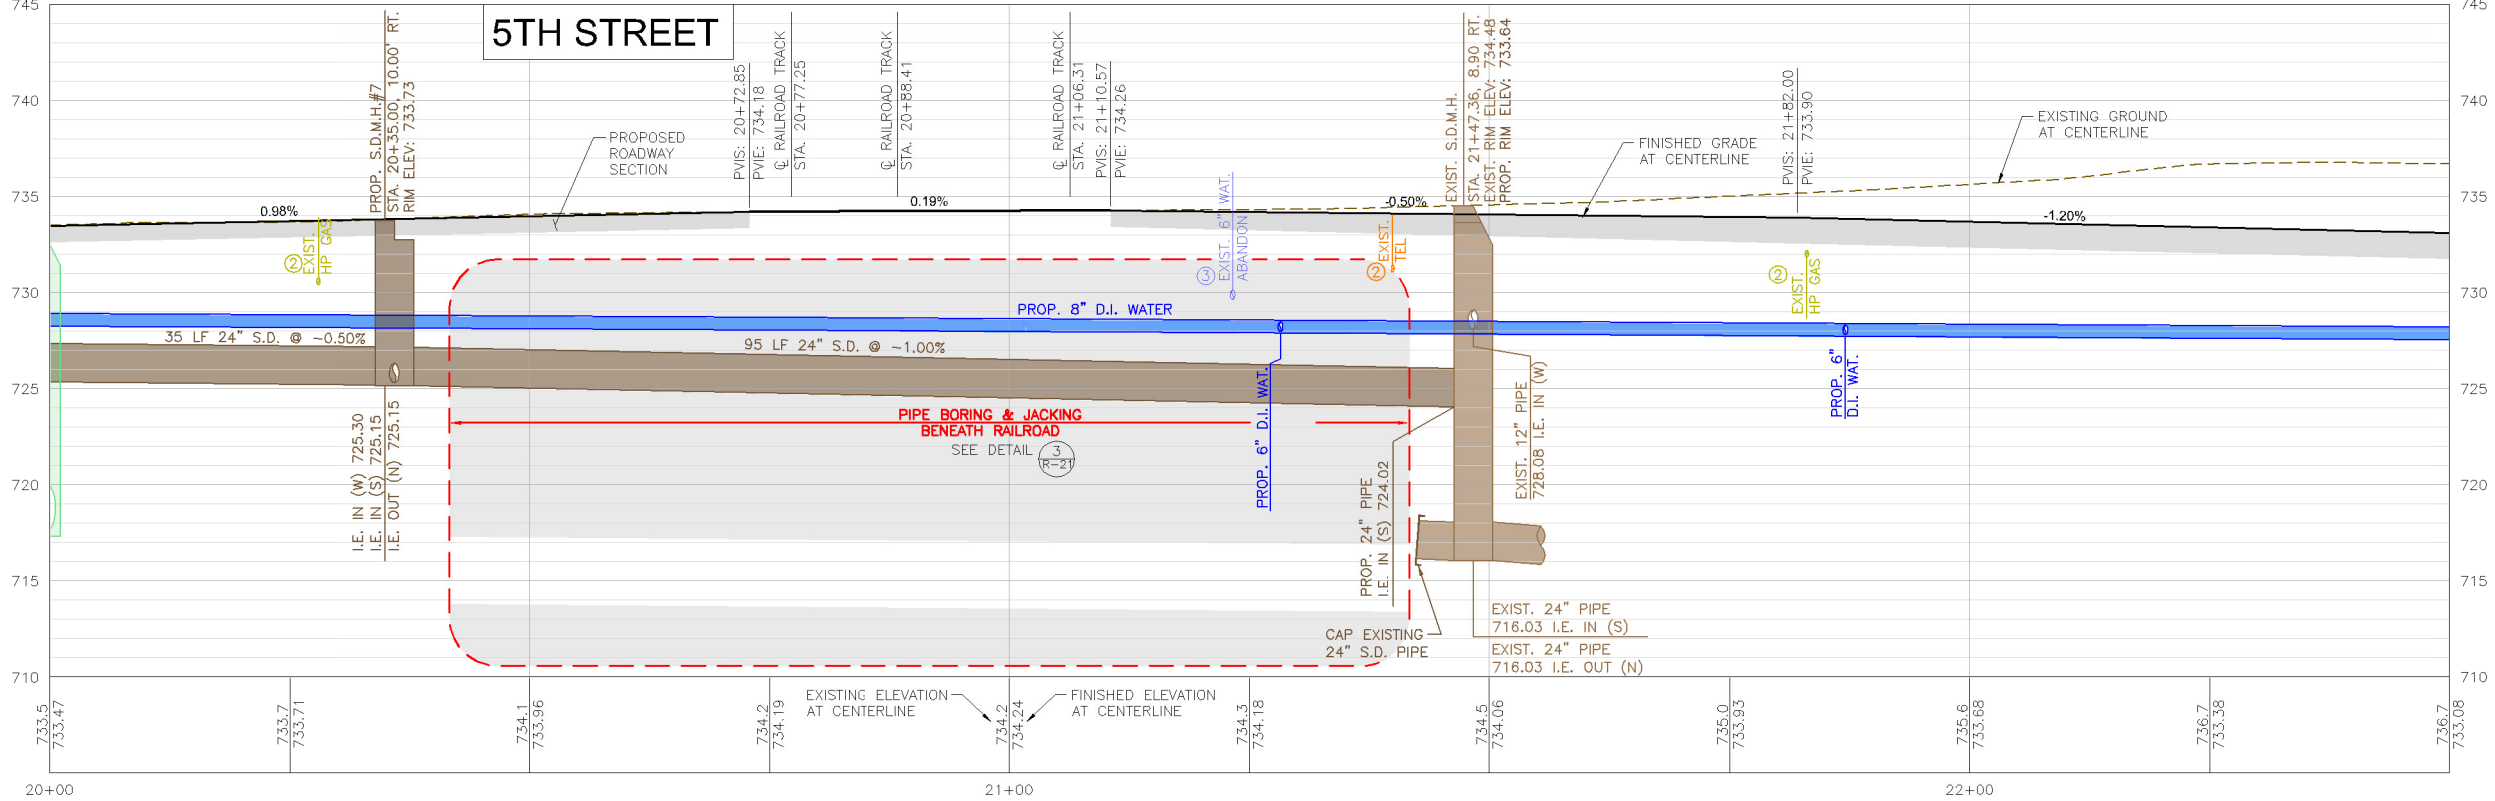

RIGHT LIP OF GUTTER PROFILE



CONTRACT PLANS

PROFESSIONAL ENGINEER
REGISTERED
STATE OF IDAHO
DAVID L. WITTMAN

REVISIONS
BY HRC
DESCR
DATE 12/11/12
DESCR Raise grade 6" and remove curb cuts

BY
DESCR
DATE
BY
DESCR
DATE

TD&H
Engineering

1dengineering.com
1000 N. 10th St.
SPRINGFIELD
WASHINGTON
LEWISTON
IDAHO

DRAWN BY: CCK
DESIGNED BY: DLW
QUALITY CHECK: CKW
DATE: 04-06-12
JOB NO. L11-016
FIELDBOOK N/A

DOWNTOWN LEWISTON STREETSCAPE (5TH STREET)
LEWISTON, IDAHO

ROADWAY PROFILES

R-5D.DWG
SHEET R-5D