




LEFT LIP OF GUTTER PROFILE

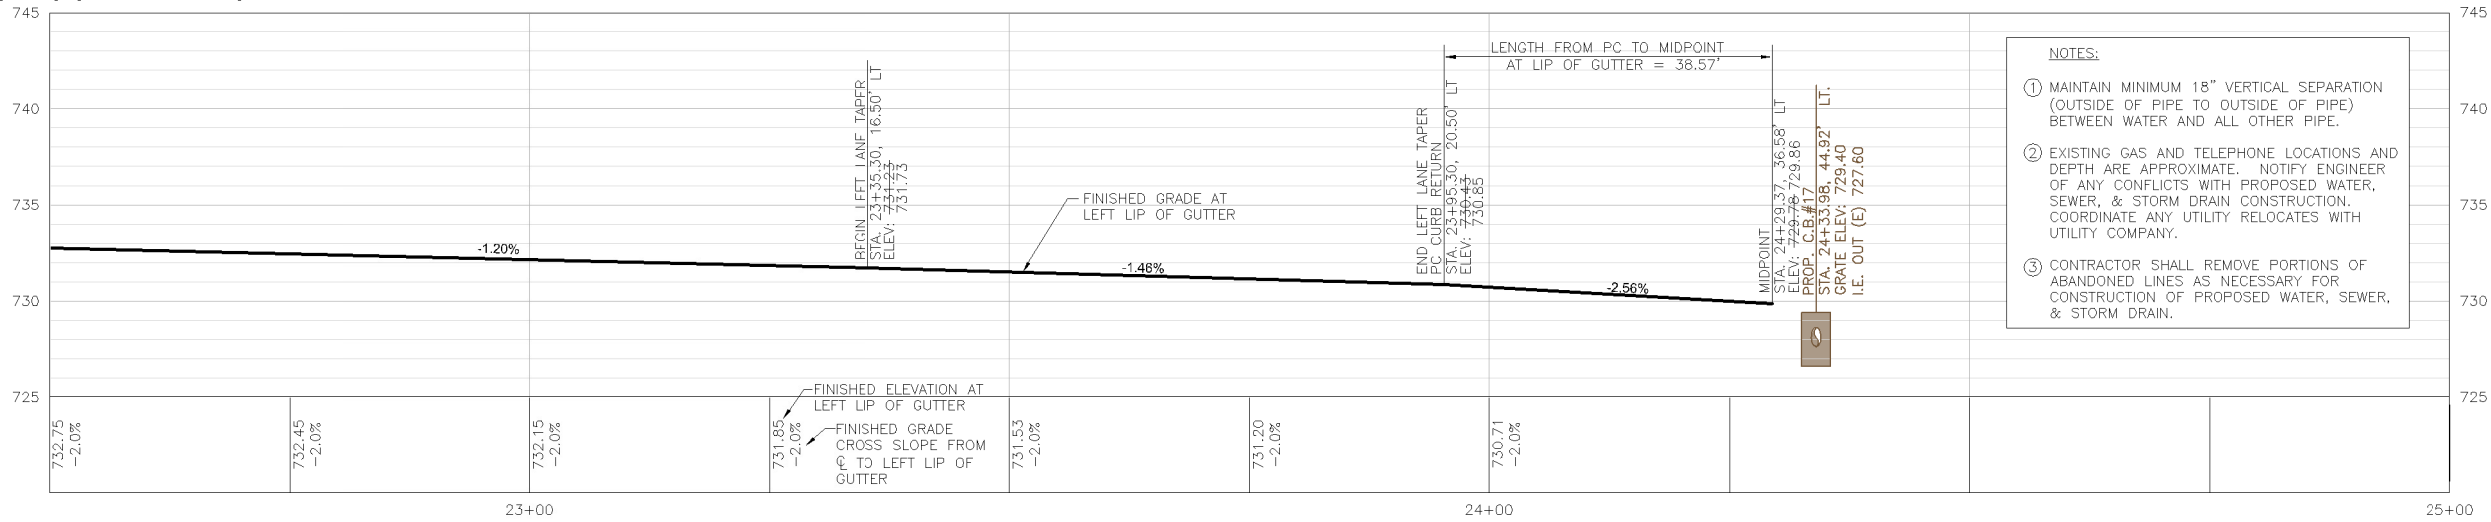

CENTERLINE PROFILE

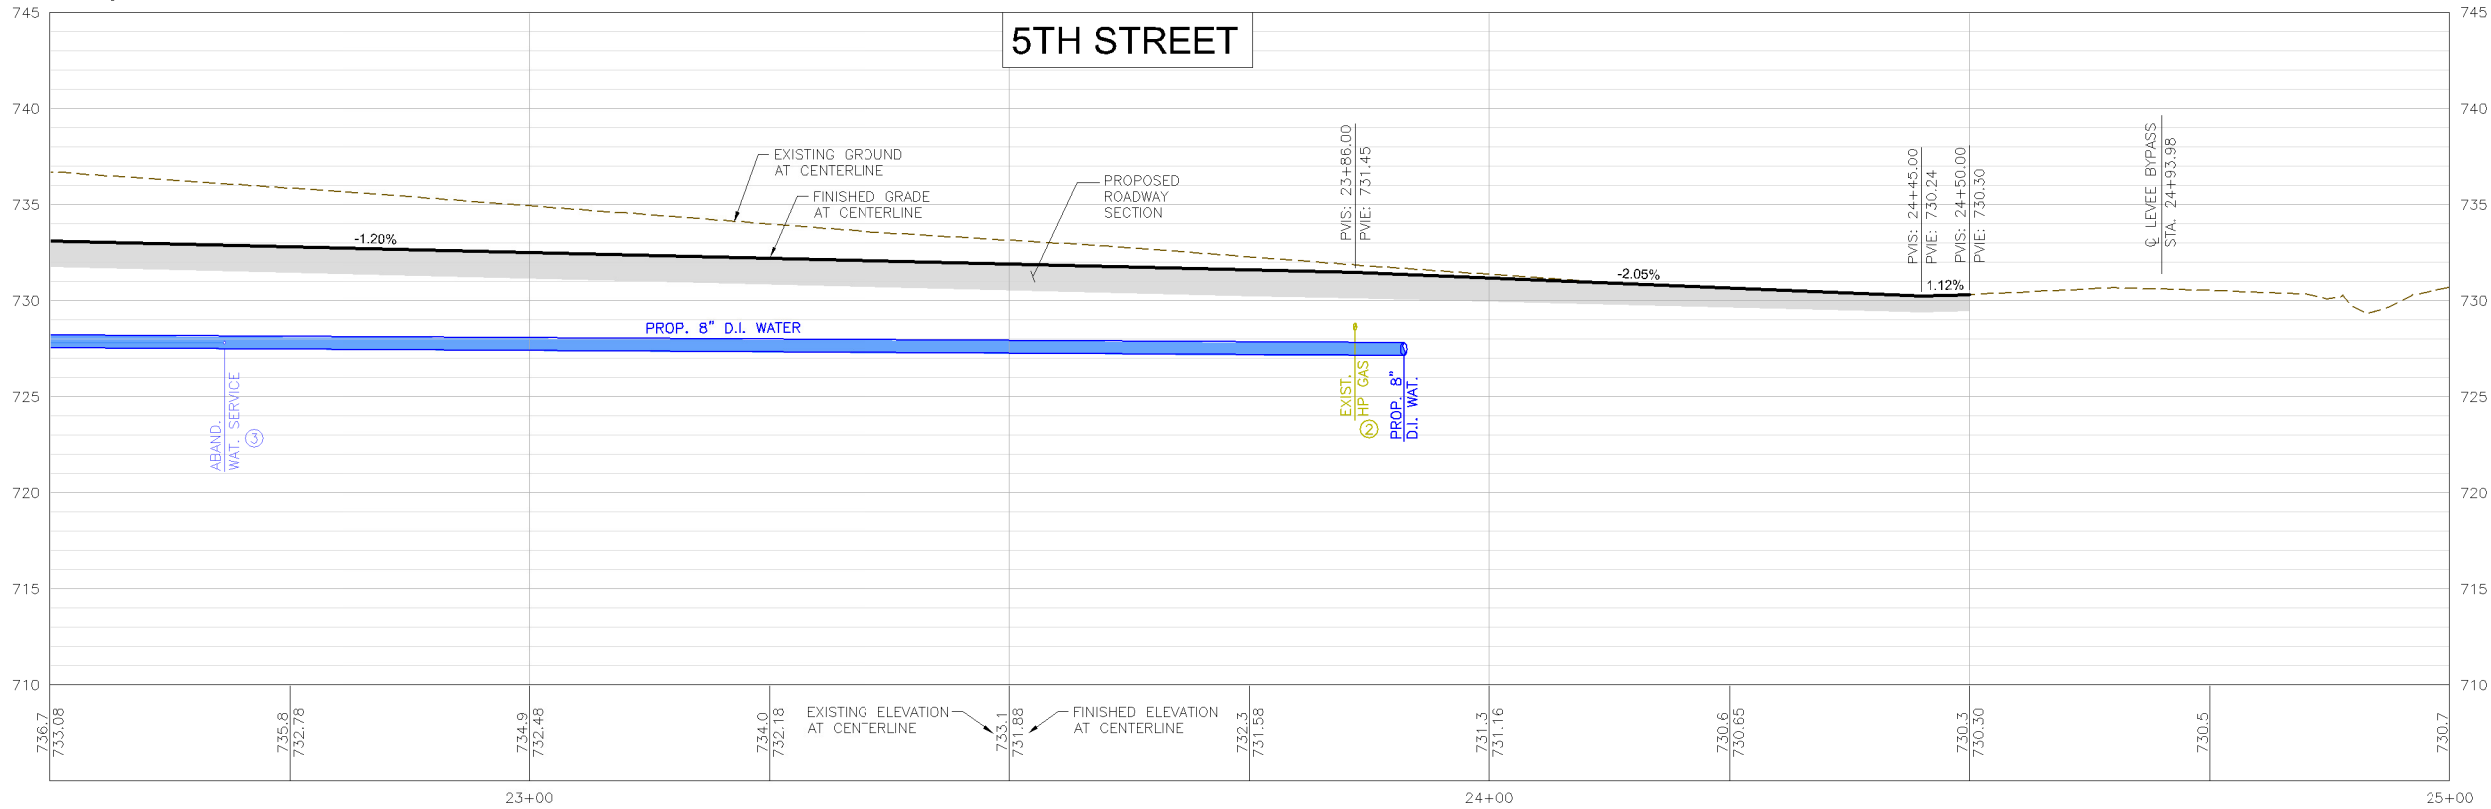

RIGHT LIP OF GUTTER PROFILE

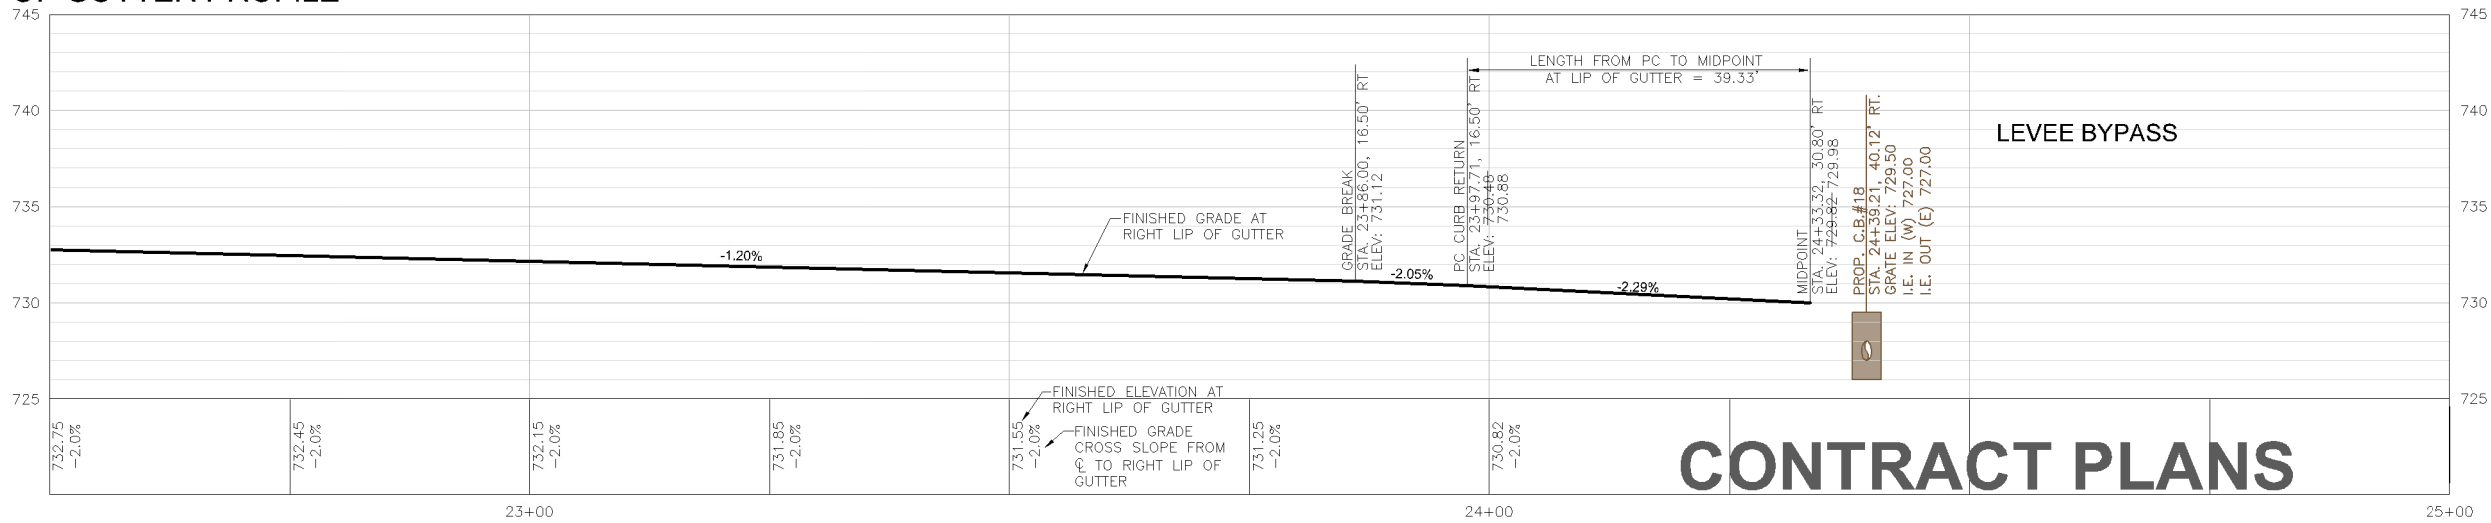

CONTRACT PLANS

PROFESSIONAL ENGINEER
REGISTERED
DAVID L. WITTHAUS
STATE OF IDAHO

REVISIONS
BY HRC
DESCR Base grade 6" & remove curb cuts
DATE 12/11/12
BY
DESCR
DATE
BY
DESCR
DATE

TD&H
Engineering
1dengineering.com
1000 N. 10th St.
SPRINGFIELD
WASHINGTON
LEWISTON
IDAHO

DESIGNED BY: DLW
QUALITY CHECK: CKW
DATE: 04-06-12
JOB NO. L11-016
FIELDBOOK N/A

DRAWN BY: CCK

DOWNTOWN LEWISTON STREETSCAPE (5TH STREET)
LEWISTON, IDAHO

ROADWAY PROFILES

R-6D.DWG
SHEET R-6D