


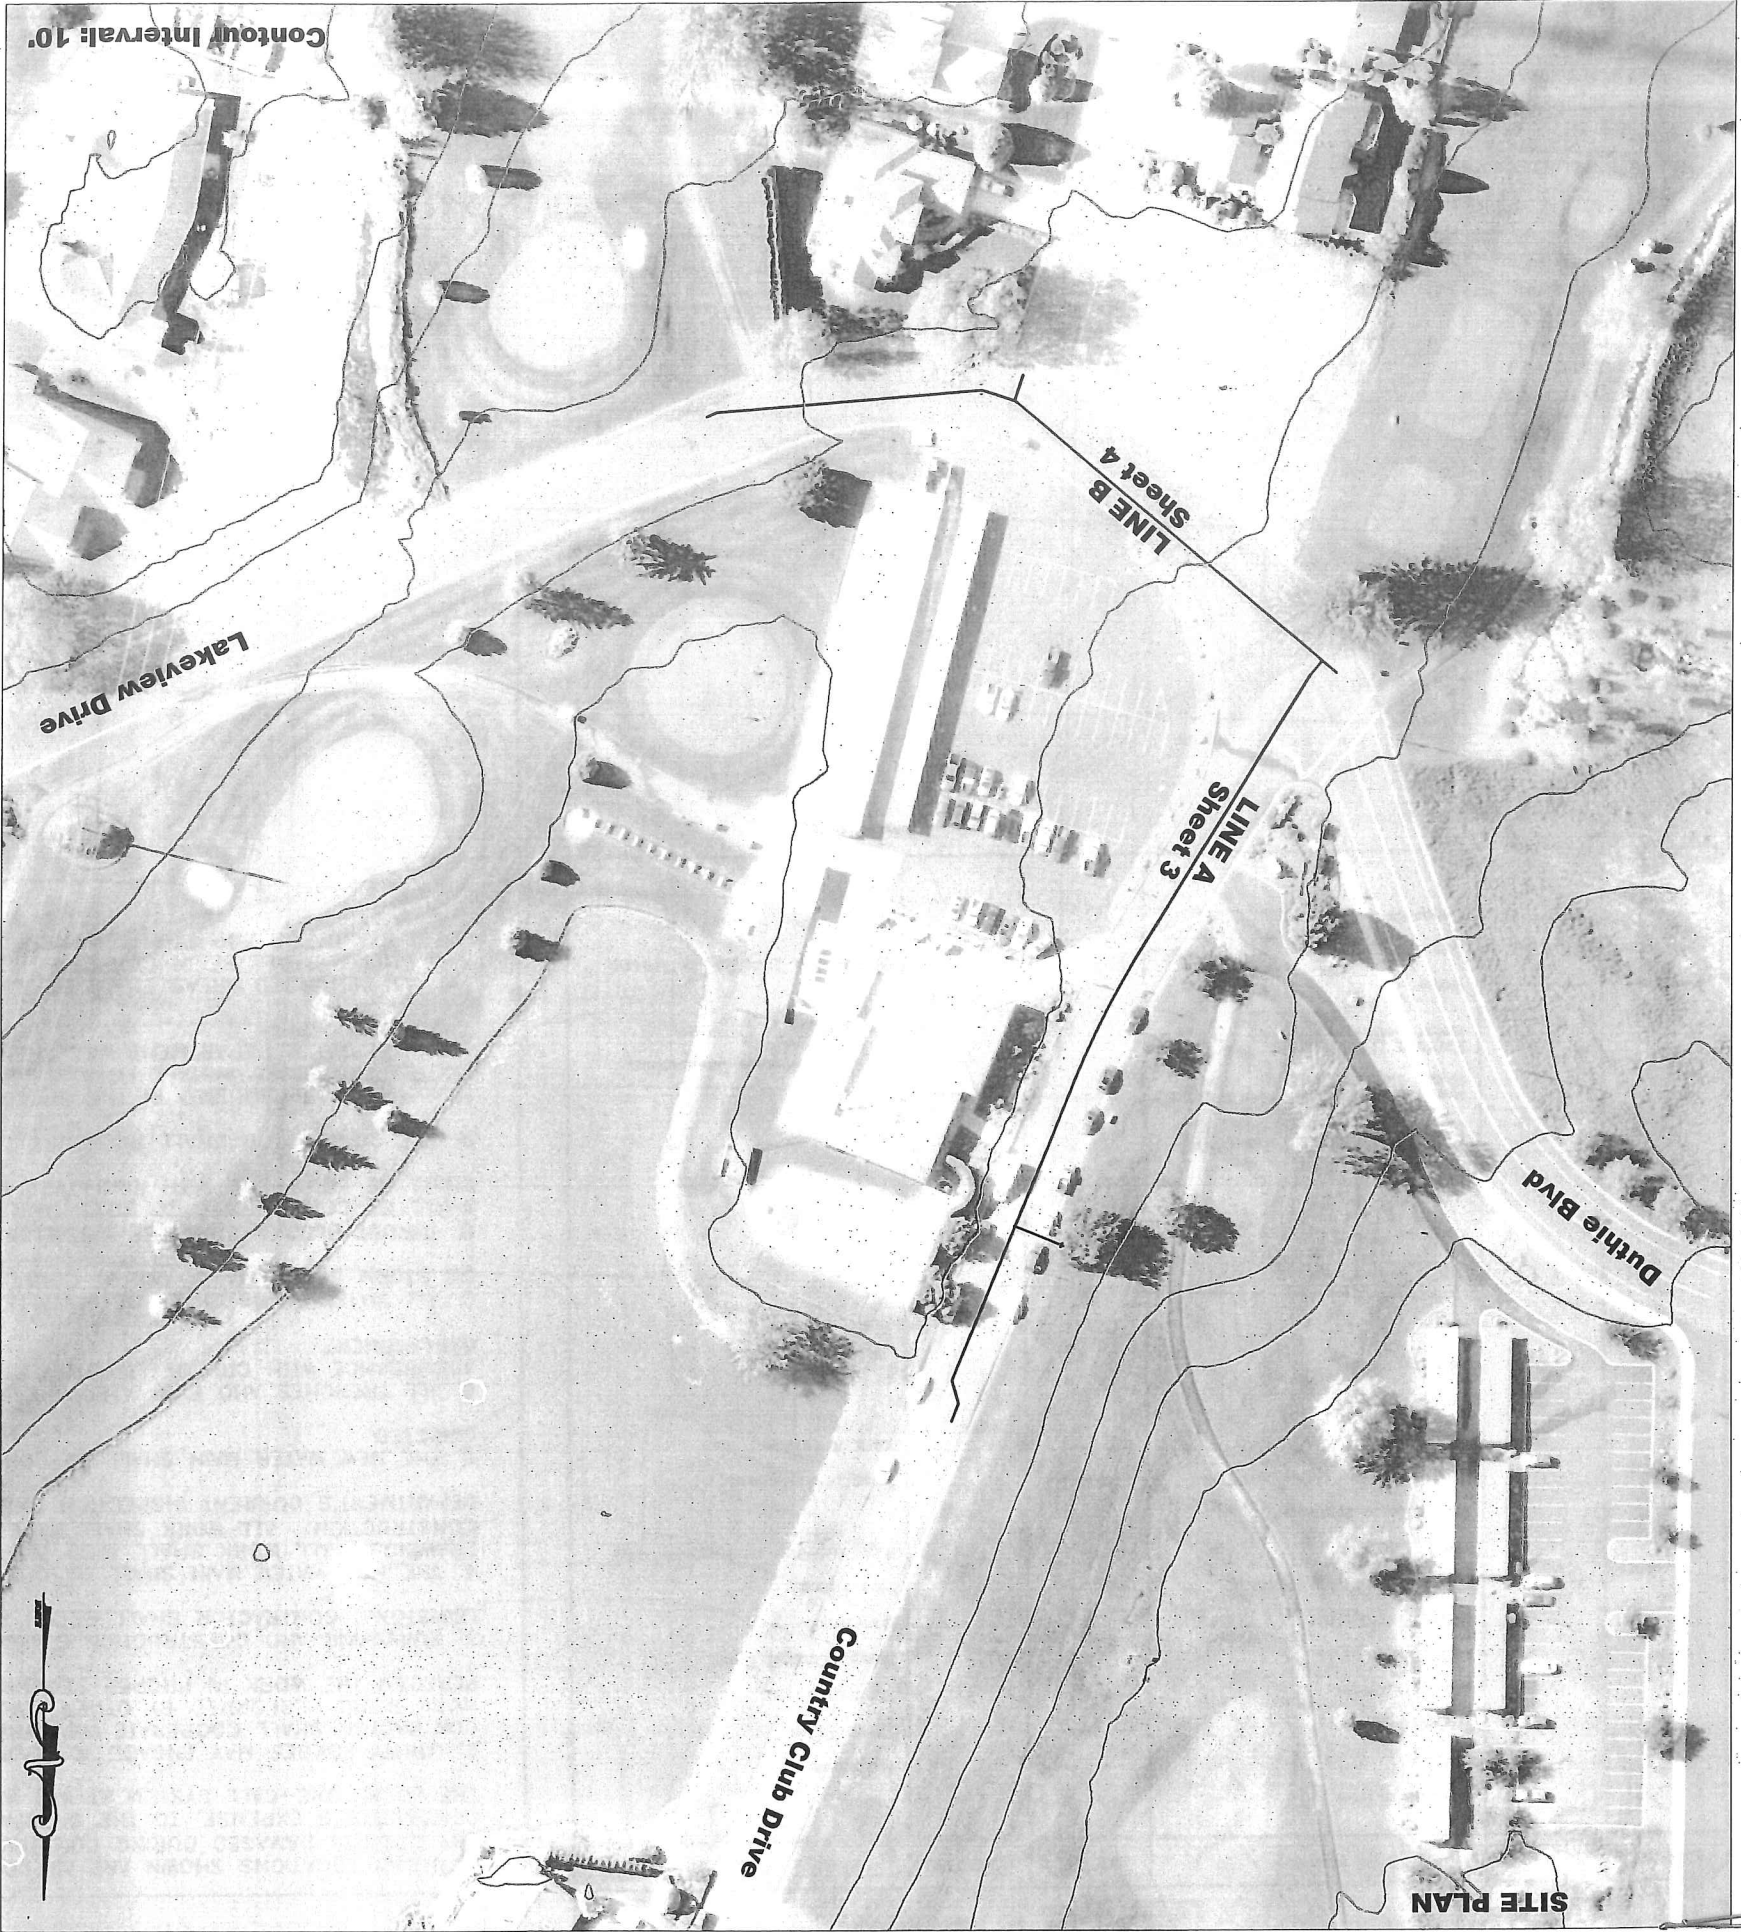

Contour Interval: 10'


SITE PLAN

VICINITY MAP


1. Site Plan & Vicinity Map
2. Legend & Construction Notes
3. Plan & Profile - Line A
4. Plan & Profile - Line B
5. Phasing Plan

SHEET INDEX

Constructed

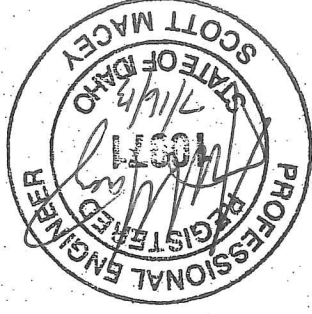

Location of Project:
Lewiston, Idaho

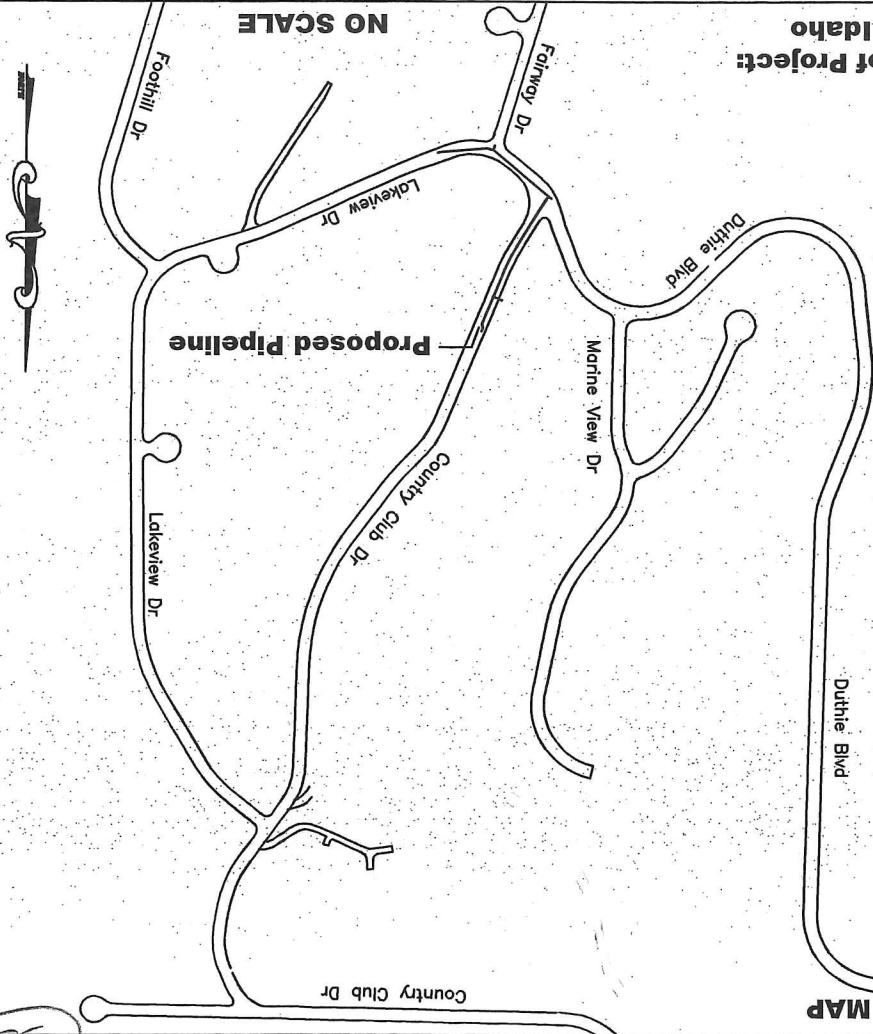

NO SCALE

Proposed Pipeline

WATER DEPARTMENT
SITE PLAN & VICINITY MAP
Duthie Blvd & Country Club Dr
Water Main Replacement

REVISIONS				DESIGNED BY:	S.M.	SCALE:	1"=100' (11x17)
NO.	DATE	FILENAME	DESCRIPTION	BY	JOB NO.	DRAWN BY:	DATE:
						S.M.	MAY 2013
						D.S.	
						CHECKED BY:	DRAWING NO.:
							slipplan.dwg
							SHEET 1 OF 5

CITY OF LEWISTON
PUBLIC WORKS DEPARTMENT
ENGINEERING SERVICES
28 D STREET LEWISTON, ID 83501
(208) 746-6316

