

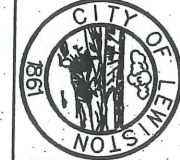
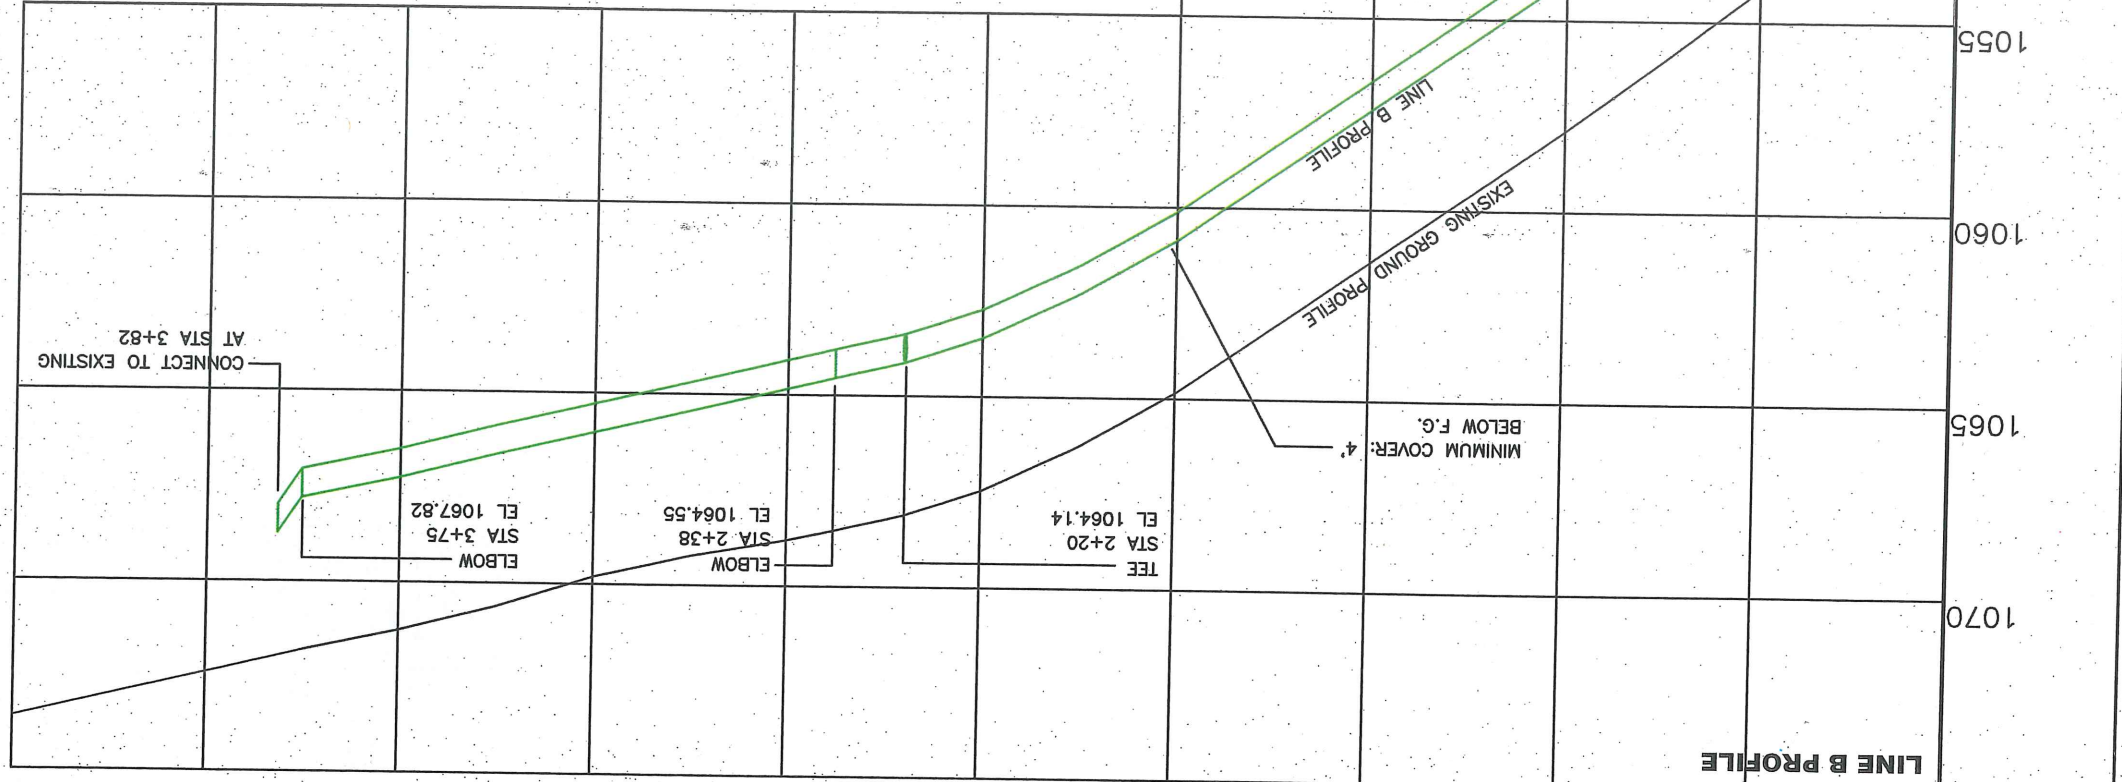
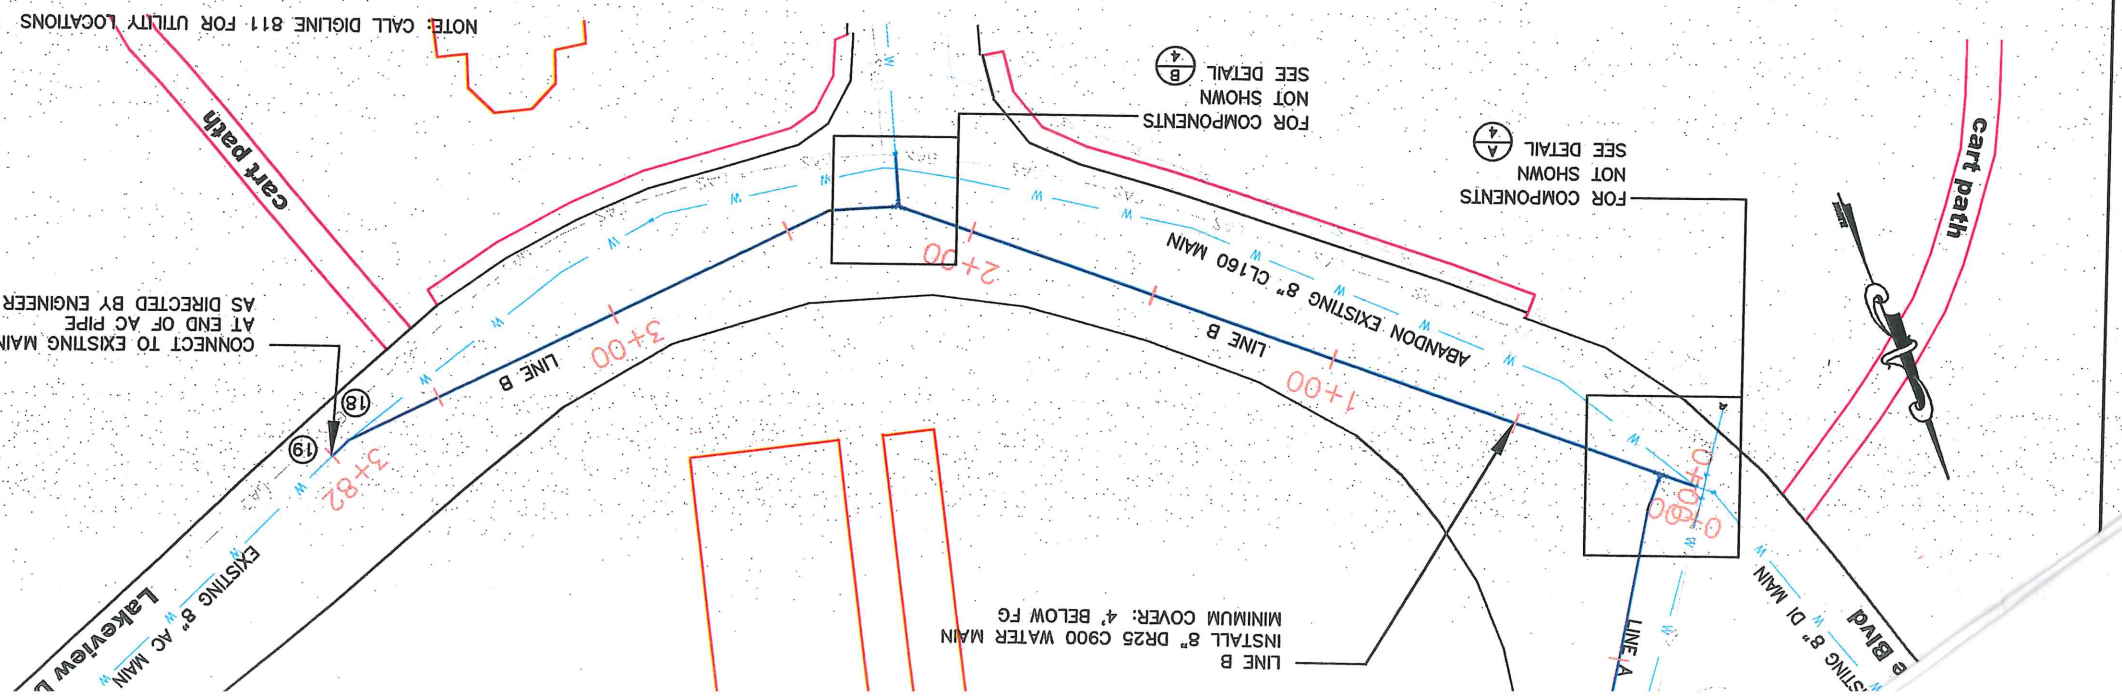


NO.	DATE	FILENAME	DESCRIPTION	BY	JOB NO.

WATER DEPARTMENT
 PLAN & PROFILE
 Duthie Blvd & Country Club Dr
 Water Main Replacement


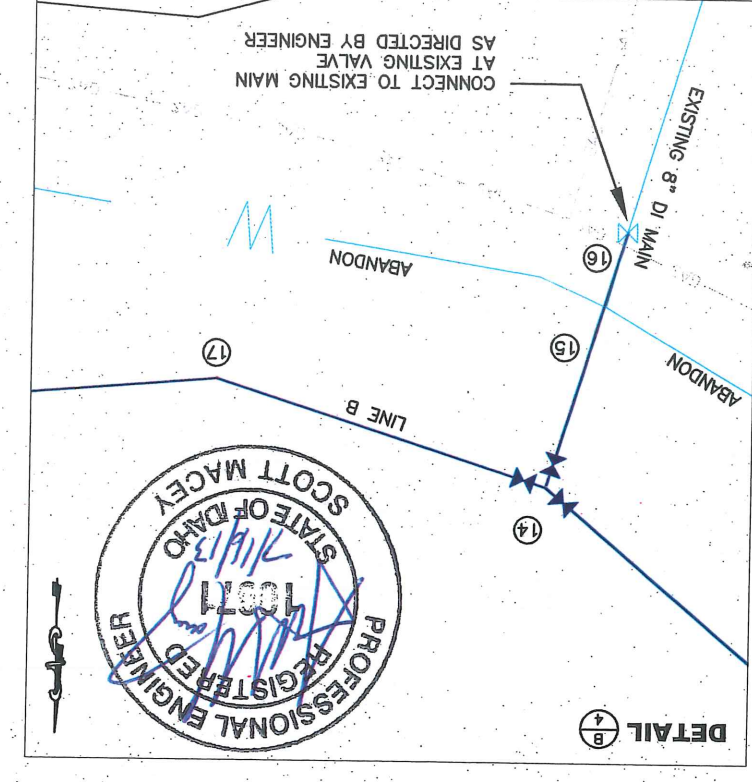


CITY OF LEWISTON
 PUBLIC WORKS DEPARTMENT
 ENGINEERING SERVICES
 26 D STREET LEWISTON, ID 83501
 (209) 746-816

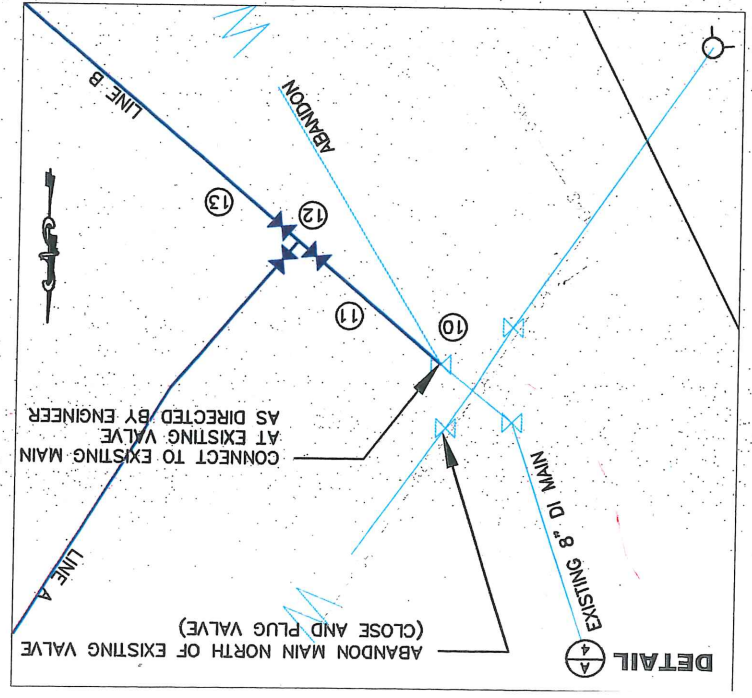

TAG	LINE	STA	FITTINGS
10	B	0+00	CONNECT TO EXISTING
11	B	0+05	8" MJ SOLID SLEEVE
12	B	0+10	8" FL TEE
13	B	0+32	8" FL x MJ GV (M.N.E)
14	B	2+20	8" FL TEE
15	A-4	15	8" PC150 DI PIPE - 14 LF
16	B-4	16	CONNECT TO EXISTING
17	B	2+38	8" MJ 22 ELL
18	B	3+75	8" MJ 22 ELL
19	B	3+82	8" MJ SOLID SLEEVE (2)
			CONNECT TO EXISTING

WATER MAIN SCHEDULE

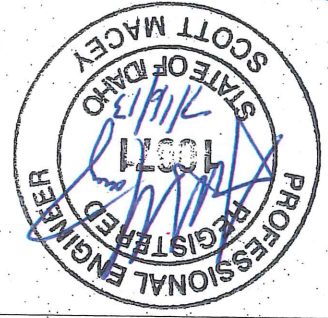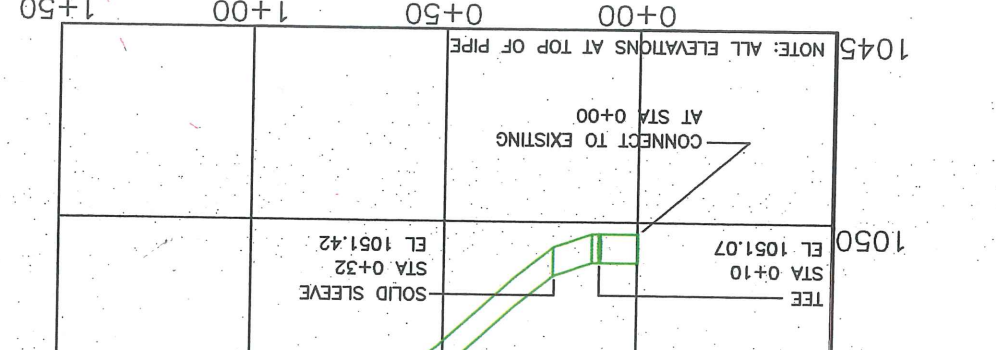

DETAIL A



DETAIL B

LINE B PROFILE

WATER MAIN SCHEDULE




NO.	DATE	FILENAME	DESCRIPTION	BY	DESIGNED BY	CHECKED BY	DRAWN BY	S.I.M.

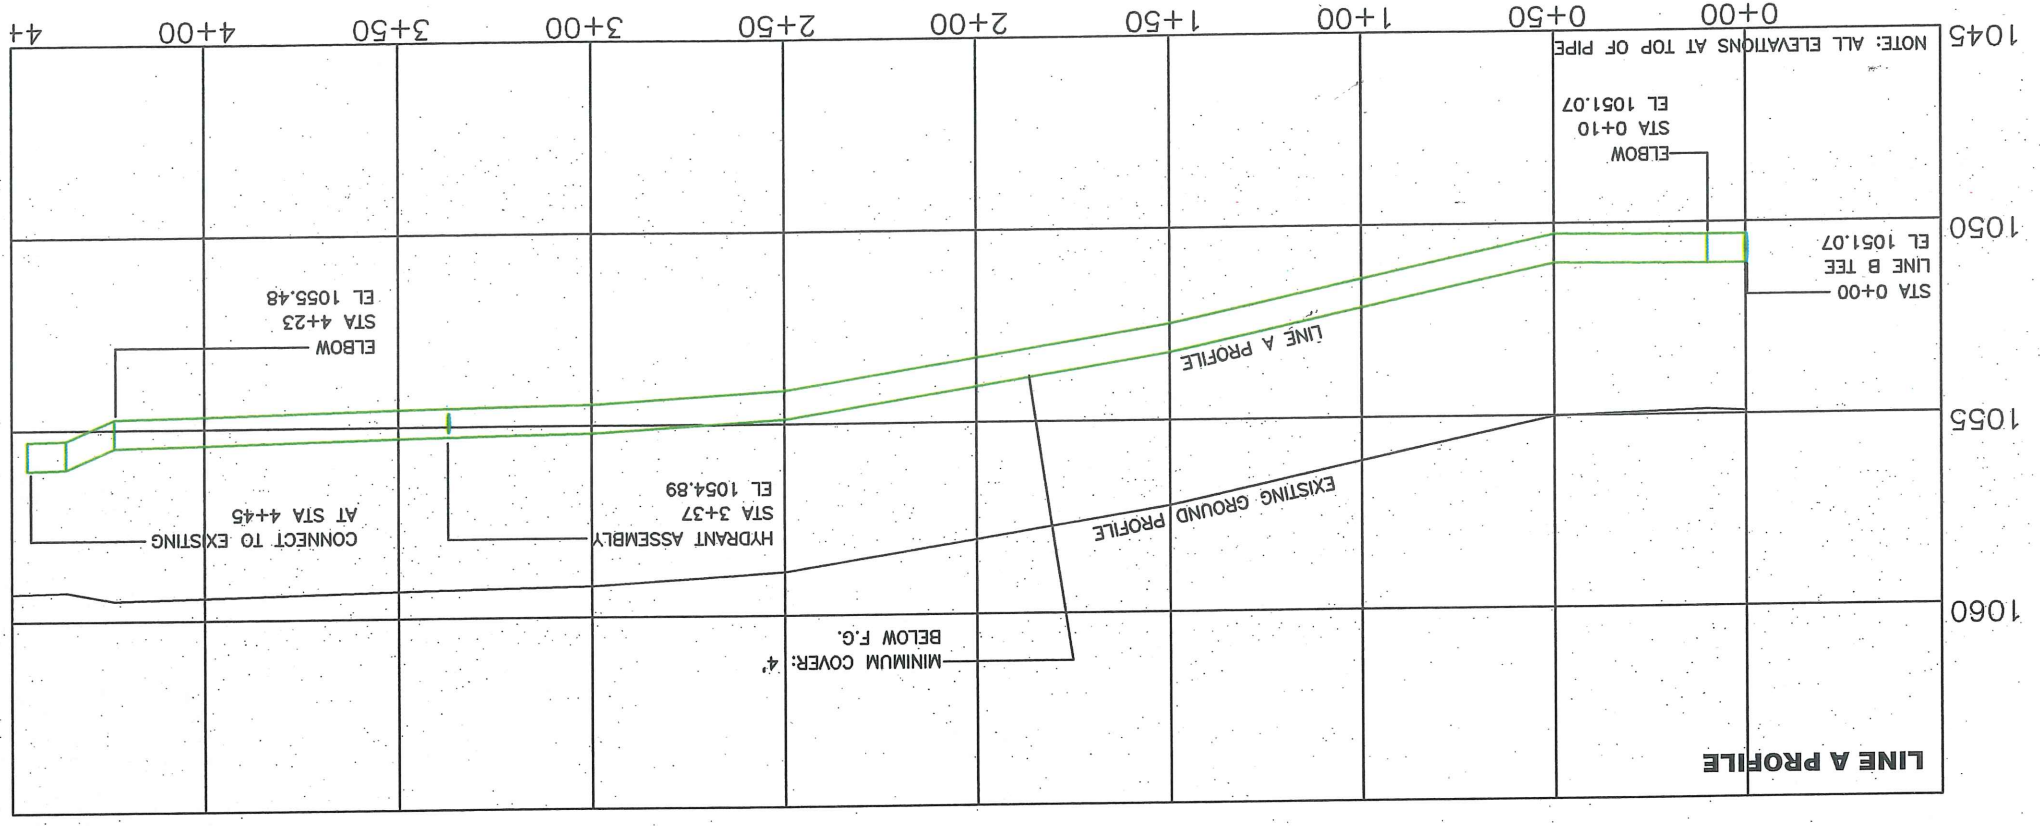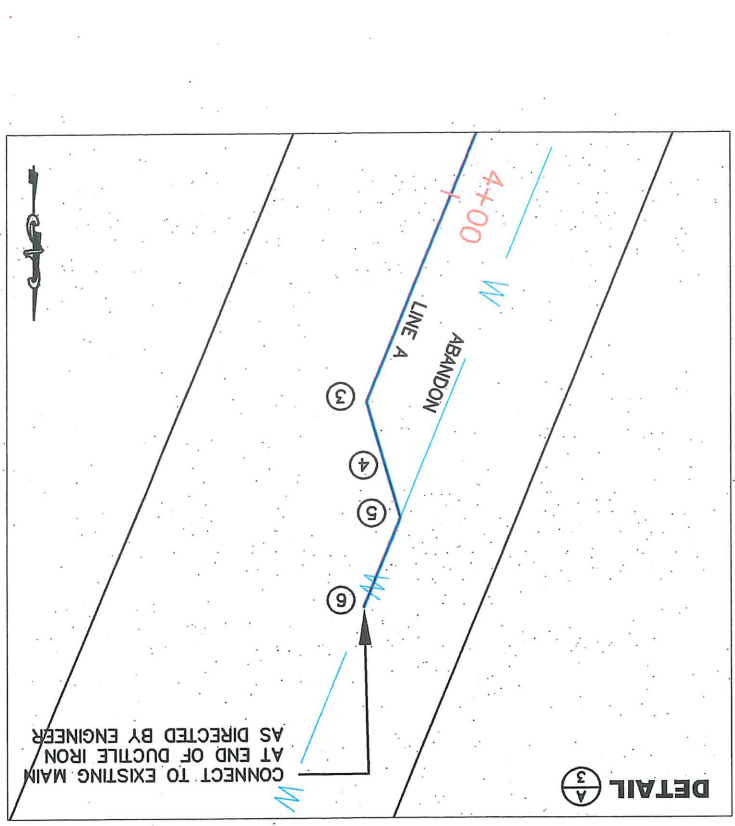

WATER MAIN SCHEDULE

TAG	LINE	STA	FITTINGS
1	A	0+10	8" MJ 11 ELL
2	A	3+37	8" x 6" MJ x FL TEE
3	A	4+23	8" MJ 45 ELL
4	A	4+29	8" MJ SOLID SLEEVE
5	A	4+35	8" MJ 45 ELL
6	A	4+45	8" MJ SOLID SLEEVE
7-9			NOT USED

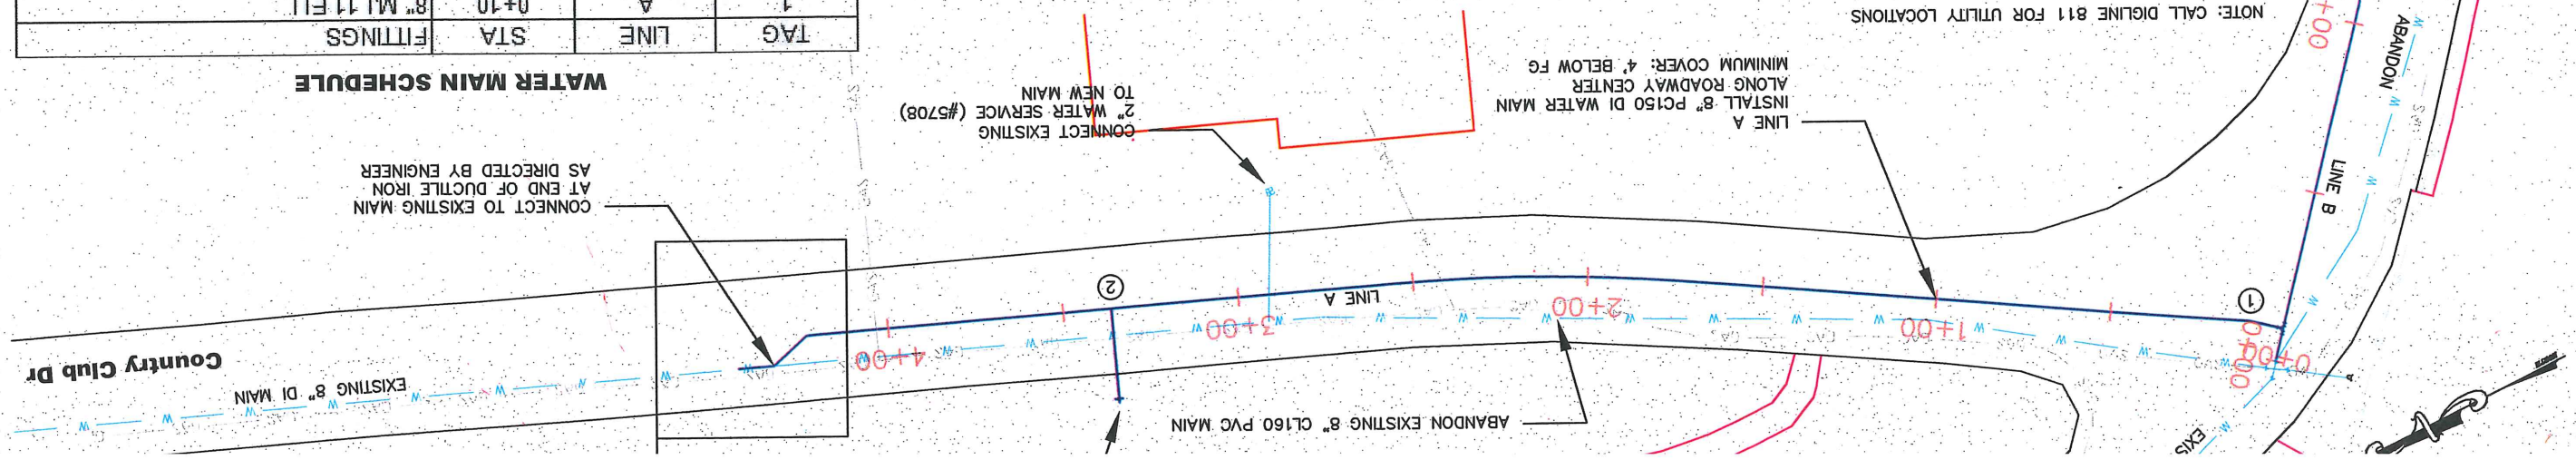

CONNECT TO EXISTING MAIN
 AT END OF DUCTILE IRON
 AS DIRECTED BY ENGINEER

