

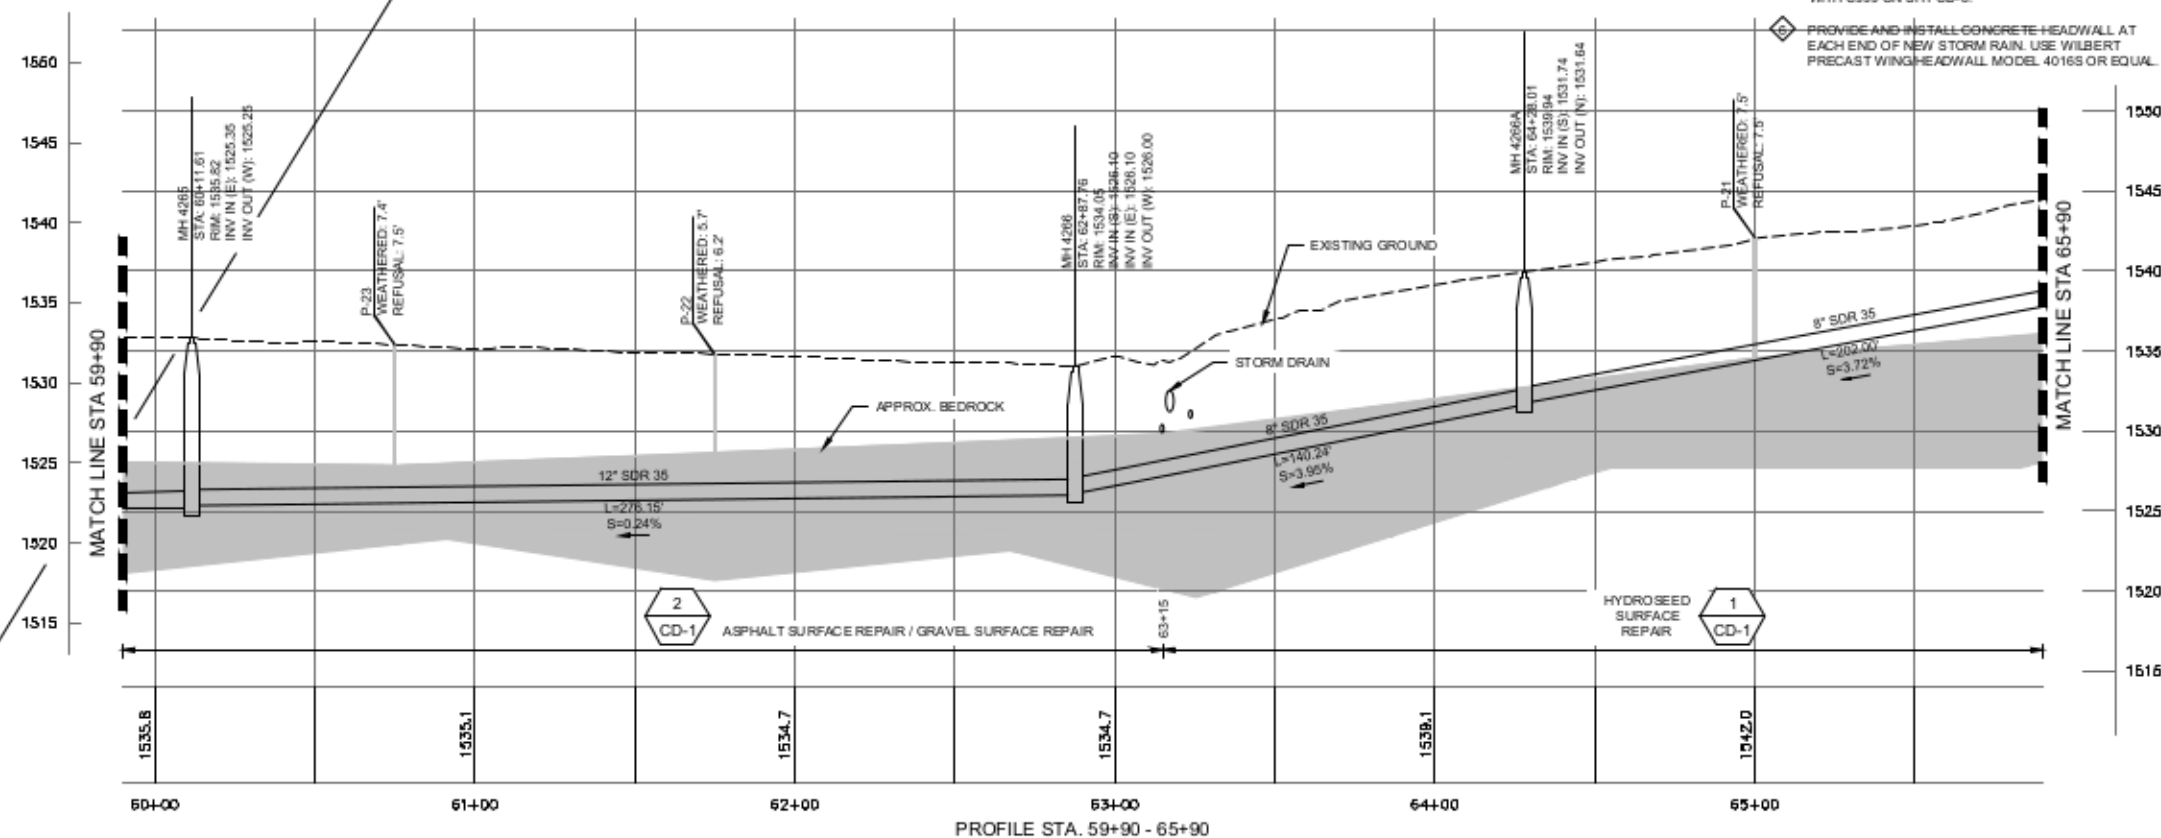
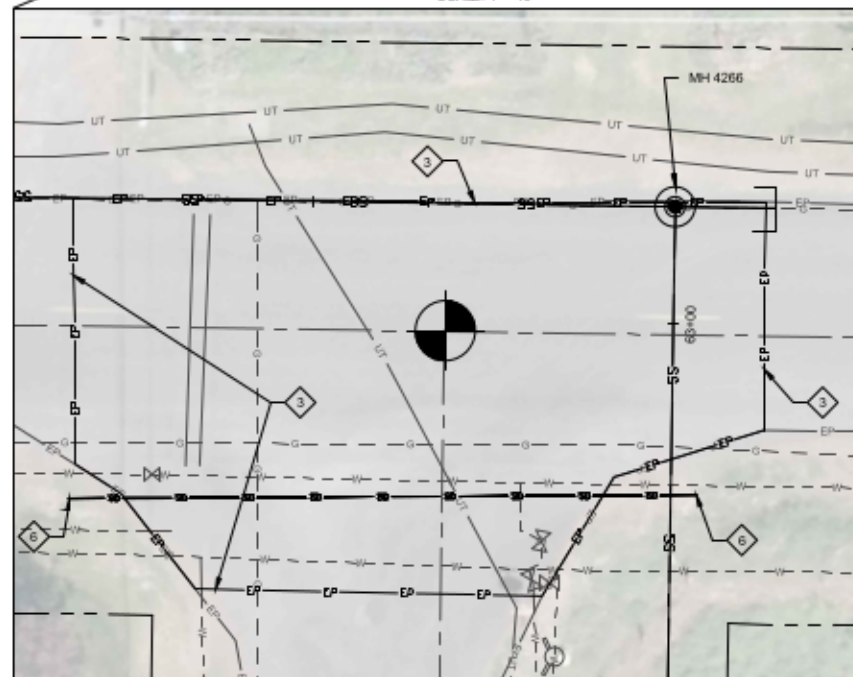


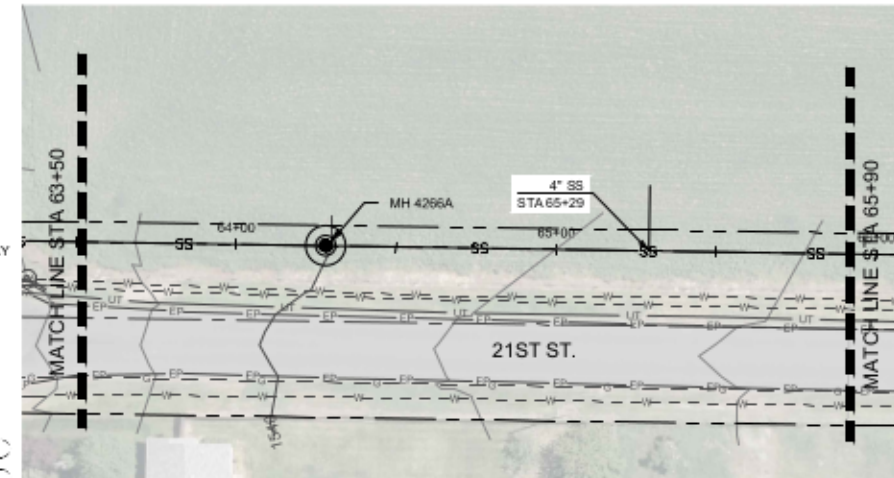

NORTH

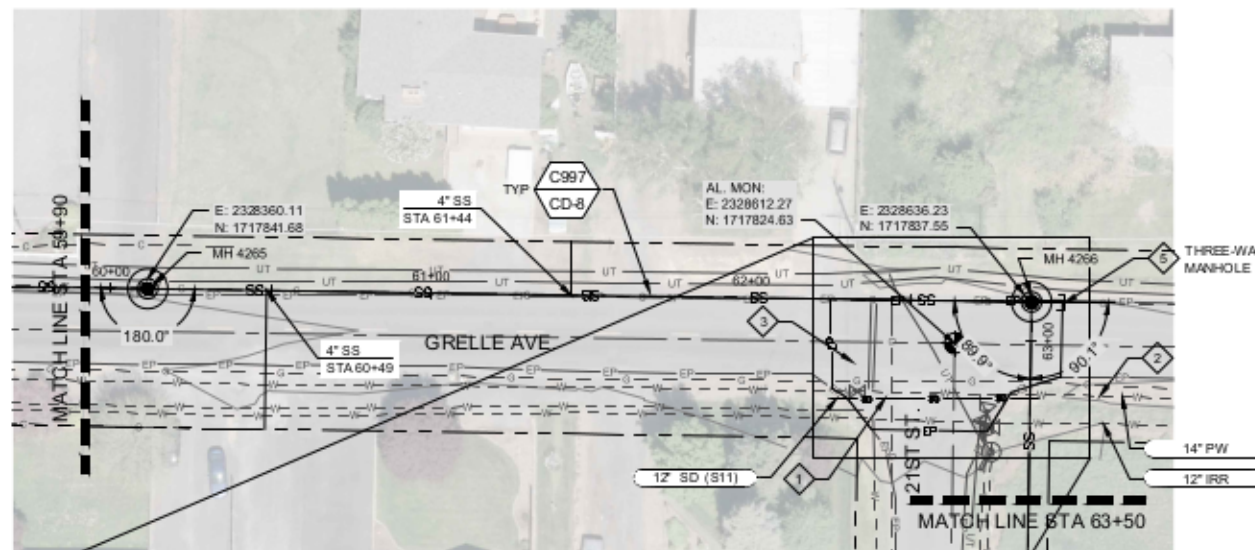

HORIZ. SCALE: 1" = 30'
VER. SCALE: 1" = 8'
(VERIFY PER SHEET SIZE)

NO.	REVISION	BY	DATE	DESIGN
				LCH
				DRAWN
				OTW
				CHECKED
				LMD
				APPROVED



RECORD DRAWING

THESE RECORD DRAWINGS HAVE BEEN PREPARED BASED IN PART ON INFORMATION PROVIDED BY OTHERS

THIS DRAWING WAS PREPARED ONLY FOR THE PROJECT AND SITE SPECIFICALLY IDENTIFIED HEREON AND IS NOT TO BE USED ELSEWHERE



ENGINEERING AND ENVIRONMENTAL SOLUTIONS

111 MAIN ST. SUITE 175
LEWISTON, IDAHO 83501
208.780.3990

IDAHO OFFICES
BOISE · LEWISTON · COEUR D'ALENE

EAST ORCHARDS SEWER EXPANSION LEWISTON, IDAHO

STA 59+90 - 65+90

VERIFY SCALE	
BAR IS ONE INCH ON FULL SIZE DRAWING	
PROJECT :	181.0020
DATE :	11/19/2019
DRAWING NO.	C-9