
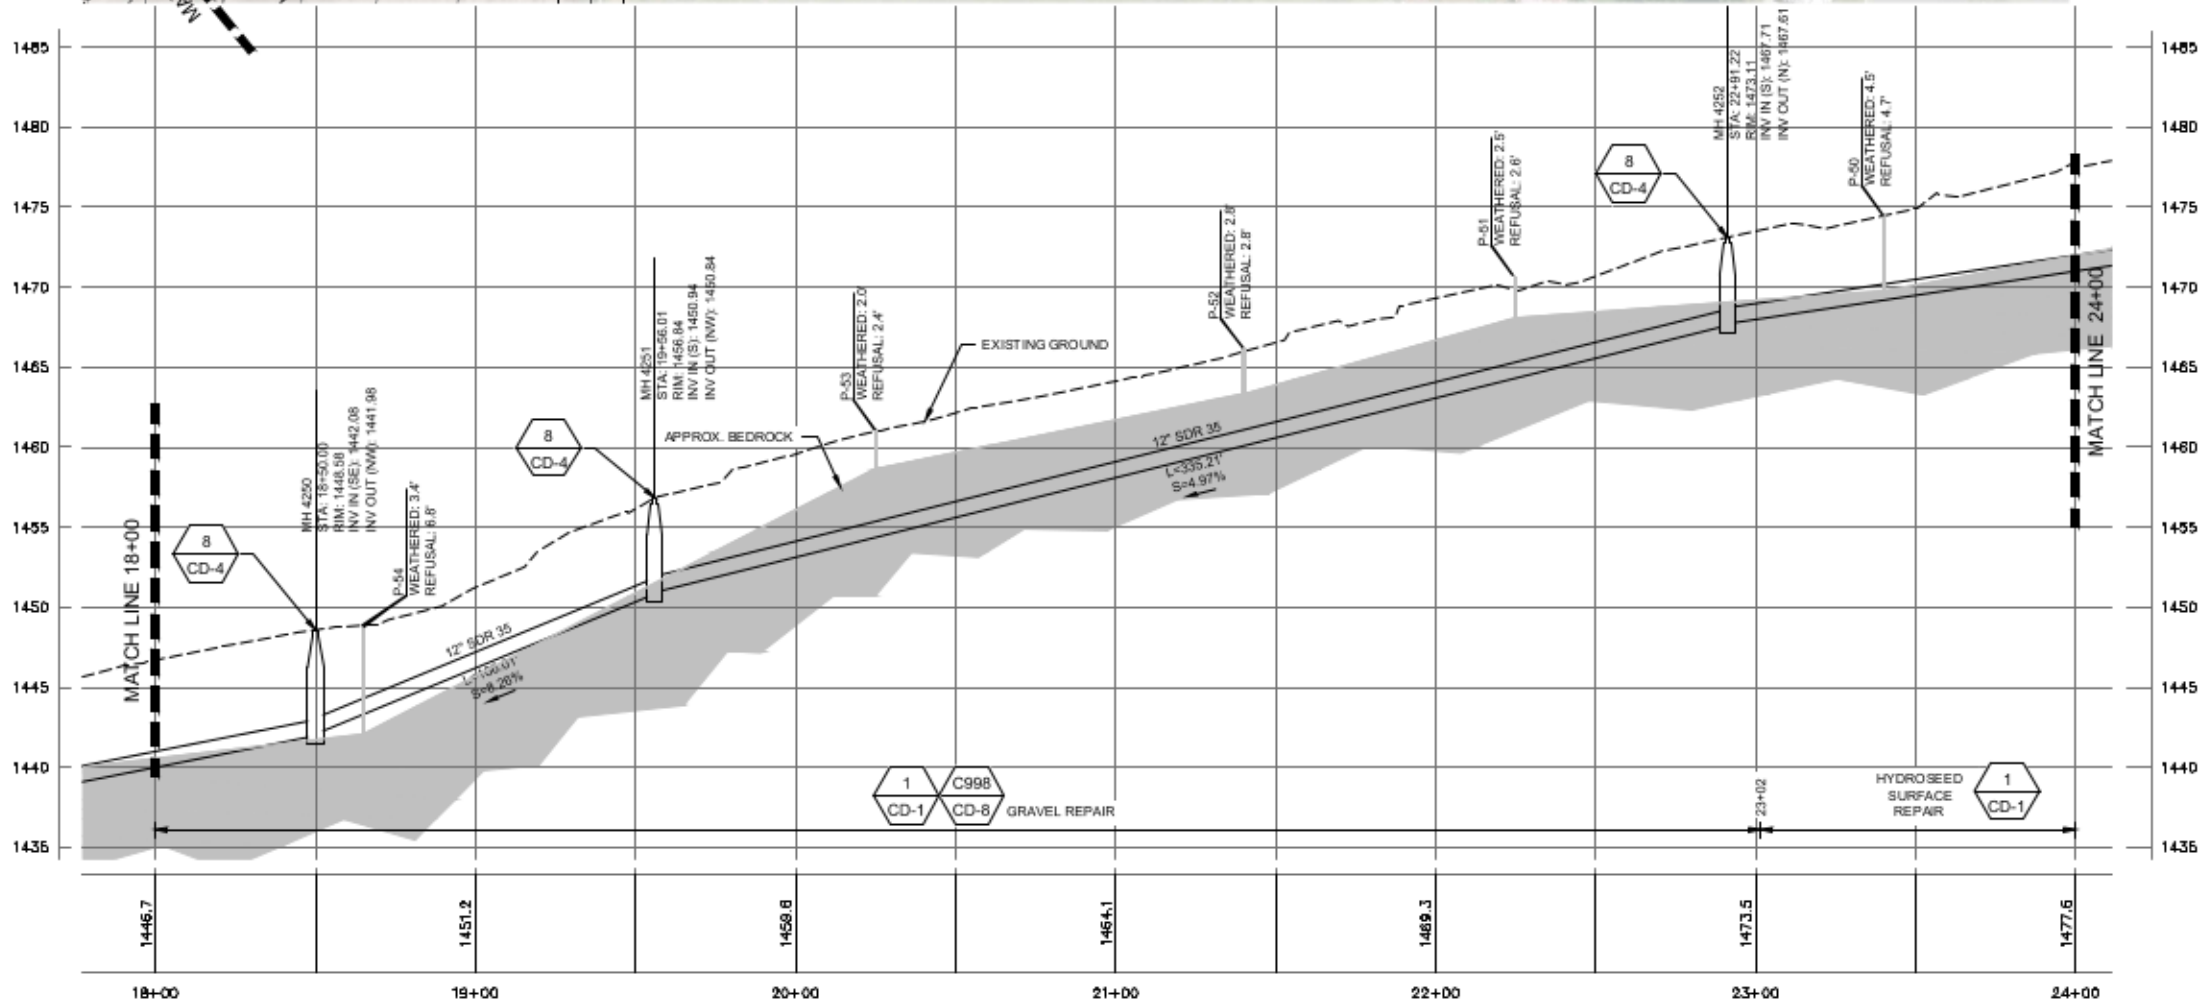
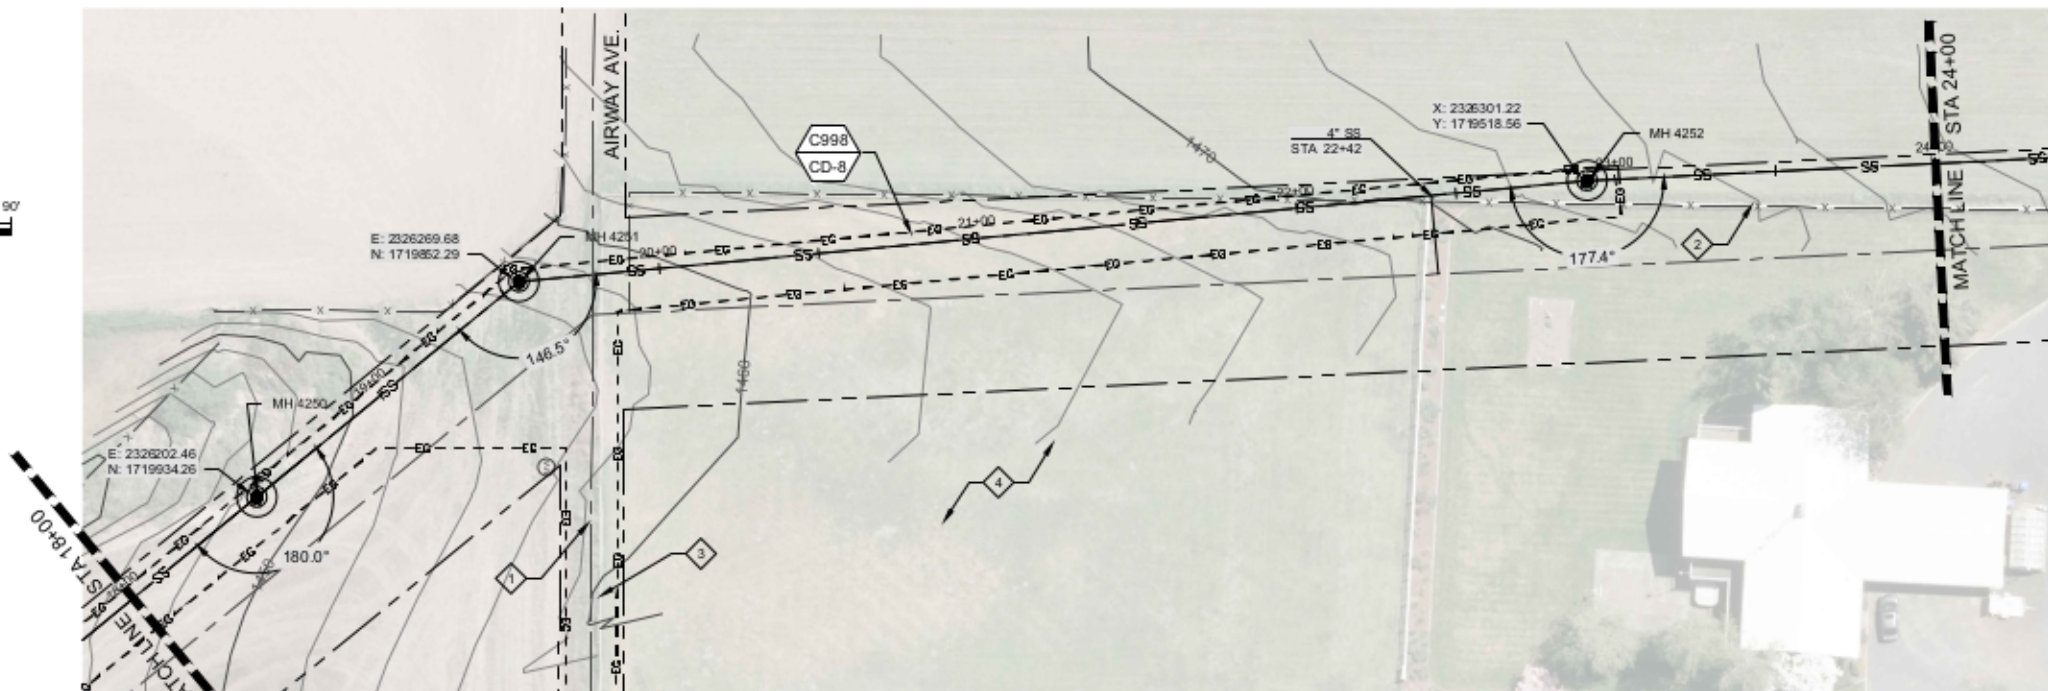


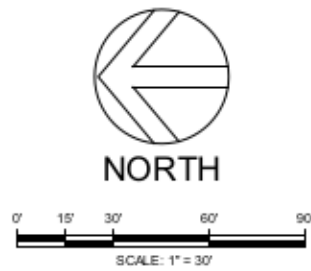

HORIZ. SCALE: 1" = 30'
VER. SCALE: 1" = 8'
(VERIFY PER SHEET SIZE)

GENERAL NOTES:

- GRAVITY SEWER PIPE MATERIAL TYPE SHALL BE MINIMUM PVC SDR-35. PIPE DIAMETER TO BE 12-INCHES UNLESS OTHERWISE SHOWN.
- CONTRACTOR TO FIELD VERIFY ALL DIMENSIONS, LOCATIONS, AND ELEVATIONS BEFORE STARTING WORK AND PRIOR TO ORDERING MATERIAL.
- CONTRACTOR TO COMPLY WITH IDAPA 58.01.08.542.07 WHEN WATER MAINS AND POTABLE WATER SERVICE LINES ARE ENCOUNTERED DURING SEWER MAIN AND SERVICE TRENCHING ACTIVITIES.
- PROPERTY LINES SHOWN ON PLAN SHEETS ARE FOR INFORMATIONAL PURPOSES ONLY AND WERE COMPILED FROM VARIOUS SOURCES. IT IS NOT THE INTENT OF THESE DRAWINGS TO BE USED FOR LOCATION OF PROPERTY LINES. MOUNTAIN WATERWORKS ASSUMES NO LIABILITY FOR PROPERTY LINES WHICH MAY NOT BE ACCURATELY SHOWN.
- ALL MANHOLES ARE TO BE CONSTRUCTED IN ACCORDANCE WITH WASTEWATER MANHOLE TYPE 1 DETAIL 7 ON SHT CD-4 UNLESS OTHERWISE SHOWN.
- GEOTECHNICAL BORINGS SHOWN IN APPROXIMATE LOCATIONS FOR INFORMATIONAL PURPOSES.

KEY NOTES:

- CONTRACTOR TO LEVEL THE GROUND SURFACE OF AIRWAY AVE. FROM THE END OF ASPHALT TO THE 15TH STREET RIGHT-OF-WAY, APPROXIMATELY 370-FEET. PROVIDE PIT RUN BASE AND GRAVEL OVERLAY IN ACCORDANCE WITH DETAIL C998 ON SHT CD-8.
- EXISTING FENCE TO BE RELOCATED BY HOMEOWNER PRIOR TO CONSTRUCTION.
- EXISTING FENCE WITHIN RIGHT-OF-WAY TO BE RELOCATED PRIOR TO CONSTRUCTION.
- POTENTIAL STAGING AREA. CONTACT PROPERTY OWNER ROBERT PRASIL AT (208) 791-2605.
- ROCK BLASTING IS ALLOWED FROM MH 4222 TO MH 4253.

PROFILE STA. 18+00 - 24+00

NO.	REVISION	BY	DATE	DESIGN
				LCH
				DRAWN
				OTW
				CHECKED
				LMD
				APPROVED



RECORD DRAWING

THESE RECORD DRAWINGS HAVE BEEN PREPARED BASED IN PART ON INFORMATION PROVIDED BY OTHERS

THIS DRAWING WAS PREPARED ONLY FOR THE PROJECT AND SITE SPECIFICALLY IDENTIFIED HEREON AND IS NOT TO BE USED ELSEWHERE



ENGINEERING AND ENVIRONMENTAL SOLUTIONS

111 MAIN ST. SUITE 175
LEWISTON, IDAHO 83501
208.780.3990

IDAHO OFFICES
BOISE · LEWISTON · COEUR D'ALENE

EAST ORCHARDS SEWER EXPANSION LEWISTON, IDAHO

STA 18+00 - 24+00

VERIFY SCALE	181.0020
BAR IS ONE INCH ON FULL SIZE DRAWING	11/19/2019
PROJECT :	DATE :
DRAWING NO.	C-2