

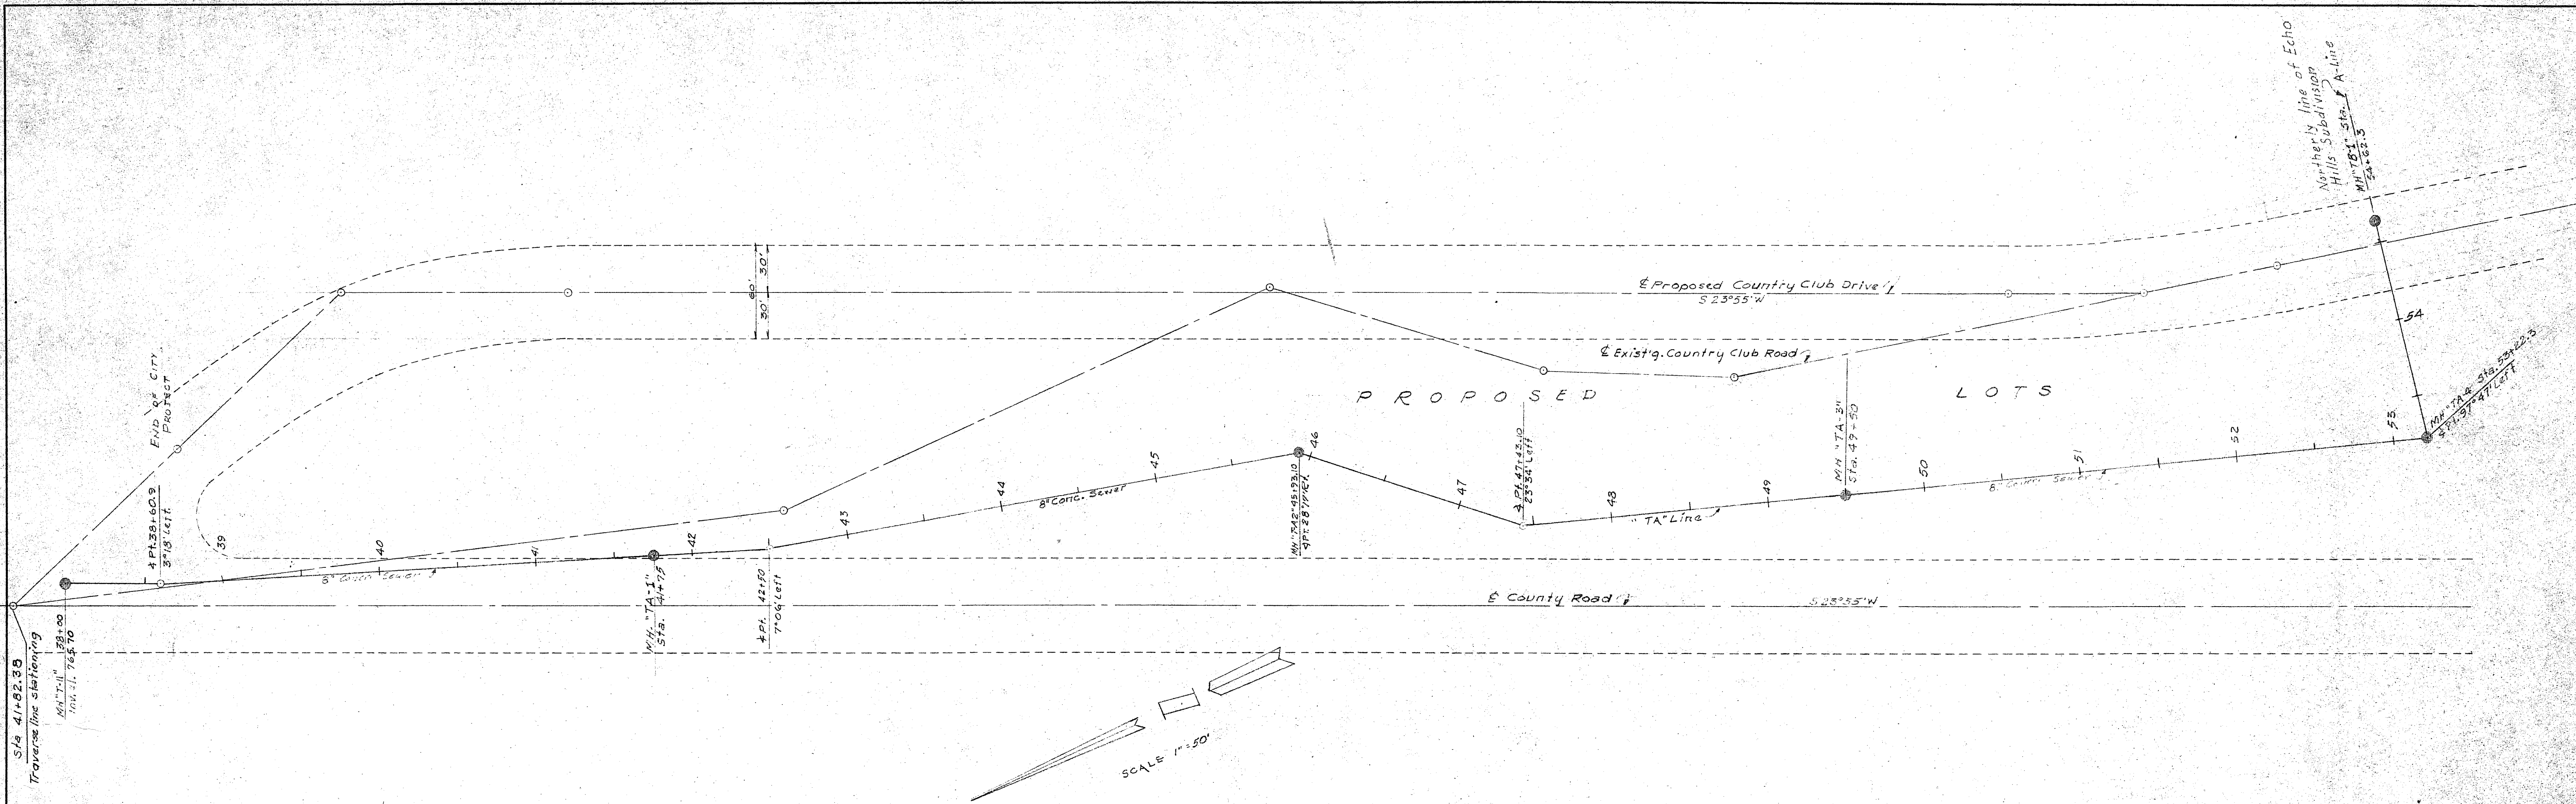


PLAN	NO.	DATE
SURVEYED		
NOTE BOOK		
ALIGNMENT CHECKED		
BY OF WAY CHECKED		

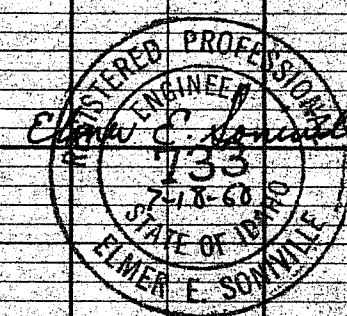

PROFILE	NO.	DATE
SURVEYED		
NOTE BOOK		
BRADIS CHECKED		
STRUCTURE NOTING CIVIL		

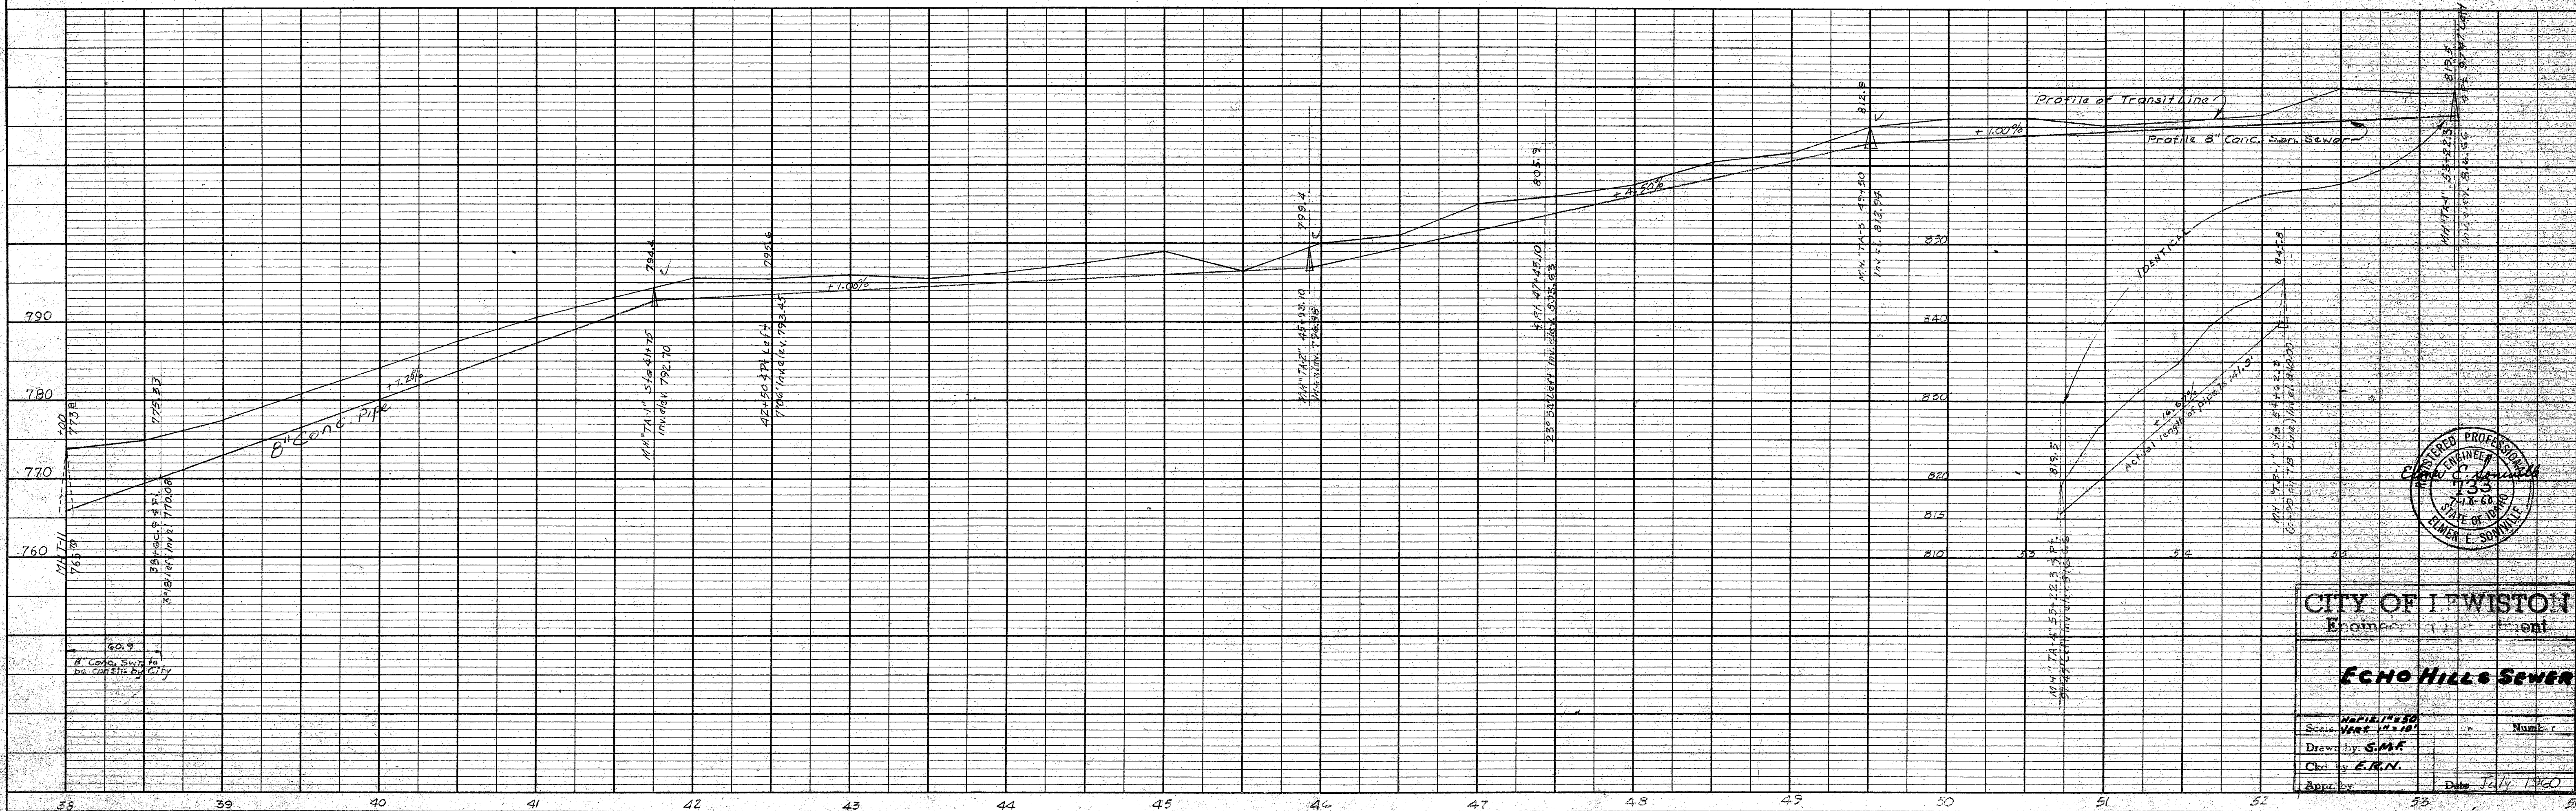

CITY OF TWISTON
Engineer

ECHO HILLS SEWER

Scale: HORIZ. 1"=50' VERT. 1"=10'

Drawn by: E.M.N.

Check by: E.M.N.

Date: July 1960

SHEET 1 OF 3