


THIS SECTION OF PIPE WAS PLANNED 04-68-08-30

THIS SECTION OF PIPE WAS PLANNED 04-68-08-30

HAVE NOT FOUND ANYTHING FOR THIS SECTION OF PIPE

PIPE REPLACEMENT JULY, 2003

Sunset Palisade 1st plans show about 300 feet of water line being part of project

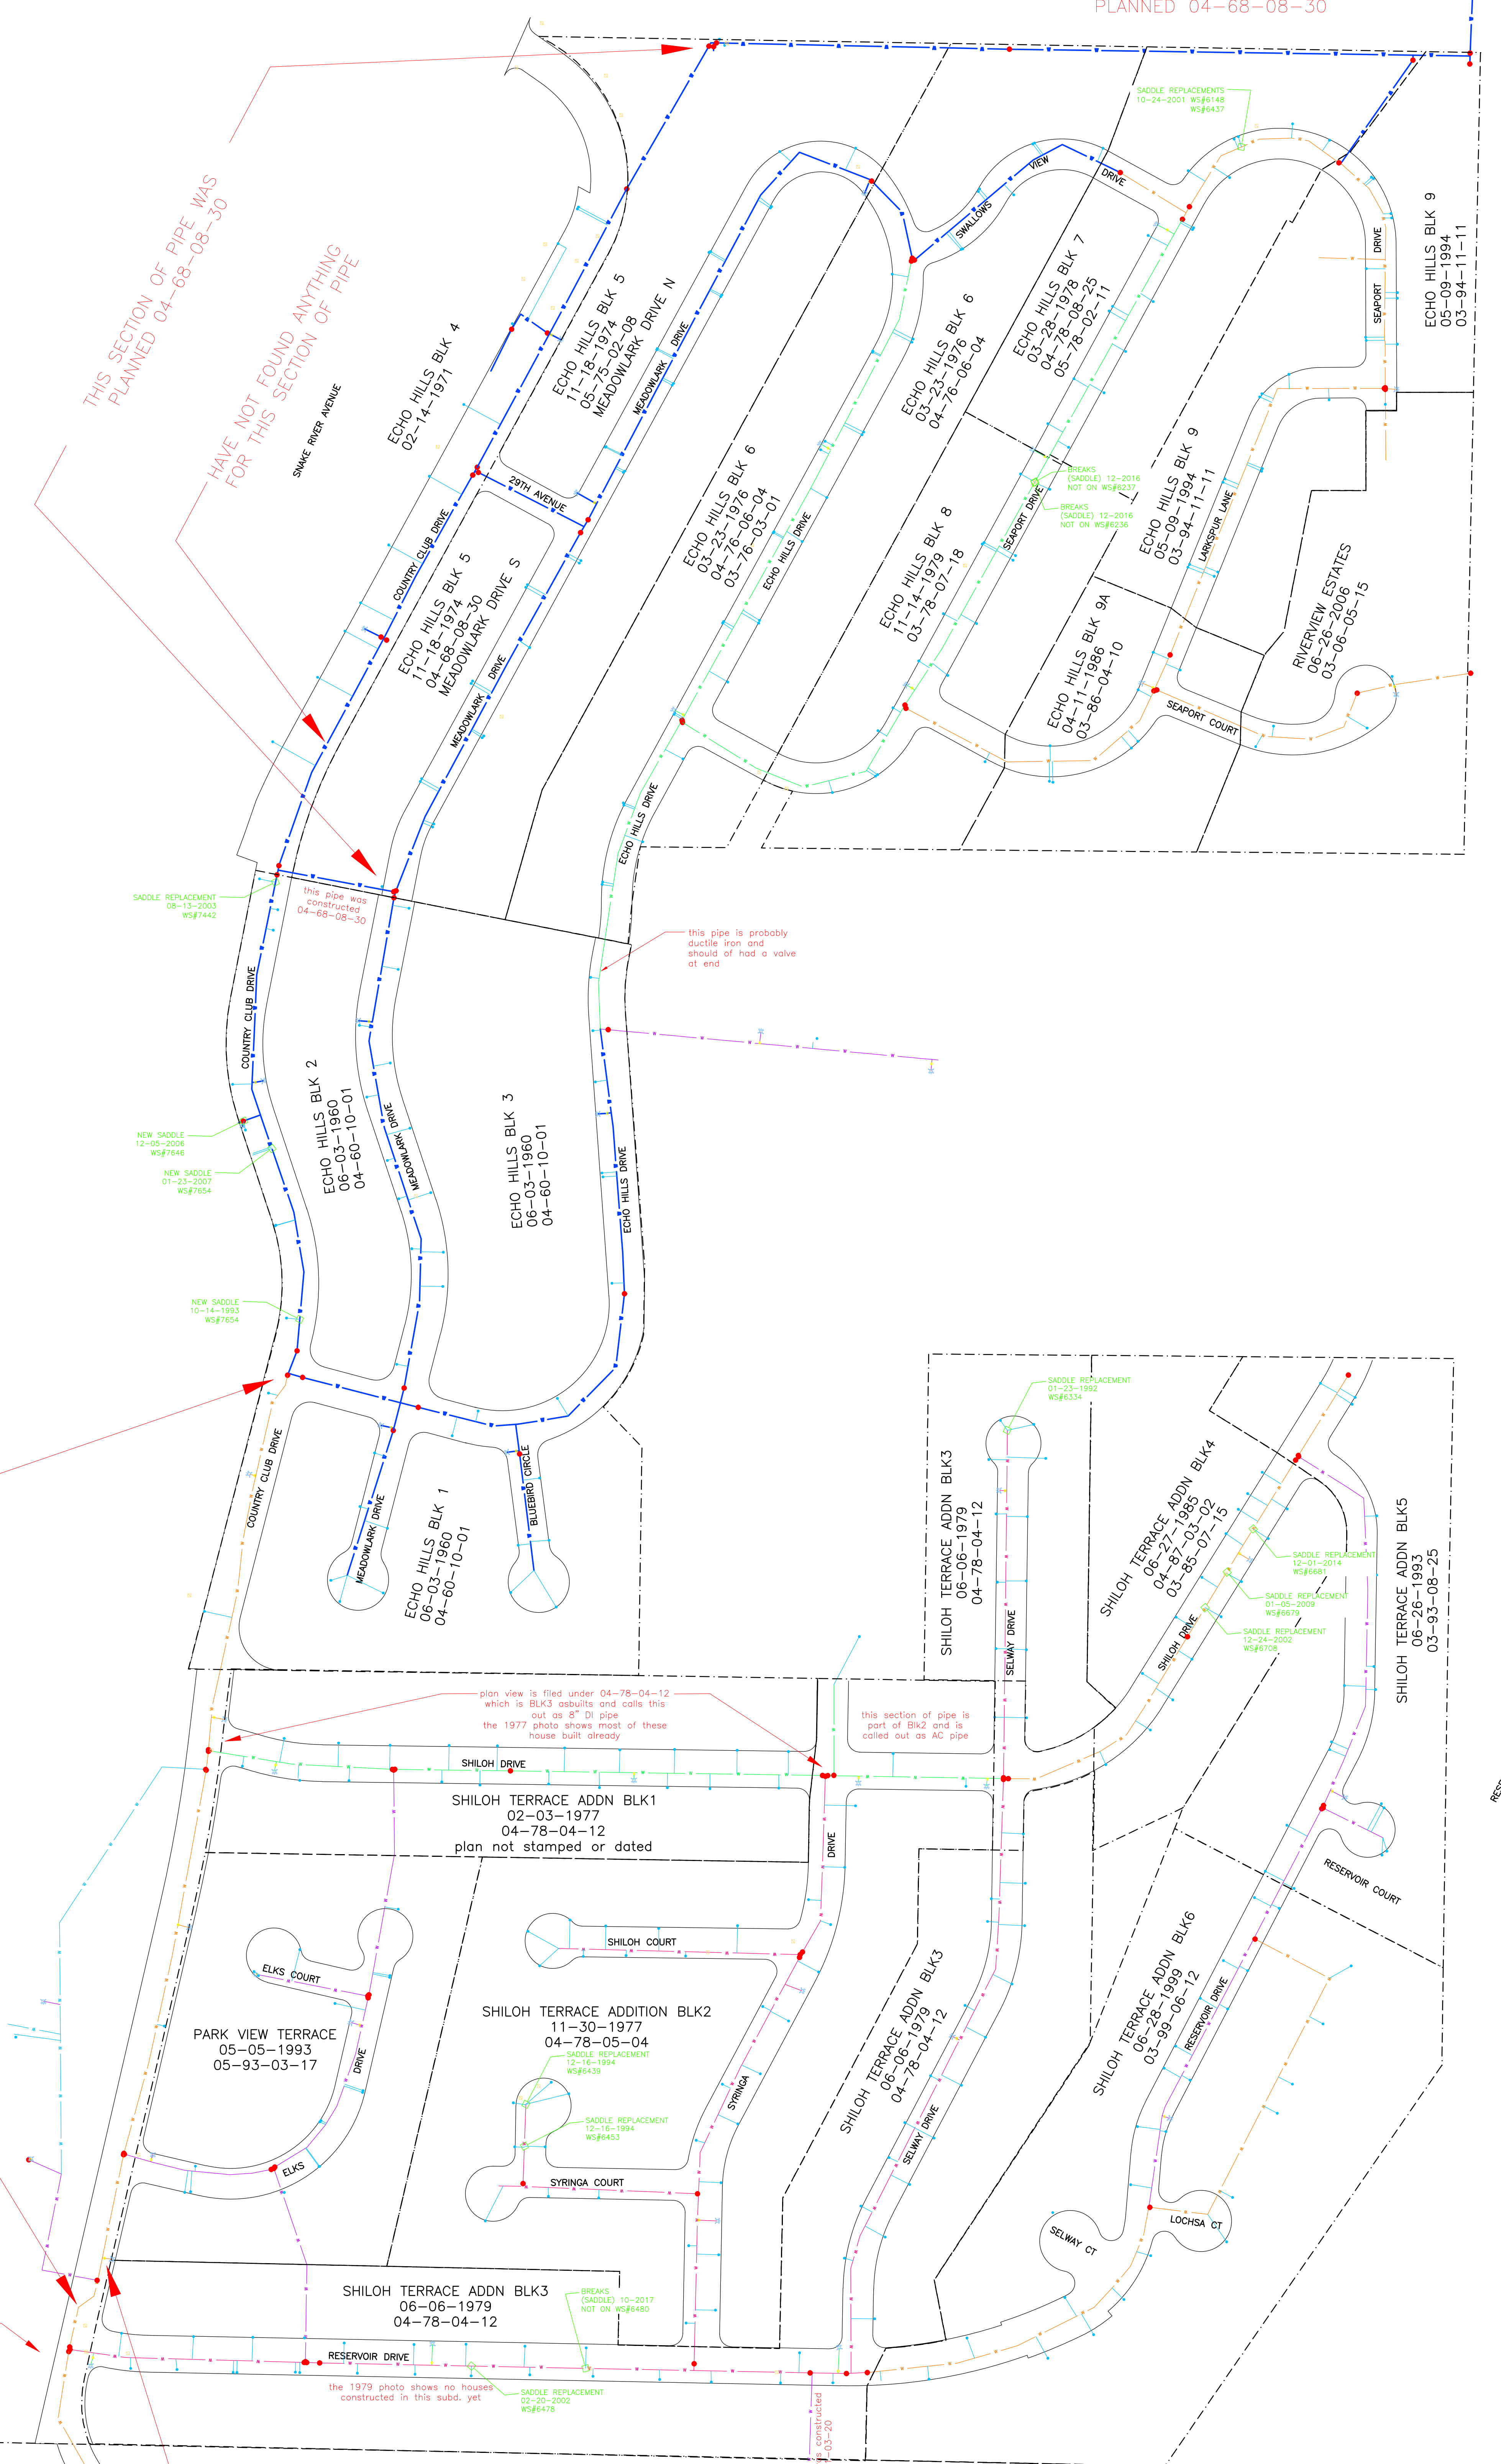

RESERVOIR DRIVE