


North

Block 51X - Echo Hill

Scale: 1" = 100' of Feet

2014 Echo Hills DR
B9-000121 Permit

- Echo Hills

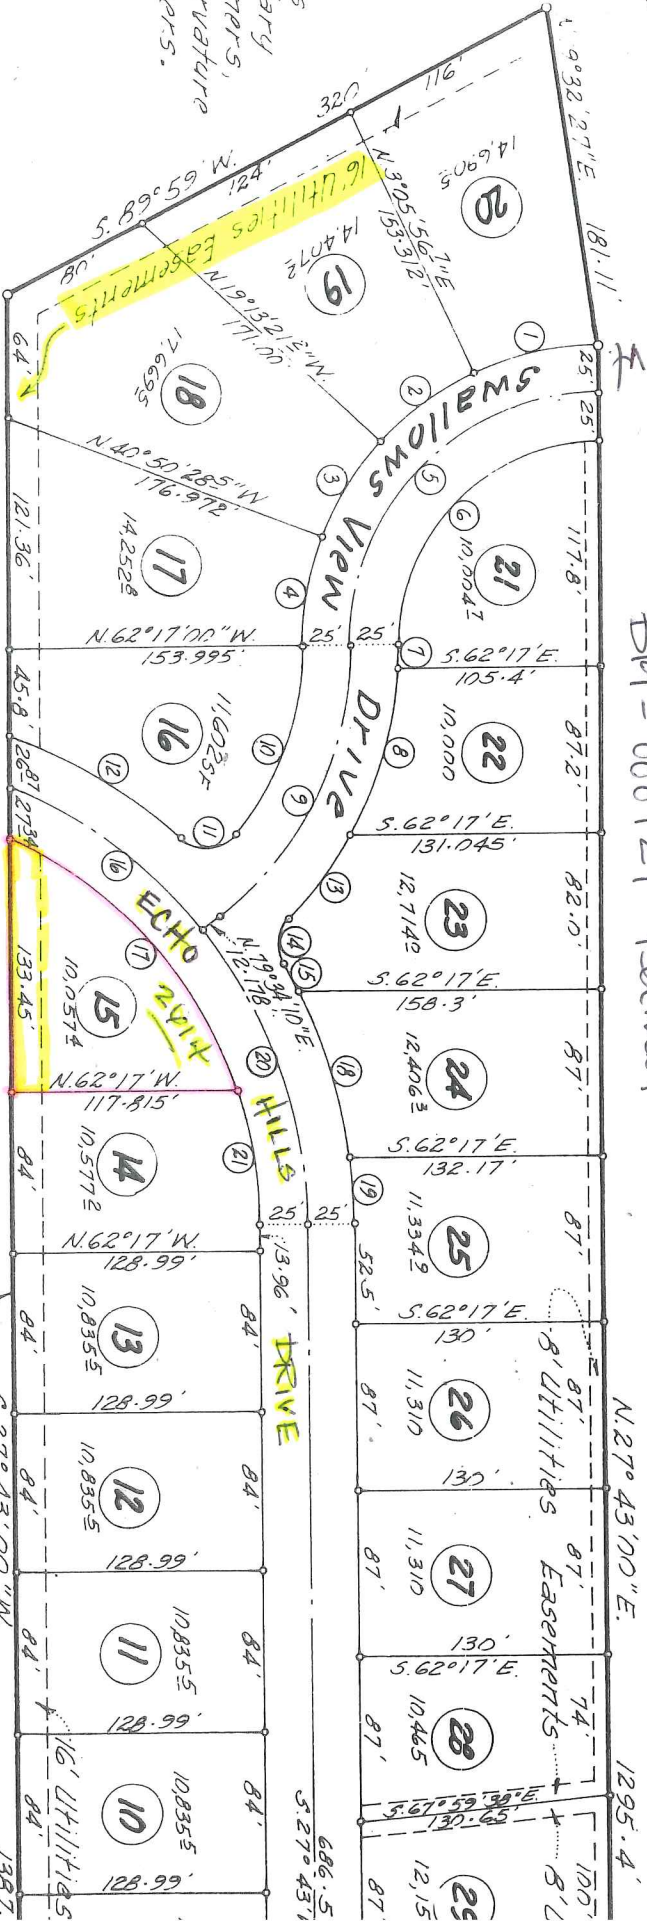

• CURVE DATA •

Δ	Arc	Chord
24°37'03.35"	66.597'	N 74°35'31.7"W. 66.086'
22°19'17.85"	60.386'	S 81°56'17.7"W. 60.005'
21°37'07.3"	58.484'	S 59°58'05.5"W. 58.138'
21°26'31.5"	58.006'	S 38°26'15.25"W. 57.669'
90°00'00"	204.204'	N 72°43'00"E. 183.848'
90°00'00"	164.934'	N 72°43'00"E. 148.492'
3°34'41.4"	12.808'	N 29°30'23.7"E. 12.806'
25°36'59.7"	91.654'	N 44°06'17.25"E. 90.893'
51°51'09.7"	162.900'	N 53°38'34.85"E. 157.398'
39°30'15.7"	106.870'	S 41°28'07.85"W. 104.765'

• Property Description •

Beginning at the monument marking the SW corner of the NE 1/4 SW 1/4 of Section 12, T.35N., R.6W. B.M.; thence N. 89°32'02"E. 124.2 feet along the south line of the said NE 1/4 SW 1/4; thence N. 27°43'E. 1295.4 feet along a line parallel to and 308.99 feet Easterly of the East line of Block Five of Echo Hills, as shown on the recorded Plat thereof; thence N. 19°32'27"E. 181.11 feet; thence S. 89°59'W.

Donald G. K husband & Edwards owners of the 3 of the same Therefore, to the City