

AS BUILT
PLANS FOR

ESPARANZA HILLS SUB. AND
ESPARANZA HILLS TWO SUB.
WATER LINE AND ACCESS RD.

LOCATED IN THE SW1/4NW1/4
SECTION 13 AND THE NE1/4SE1/4,
E 1/2NE1/4 OF SECTION 14 ,
TOWNSHIP 35 NORTH, RANGE
6 WEST , BOISE MERIDIAN ,
NEZ PERCE COUNTY , IDAHO,
CITY OF LEWISTON ,


AUGUST, 2008

TABLE OF CONTENT - PLANS
SHEET NO,

1. WATER LINE & ROAD PLAN
2. WATER LINE
3. RECORD OF SURVEY PLAT
& GRADING - SWPP PLAN
4. TYPICAL DRAWINGS
- 5

SUBDIVISION
SITE

VICINITY MAP

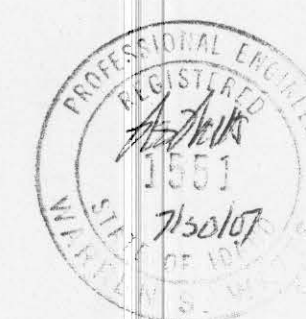

OWNER :

GARY AND JEANNE MEDLEY
194 MARINE VIEW DRIVE
LEWISTON, IDAHO 83501
AND

COREY AND ROBIN MEDLEY
H.C. 11, BOX 73F
KAMIAH, IDAHO 83536

ENGINEER :

W. W. ENGINEERING
3435 CLEMANS ROAD
CLARKSTON, WASHINGTON, 99403
PH : (509) 243 - 4003



A copy of these plans have been filed in hanging folders, As Builts
Esparanza Hills I & II

U88-000017