


WATER LINE LEGEND

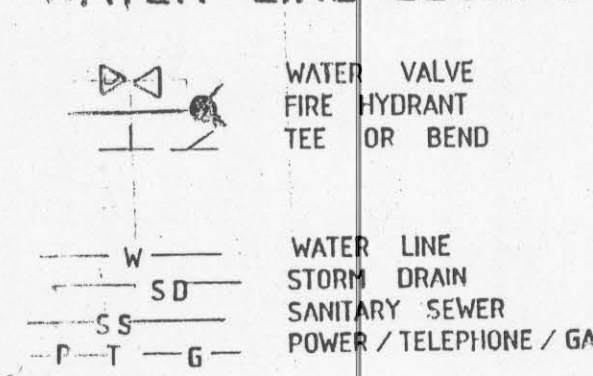

NOTE:
ALL CONSTRUCTION TO BE
IN ACCORDANCE WITH IDAHO
STATE STANDARDS FOR
PUBLIC WORKS. (ISPCW).

NOTE:
WATER PRESSURE REDUCER
EXIST 20' RT. OF STA.
27+20 ELEV. 767.55
AT TOP AND CENTER LID

LEGEND

MANHOLE
PROPERTY CORNER - FOUND 5/8" BY 30" REBAR / CAP.
UTILITY LINE ANGLE POINT - NOT SET.
PROPOSED LOT CORNER - NOT SET.
TELEPHONE STAND.
STORM WATER BASIN INLET - EXISTING.
CENTERLINE ROAD COURSE CHANGE - FOUND BRASS CAP IN CASE.
WATER LINE VALVE CASE - EXISTING
STREET LIGHT - EXISTING.
POWER POLE - EXISTING
CULVERT EXISTING.
ROAD CENTERLINE
EASEMENT LINE
WATER LINE - EXISTING.
GAS LINE - EXISTING.
ELECTRIC LINE UNDERGROUND - EXISTING.
EXISTING STORM DRAIN

BENCH MARKS - SEA LEVEL

B.M. # & IDENT.	ELEV.	ELEV. TOP C/G
1 PROP. COR.	778.70'	
2 LIGHT POLE - TOP	790.06'	789.07'
ELECT. BOX		
3 "	802.40'	800.85'
4 "	816.26'	815.29'
5 "	829.73'	828.14'
6 "	841.79'	840.74'
7 "	854.40'	853.33'
8 "	867.26'	866.07'
9 "	879.53'	878.58'
10 "	893.07'	891.84'
11 "	906.24'	905.16'

AS BUILT

ROAD TYPICAL SECTION


SCALE 1"=5'

NOTE: FROM STA. 4+00 TO 9+00 AVISTA
GAS LINE EXIST IN 10' UTILITY STRIP
WATER LINE NEEDS TO BE PLACED 3' FROM
WEST SIDE EASEMENT.

BASIS OF BEARING



S00°44'44"W

DUTHIE BOULEVARD WATER LINE

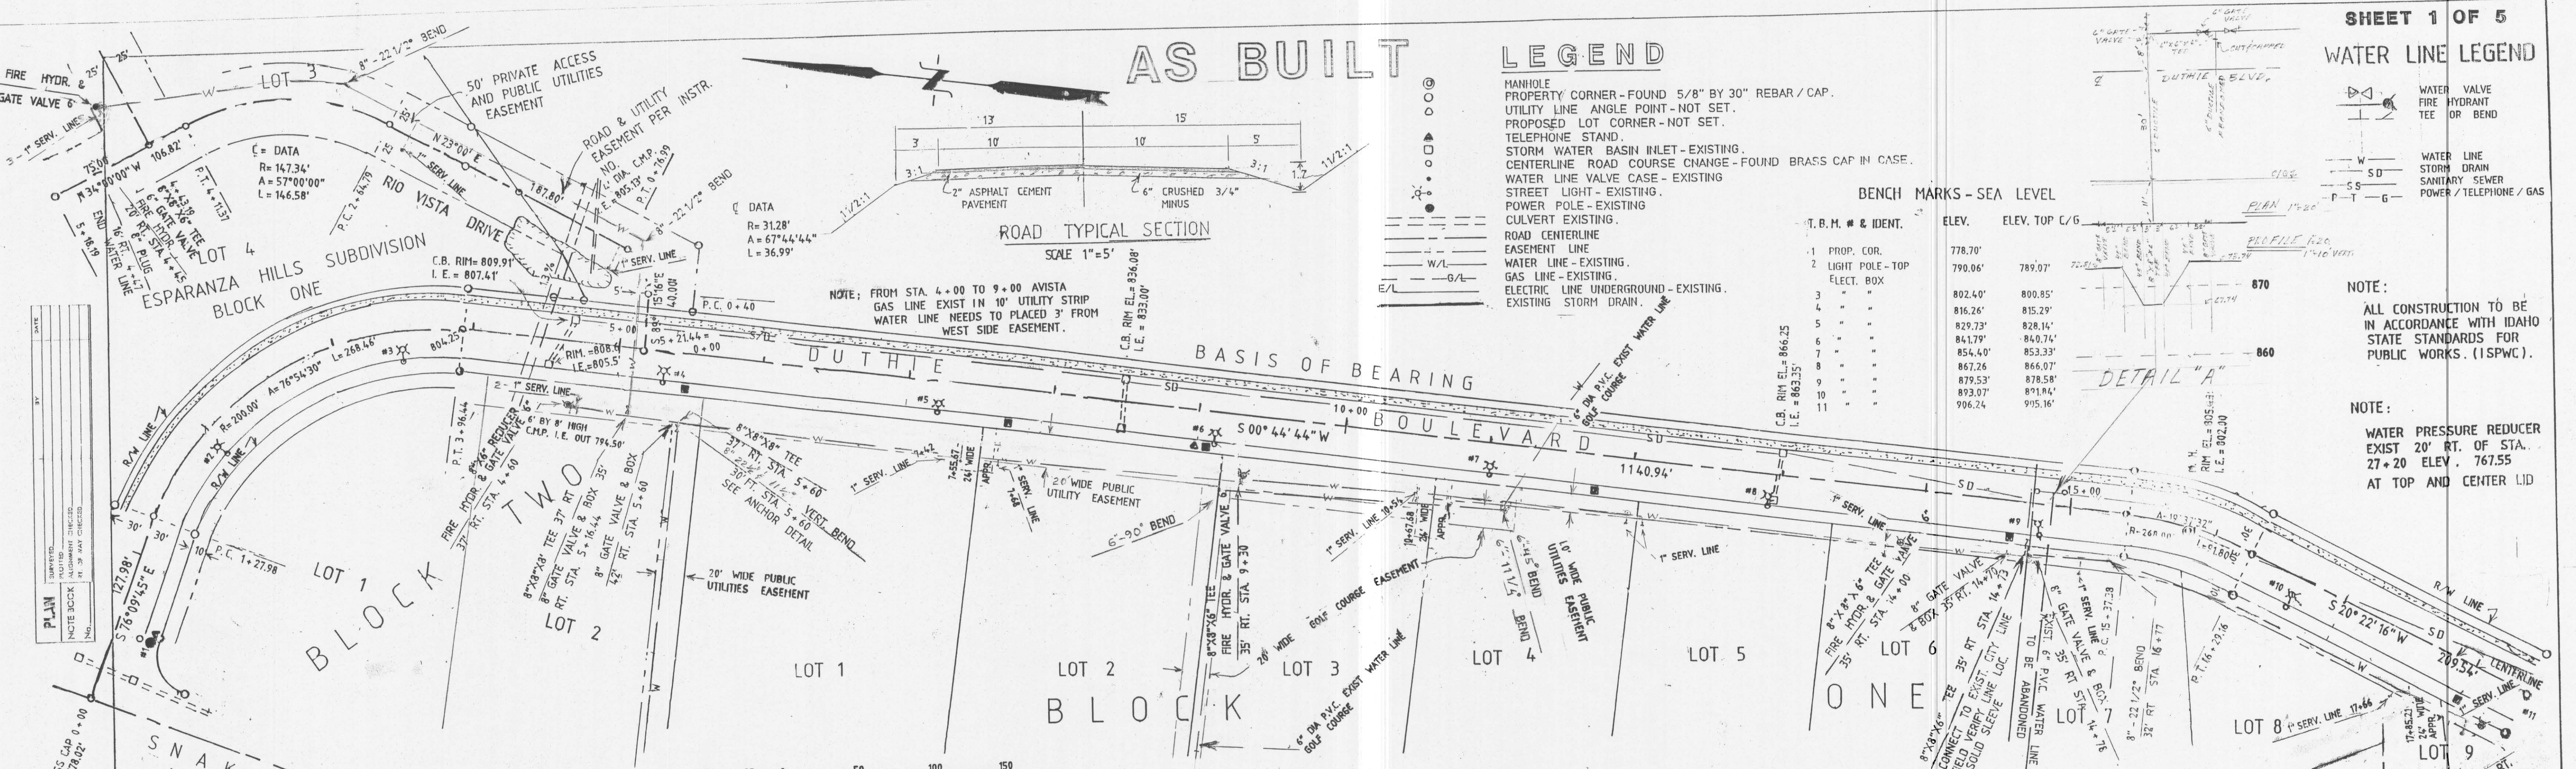

SCALE IN FEET

RIO VISTA DRIVE - PROFILE

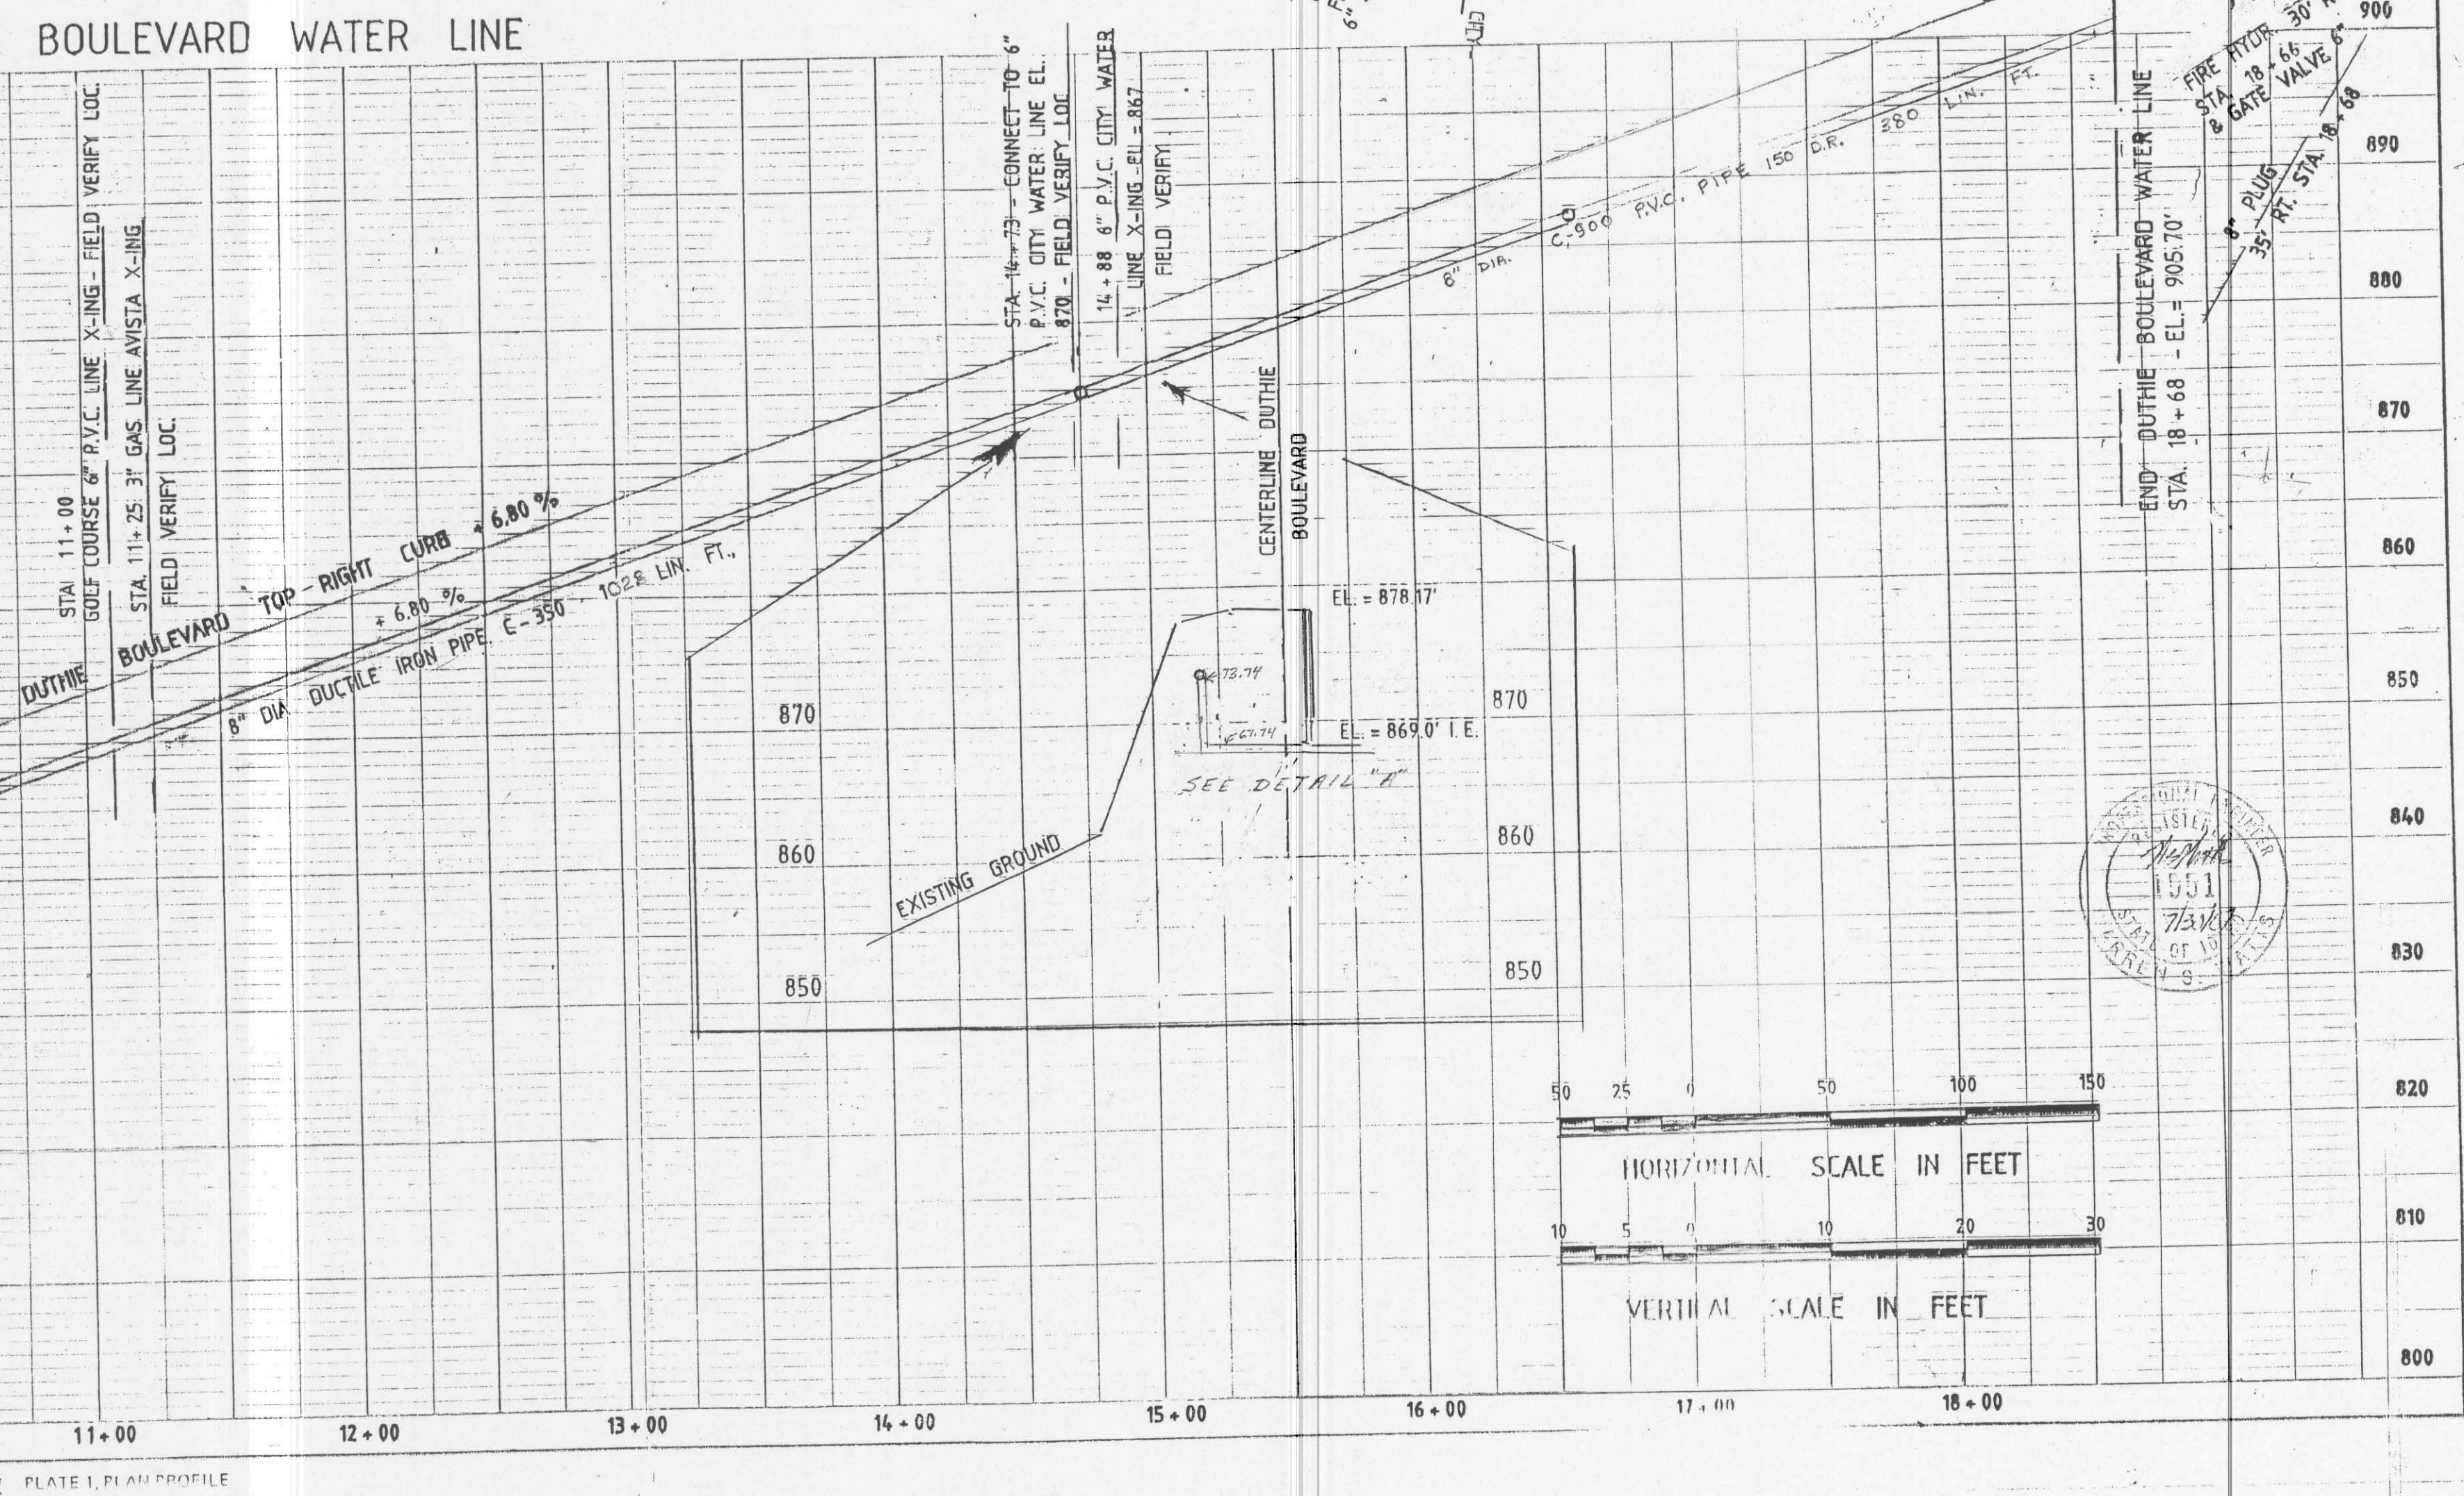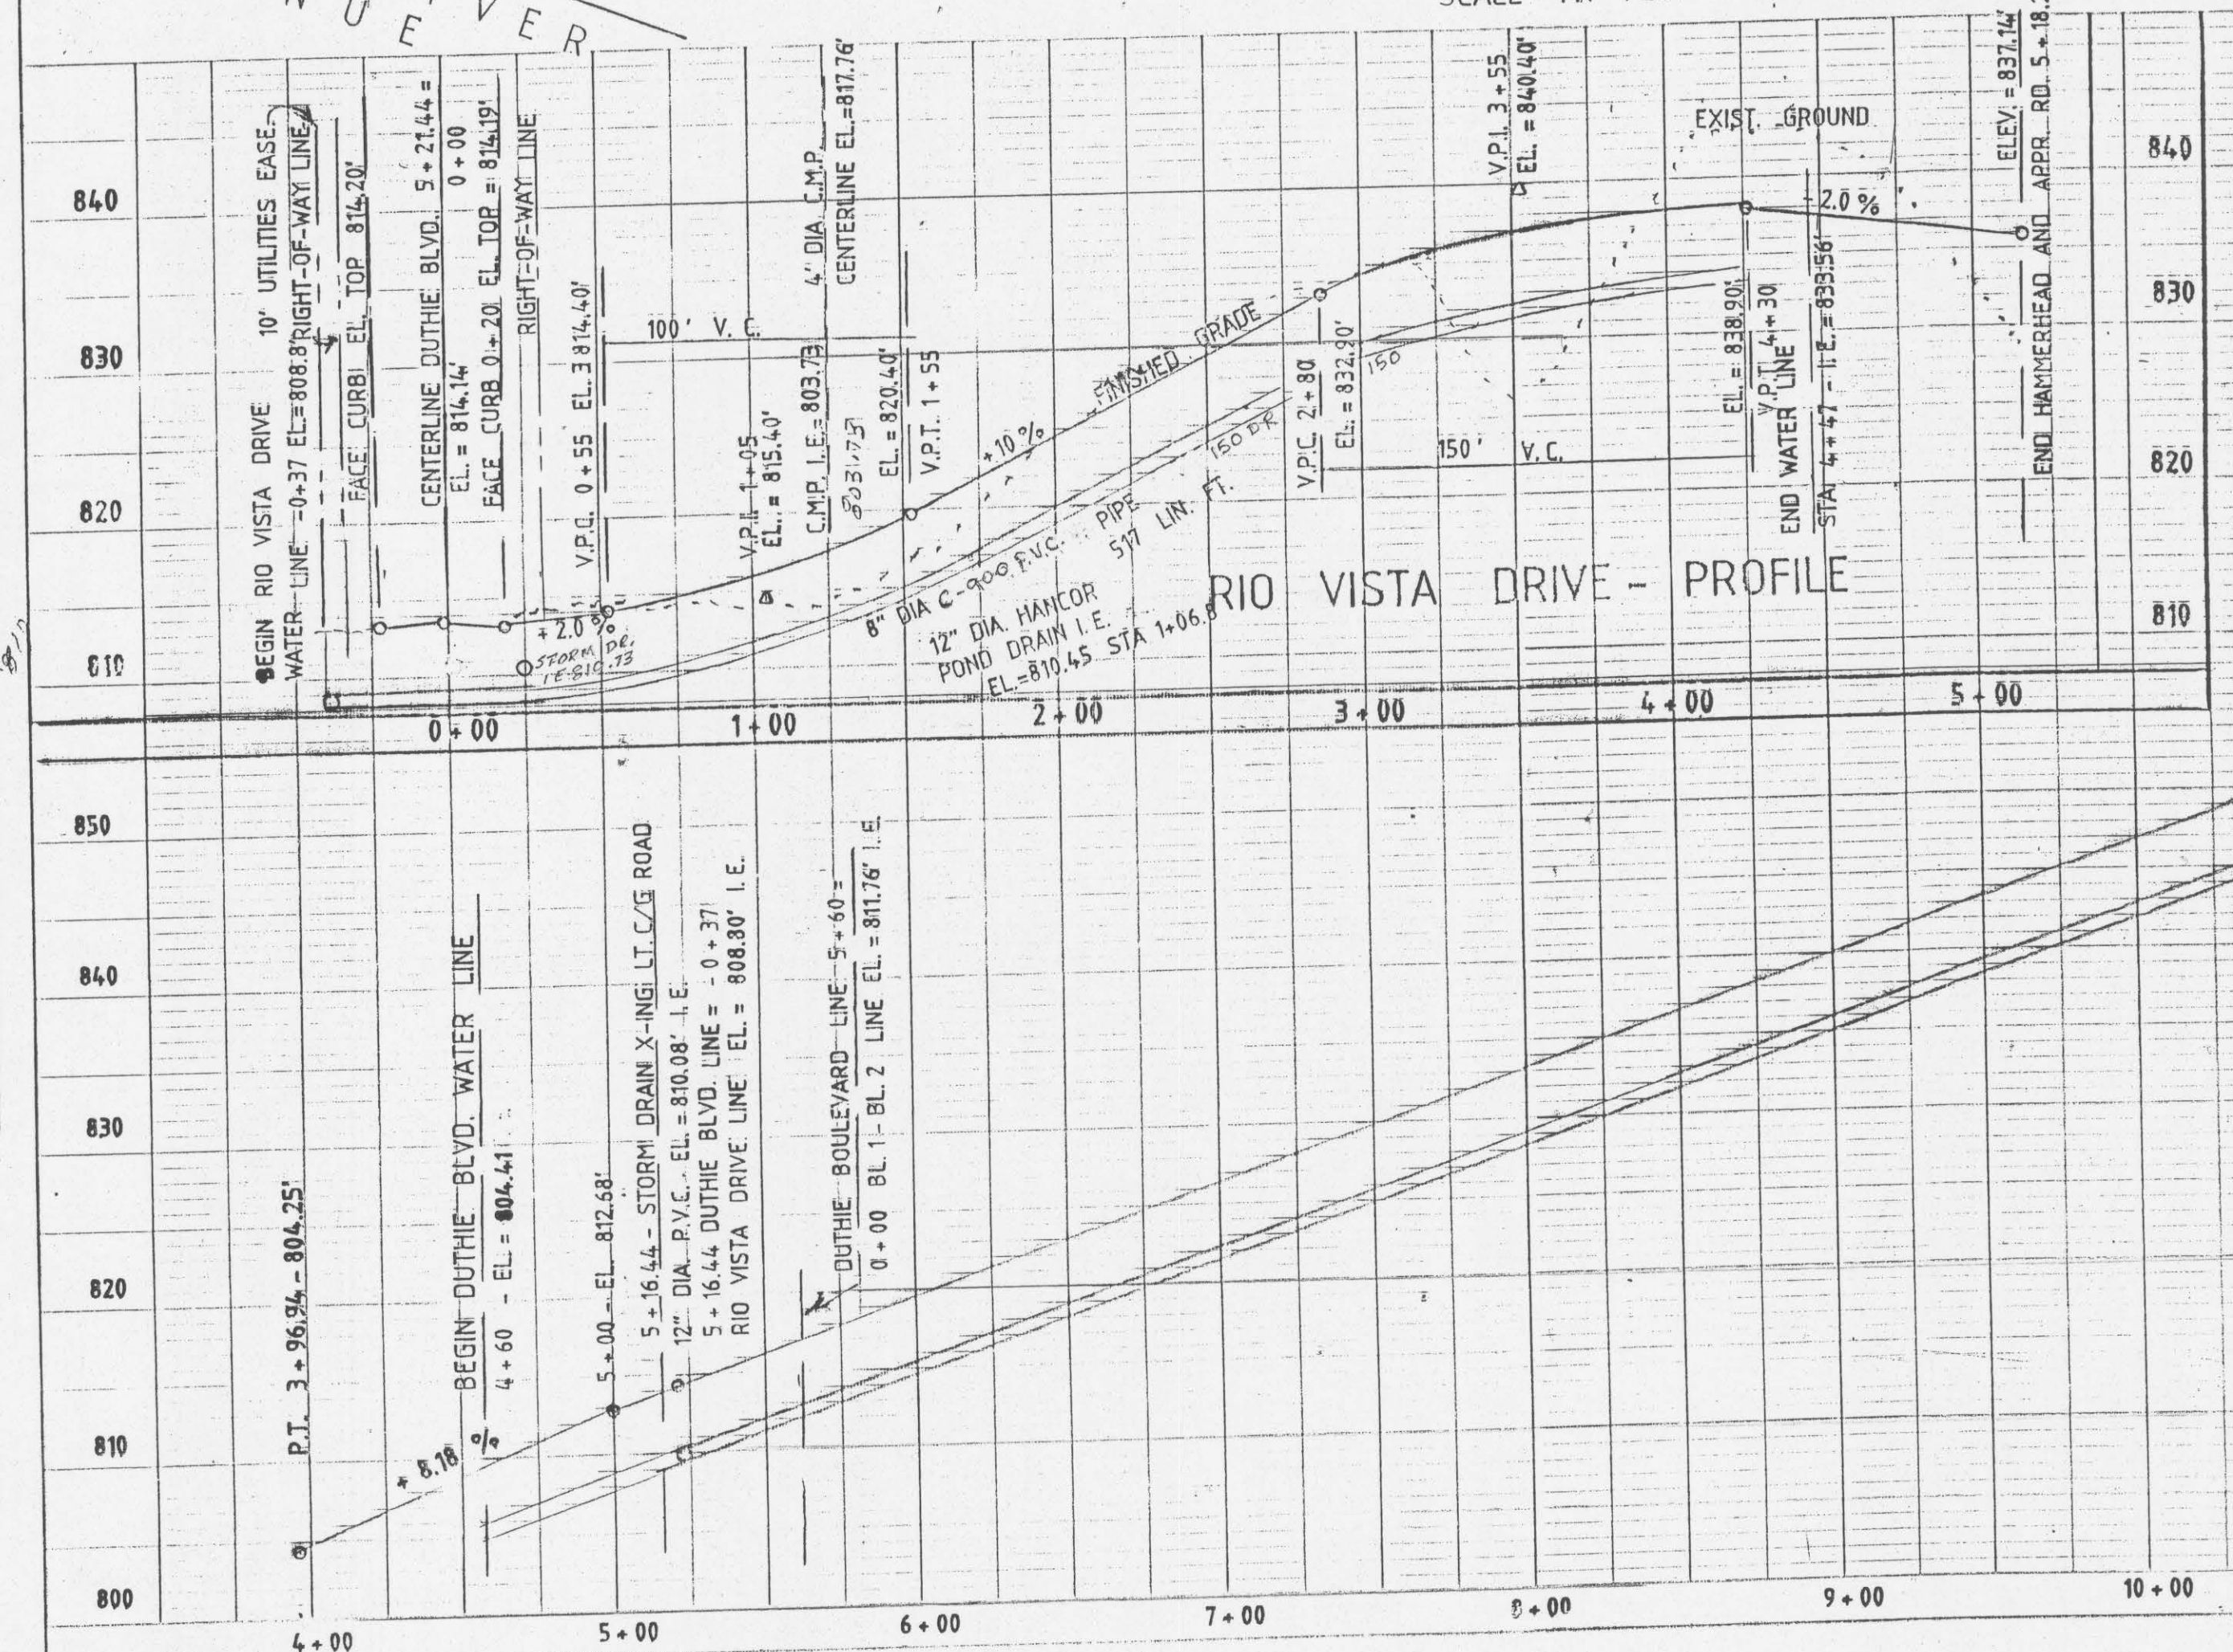

HORIZONTAL SCALE IN FEET
VERTICAL SCALE IN FEET