

AS BUILT  
PLANS FOR

ESPARANZA HILLS SUB. AND  
ESPARANZA HILLS TWO SUB.  
WATER LINE AND ACCESS RD.

LOCATED IN THE SW1/4NW1/4  
SECTION 13 AND THE NE1/4SE1/4,  
E 1/2NE1/4 OF SECTION 14 ,  
TOWNSHIP 35 NORTH, RANGE  
6 WEST , BOISE MERIDIAN ,  
NEZ PERCE COUNTY , IDAHO,  
CITY OF LEWISTON ,


AUGUST, 2008

TABLE OF CONTENT - PLANS  
SHEET NO,

1. WATER LINE & ROAD PLAN
2. WATER LINE
3. RECORD OF SURVEY PLAT  
& GRADING - SWPP PLAN
4. TYPICAL DRAWINGS
- 5

SUBDIVISION  
SITE

VICINITY MAP

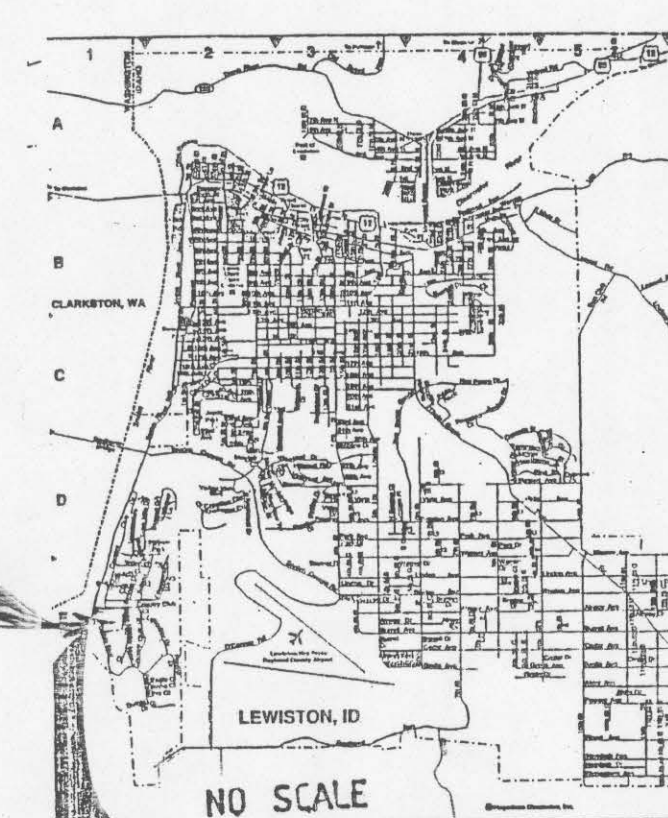

OWNER :

GARY AND JEANNE MEDLEY  
194 MARINE VIEW DRIVE  
LEWISTON, IDAHO 83501  
AND

COREY AND ROBIN MEDLEY  
H.C. 11, BOX 73F  
KAMIAH, IDAHO 83536

ENGINEER :

W. W. ENGINEERING  
3435 CLEMANS ROAD  
CLARKSTON, WASHINGTON, 99403  
PH : ( 509 ) 243 - 4003



FILE COPY

FILE COPY

088-000017

Esparanza Hills I & II

As-Built's