

LEGEND

MANHOLE
PROPERTY CORNER - FOUND 5/8" BY 30" REBAR / CAP.
UTILITY LINE ANGLE POINT - NOT SET.
PROPOSED LOT CORNER - NOT SET.
TELEPHONE STAND.
STORM WATER BASIN INLET - EXISTING.
CENTERLINE ROAD COURSE CHANGE - FOUND BRASS CAP IN CASE.
WATER LINE VALVE CASE - EXISTING
STREET LIGHT - EXISTING.
POWER POLE - EXISTING
CULVERT EXISTING.
ROAD CENTERLINE
EASEMENT LINE
WATER LINE - EXISTING.
GAS LINE - EXISTING.
ELECTRIC LINE UNDERGROUND - EXISTING.
EXISTING STORM DRAIN.

BENCH MARKS - SEA LEVEL

T.B.M. # & IDENT.	ELEV.	ELEV. TOP C/G
1. PROP. COR.	778.70'	
2. LIGHT POLE - TOP	790.06'	789.07'
3. ELECT. BOX	802.40'	800.85'
4. " "	816.26'	815.29'
5. " "	829.73'	828.16'
6. " "	841.77'	840.74'
7. " "	854.40'	853.33'
8. " "	867.26'	866.07'
9. " "	879.53'	878.58'
10. " "	891.84'	891.84'
11. " "	906.24'	905.16'

NOTE:
ALL CONSTRUCTION TO BE
IN ACCORDANCE WITH IDAHO
STATE STANDARDS FOR
PUBLIC WORKS. (ISPCW).

NOTE:
WATER PRESSURE REDUCER
EXIST 20' RT. OF STA.
27+20 ELEV. 767.55
AT TOP AND CENTER LID

AS BUILT

ROAD TYPICAL SECTION

SCALE 1"=5'

NOTE: FROM STA. 4+00 TO 9+00 AVISTA
GAS LINE EXIST IN 10' UTILITY STRIP
WATER LINE NEEDS TO BE PLACED 3' FROM
WEST SIDE EASEMENT.

BASIS OF BEARING


DUTHIE BOULEVARD WATER LINE

SCALE IN FEET

RIO VISTA DRIVE - PROFILE

PLAN
NOTE BOOK
NO.

PROFILE
NOTE BOOK
NO.

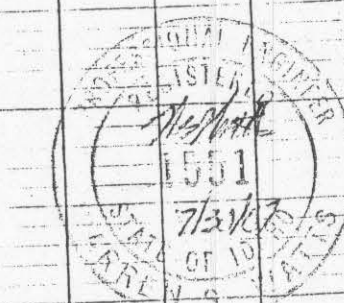

HORIZONTAL SCALE IN FEET

VERTICAL SCALE IN FEET