


AS BUILT

DATE	BY	REVISION
		1. AS BUILT

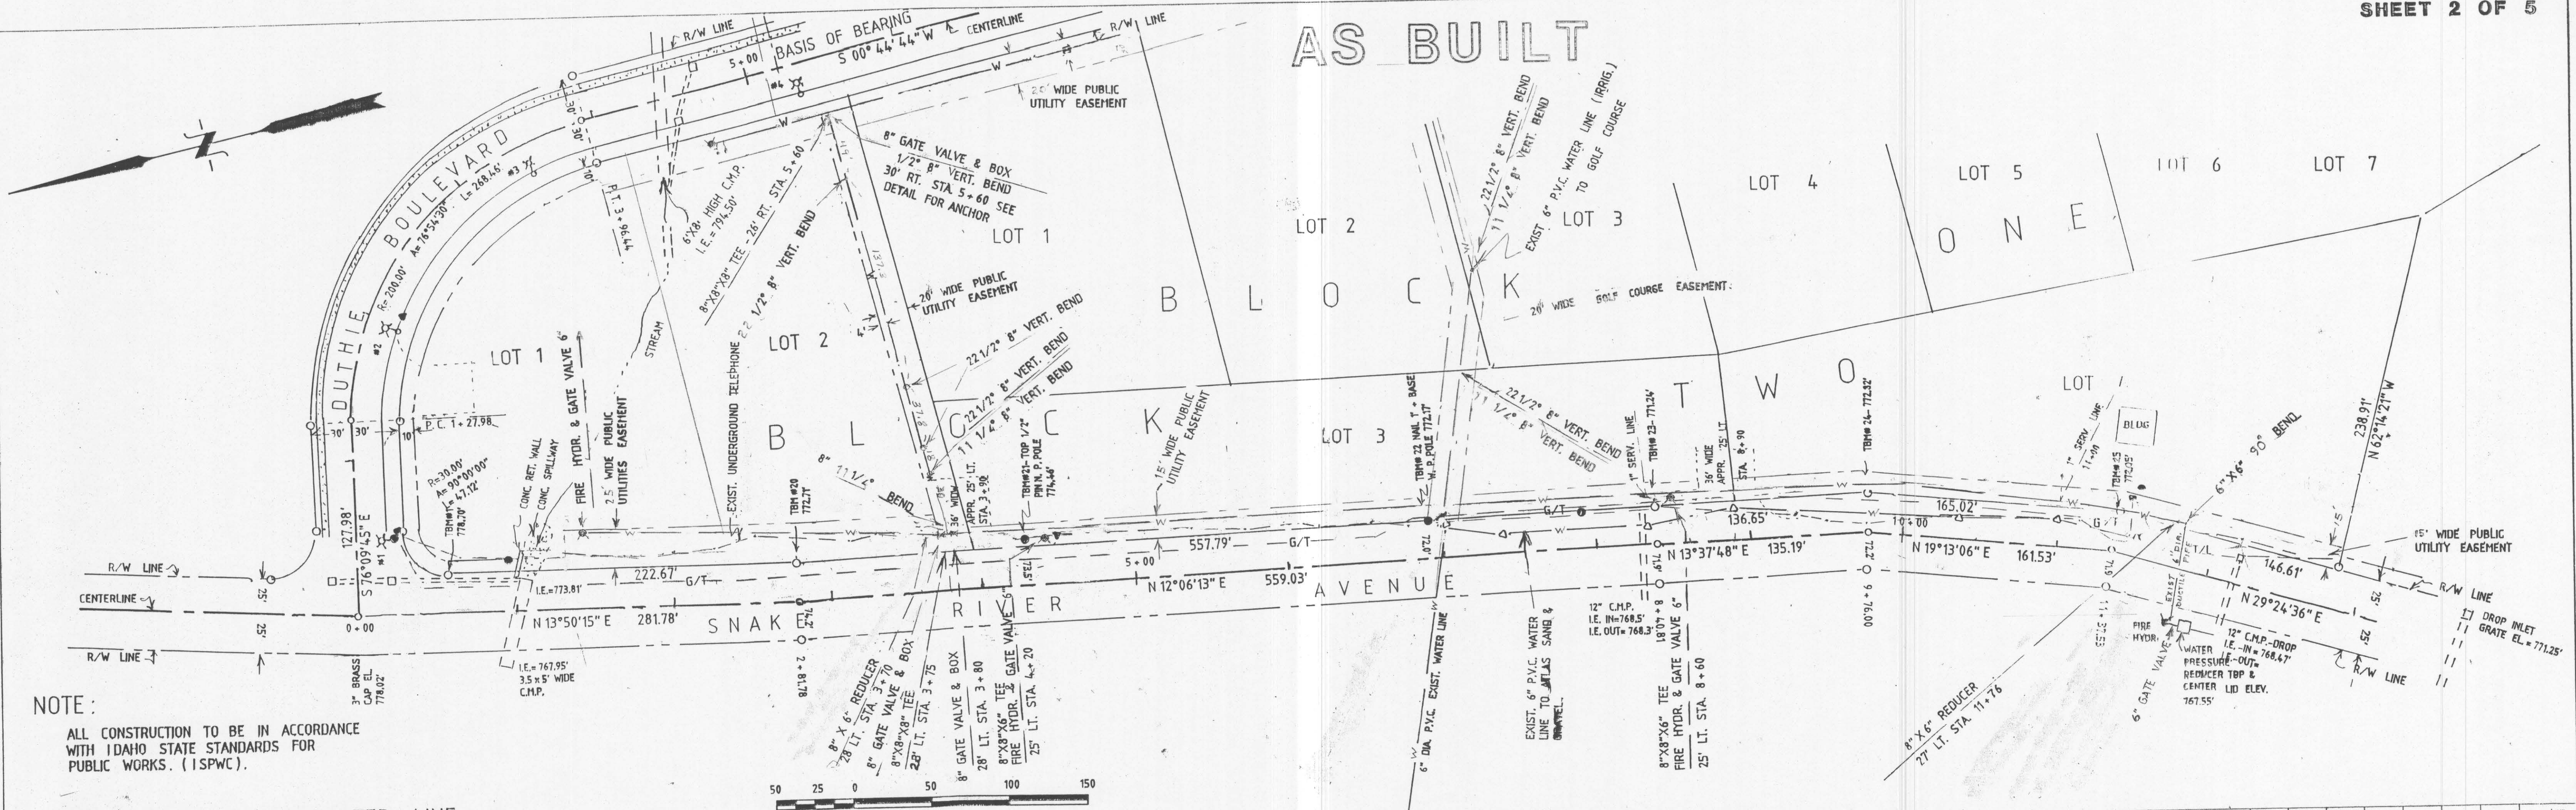

NOTE:
ALL CONSTRUCTION TO BE IN ACCORDANCE
WITH IDAHO STATE STANDARDS FOR
PUBLIC WORKS. (ISPWC).

Snake River Avenue Water Line


LEGEND

MANHOLE
PROPERTY CORNER - FOUND 5/8" BY 30" REBAR / CAP.
UTILITY LINE ANGLE POINT - NOT SET.
PROPOSED LOT CORNER - NOT SET.
TELEPHONE STAND.
STORM WATER BASIN INLET - EXISTING.
CENTERLINE ROAD COURSE CHANGE - FOUND BRASS CAP IN CASE
WATER LINE VALVE CASE - EXISTING
STREET LIGHT - EXISTING.
POWER POLE - EXISTING
CULVERT EXISTING.
ROAD CENTERLINE
EASEMENT LINE
WATER LINE - EXISTING.
GAS LINE - EXISTING.
ELECTRIC LINE UNDERGROUND - EXISTING.
EXISTING STORM DRAIN.


BENCH MARKS - SEA LEVEL

T.B.M. # & IDENT.	ELEV.	ELEV. TOP C/G
1 PROP. COR.	778.70'	
2 LIGHT POLE - TOP ELECT. BOX	790.06'	789.07'
3	802.40'	800.85'
4	816.26'	815.29'
5	829.73'	828.14'
6	841.79'	840.74'
7	854.40'	853.33'
8	867.26'	866.07'
9	879.53'	878.58'
10	893.07'	891.84'
11	906.24'	905.16'

SCALE IN FEET

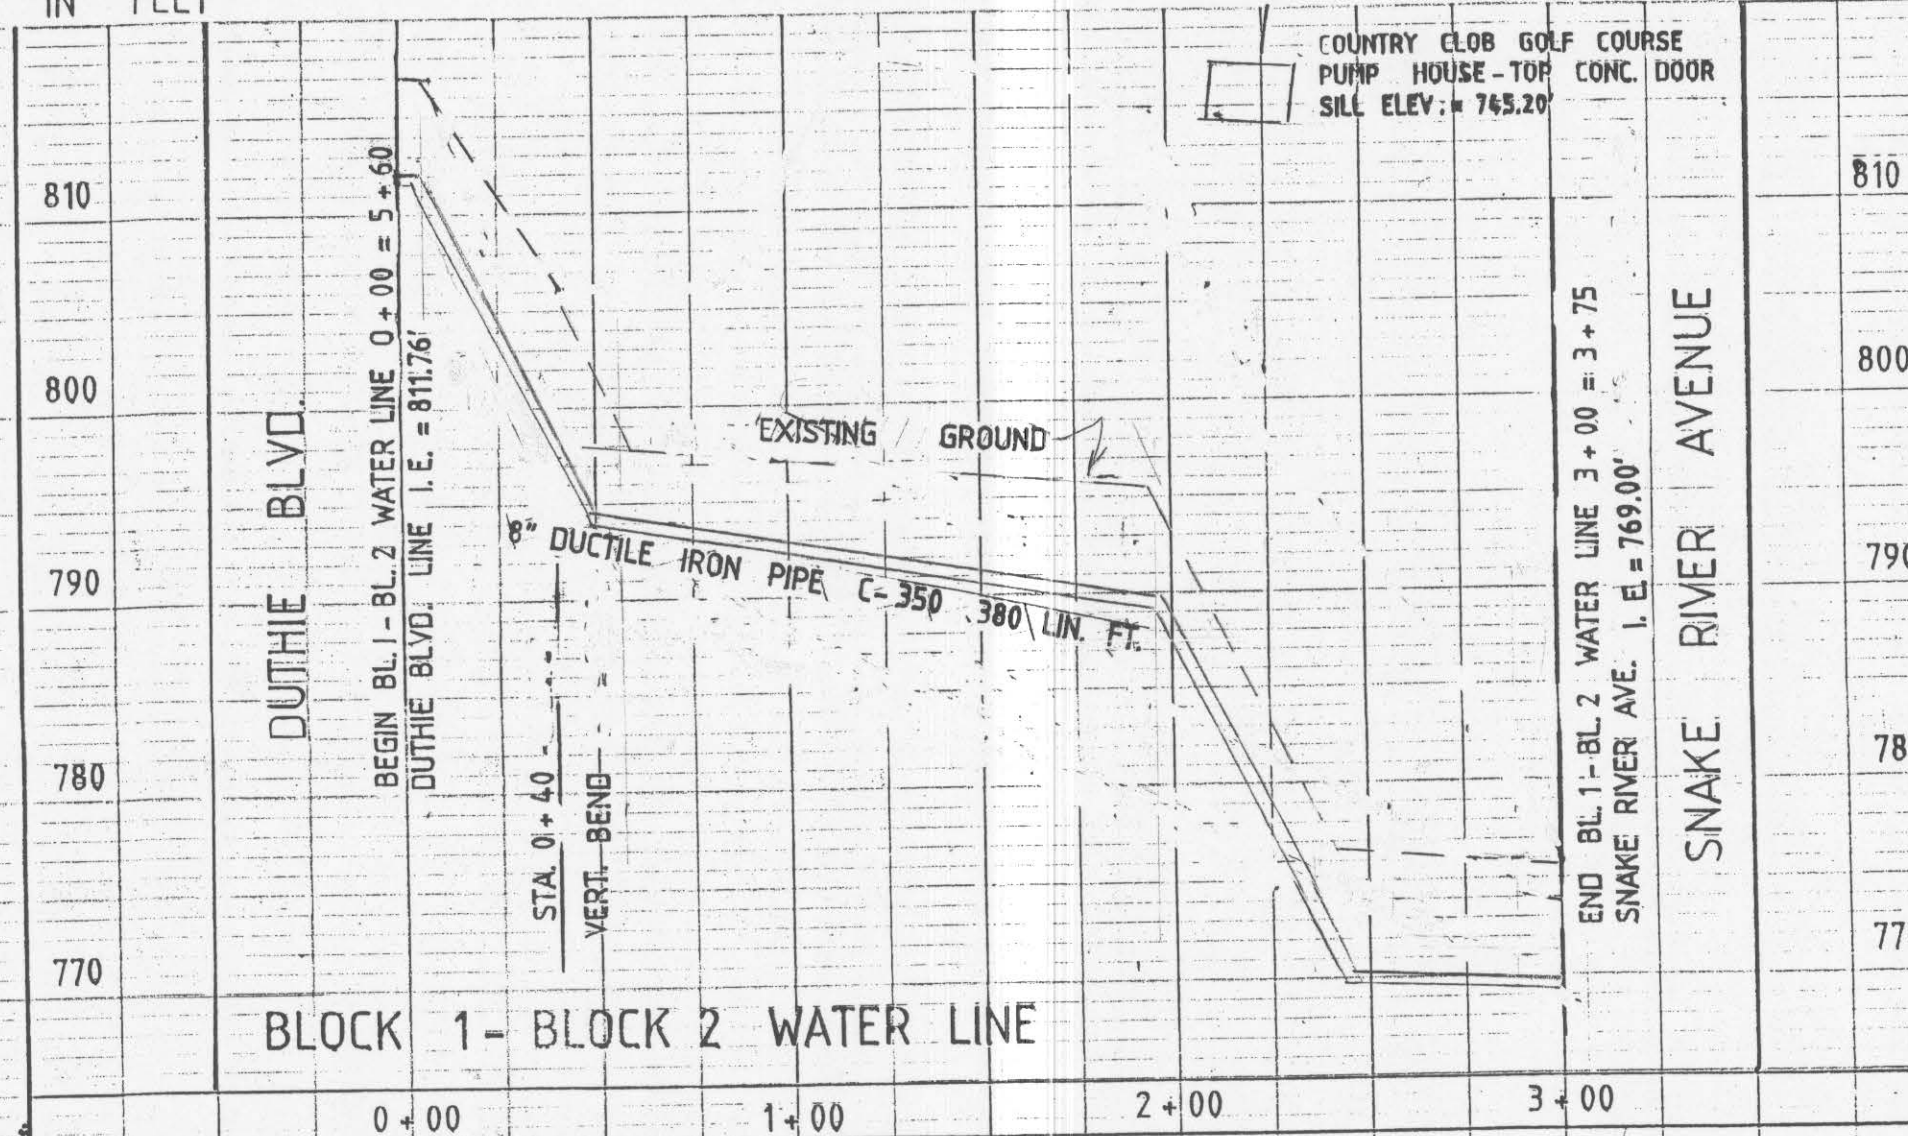

DUTHIE BOULEVARD TYPICAL

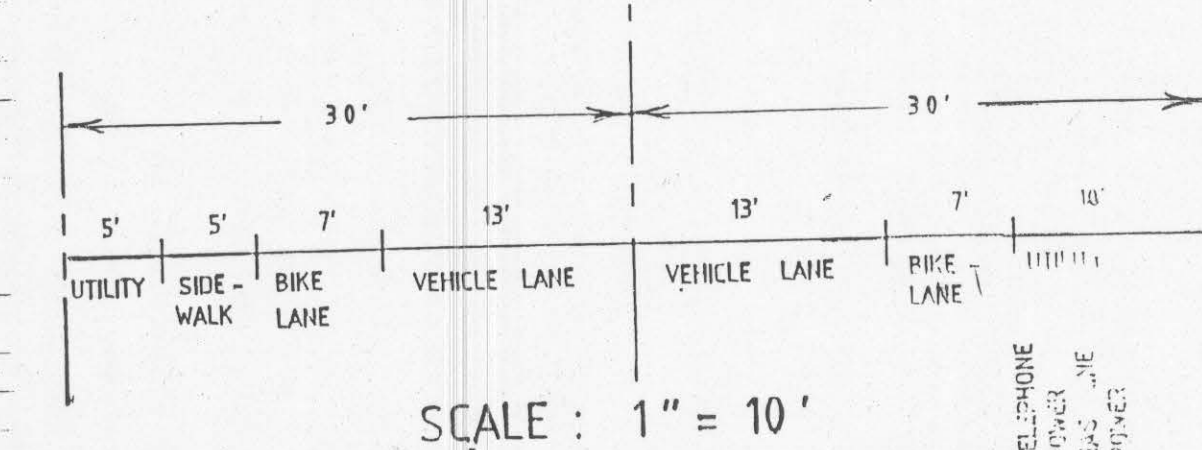

WATER LINE LEGEND

WATER VALVE
FIRE HYDRANT
TEE OR BEND
WATER LINE
STORM DRAIN
SANITARY SEWER
POWER / TELEPHONE / GAS

HORIZONTAL SCALE IN FEET

VERTICAL SCALE IN FEET

DATE	BY	REVISION
		1. AS BUILT

