

AVISTA	#	FIBER	CONSTRUCTION
DIST. POLES	7	1045'	AERIAL 96 STRAND F.O.CABLE
TXM. POLES	0	1589'	Buried 96 STRAND F.O.CABLE
CONDUITS	0	1139'	1½" HDPE CONDUIT
ANCHORS	0	1	2" SCHEDULE 40 RISER
MGN'S	7	1	NEW ANCHOR
		7	AERIAL MARKER
		1	BURIED MARKER
		0	PUPI ARM
		1	EXTENSION ARM
		4	NEW HAND HOLE


Project begins at Avista pole #182113 at the intersection of 11th st and Warner Ave. Proceeding south on the East side of 11th street 895' to Avista pole# 182105. Then transitioning to buried proceeding south on the East side of 11th street to the intersection of 11TH street and Bryden Ave. Then proceeding buried West on the North side of Bryden Ave. to 1021 Bryden Ave.

CONTACTS:
AVISTA: TODD ELLSWORTH -509-495-2773

CENTURY LINK: Rick Harms – 509-235-3349

CABLE ONE: TOM DONOHUE – 208-791-5032

X O COMM.: STEVE STYERN – 509-444-8547

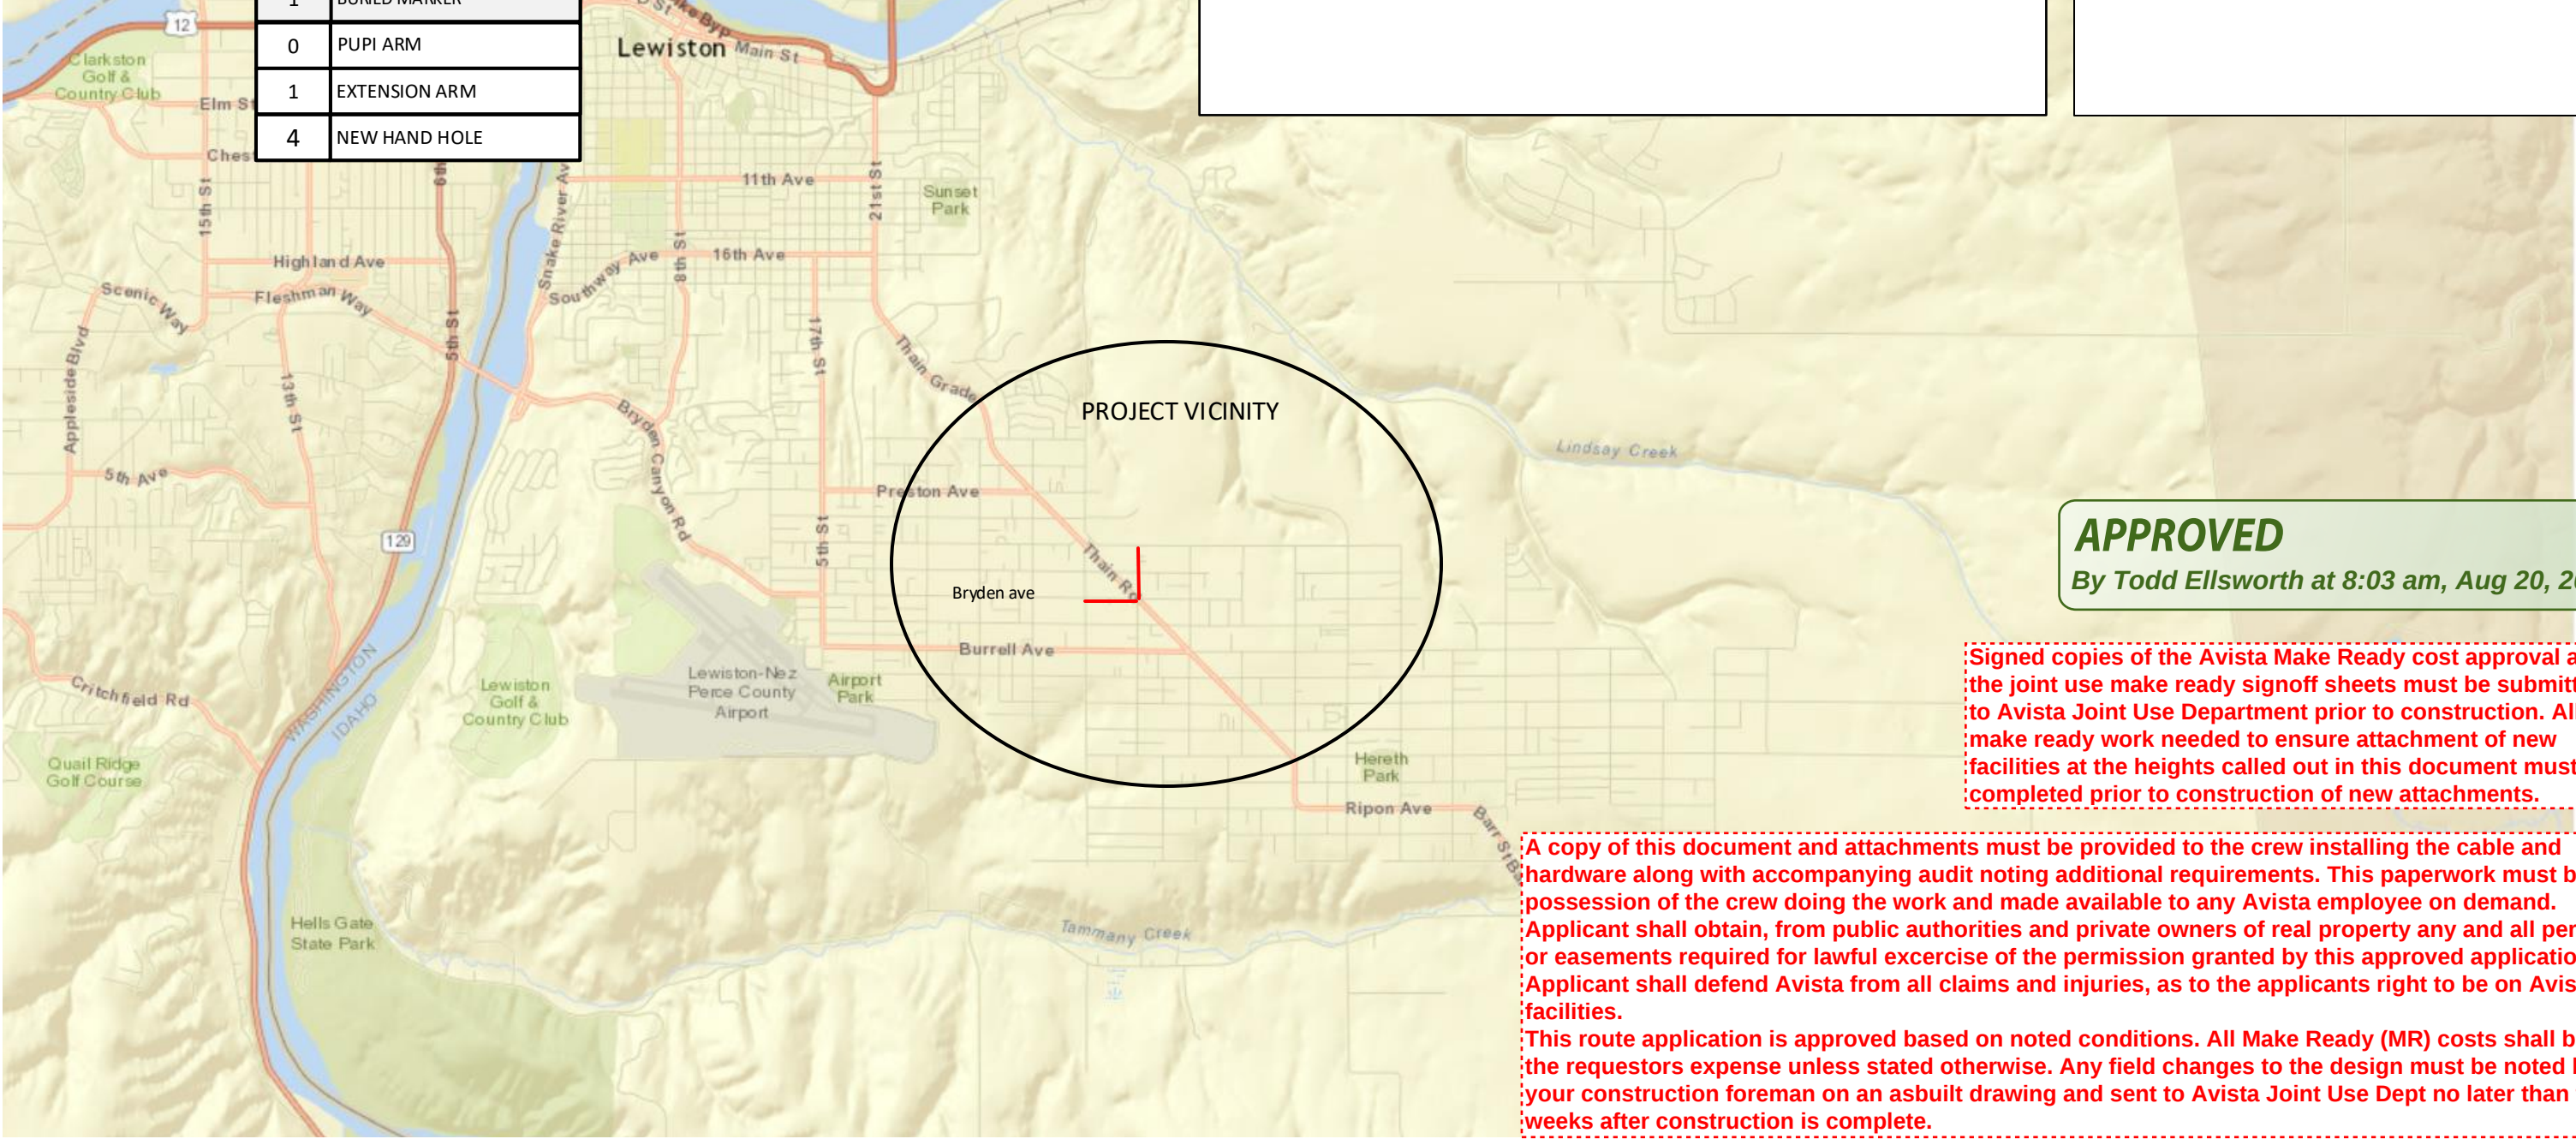

Drawing Name:Port of Lewiston	Drawn By: Ron Glessner 07-24-18			
	1021 BRYDEN AVE			
	SIZE	FSCM NO	DWG NO	REV
	SCALE		SHEET 1	

REV.	DESCRIPTION	DATE	BY
REV.	DESCRIPTION	DATE	BY
REV.	DESCRIPTION	DATE	BY
REV.	DESCRIPTION	DATE	BY

Contact Information	State: ID County:Nez Perce City:Lewiston
Port of Lewiston Dave Doeringsfeld 208-743-5531 Outside Plant Maintenance,Ilc Ron Glessner208-661-5648	Section: Township: Range: Legal:



GENERAL CONSTRUCTION NOTES

CONTRACTOR IS RESPONSIBLE FOR ALL PERMITS EXCEPT STATE HWY., COUNTY ROAD,RAILROAD
OR WATER CROSSINGS.

RESTORATION OF ALL RIGHT OF WAY GROUND WILL BE RESTORED TO ORIGINAL CONDITION OR BETTER.

**CONTRACTOR WILL COORDINATE WITH OSP MANAGER 24 HRS. PRIOR TO BEGINNING CONSTRUCTION.
CALL OSP MANAGER WHEN CONSTRUCTION IS COMPLETED. RON 208-661-5648**

OSP MANAGER WILL CONTACT BUILDING OWNER/TENANT 24 HRS. PRIOR TO
BEGINNING CONSTRUCTION TO COORDINATE ACCESS TO BUILDINGS.

CONTRACTOR IS RESPONSIBLE FOR CALLING LOCATES AND IS RESPONSIBLE
FOR REPAIR AND RESTORATION OF DAMAGED UTILITIES.

FOLLOW ALL NESC CONSTRUCTION GUIDELINES.


CONTRACTOR WILL HAVE ON SITE THE APPROVED DRAWINGS FROM THE UTILITY AND OR
STATE,COUNTY,CITY,RAILROAD.


CONTRACTOR WILL PROVIDE CONDUIT , HAND HOLES , ANCHORS, AERIAL HARDWARE , LOCATE WIRE

PORT OF LEWISTON (POL) WILL PROVIDE , FIBER OPTIC CABLE ,
AERIAL MARKERS , AND LINE ROUTE MARKERS.

ABBREVIATIONS:


TIP	TOP INSIDE POSITION
TOP	TOP OUTSIDE POSITION
BIP	BOTTOM INSIDE POSITION
BOP	BOTTOM OUTSIDE POSTION
EA	EXTENSION ARM
PEA	PLACE EXTENSION ARM
RS	ROAD SIDE
FS	FIELD SIDE
DE	DEAD END
HOA	HEIGHT OF ATTACHMENT

 	CULVERT
	DIRECTIONAL BORE
	AERIAL CABLE
	BURIED CABLE
	NEW ANCHOR
	SIDEWALK ANCHOR
	EXISTING ANCHOR
	OVERHEAD GUY
	ATTACH TO POLE GROUND
	FIBER SLACK LOOP
	JOINT USE POLE
	CABLE CHANGE
	BURIED ROUTE MARKER
	EXISTING HAND HOLE
	NEW HAND HOLE

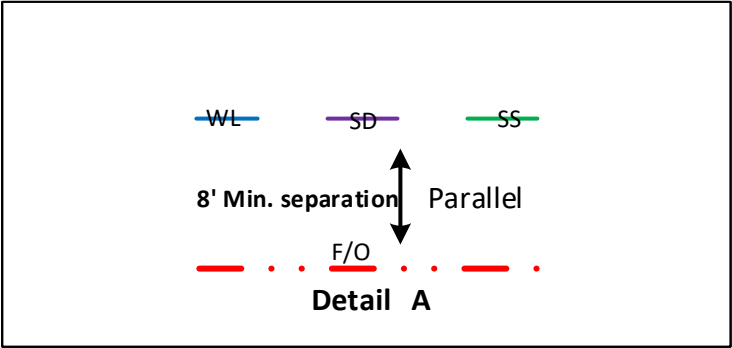

Cable Bundle Plot

1 = 5/16"11.2mEHS
2 = ORF-O-048-CN
Bundle = 0.792 in

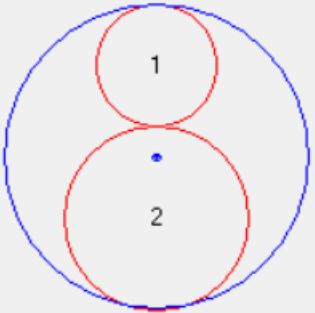

APPROVED

By Todd Ellsworth at 8:03 am, Aug 20, 2018

Drawing Name:Port of Lewiston	Drawn By:Ron Glessner 07-24-18								Contact Information Port of Lewiston Dave Doeringsfeld 208-743-5531 Outside Plant Maintenance,Ilc Ron Glessner208-661-5648	State:ID. County:Nez Perce City: Lewiston Section: Township: Range: Legal:
	1021 BRYDEN AVE				REV.	DESCRIPTION	DATE	BY		
	SIZE	FSCM NO	DWG NO	REV	REV.	DESCRIPTION	DATE	BY		
	SCALE	No scale		SHEET 2	REV.	DESCRIPTION	DATE	BY		



FIBER	CONSTRUCTION
1045'	AERIAL 48 STRAND F.O.CABLE
0'	Buried 48 STRAND F.O.CABLE
0'	1¼" HDPE CONDUIT
1	3" SCHEDULE 40 RISER
1	NEW ANCHOR
7	AERIAL MARKER
0	BURIED MARKER
0	PUPI ARM
1	EXTENSION ARM
1	NEW HAND HOLE

AVISTA	#
DIST. POLES	7
TXM. POLES	0
CONDUITS	0
ANCHORS	0
MGN'S	7

	00+64	17366	
POLE #	182112		
POLE CLASS	CL-4 45'		
ATTACHMENTS	HOA	POSITION	MISC
3 RACK	27'3"		
Svc. Riser	25'1"		
LIGHT	24'8"		
LSD	22'3"	RS	
LSD	21'9"	RS	
C 1	20'4"	RS	
X O	19'5"	RS	
POL	18'5"	RS	

	04+00	17698	
POLE #	182107		
POLE CLASS	CL-4 40'		
ATTACHMENTS	HOA	POSITION	MISC
3 RACK	26'5"		
RISER	24'10"		
LSD	22'3"	RS ↓	21'6"
C 1	20'1"	RS ↑	20'6"
X O	19'5"	RS	
Proposed POL	18'5"	RS	

	07+36	18036	
POLE #	182104		
POLE CLASS	CL-3 50'		
ATTACHMENTS	HOA	POSITION	MISC
NEUTRAL	32'2"		
LIGHT	28'8"		
LSD	27'	RS	
C 1	25'6"	RS	26'
CTL	23'3"	RS	25'
X O	24'	RS	
Proposed POL	23'	RS	

	00+00		
POLE #	182113		
POLE CLASS	CL-4 40'		
ATTACHMENTS	HOA	POSITION	MISC
NEUTRAL	25'		
C 1	20'5"	RS	
X O	19'11"	RS	
POL	18'11"	RS	

17526	02+27		
POLE #	182111		
POLE CLASS	CL-4 45'		
ATTACHMENTS	HOA	POSITION	MISC
3 RACK	26'7"		
LSD	23'	RS	
C 1	21'	RS	22'
XO	20'5"	RS	21'
Proposed POL	20'	RS	

17840	05+41		
POLE #	182106		
POLE CLASS	CL-4 45'		
ATTACHMENTS	HOA	POSITION	MISC
3 RACK	28'5"		
RISER	27'		
LSD	21'6"	RS ▲	23'6"
C 1	19'8"	RS ▲	22'6"
X O	18'6"	RS ▲	21'6"
Proposed POL	20'6"	RS	EA

18192	08+95		
POLE #	182105		
POLE CLASS	CL-4 40'		
ATTACHMENTS	HOA	POSITION	MISC
3 RACK	24'11"		
SINGLE EYE	24'4"		
LIGHT	22'11"		
LSD	22'2"	RS	21'
Proposed POL	20'	RS	

LSD MOVE HOA DOWN 9"
C 1 MOVE HOA UP 5"

C 1 MOVE HOA UP 6"
CTL MOVE HOA UP 9"
X O BOND TO GROUND
AND REMOVE OLD POLE

C 1 MOVE HOA UP 12"
XO MOVE HOA UP 7" TAKE
VACATED POSITION AT 21'
BOND TO GROUND

LSD MOVE HOA UP 24"
C 1 MOVE HOA UP 34"
X O MOVE HOA UP 36"
BOND TO GROUND

LSD LOWER HOA 14"
POL PLACE ANCHOR AND DG S. SIDE

APPROVED

By Todd Ellsworth at 8:03 am, Aug 20, 2018

PLACE HH IN ASPHALT MINIMUM
6' FROM BASE OF POLE.
LEAVE 150' FIBER SLACK

Drawing Name:Port of Lewiston

Drawn By: Ron Glessner 07-24-18

1021 BRYDEN AVE


SIZE	FSCM NO	DWG NO	REV
SCALE		SHEET 3	

REV.	DESCRIPTION	DATE	BY
REV.	DESCRIPTION	DATE	BY
Contact Information	State: ID County:Nez Perce City:Lewiston
Port of Lewiston Dave Doeringsfeld 208-743-5531 Outside Plant Maintenance,Ilc Ron Glessner208-661-5648	Section: Township: Range: Legal:




FIBER	CONSTRUCTION
0'	AERIAL 48 STRAND F.O.CABLE
1589'	Buried 48 STRAND F.O.CABLE
1139'	1½" HDPE CONDUIT
0	3" SCHEDULE 40 RISER
0	NEW ANCHOR
0	AERIAL MARKER
1	BURIED MARKER
0	PUPI ARM
0	EXTENSION ARM
3	NEW HAND HOLE

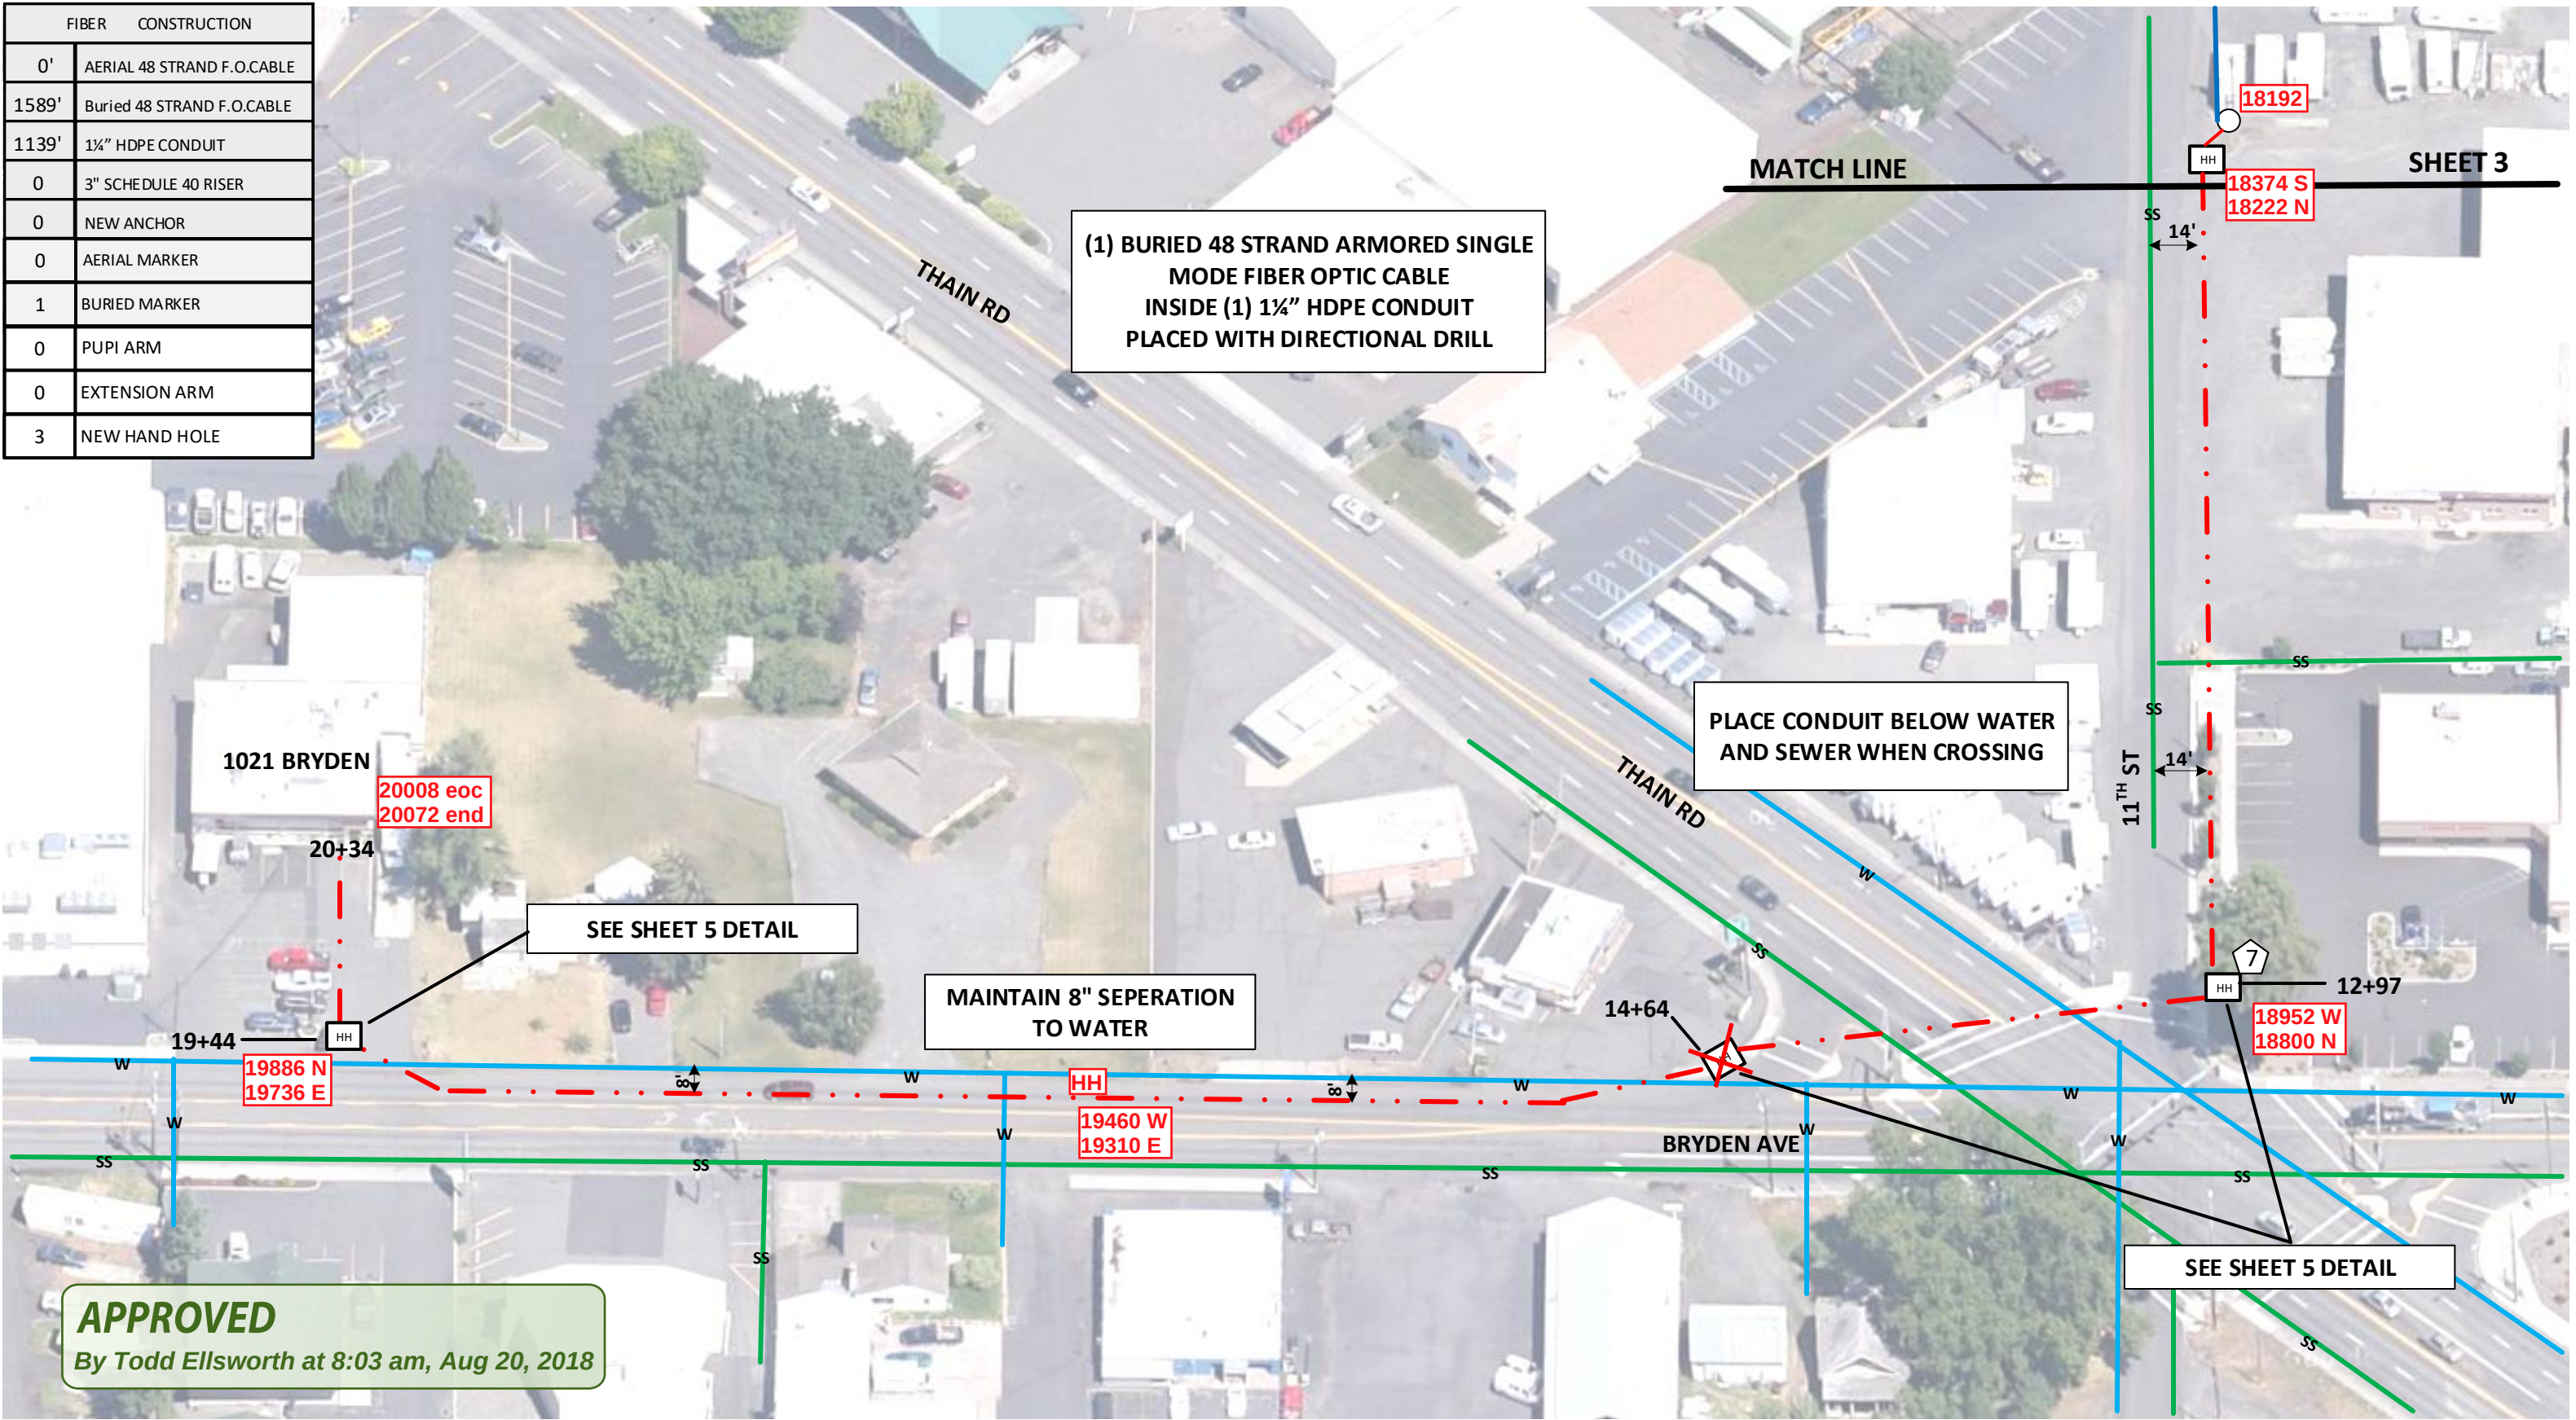

Drawing Name:Port of Lewiston	Drawn By: Ron Glessner 07-24-18				REV.	DESCRIPTION	DATE	BY	Contact Information Port of Lewiston Dave Doeringsfeld 208-743-5531 Outside Plant Maintenance, llc Ron Glessner208-661-5648	State: ID County:Nez Perce City:Lewiston
	1021 BRYDEN AVE				REV.	DESCRIPTION	DATE	BY		Section: Township: Range: Legal:
	SIZE	FSCM NO	DWG NO	REV	REV.	DESCRIPTION	DATE	BY		
	SCALE		SHEET 4		REV.	DESCRIPTION	DATE	BY		
					REV.	DESCRIPTION	DATE	BY		





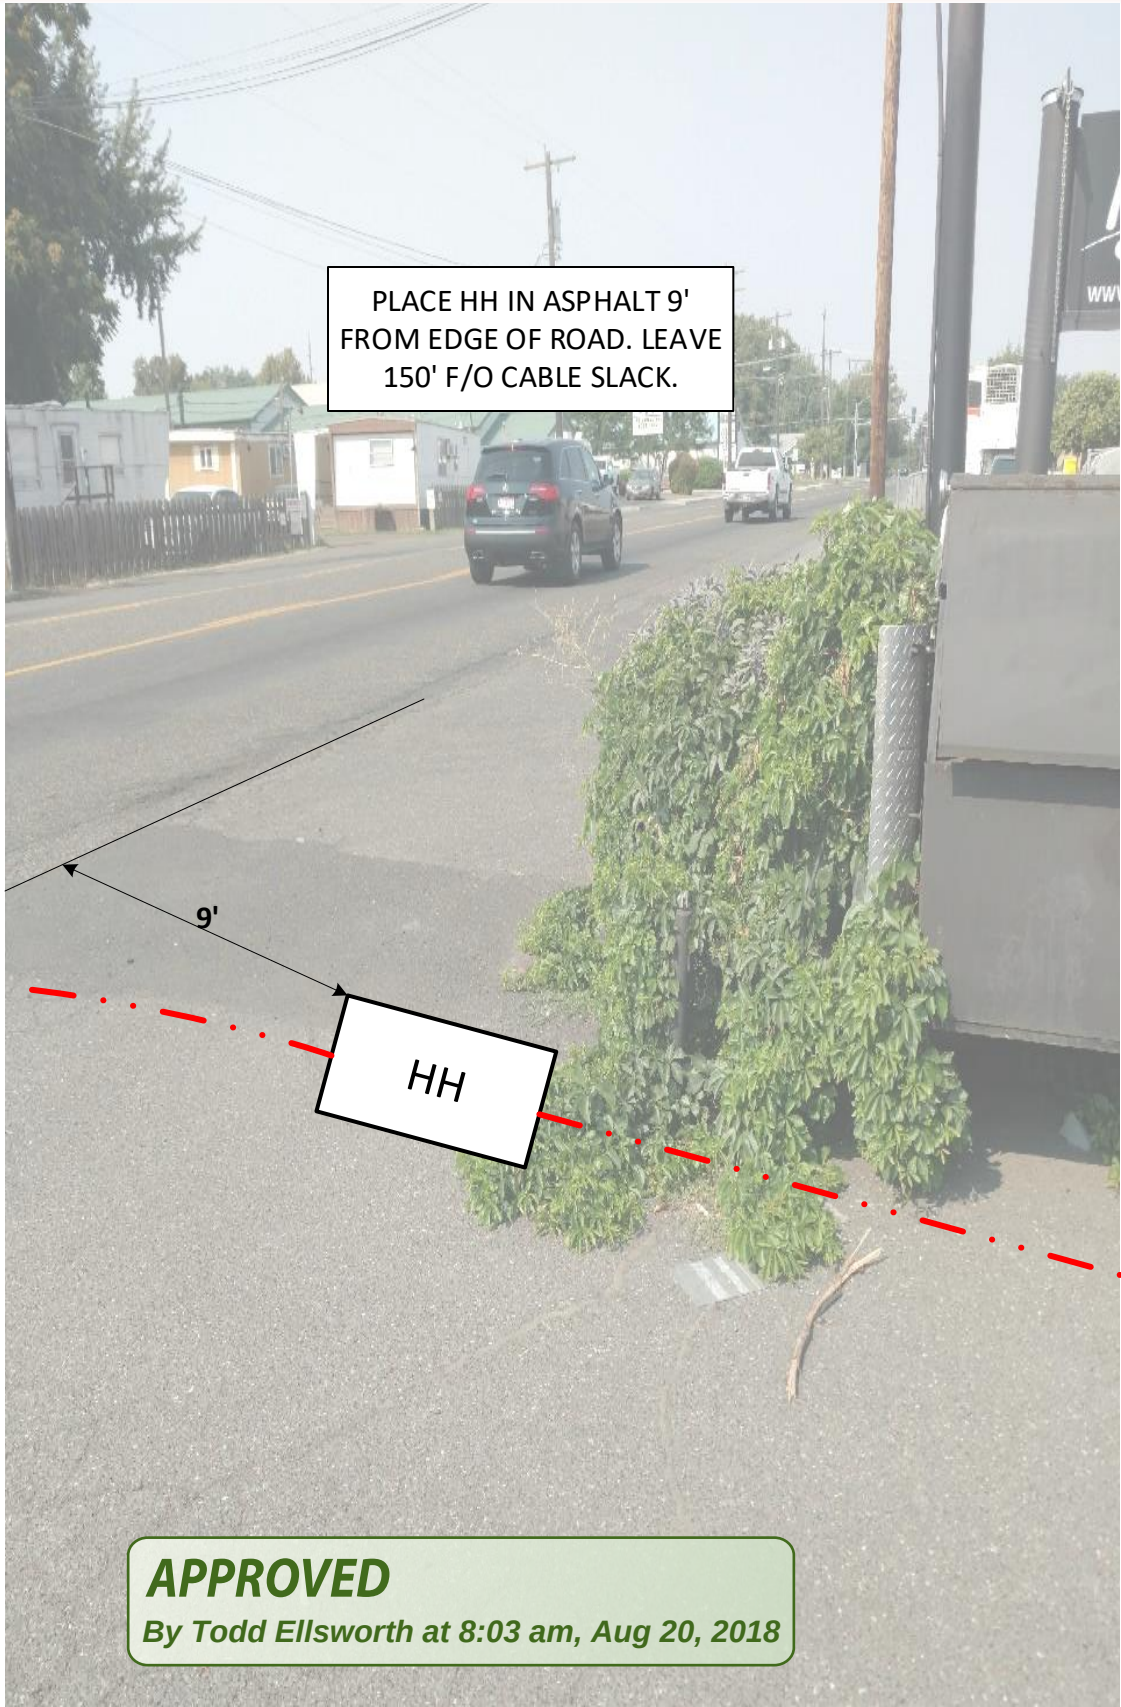

Drawing Name:Port of Lewiston		07-24-18			
		1021 BRYDEN AVE			
	SIZE	FSCM NO	DWG NO	REV	
	SCALE			SHEET 6	

REV.	DESCRIPTION	DATE	BY
REV.	DESCRIPTION	DATE	BY

Contact Information

Port of Lewiston
Dave Doeringsfeld
208-743-5531
Outside Plant Maintenance, LLC
Ron Glessner 208-661-5648

State: ID
County: Nez Perce
City: Lewiston

Section:
Township:
Range:
Legal:



Make Ready Summary	
Cable One	
Stationing	Description of work
02+27	Move HOA up 12" Bond to ground
04+00	Move HOA up 5" Bond to ground
05+41	Move HOA up 34" Bond to ground
07+36	Move HOA up 6" Bond to ground

Make Ready Summary	
Century Link	
Stationing	Description of Work
07+36	Move HOA up 9" Bond to ground

Make Ready Summary	
X O Communications	
Stationing	Description of Work
02+27	Move HOA up 7" Bond to ground
05+41	Move HOA up 36" Bond to ground
07+36	Transfer to new pole at 24' Bond to ground
07+36	Remove old pole

Make Ready Summary	
Avista	
Stationing	Description of Work

Make Ready Summary	
LEWISTON SCHOOL DISTRICT	
Stationing	Description of Work
04+00	Move HOA down 9"
05+41	Move HOA up 24"
08+95	Move HOA down 14"

APPROVED

By Todd Ellsworth at 8:03 am, Aug 20, 2018

Drawing Name:Port of Lewiston	07-24-18								Contact Information	State:ID County:Nez Perce City:Lewiston	
	1021 BRYDEN AVE										
	SIZE	FSCM NO	DWG NO	REV	REV.	DESCRIPTION	DATE	BY		Section: Township: Range: Legal:	
	SCALE			SHEET 7	REV.	DESCRIPTION	DATE	BY		Port of Lewiston Dave Doeringsfeld 208-743-5531 Outside Plant Maintenanc,llc Ron Glessner208-661-5648	

