

Drawing Name: Port of Lewiston

Drawn By: Ron Glessner 08-12-19

**2728 17<sup>TH</sup> STREET**

SIZE	FSCM NO	DWG NO	REV
SCALE		SHEET 1	

REV.	DESCRIPTION	DATE	BY
REV.	DESCRIPTION	DATE	BY
Contact Information

Port of Lewiston  
Dave Doeringsfeld  
208-743-5531  
Outside Plant Maintenance, llc  
Ron Glessner 208-661-5648

State: ID  
County: Nez Perce  
City: Lewiston

Section:  
Township:  
Range:  
Legal:



GENERAL CONSTRUCTION NOTES

CONTRACTOR IS RESPONSIBLE FOR ALL PERMITS EXCEPT STATE HWY., COUNTY ROAD,RAILROAD  
OR WATER CROSSINGS.

RESTORATION OF ALL RIGHT OF WAY GROUND WILL BE RESTORED TO ORIGINAL CONDITION OR BETTER.

**CONTRACTOR WILL COORDINATE WITH OSP MANAGER 24 HRS. PRIOR TO BEGINNING CONSTRUCTION.  
CALL OSP MANAGER WHEN CONSTRUCTION IS COMPLETED. RON 208-661-5648**

OSP MANAGER WILL CONTACT BUILDING OWNER/TENANT 24 HRS. PRIOR TO  
BEGINNING CONSTRUCTION TO COORDINATE ACCESS TO BUILDINGS.





 
 

 
 


 



CONTRACTOR IS RESPONSIBLE FOR CALLING LOCATES AND IS RESPONSIBLE  
FOR REPAIR AND RESTORATION OF DAMAGED UTILITIES.

FOLLOW ALL NESC CONSTRUCTION GUIDELINES.

CONTRACTOR WILL HAVE ON SITE THE APPROVED DRAWINGS FROM THE UTILITY AND OR  
STATE,COUNTY,CITY,RAILROAD.

CONTRACTOR WILL PROVIDE CONDUIT , FIBER OPTIC CABLE.

**CONTACT:  
Aaron Westgate at Inland  
Cellular for riser room entry.  
208-301-4111**

	CULVERT
	DIRECTIONAL BORE
	AERIAL CABLE
	EXISTING CONDUIT
	NEW ANCHOR
	SIDEWALK ANCHOR
	EXISTING ANCHOR
	OVERHEAD GUY
	ATTACH TO POLE GROUND
	FIBER SLACK LOOP
	FOREIGN POLE
	CABLE CHANGE
	BURIED ROUTE MARKER
	EXISTING HAND HOLE
	NEW HAND HOLE

Drawing Name:Port of Lewiston	Drawn By:Ron Glessner 08-12-19								Contact Information	State:ID. County:Nez Perce City: Lewiston	
	2728 17 <sup>TH</sup> STREET				REV.	DESCRIPTION	DATE	BY		Port of Lewiston Dave Doeringsfeld 208-743-5531 Outside Plant Maintenance,Ilc Ron Glessner208-661-5648	
	SIZE	FSCM NO	DWG NO	REV	REV.	DESCRIPTION	DATE	BY			
					REV.	DESCRIPTION	DATE	BY			
	SCALE	No scale		SHEET 2	REV.	DESCRIPTION	DATE	BY			







**CONTACT:**  
 Aaron Westgate at Inland  
 Cellular for riser room entry.  
 208-301-4111

**CANYON VIEW  
 APARTMENTS**

INSTALL ONE 2" RISER ON  
 EXISTING STAND OFF BRACKETS  
 INTERCEPT C1 RISER BELOW  
 GRADE AND PUSH NEW 6CT. FIBER  
 CABLE THROUGH EXISTING  
 CONDUIT INTO RISER ROOM ON  
 END OF APARTMENT BUILDING

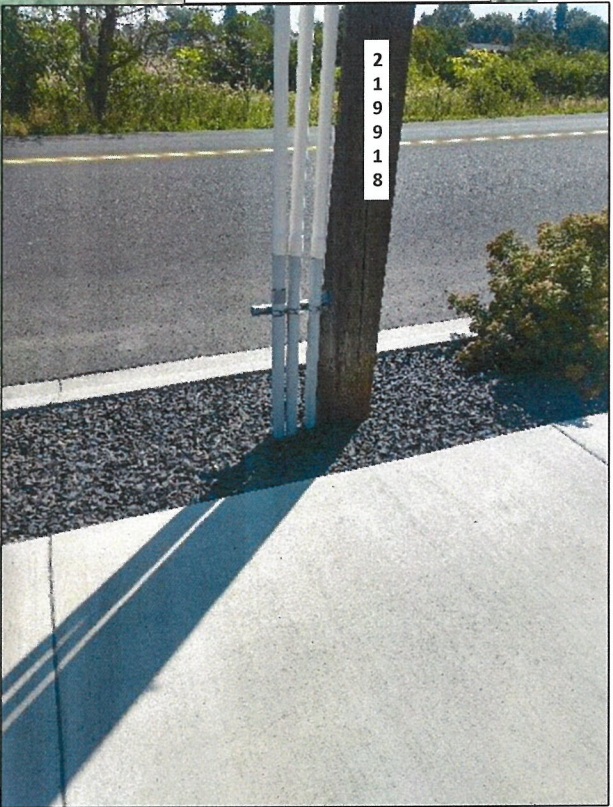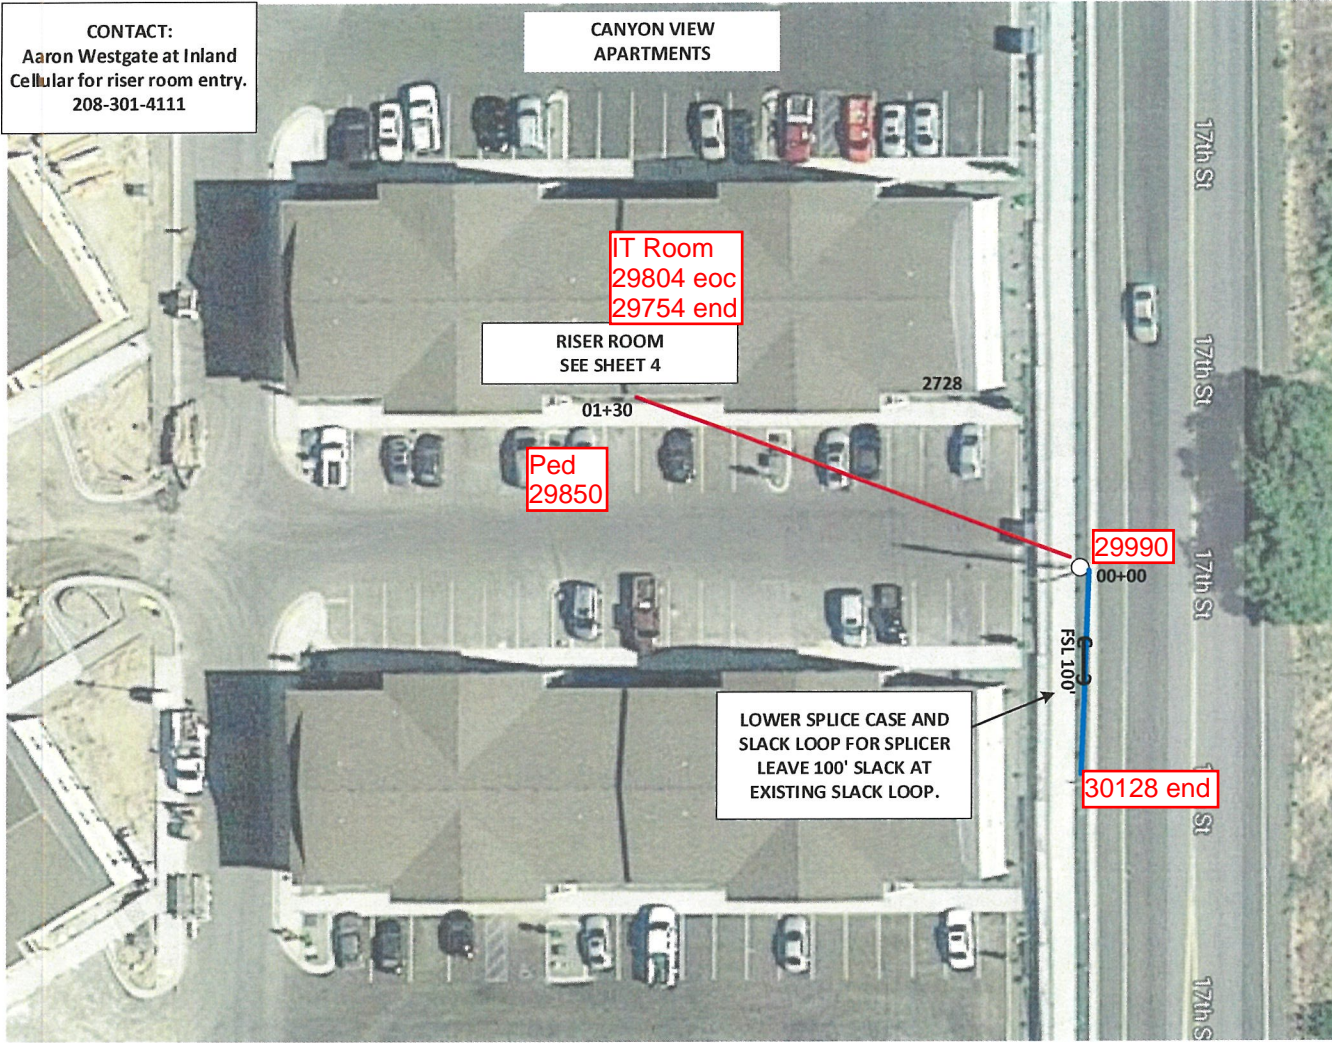

**Drawing Name: Port of Lewiston**

Drawn By: Ron Glessner 08-12-19

**2728 17<sup>th</sup> STREET**

SIZE	FSC1M NO	DWG NO	REV
SCALE		SHEET 3	

REV.	DESCRIPTION	DATE	BY
REV.	DESCRIPTION	DATE	BY
**Contact Information**

Port of Lewiston  
 Dave Doeringsfeld  
 208-743-5531  
 Outside Plant Maintenance, llc  
 Ron Glessner 208-661-5648


State: ID  
 County: Nez Perce  
 City: Lewiston

Section:  
 Township:  
 Range:  
 Legal:





**CONTACT:**  
**Aaron Westgate at Inland**  
**Cellular for riser room entry.**  
**208-301-4111**

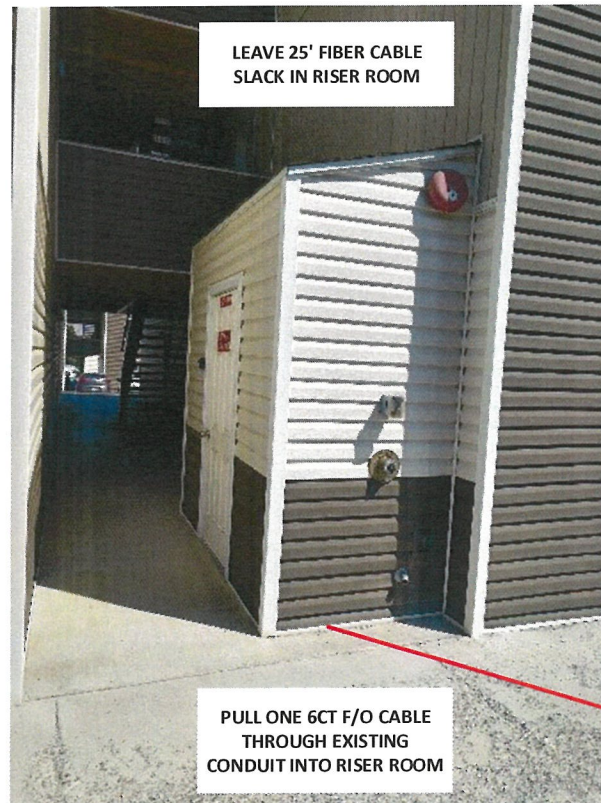

Drawing Name: Port of Lewiston	Drawn By: Ron Glessner 08-12-19				REV.	DESCRIPTION	DATE	BY	Contact Information	State: ID County: Nez Perce City: Lewiston	
	2728 17 <sup>TH</sup> STREET				REV.	DESCRIPTION	DATE	BY		Section: Township: Range: Legal:	
	SIZE	FSCM NO	DWG NO	REV	REV.	DESCRIPTION	DATE	BY	Port of Lewiston Dave Doeringsfeld 208-743-5531 Outside Plant Maintenance, llc Ron Glessner 208-661-5648		
	SCALE		SHEET 4		REV.	DESCRIPTION	DATE	BY			
					REV.	DESCRIPTION	DATE	BY			

