

Drawing Name: Port of Lewiston	Drawn By: Ron Glessner 01-09-19				REV.	DESCRIPTION	DATE	BY	Contact Information  Port of Lewiston Dave Doeringsfeld 208-743-5531 Outside Plant Maintenance, llc Ron Glessner208-661-5648	State: ID County:Nez Perce City:Lewiston
	2840 JUNIPER DR.				REV.	DESCRIPTION	DATE	BY		
	SIZE	FSCM NO	DWG NO	REV	REV.	DESCRIPTION	DATE	BY		Section: Township: Range: Legal:
	SCALE				REV.	DESCRIPTION	DATE	BY		
					REV.	DESCRIPTION	DATE	BY		



GENERAL CONSTRUCTION NOTES

CONTRACTOR IS RESPONSIBLE FOR ALL PERMITS EXCEPT STATE HWY., COUNTY ROAD,RAILROAD OR WATER CROSSINGS.

RESTORATION OF ALL RIGHT OF WAY GROUND WILL BE RESTORED TO ORIGINAL CONDITION OR BETTER.

CONTRACTOR WILL COORDINATE WITH OSP MANAGER 24 HRS. PRIOR TO BEGINNING CONSTRUCTION.

OSP MANAGER WILL CONTACT BUILDING OWNER/TENANT 24 HRS. PRIOR TO BEGINNING CONSTRUCTION TO COORDINATE ACCESS TO BUILDINGS.



 












CONTRACTOR IS RESPONSIBLE FOR CALLING LOCATES AND IS RESPONSIBLE FOR REPAIR AND RESTORATION OF DAMAGED UTILITIES.

FOLLOW ALL NESC CONSTRUCTION GUIDELINES.


BURIED CONDUIT MUST CROSS UNDERNEATH ALL CITY UTILITIES

CONTRACTOR WILL HAVE ON SITE THE APPROVED DRAWINGS FROM THE UTILITY AND OR STATE,COUNTY,CITY,RAILROAD.



CONTRACTOR WILL PROVIDE CONDUIT , FIBER OPTIC CABLE, AND HAND HOLES

	CULVERT
	DIRECTIONAL BORE
	EXISTING CONDUIT
	BURIED CABLE
	NEW ANCHOR
	SIDEWALK ANCHOR
	EXISTING ANCHOR
	OVERHEAD GUY
	ATTACH TO POLE GROUND
	FIBER SLACK LOOP
	JOINT USE POLE
	CABLE CHANGE
	BURIED ROUTE MARKER
	EXISTING HAND HOLE
	NEW HAND HOLE

Riser Detail

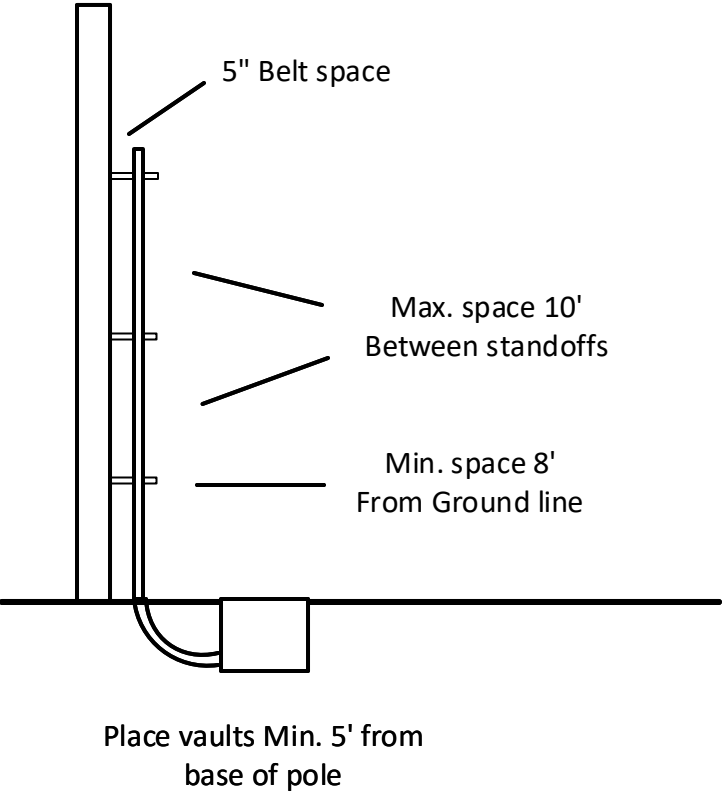


Vault/ Hand Hole Detail

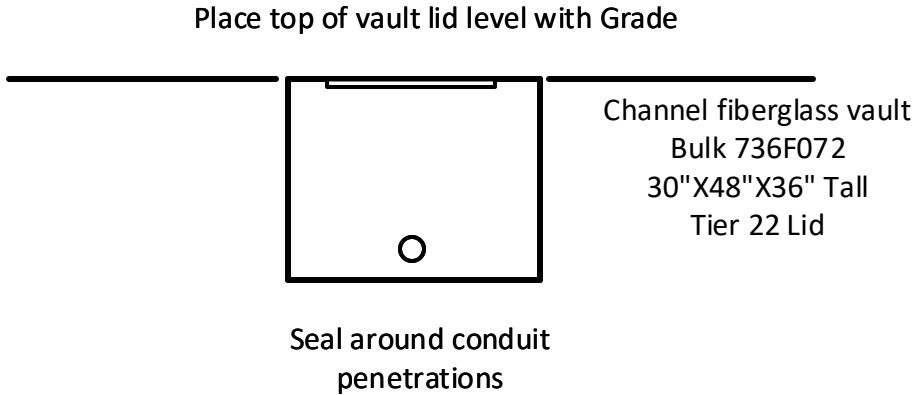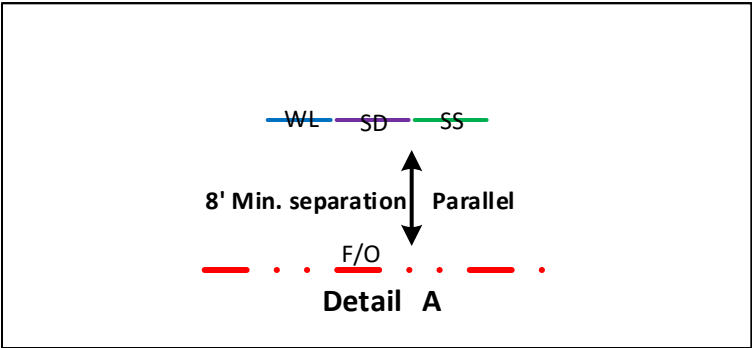

Drawing Name:Port of Lewiston	Drawn By:Ron Glessner 01-09-2019				REV.				Contact Information  Port of Lewiston Dave Doeringsfeld 208-753-5531 Outside Plant Maintenance,Ilc Ron Glessner208-661-5648	State:ID County:Nez Perce City:Lewiston  Section: Township: Range: Legal:
	2840 JUNIPER DR				REV.	DESCRIPTION	DATE	BY		
	SIZE	FSCM NO	DWG NO	REV	REV.	DESCRIPTION	DATE	BY		
	SCALE	No scale		SHEET 2	REV.	DESCRIPTION	DATE	BY		
					REV.	DESCRIPTION	DATE	BY		





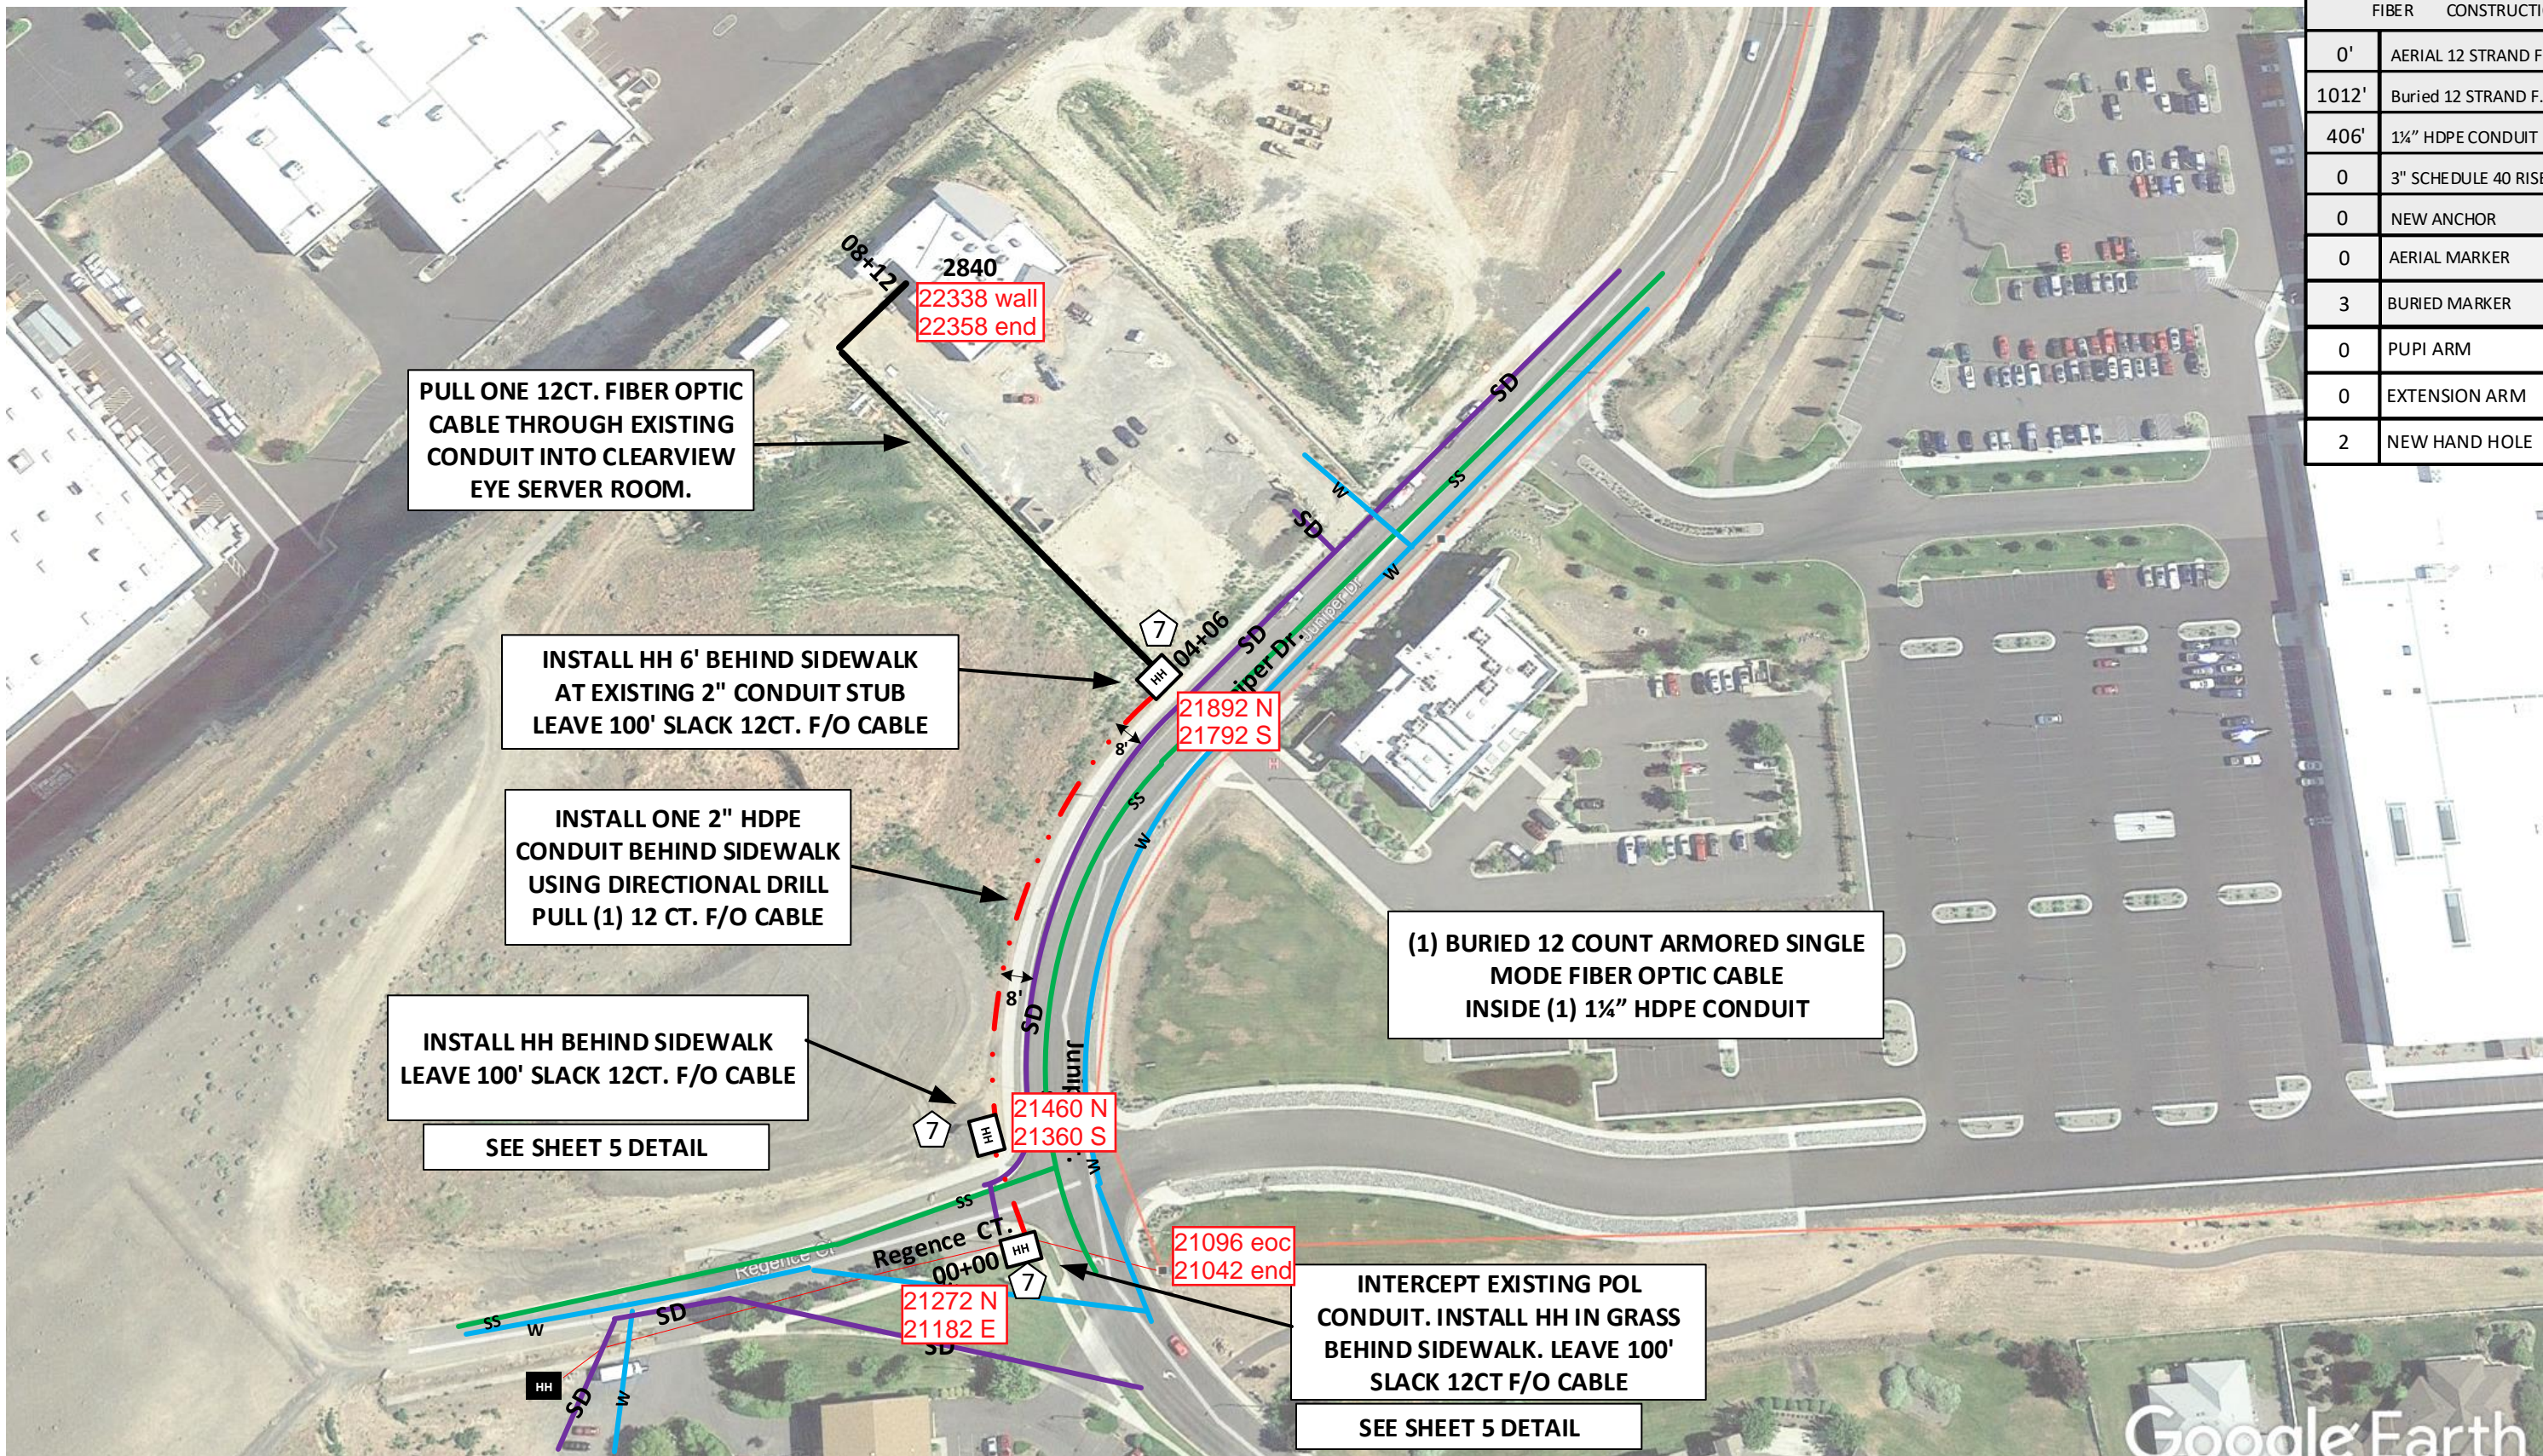

FIBER CONSTRUCTION	
0'	AERIAL 12 STRAND F.O.CABLE
1012'	Buried 12 STRAND F.O.CABLE
406'	1¼" HDPE CONDUIT
0	3" SCHEDULE 40 RISER
0	NEW ANCHOR
0	AERIAL MARKER
3	BURIED MARKER
0	PUPI ARM
0	EXTENSION ARM
2	NEW HAND HOLE

Drawing Name: Port of Lewiston

Drawn By: Ron Glessner 01-09-19

2840 JUNIPER DR

SIZE	FSCM NO	DWG NO	REV
SCALE		SHEET 3	

REV.	DESCRIPTION	DATE	BY
REV.	DESCRIPTION	DATE	BY
Contact Information	State: ID County:Nez Perce City:Lewiston
Port of Lewiston Dave Doeringsfeld 208-743-5531 Outside Plant Maintenance,Ilc Ron Glessner208-661-5648	Section: Township: Range: Legal:







PULL THROUGH EXISTING  
CONDUIT IN SERVER ROOM

FOR SERVER ROOM ACCESS  
CALL BUILDING MANAGER  
TERRY – 208-746-5100



INSTALL WALL MOUNTED  
PATCH PANEL

Drawing Name:Port of Lewiston	Drawn By: Ron Glessner 01-09-19			
	2840 JUNIPER DR.			
	SIZE	FSCM NO	DWG NO	REV
	SCALE		SHEET 4	


REV.	DESCRIPTION	DATE	BY
REV.	DESCRIPTION	DATE	BY
Contact Information	State: ID County:Nez Perce City:Lewiston
Port of Lewiston Dave Doeringsfeld 208-743-5531 Outside Plant Maintenance,Ilc Ron Glessner208-661-5648	Section: Township: Range: Legal:







Drawing Name: Port of Lewiston		Drawn By: Ron Glessner 01-09-19				REV.	DESCRIPTION	DATE	BY	Contact Information  Port of Lewiston Dave Doeringsfeld 208-743-5531 Outside Plant Maintenance, llc Ron Glessner208-661-5648	State: ID County:Nez Perce City:Lewiston	
		2840 JUNIPER DR				REV.	DESCRIPTION	DATE	BY		Section: Township: Range: Legal:	
	SIZE	FSCM NO	DWG NO		REV	REV.	DESCRIPTION	DATE	BY			
	SCALE			SHEET 5		REV.	DESCRIPTION	DATE	BY			
						REV.	DESCRIPTION	DATE	BY			