


Project begins at Avista pole# 215375 at the intersection of F ST. and 5<sup>th</sup> st in Lewiston ID.. Then proceeds East on the South side F ST. 95 feet to Avista pole# 134519. Then cable is dropped to the building on the North side of F street addressed 504 Main street.

**CONTACTS:**  
 AVISTA: KRISTIN NELSON – 509-495-2548  
 CENTURY LINK: Rick Harms – 509-235-3349  
 CABLE ONE: TOM DONOHUE – 208-791-5032  
 X O COMM. : STEVE STYERN – 509-444-8547

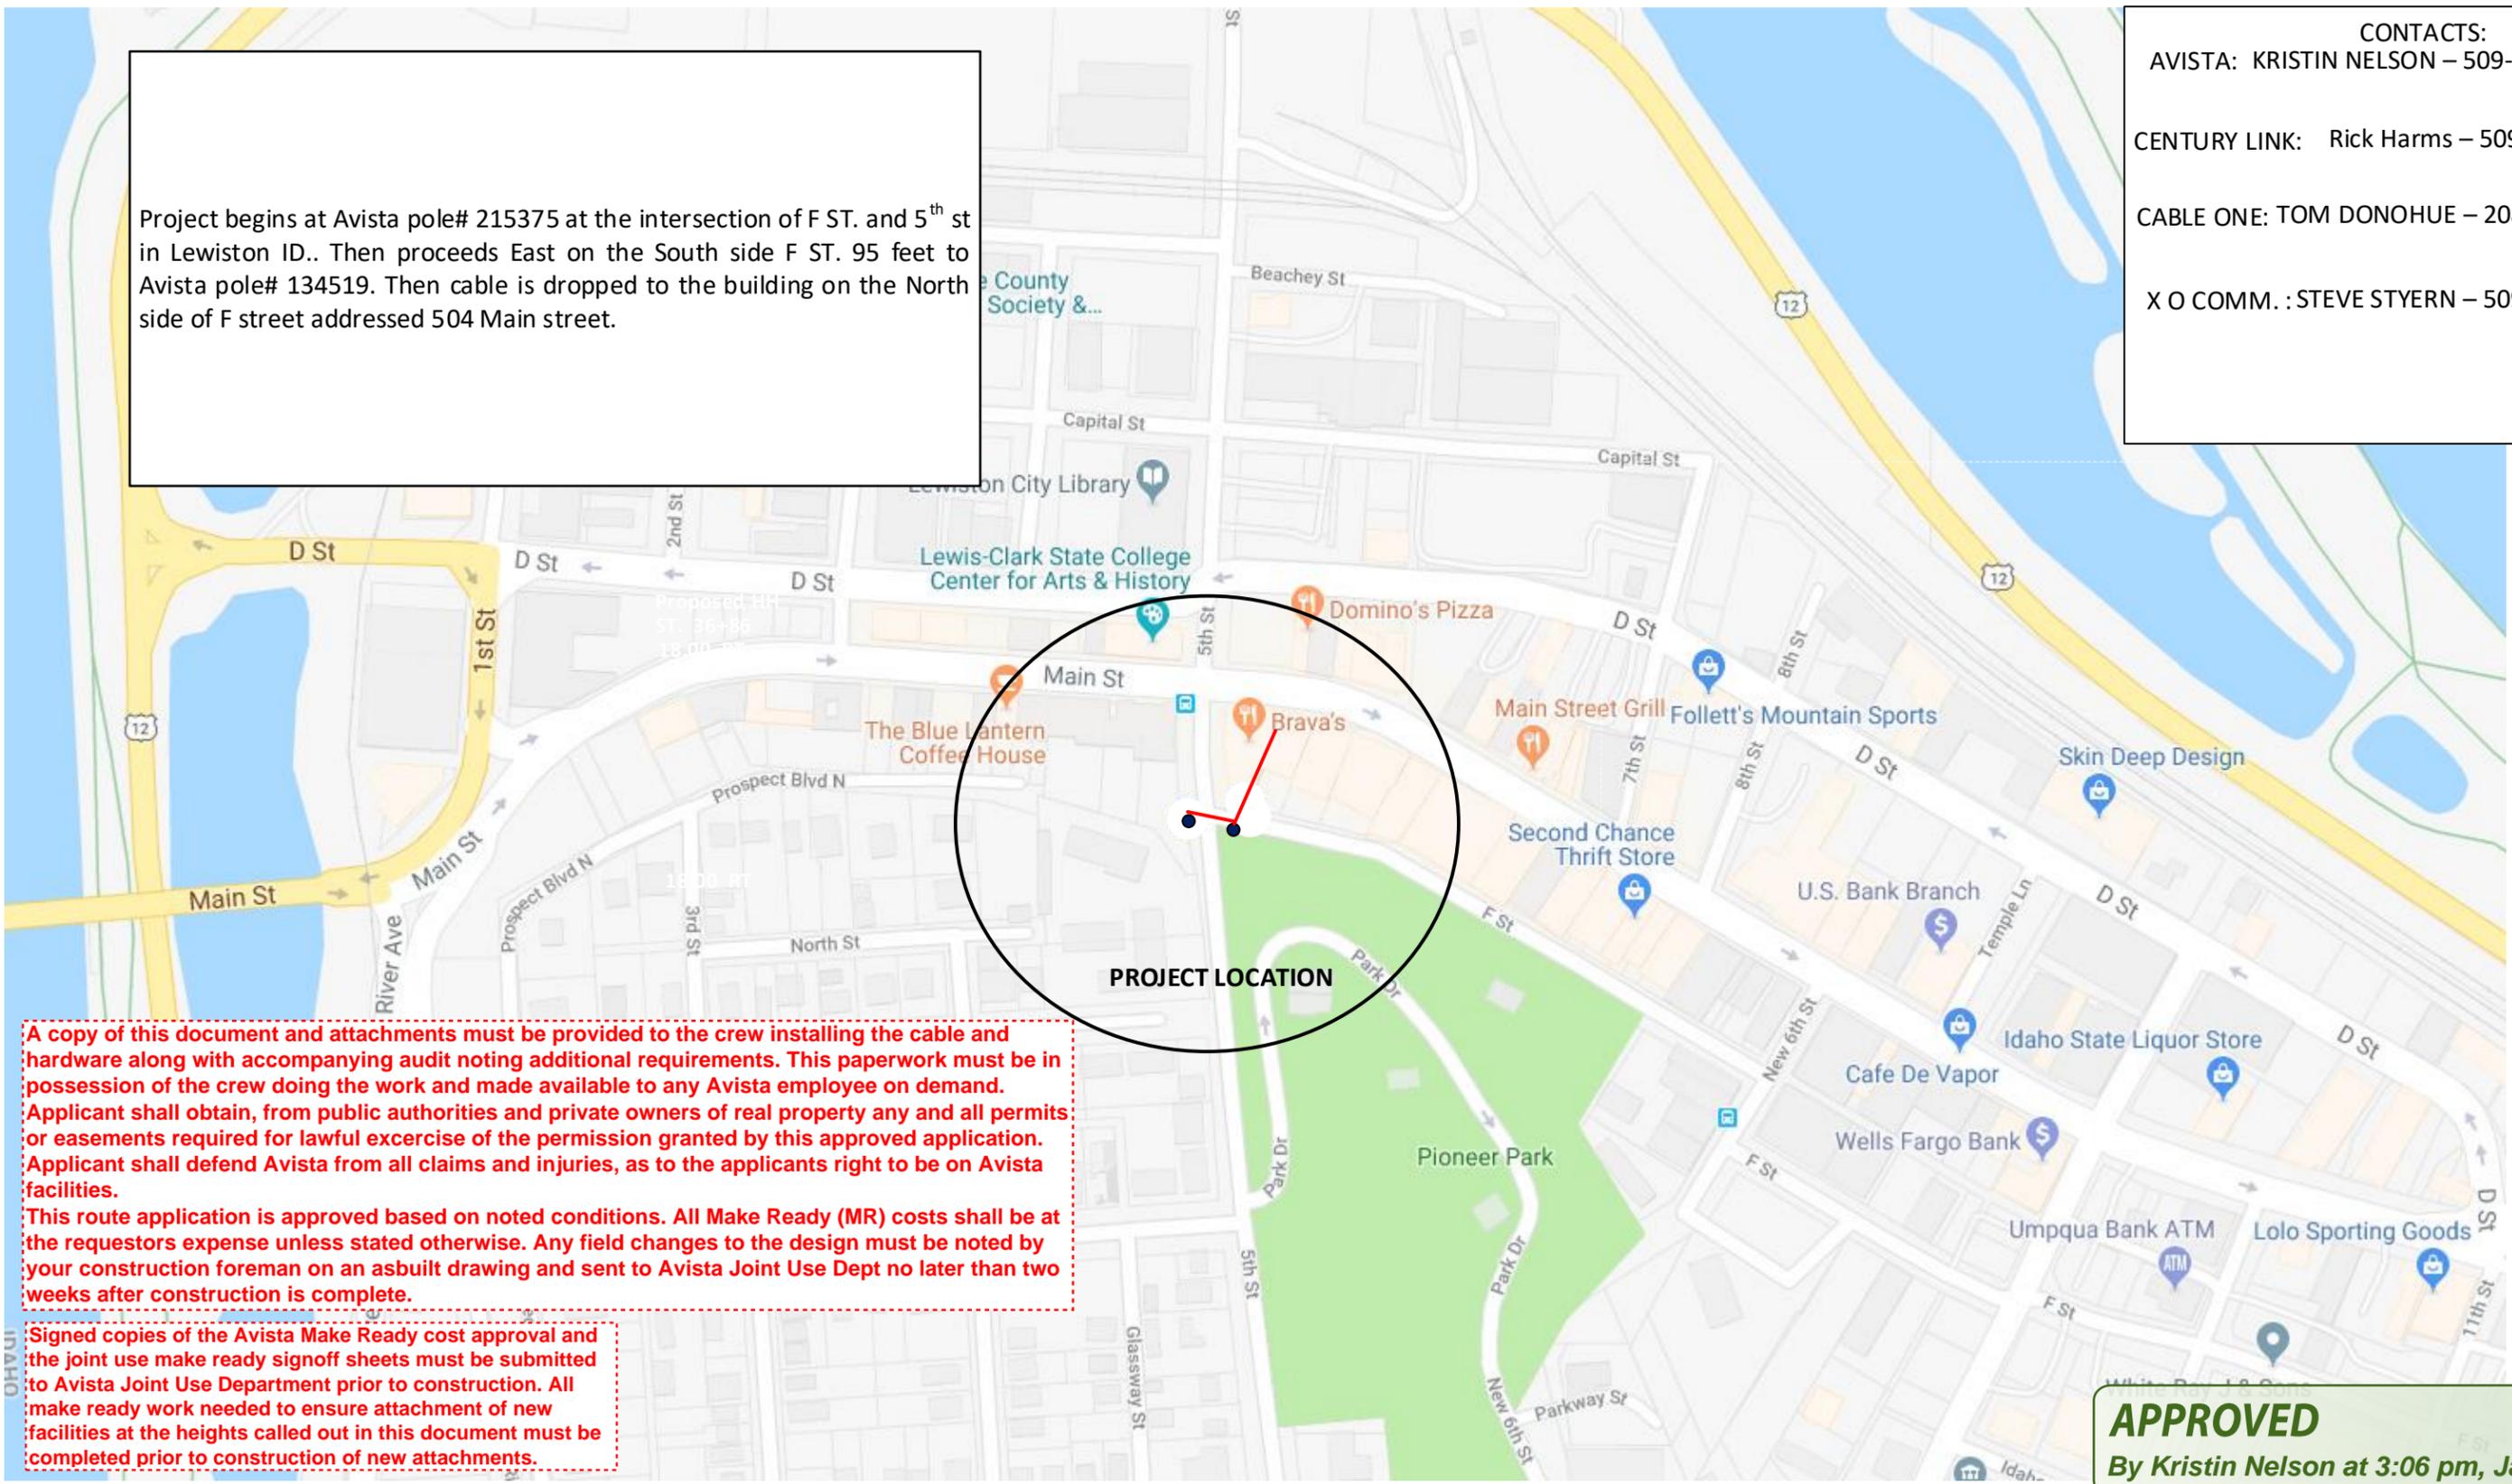

**A copy of this document and attachments must be provided to the crew installing the cable and hardware along with accompanying audit noting additional requirements. This paperwork must be in possession of the crew doing the work and made available to any Avista employee on demand. Applicant shall obtain, from public authorities and private owners of real property any and all permits or easements required for lawful exercise of the permission granted by this approved application. Applicant shall defend Avista from all claims and injuries, as to the applicants right to be on Avista facilities. This route application is approved based on noted conditions. All Make Ready (MR) costs shall be at the requestors expense unless stated otherwise. Any field changes to the design must be noted by your construction foreman on an asbuilt drawing and sent to Avista Joint Use Dept no later than two weeks after construction is complete.**

**Signed copies of the Avista Make Ready cost approval and the joint use make ready signoff sheets must be submitted to Avista Joint Use Department prior to construction. All make ready work needed to ensure attachment of new facilities at the heights called out in this document must be completed prior to construction of new attachments.**

**APPROVED**  
 By Kristin Nelson at 3:06 pm, Jan 02, 2019

|                                |         |                                 |     |
|--------------------------------|---------|---------------------------------|-----|
| Drawing Name: Port of Lewiston |         | Drawn By: Ron Glessner 12-04-18 |     |
| <b>504 MAIN STREET</b>         |         |                                 |     |
| SIZE                           | FSCM NO | DWG NO                          | REV |
| SCALE                          |         | SHEET 1                         |     |

| REV. | DESCRIPTION | DATE | BY |
|------|-------------|------|----|
|      |             |      |    |
|      |             |      |    |
|      |             |      |    |
|      |             |      |    |

|  |  |
|--|--|
| Contact Information  | State: ID<br>County: Nez Perce<br>City: Lewiston |
| Port of Lewiston<br>Dave Doeringsfeld<br>208-743-5531<br>Outside Plant Maintenance, llc<br>Ron Glessner 208-661-5648 | Section:<br>Township:<br>Range:<br>Legal:        |



GENERAL CONSTRUCTION NOTES

CONTRACTOR IS RESPONSIBLE FOR ALL PERMITS EXCEPT STATE HWY., COUNTY ROAD,RAILROAD OR WATER CROSSINGS.

RESTORATION OF ALL RIGHT OF WAY GROUND WILL BE RESTORED TO ORIGINAL CONDITION OR BETTER.

**CONTRACTOR WILL COORDINATE WITH OSP MANAGER 24 HRS. PRIOR TO BEGINNING CONSTRUCTION. CALL OSP MANAGER WHEN CONSTRUCTION IS COMPLETED. RON 208-661-5648**

OSP MANAGER WILL CONTACT BUILDING OWNER/TENANT 24 HRS. PRIOR TO BEGINNING CONSTRUCTION TO COORDINATE ACCESS TO BUILDINGS.

CONTRACTOR IS RESPONSIBLE FOR CALLING LOCATES AND IS RESPONSIBLE FOR REPAIR AND RESTORATION OF DAMAGED UTILITIES.

FOLLOW ALL NESC CONSTRUCTION GUIDELINES.

CONTRACTOR WILL HAVE ON SITE THE APPROVED DRAWINGS FROM THE UTILITY AND OR STATE,COUNTY,CITY,RAILROAD.


CONTRACTOR WILL PROVIDE CONDUIT , HAND HOLES , ANCHORS, AERIAL HARDWARE , FIBER OPTIC CABLE, LOCATE WIRE

PORT OF LEWISTON (POL) WILL PROVIDE , AERIAL MARKERS , AND LINE ROUTE MARKERS.

**ABBREVIATIONS:**

|     |                        |
|-----|------------------------|
| TIP | TOP INSIDE POSITION    |
| TOP | TOP OUTSIDE POSITION   |
| BIP | BOTTOM INSIDE POSITION |
| BOP | BOTTOM OUTSIDE POSTION |
| EA  | EXTENSION ARM          |
| PEA | PLACE EXTENSION ARM    |
| RS  | ROAD SIDE              |
| FS  | FIELD SIDE             |
| DE  | DEAD END               |
| HOA | HEIGHT OF ATTACHMENT   |

|  |                       |
|--|-----------------------|
|  | CULVERT               |
|  | DIRECTIONAL BORE      |
|  | AERIAL CABLE          |
|  | BURIED CABLE          |
|  | NEW ANCHOR            |
|  | SIDEWALK ANCHOR       |
|  | EXISTING ANCHOR       |
|  | OVERHEAD GUY          |
|  | ATTACH TO POLE GROUND |
|  | FIBER SLACK LOOP      |
|  | FOREIGN POLE          |
|  | CABLE CHANGE          |
|  | BURIED ROUTE MARKER   |
|  | EXISTING HAND HOLE    |
|  | NEW HAND HOLE         |

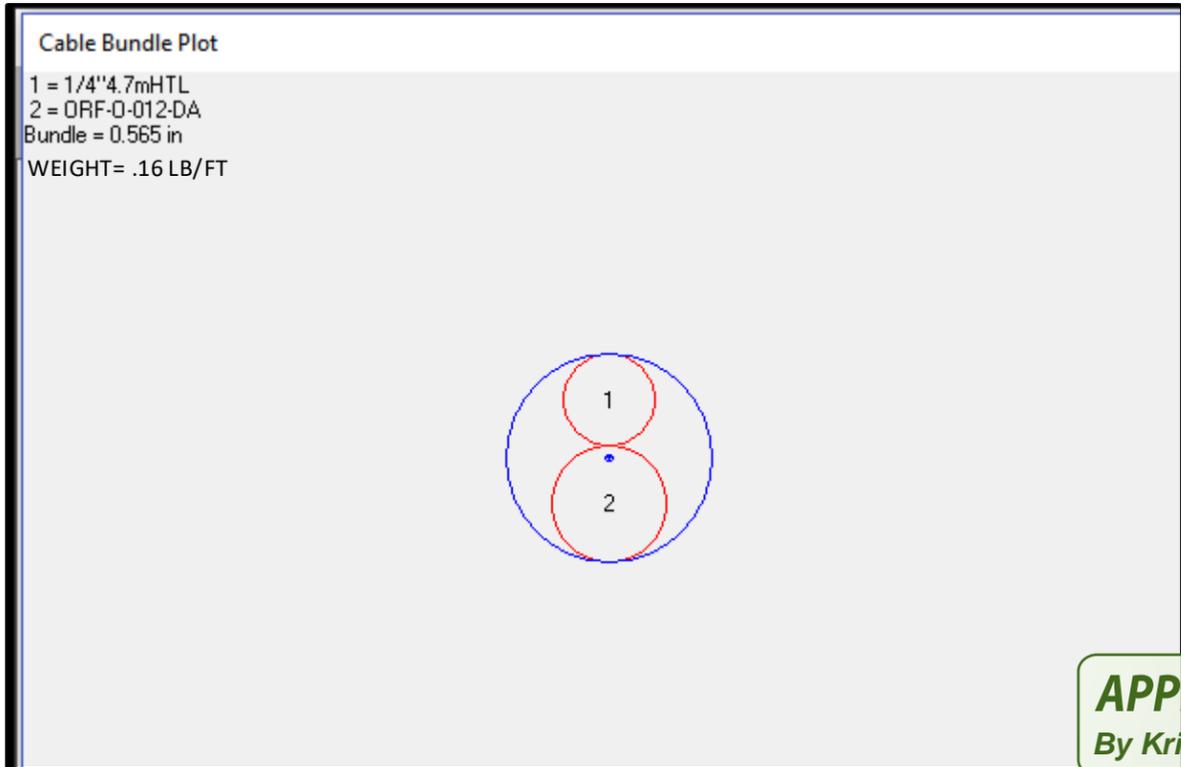

**APPROVED**  
By Kristin Nelson at 3:06 pm, Jan 02, 2019

|                               |          |                                |  |     |  |
|-------------------------------|----------|--------------------------------|--|-----|--|
| Drawing Name:Port of Lewiston |          | Drawn By:Ron Glessner 12-04-18 |  |     |  |
| <b>504 MAIN STREET</b>        |          |                                |  |     |  |
| SIZE                          | FSCM NO  | DWG NO                         |  | REV |  |
| SCALE                         | No scale | SHEET 2                        |  |     |  |

| REV. | DESCRIPTION | DATE | BY |
|------|-------------|------|----|
|      |             |      |    |
|      |             |      |    |
|      |             |      |    |
|      |             |      |    |



|  |  |   |  |
|--|--|---|--|
| Contact Information  |  | State:ID.<br>County:Nez Perce<br>City: Lewiston |  |
| Port of Lewiston<br>Dave Doeringsfeld<br>208-743-5531<br>Outside Plant Maintenance,Ilc<br>Ron Glessner208-661-5648 |  | Section:<br>Township:<br>Range:<br>Legal:       |  |



| FIBER | CONSTRUCTION                |
|-------|-----------------------------|
| 270'  | AERIAL 12 STRAND F.O.CABLE  |
| 0'    | Buried 288 STRAND F.O.CABLE |
| 0'    | 1 1/4" HDPE CONDUIT         |
| 1     | 2" SCHEDULE 40 RISER        |
| 2     | NEW ANCHOR                  |
| 2     | AERIAL MARKER               |
| 0     | BURIED MARKER               |
| 0     | PUPI ARM                    |
| 0     | EXTENSION ARM               |
| 0     | NEW HAND HOLE               |

| AVISTA      | # |
|-------------|---|
| DIST. POLES | 2 |
| TXM. POLES  | 0 |
| CONDUITS    | 0 |
| ANCHORS     | 0 |
| MGN'S       | 2 |

(1) AERIAL 12 STRAND SINGLE MODE FIBER OPTIC CABLE ON 1/4" EHS MESSENGER

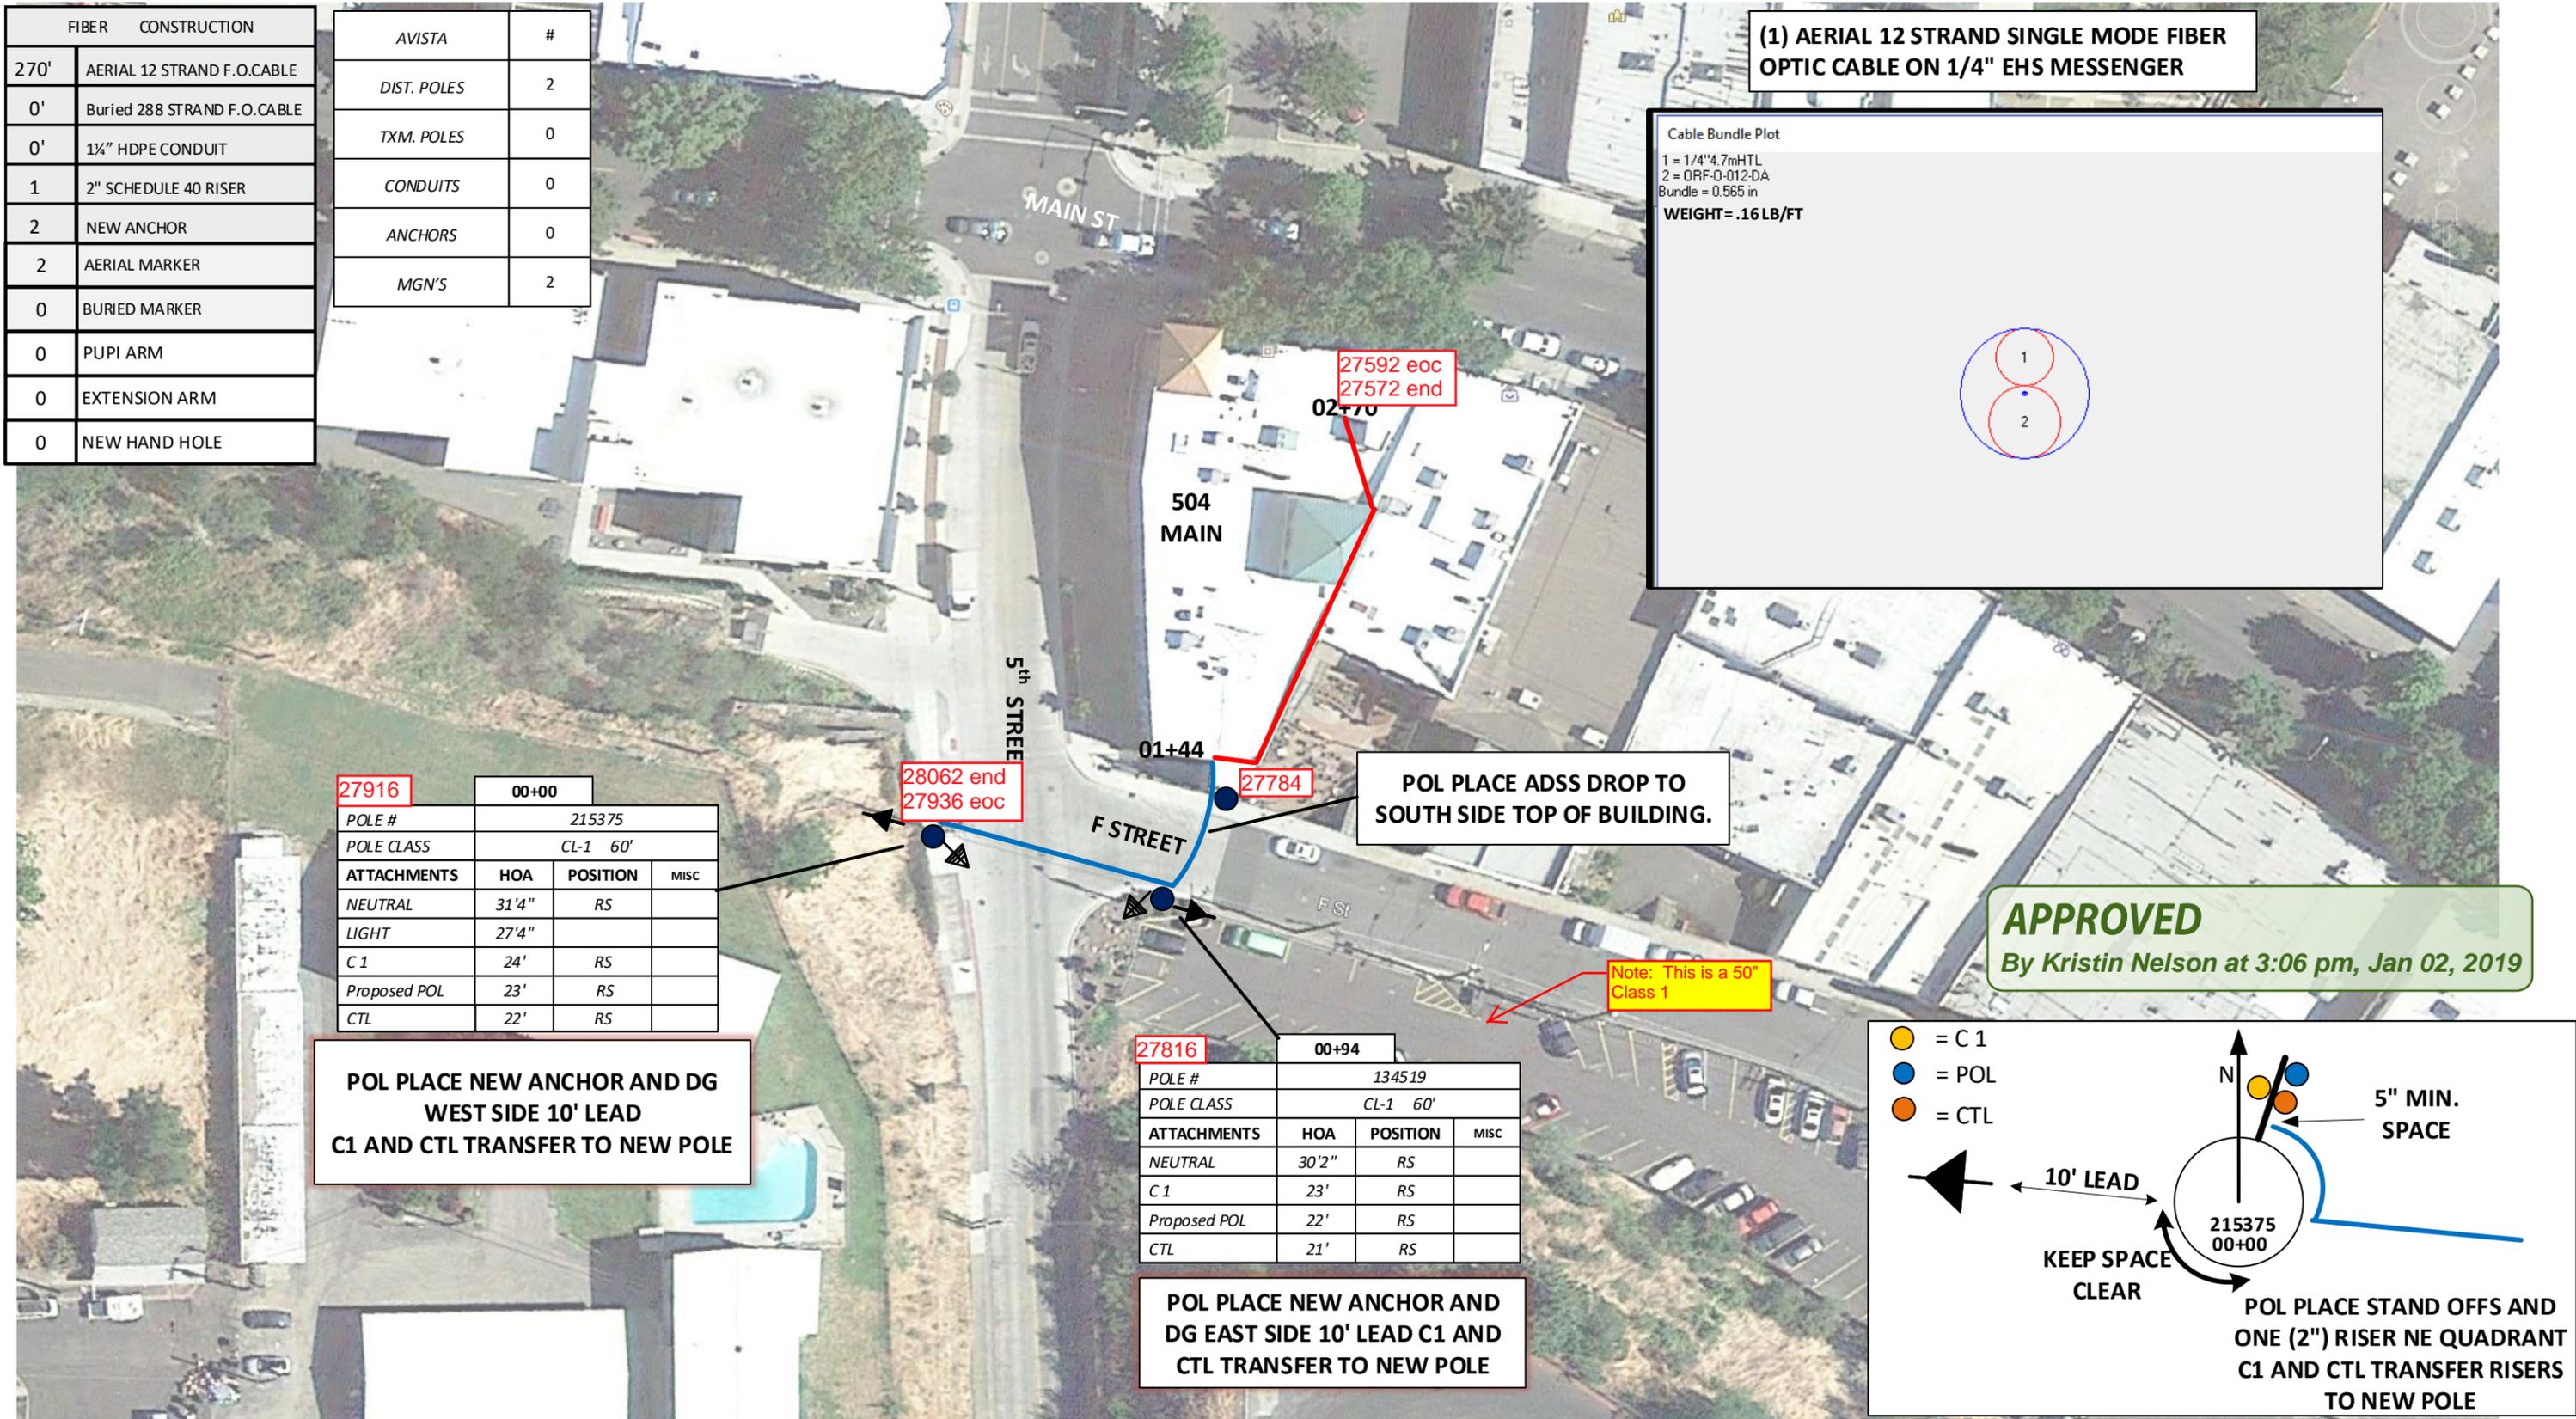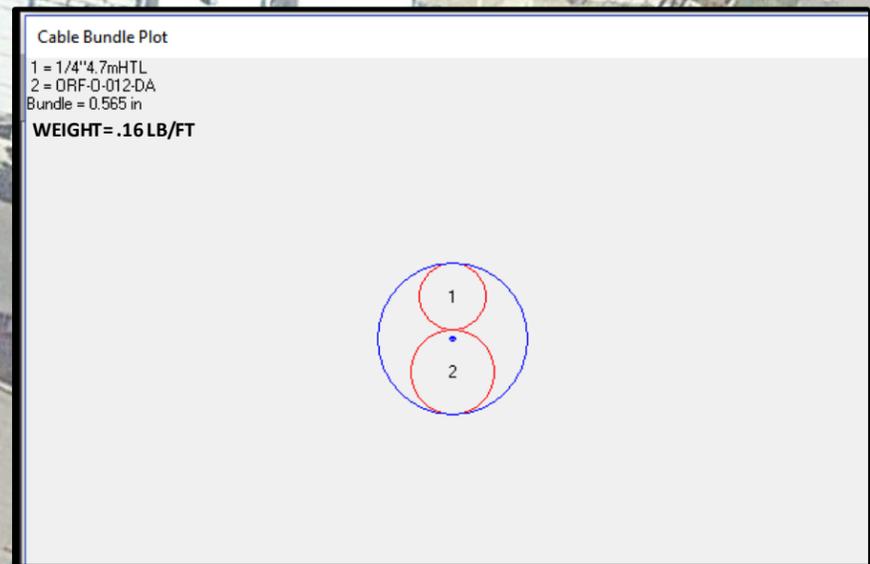


| POLE #       | 215375            |
|--------------|-------------------|
| POLE CLASS   | CL-1 60'          |
| ATTACHMENTS  | HOA POSITION MISC |
| NEUTRAL      | 31'4" RS          |
| LIGHT        | 27'4" RS          |
| C 1          | 24' RS            |
| Proposed POL | 23' RS            |
| CTL          | 22' RS            |

POL PLACE NEW ANCHOR AND DG WEST SIDE 10' LEAD C1 AND CTL TRANSFER TO NEW POLE

| POLE #       | 134519            |
|--------------|-------------------|
| POLE CLASS   | CL-1 60'          |
| ATTACHMENTS  | HOA POSITION MISC |
| NEUTRAL      | 30'2" RS          |
| C 1          | 23' RS            |
| Proposed POL | 22' RS            |
| CTL          | 21' RS            |

POL PLACE NEW ANCHOR AND DG EAST SIDE 10' LEAD C1 AND CTL TRANSFER TO NEW POLE

**APPROVED**  
By Kristin Nelson at 3:06 pm, Jan 02, 2019

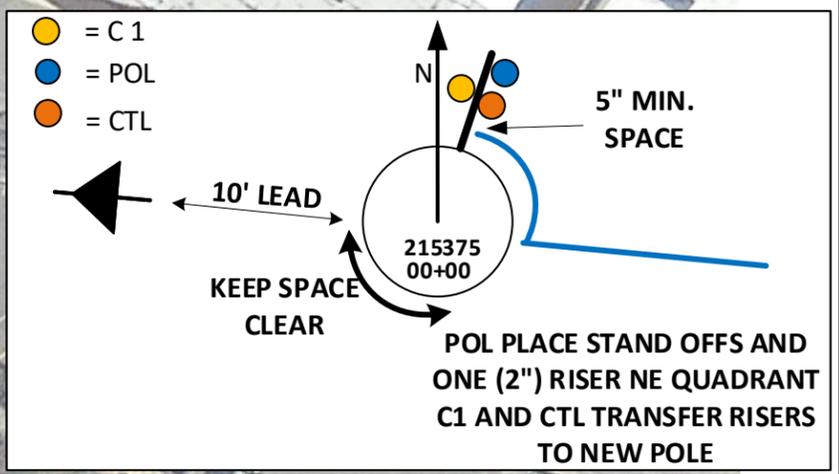

|                                |         |                                 |     |
|--------------------------------|---------|---------------------------------|-----|
| Drawing Name: Port of Lewiston |         | Drawn By: Ron Glessner 12-04-18 |     |
| <b>504 MAIN STREET</b>         |         |                                 |     |
| SIZE                           | FSCM NO | DWG NO                          | REV |
| SCALE                          |         | SHEET 3                         |     |


| REV. | DESCRIPTION | DATE | BY |
|------|-------------|------|----|
|      |             |      |    |
|      |             |      |    |
|  |  |
|--|--|
| Contact Information  | State: ID<br>County: Nez Perce<br>City: Lewiston |
| Port of Lewiston<br>Dave Doeringsfeld<br>208-743-5531<br>Outside Plant Maintenance, llc<br>Ron Glessner 208-661-5648 | Section:<br>Township:<br>Range:<br>Legal:        |





USE EXISTING EMPTY CONDUIT OR ATTACH NEW SCH.40 CONDUIT TO TOP OF BUILDING WALL

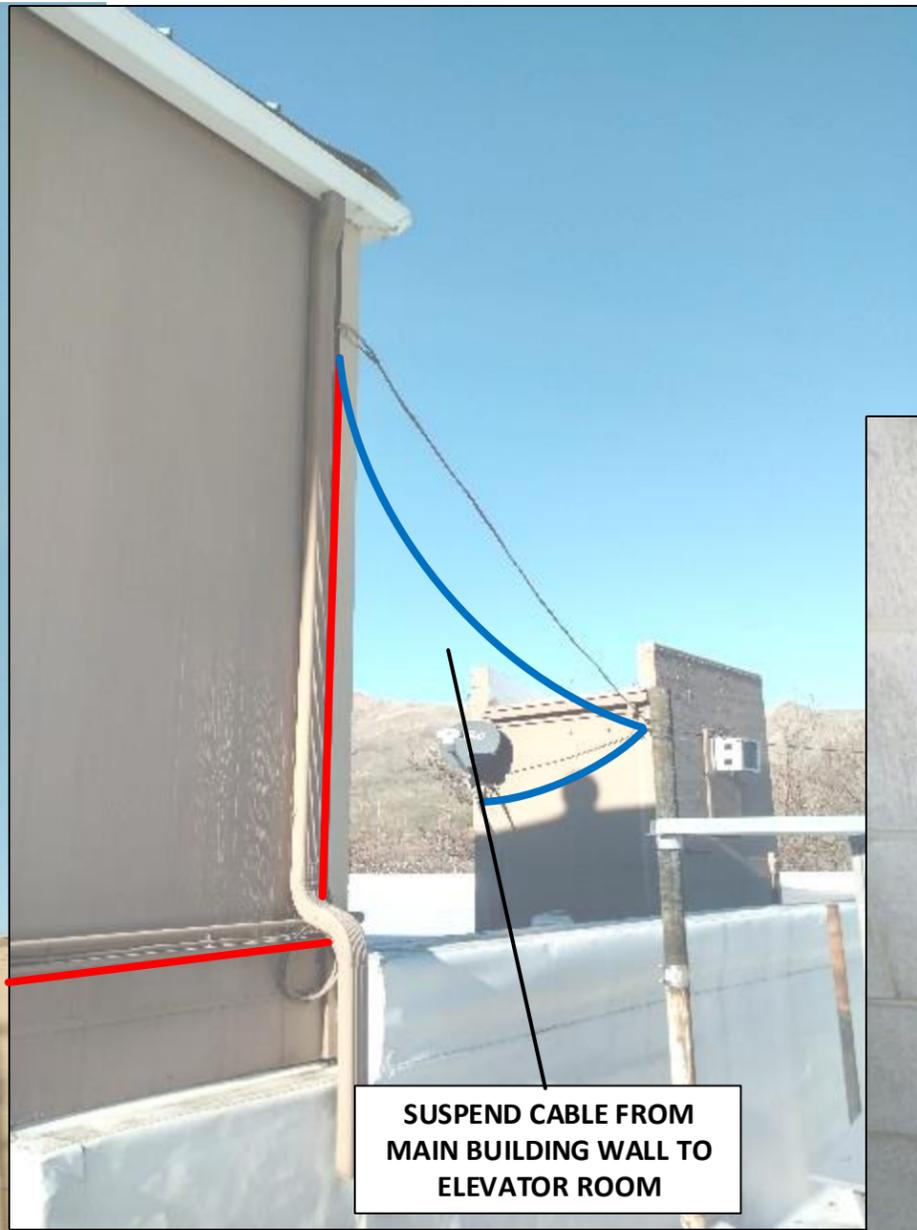

SUSPEND CABLE FROM MAIN BUILDING WALL TO ELEVATOR ROOM



USE EXISTING PULL STRING IN TOP OF ELEVATOR ROOM TO PULL CABLE TO STREET LEVEL FLOOR SERVER ROOM

FOR BUILDING ACCESS CONTACT:  
DENNIS 208-816-0377  
BEN 208-790-1320

**APPROVED**  
By Kristin Nelson at 3:06 pm, Jan 02, 2019

|                                |         |                                 |  |     |  |
|--------------------------------|---------|---------------------------------|--|-----|--|
| Drawing Name: Port of Lewiston |         | Drawn By: Ron Glessner 12-04-18 |  |     |  |
|                                |         | <b>504 MAIN STREET</b>          |  |     |  |
| SIZE                           | FSCM NO | DWG NO                          |  | REV |  |
| SCALE                          |         | SHEET 4                         |  |     |  |

| REV. | DESCRIPTION | DATE | BY |
|------|-------------|------|----|
| REV. | DESCRIPTION | DATE | BY |
| REV. | DESCRIPTION | DATE | BY |
| REV. | DESCRIPTION | DATE | BY |
| REV. | DESCRIPTION | DATE | BY |

Contact Information  
  
Port of Lewiston  
Dave Doeringsfeld  
208-743-5531  
Outside Plant Maintenance, llc  
Ron Glessner 208-661-5648

State: ID  
County: Nez Perce  
City: Lewiston  
  
Section:  
Township:  
Range:  
Legal:

