

Drawing Name: Port of Lewiston

Drawn By: Ron Glessner 09-14-18

1828 21st STREET




SIZE	FSCM NO	DWG NO	REV
SCALE		SHEET 1	

REV.	DESCRIPTION	DATE	BY
	REVISED	07-23-18	RG

Contact Information
 Port of Lewiston
 Dave Doeringsfeld
 208-743-5531
 Outside Plant Maintenance, LLC
 Ron Glessner 208-661-5648

State: ID
 County: Nez Perce
 City: Lewiston
 Section:
 Township:
 Range:
 Legal:



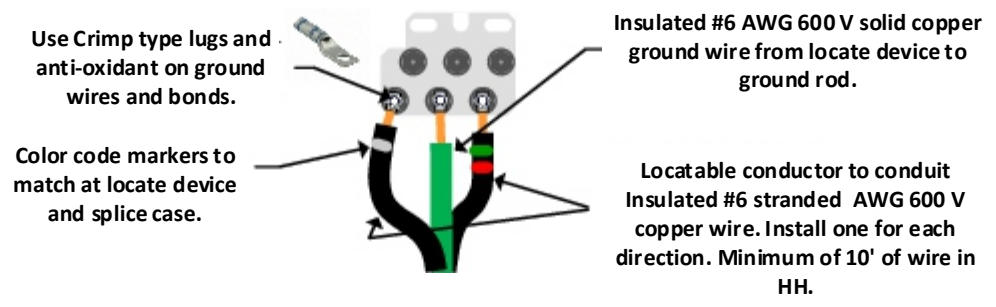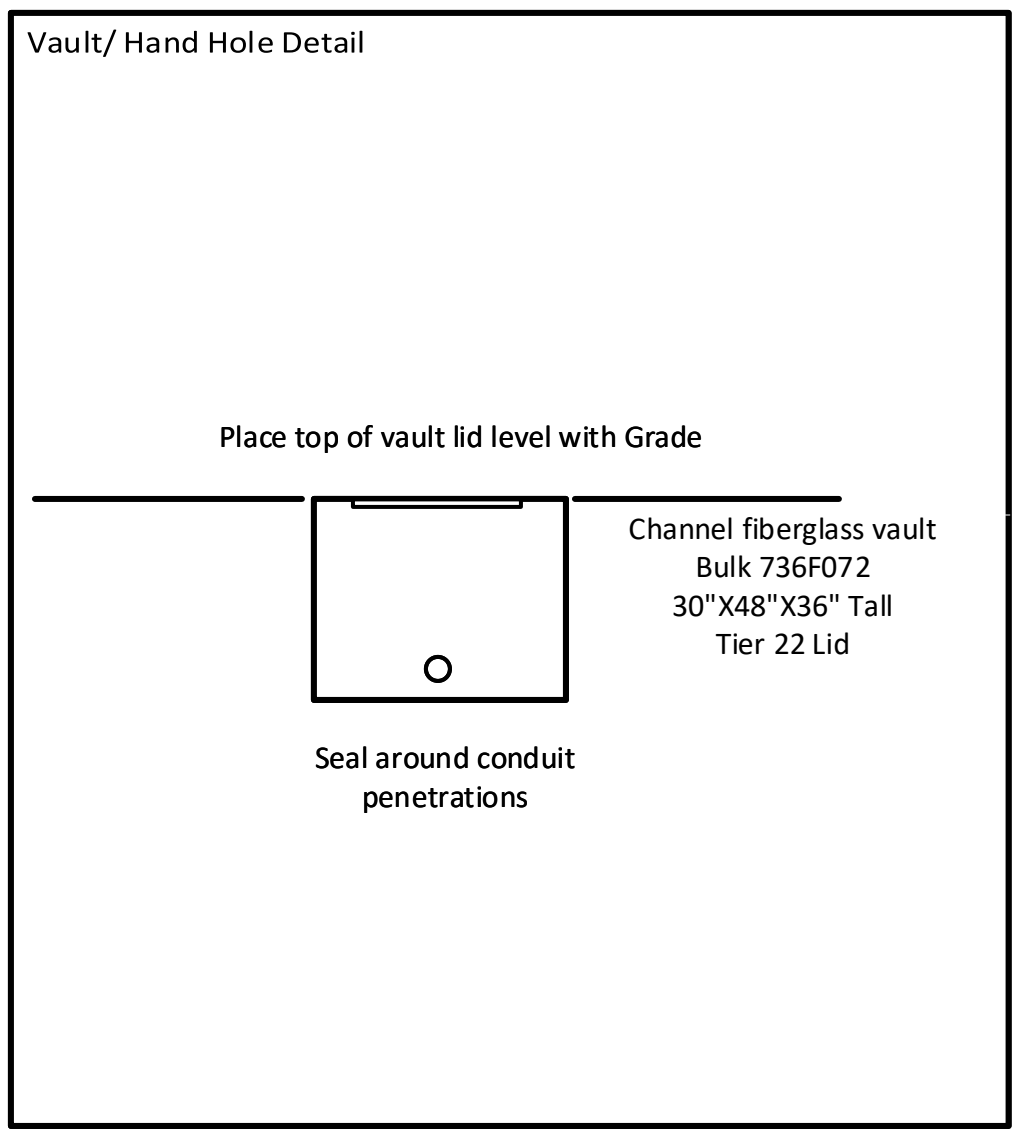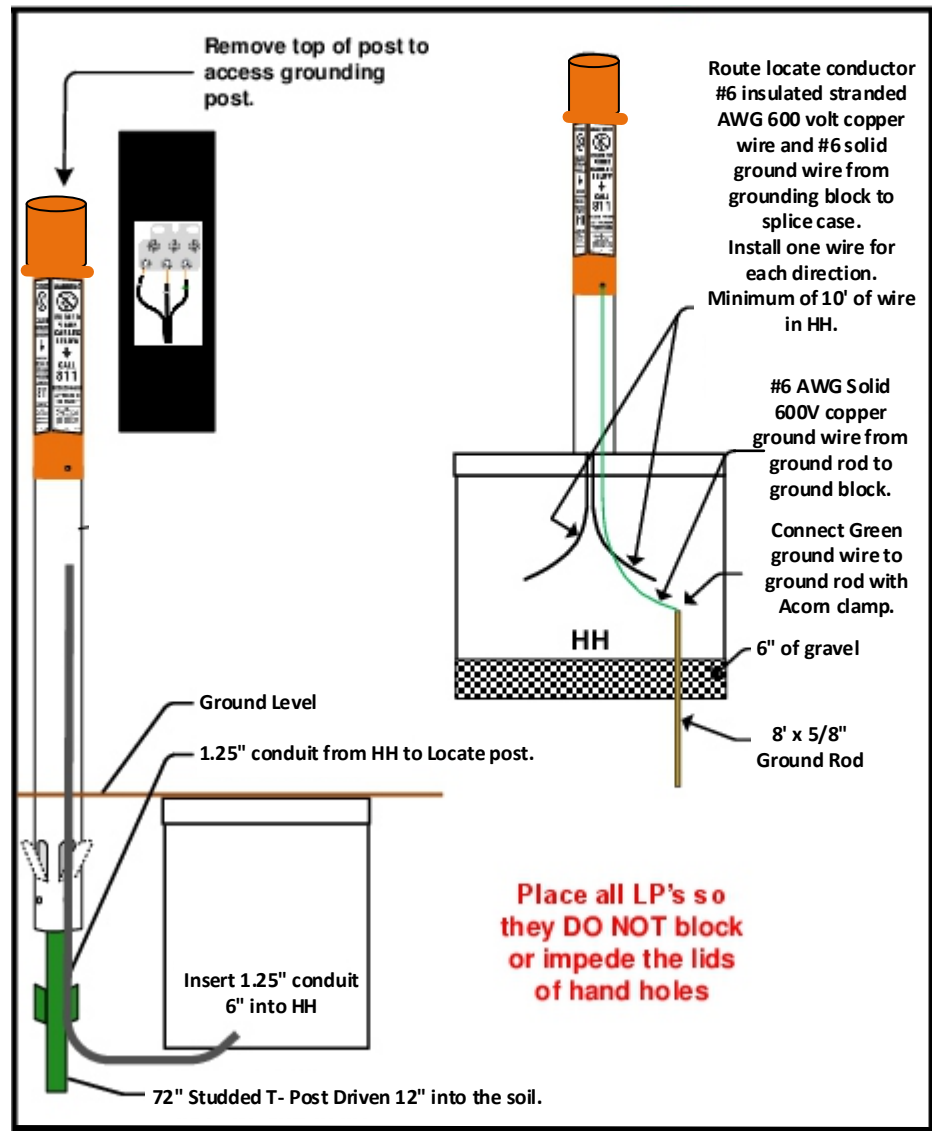

Drawn By: Ron Glessner 09-14-18			
1828 21st STREET			
SIZE	FSCM NO	DWG NO	REV
SCALE	SHEET 2		

REV.	DESCRIPTION	DATE	BY

Contact Information Outside Plant Maintenance, llc Ron Glessner 208-661-5648	State: ID County: NEZ PERCE City: LEWISTON
	Section: Township: Range: Legal:



FIBER	CONSTRUCTION
0'	AERIAL 12 STRAND F.O.CABLE
571'	Buried 12 STRAND F.O.CABLE
127'	1½" HDPE CONDUIT
0'	3" SCHEDULE 40 RISER
0	NEW ANCHOR
0	AERIAL MARKER
1	BURIED MARKER
0	PUPI ARM
0	EXTENSION ARM
1	NEW HAND HOLE

INTERCEPT EXISTING EMPTY POL CONDUIT UNDER SIDEWALK. PLACE NEW HH BETWEEN TACO TIME AND JIFFY LUBE DRIVEWAYS AND RESTORE CONCRETE.

PULL ONE 12CT. FIBER OPTIC CABLE FROM EXISTING HH THROUGH EXISTING CONDUIT TO NEW HH LEAVE 50' SLACK IN EACH HH

23862 N
23812 W

23460 eoc
23410 end

1828
24010 eoc
24084 end

PLACE ONE 1½" HDPE CONDUIT USING DIRECTIONAL DRILL PULL ONE 12CT F/O CABLE INTO TACO TIME BUILDING



Drawing Name: Port of Lewiston			
Drawn By: Ron Glessner 09-14-18			
1828 21st STREET			
SIZE	FSCM NO	DWG NO	REV
SCALE		SHEET 3	

REV.	DESCRIPTION	DATE	BY
REV.	DESCRIPTION	DATE	BY
Contact Information	
Port of Lewiston Dave Doeringsfeld 208-743-5531 Outside Plant Maintenance, llc Ron Glessner 208-661-5648	


State: ID	County: Nez Perce	City: Lewiston
Section:	Township:	Range:
Legal:		

--	--





PLACE ONE 1¼" HDPE CONDUIT TO NORTH WEST CORNER OF BUILDING. ATTACH 1½" SCHEDULE 40 PVC CONDUIT AND PULL BOX ON BUILDING. ENTER BUILDING THROUGH ROOF SOFFIT.

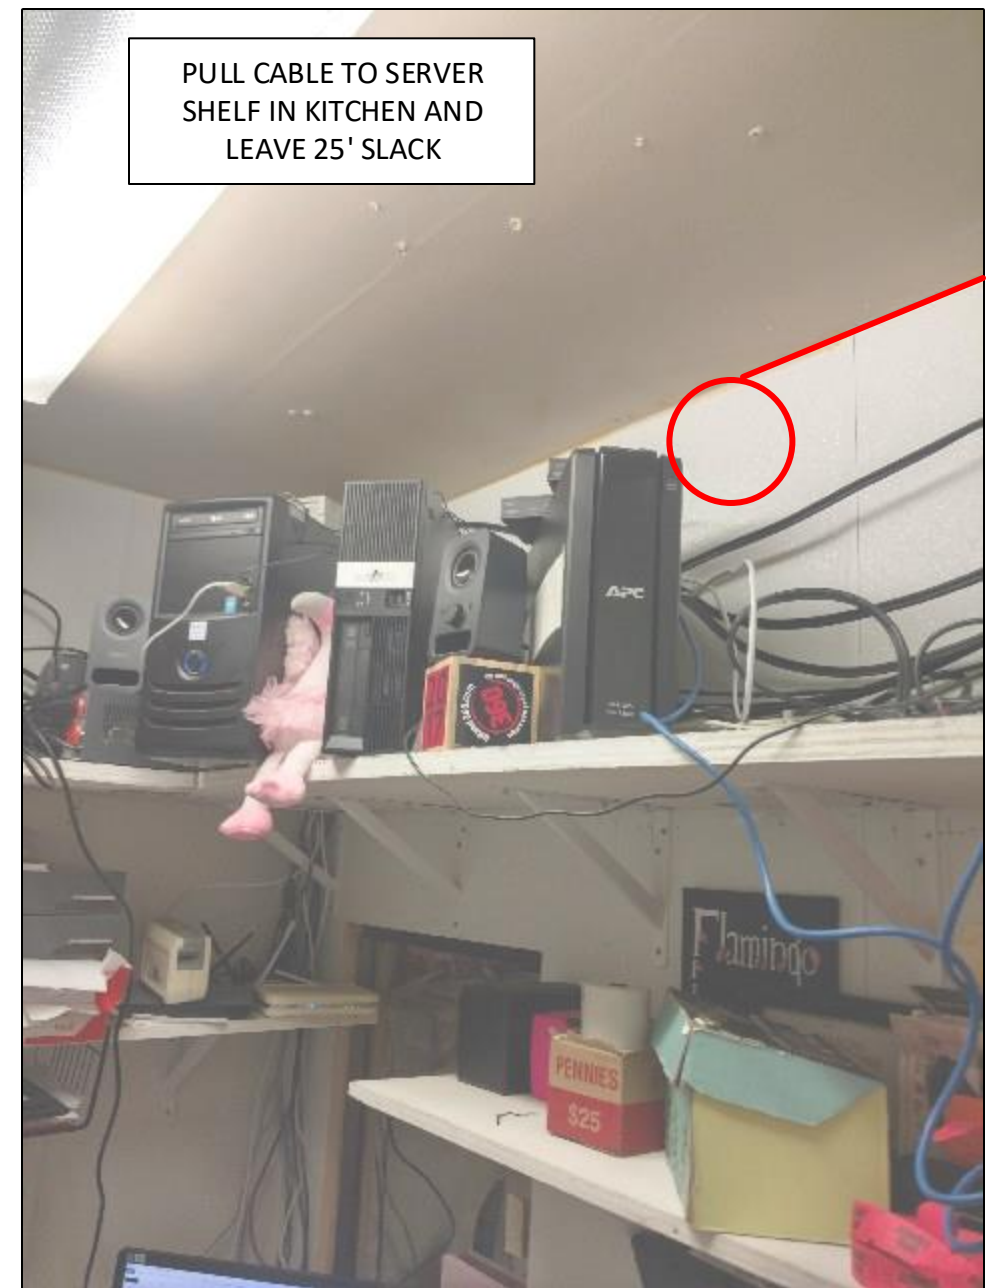

PULL CABLE TO SERVER SHELF IN KITCHEN AND LEAVE 25' SLACK

Drawing Name: Port of Lewiston	Drawn By: Ron Glessner 09-14-18			
	1828 21ST STREET			
	SIZE	FSCM NO	DWG NO	REV
	SCALE		SHEET 4	

REV.	DESCRIPTION	DATE	BY

Contact Information Port of Lewiston Dave Doeringsfeld 208-743-5531 Outside Plant Maintenance, llc Ron Glessner 208-661-5648	State: ID County: Nez Perce City: Lewiston Section: Township: Range: Legal:
---	---

