

PROJECT LOCATION 18TH STREET N. AND 5TH AVE. N LEWISTON ID.

Drawing Name: Port of Lewiston

DRAWN BY: Ron Glessner 01-30-18

1903 5th AVE N.

SIZE	FSCMNO	REV
SCALE	SHEET	Cover

REV.			
REV.	DESCRIPTION	DATE	BY
REV.	DESCRIPTION	DATE	BY

Contact Information

Port of Lewiston
 Dave Doeringsfeld
 208-743-5531
 Outside Plant Maintenance, llc
 Ron Glessner 208-661-5648

State: ID
 County: Nez Perce
 City: Lewiston

Section:
 Township:
 Range:
 Legal:



GENERAL CONSTRUCTION NOTES

CONTRACTOR IS RESPONSIBLE FOR ALL PERMITS EXCEPT STATE HWY., COUNTY ROAD,RAILROAD OR WATER CROSSINGS.

RESTORATION OF ALL RIGHT OF WAY GROUND WILL BE RESTORED TO ORIGINAL CONDITION OR BETTER.

CONTRACTOR WILL COORDINATE WITH OSP MANAGER 24 HRS. PRIOR TO BEGINNING CONSTRUCTION.

OSP MANAGER WILL CONTACT BUILDING OWNER/TENANT 24 HRS. PRIOR TO BEGINNING CONSTRUCTION TO COORDINATE ACCESS TO BUILDINGS.

CONTRACTOR IS RESPONSIBLE FOR CALLING LOCATES AND IS RESPONSIBLE FOR REPAIR AND RESTORATION OF DAMAGED UTILITIES.


FOLLOW ALL NESC CONSTRUCTION GUIDELINES.

BURIED CONDUIT MUST CROSS UNDERNEATH ALL CITY UTILITIES



CONTRACTOR WILL HAVE ON SITE THE APPROVED DRAWINGS FROM THE UTILITY AND OR STATE,COUNTY,CITY,RAILROAD.

CONTRACTOR WILL PROVIDE CONDUIT AND HAND HOLES


Riser Detail

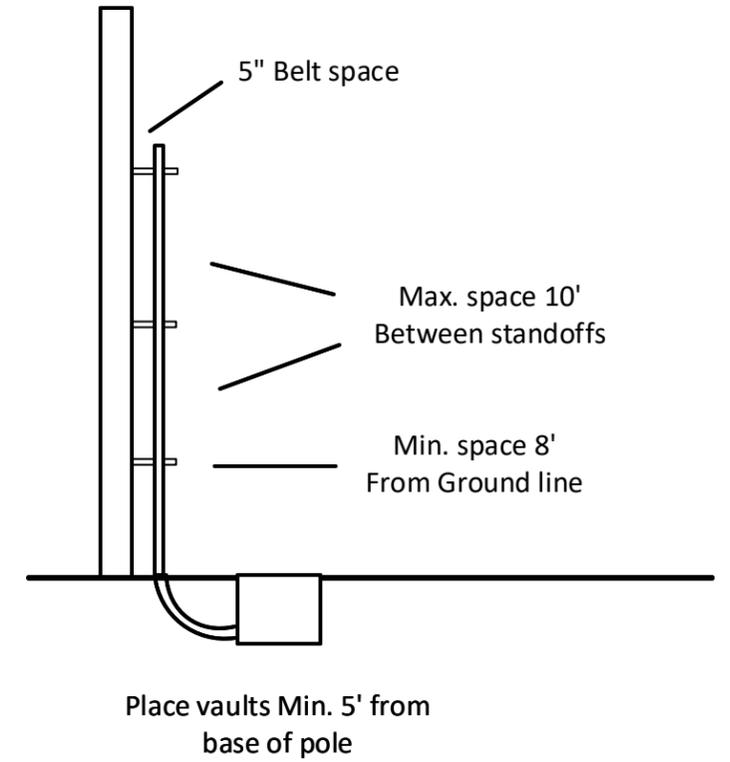

Road crossing Detail

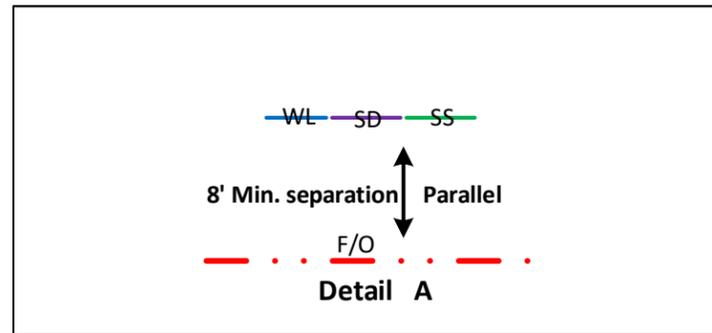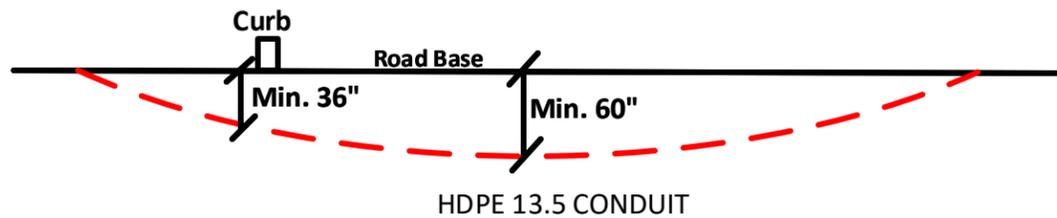

Vault/ Hand Hole Detail

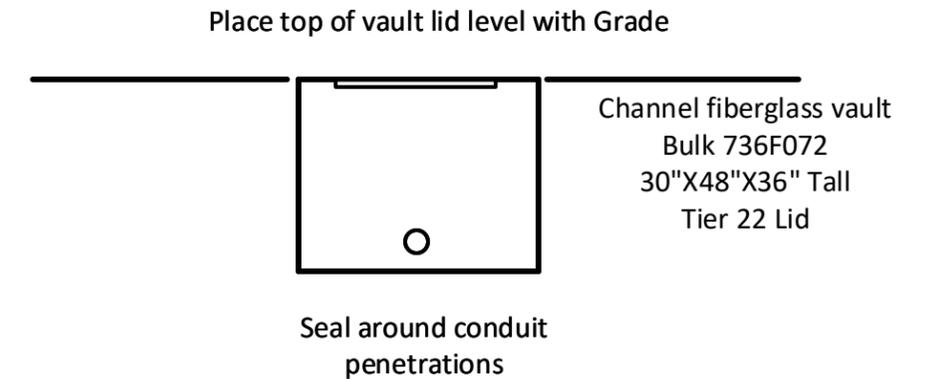


Drawing Name:Port of Lewiston		Drawn By:Ron Glessner 01-30-18	
1903 5TH AVE N.			
SIZE	FSCM NO	DWG NO	REV
SCALE	No scale	SHEET 2	

REV.	DESCRIPTION	DATE	BY

Contact Information
 Port of Lewiston
 Dave Doeringsfeld
 208-753-5531
 Outside Plant Maintenance, llc
 Ron Glessner208-661-5648

State:ID
 County:Nez Perce
 City:Lewiston
 Section:
 Township:
 Range:
 Legal:



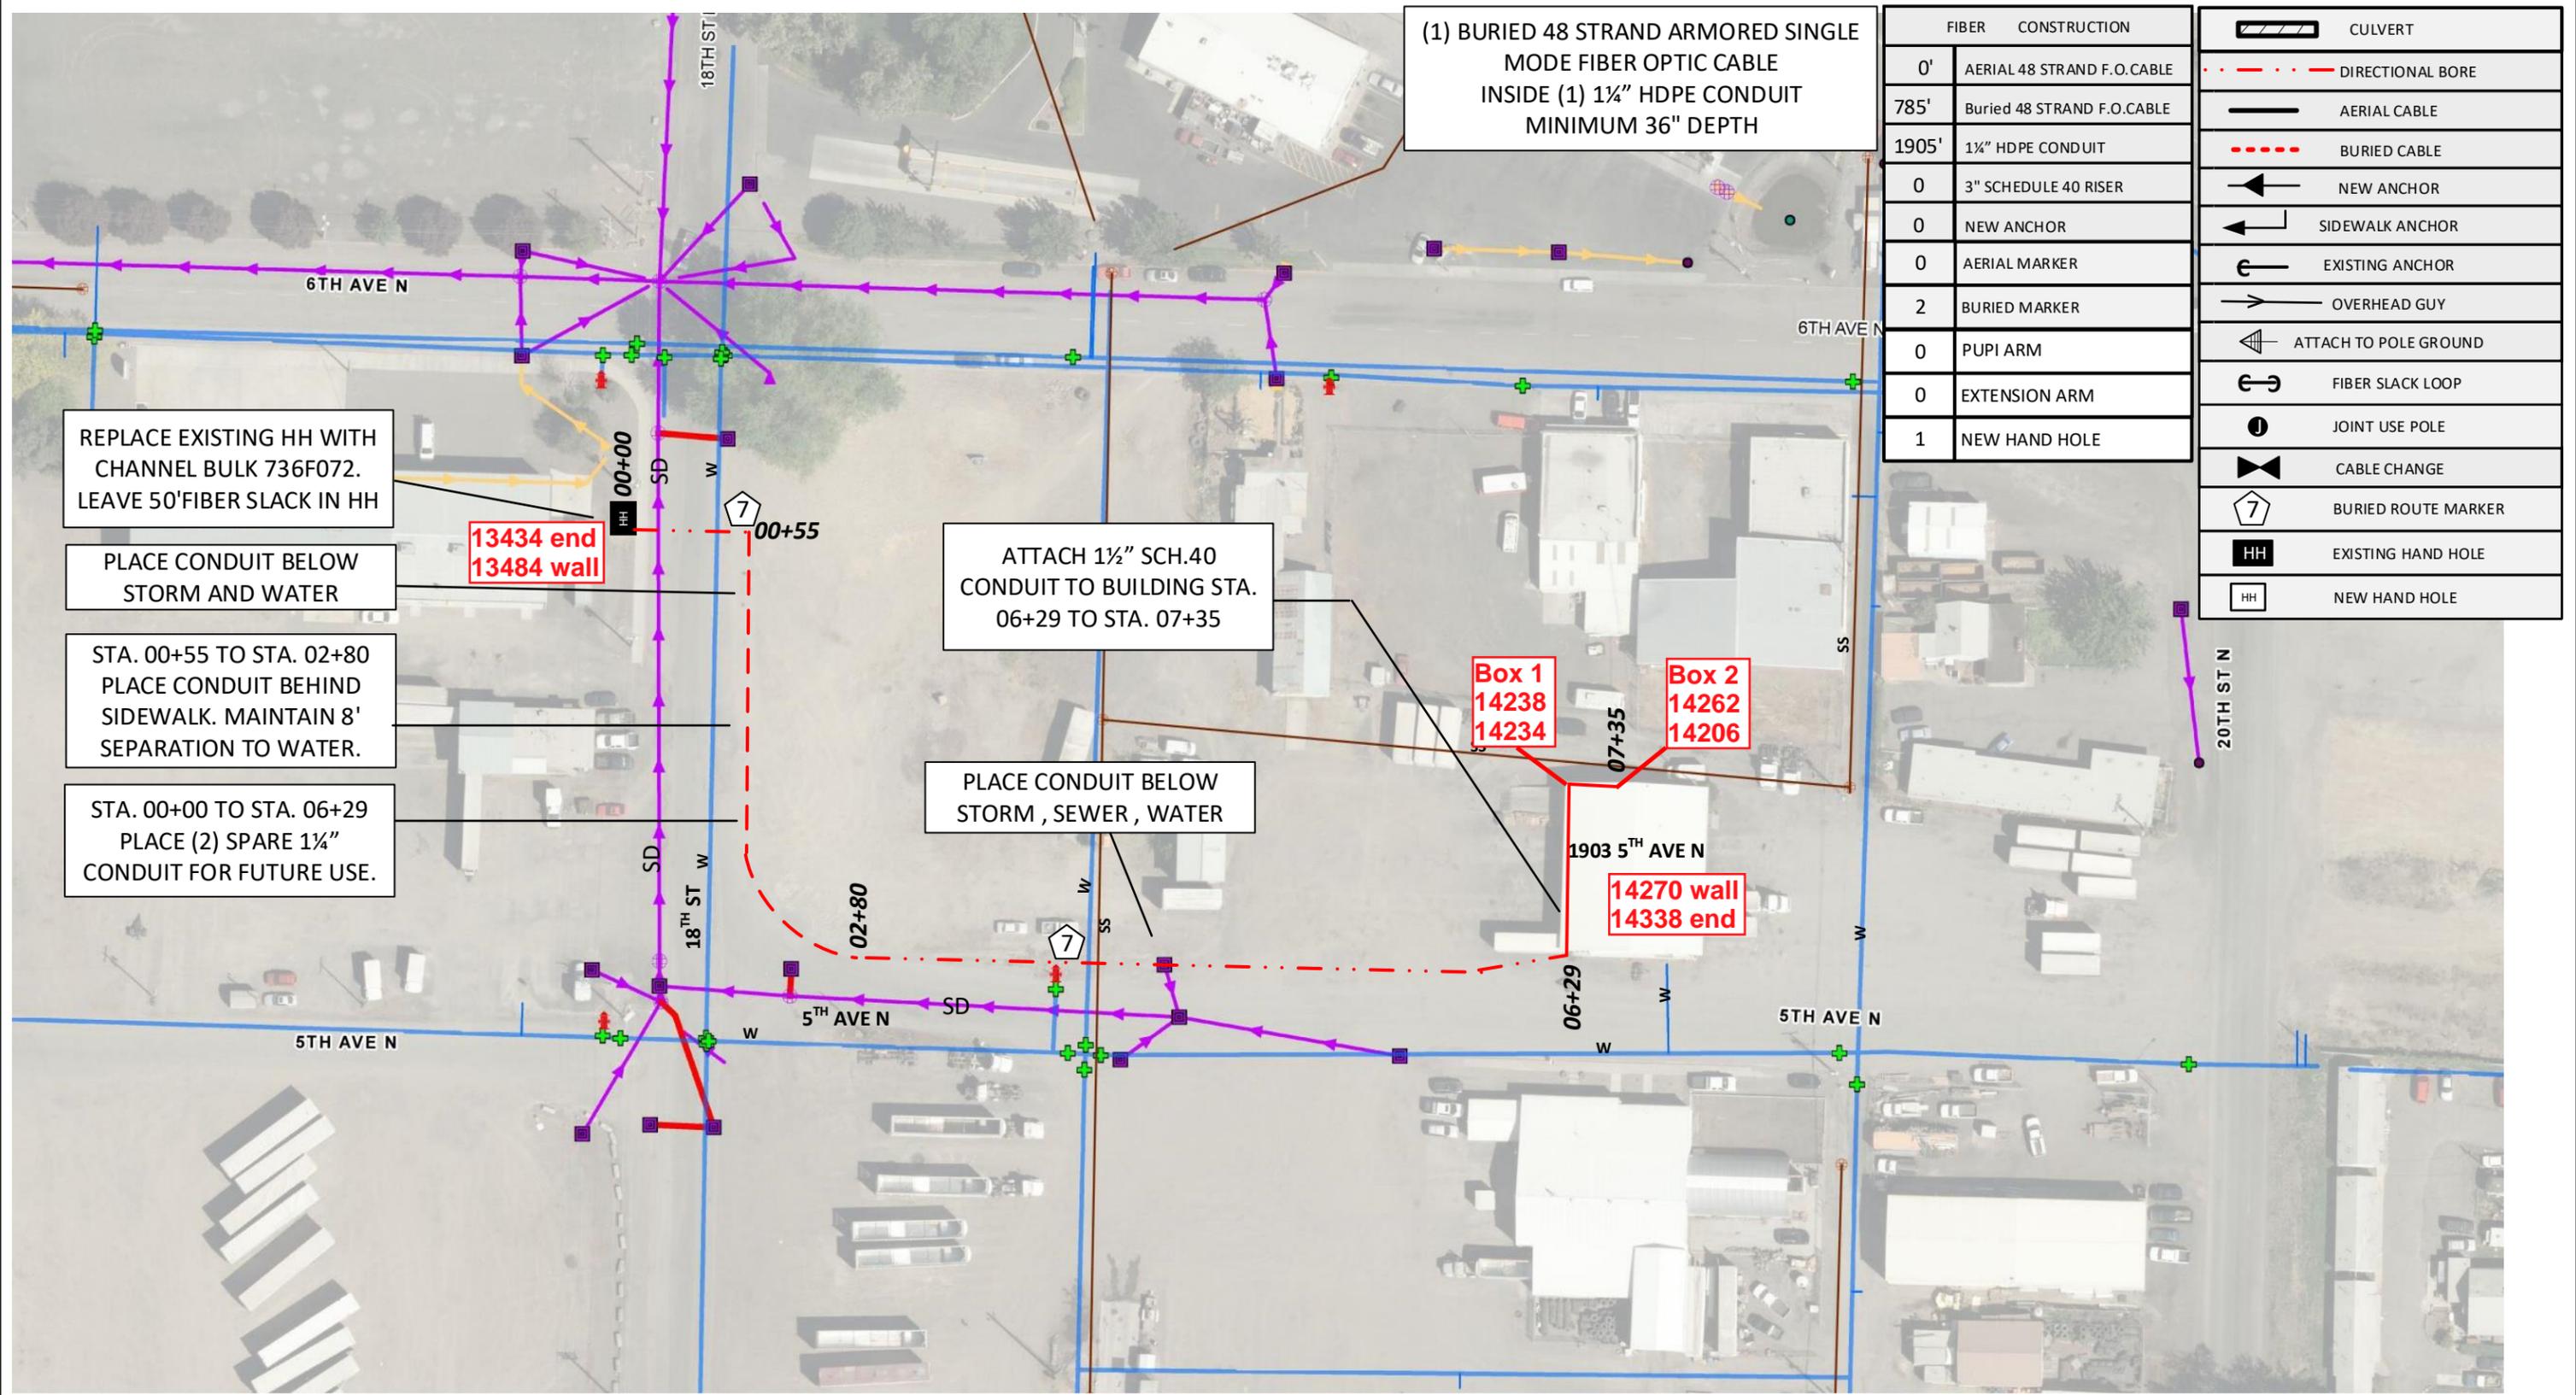

(1) BURIED 48 STRAND ARMORED SINGLE MODE FIBER OPTIC CABLE
INSIDE (1) 1 1/4" HDPE CONDUIT
MINIMUM 36" DEPTH

FIBER	CONSTRUCTION
0'	AERIAL 48 STRAND F.O.CABLE
785'	Buried 48 STRAND F.O.CABLE
1905'	1 1/4" HDPE CONDUIT
0	3" SCHEDULE 40 RISER
0	NEW ANCHOR
0	AERIAL MARKER
2	BURIED MARKER
0	PUPI ARM
0	EXTENSION ARM
1	NEW HAND HOLE

	CULVERT
	DIRECTIONAL BORE
	AERIAL CABLE
	BURIED CABLE
	NEW ANCHOR
	SIDEWALK ANCHOR
	EXISTING ANCHOR
	OVERHEAD GUY
	ATTACH TO POLE GROUND
	FIBER SLACK LOOP
	JOINT USE POLE
	CABLE CHANGE
	BURIED ROUTE MARKER
	EXISTING HAND HOLE
	NEW HAND HOLE

REPLACE EXISTING HH WITH CHANNEL BULK 736F072. LEAVE 50' FIBER SLACK IN HH

PLACE CONDUIT BELOW STORM AND WATER

STA. 00+55 TO STA. 02+80
PLACE CONDUIT BEHIND SIDEWALK. MAINTAIN 8' SEPARATION TO WATER.

STA. 00+00 TO STA. 06+29
PLACE (2) SPARE 1 1/4" CONDUIT FOR FUTURE USE.

ATTACH 1 1/2" SCH.40 CONDUIT TO BUILDING STA. 06+29 TO STA. 07+35

PLACE CONDUIT BELOW STORM, SEWER, WATER

Box 1
14238
14234

Box 2
14262
14206

1903 5TH AVE N
14270 wall
14338 end

Drawing Name: Port of Lewiston			
Drawn By: Ron Glessner 01-30-18			
1903 5th Ave N			
SIZE	FSCMNO	DWG NO	REV
SCALE			SHEET 3

REV.	REVISION	DATE	BY
	REVISED	02-26-18	RG
	DESCRIPTION	DATE	BY

Contact Information	
Port of Lewiston Dave Doeringsfeld 208-743-5531 Outside Plant Maintenance, llc Ron Glessner 208-661-5648	

State: ID	County: Nez Perce	City: Lewiston
Section:	Township:	Range:
Legal:		

State: ID		County: Nez Perce	City: Lewiston
Section:	Township:	Range:	Legal:





ATTACH 1½" SCHEDULE 40 CONDUIT TO NORTH SIDE OF BUILDING. PENETRATE BUILDING BELOW EXISTING PHONE CABLE.

Drawing Name:Port of Lewiston		Drawn By: Ron Glessner 01-30-18		
		1903 5th AVE N.		
SIZE	FSCM NO	DWG NO	REV	
SCALE		SHEET 4		

REV.	Revised	02-26-18	RG
REV.	DESCRIPTION	DATE	BY
REV.	DESCRIPTION	DATE	BY
REV.	DESCRIPTION	DATE	BY
REV.	DESCRIPTION	DATE	BY

Contact Information
 Port of Lewiston
 Dave Doeringsfeld
 208-743-5531
 Outside Plant Maintenance, llc
 Ron Glessner 208-661-5648

State: ID
 County: Nez Perce
 City: Lewiston
 Section:
 Township:
 Range:
 Legal:

