

CONTACTS:

RED LION: HEIDI SWINEHART – 208-791-3801

AVISTA: TODD ELLSWORTH – 509-495-2773

CENTURY LINK: JULIO MENDEZ – 208-798-8390

APPROVED

By Todd Ellsworth at 7:14 am, May 26, 2017

A copy of this document and attachments must be provided to the crew installing the cable and hardware along with accompanying audit noting additional requirements. This paperwork must be in possession of the crew doing the work and made available to any Avista employee on demand. Applicant shall obtain, from public authorities and private owners of real property any and all permits or easements required for lawful exercise of the permission granted by this approved application. Applicant shall defend Avista from all claims and injuries, as to the applicants right to be on Avista facilities.

This route application is approved based on noted conditions. All Make Ready (MR) costs shall be at the requestors expense unless stated otherwise. Any field changes to the design must be noted by your construction foreman on an asbuilt drawing and sent to Avista Joint Use Dept no later than two weeks after construction is complete.

This project is located at the intersection of Idaho street and 19th street in Lewiston Idaho. Beginning at Avista pole # 115398 proceed east 686' to Avista pole # 115403. Transition to ground and proceed south 182' to new HH then west 140' to Red lion building.

Signed copies of the Avista Make Ready cost approval and the joint use make ready signoff sheets must be submitted to Avista Joint Use Department prior to construction. All make ready work needed to ensure attachment of new facilities at the heights called out in this document must be completed prior to construction of new attachments.

Drawing Name:Port of LEWISTON		Drawn By:Ron Glessner 5-2-2017	
RED LION LEWISTON			
SIZE	FSCMNO	DWG NO	REV
SCALE		SHEET 1	

REV.	Add over lash poles	5-10-17	RG
REV.	DESCRIPTION	DATE	BY
REV.	DESCRIPTION	DATE	BY
REV.	DESCRIPTION	DATE	BY
REV.	DESCRIPTION	DATE	BY

Contact Information

 Port of Lewiston
 Dave Doeringsfeld
 208-743-5531
 Outside Plant Maintenance, llc
 Ron Glessner208-661-5648


State:ID
 County: NEZ PERCE
 City: LEWISTON

 Section:
 Township:
 Range:
 Legal:




● = POL

INSTALL STAND OFF S. SIDE.
POL INSTALL (1) 2" RISER TO STAND OFF.
MIN. 6" SPACE TO POLE.

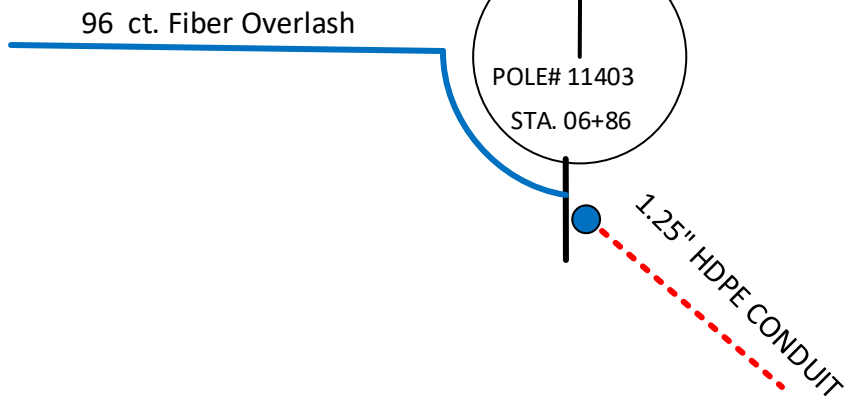


1= 1/4" 6mHTL
2= ORF-O-96-LN
Bundle = 0.827 in.

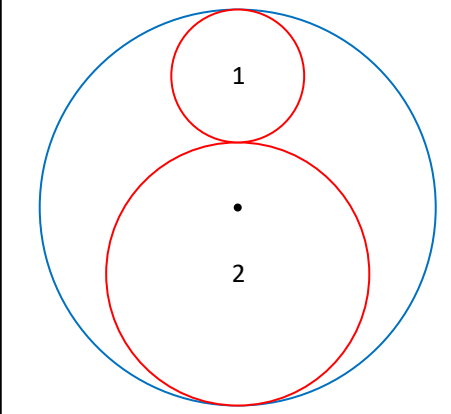

AVISTA	#
DIST. POLES	5
TXM. POLES	0
CONDUITS	0
ANCHORS	0
MGN'S	4

FIBER	CONSTRUCTION
686'	AERIAL 96 STRAND F.O. CABLE
282'	Buried 96 STRAND F.O. CABLE
390'	BURIED 12 STRAND F.O. CABLE
1	1 1/4" HDPE CONDUIT
1	2" SCH 40 RISER
0	NEW ANCHOR
4	AERIAL MARKER
1	BURIED MARKER
0	EXTENSION ARM
1	NEW HAND HOLE

	JOINT USE POLE
	EXISTING ANCHOR
	AERIAL CABLE
	BURIED CABLE
	NEW ANCHOR
	SIDEWALK ANCHOR
	FIBER SLACK LOOP
	OVERHEAD GUY
	ATTACH TO POLE GROUND
	CABLE CHANGE
	LINE ROUTE MARKER
	EXISTING HAND HOLE
	NEW HAND HOLE
	EXISTING CONDUIT

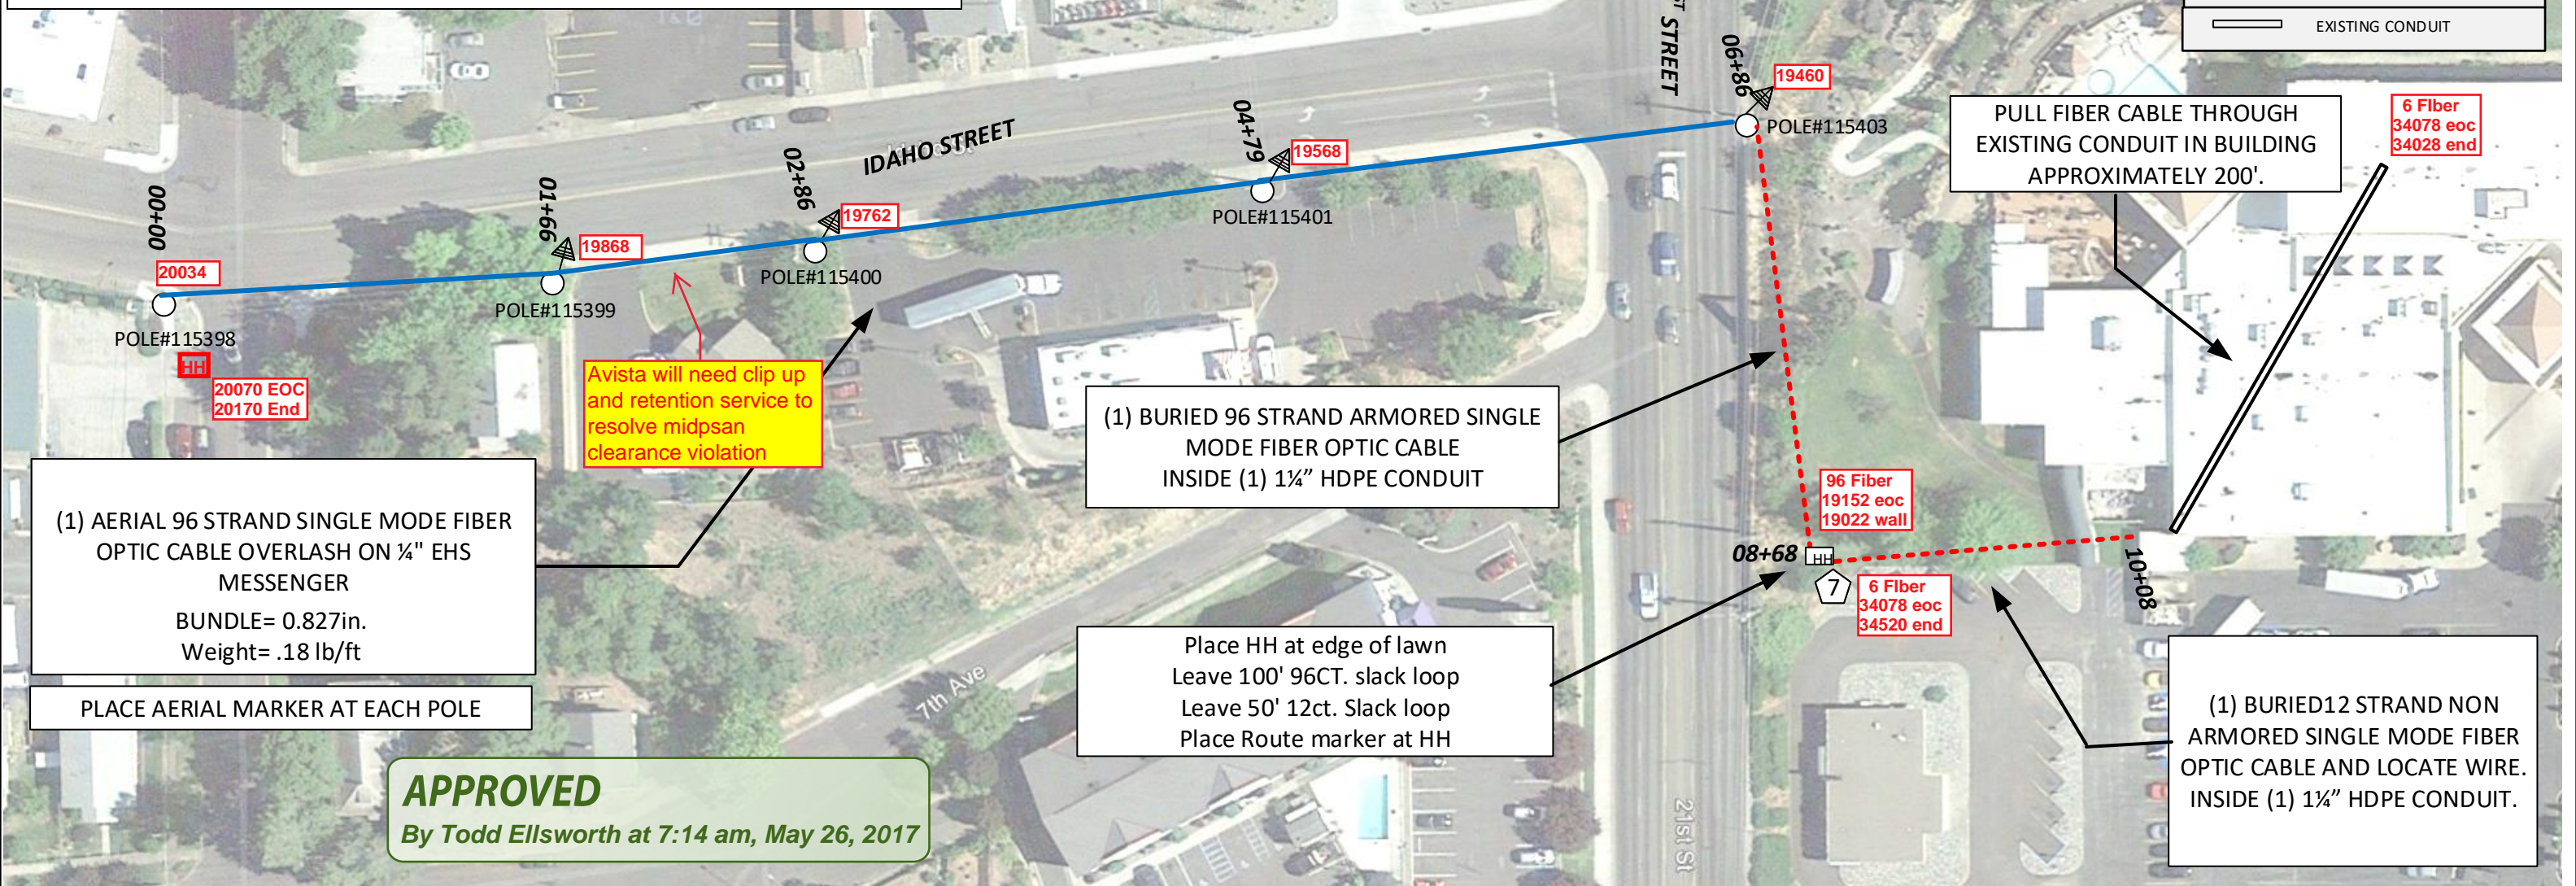

Avista will need clip up and retention service to resolve midspan clearance violation

(1) AERIAL 96 STRAND SINGLE MODE FIBER OPTIC CABLE OVERLASH ON 1/4" EHS MESSENGER
BUNDLE= 0.827in.
Weight= .18 lb/ft

PLACE AERIAL MARKER AT EACH POLE

(1) BURIED 96 STRAND ARMORED SINGLE MODE FIBER OPTIC CABLE INSIDE (1) 1 1/4" HDPE CONDUIT

Place HH at edge of lawn
Leave 100' 96CT. slack loop
Leave 50' 12ct. Slack loop
Place Route marker at HH

PULL FIBER CABLE THROUGH EXISTING CONDUIT IN BUILDING APPROXIMATELY 200'.

6 Fiber
34078 eoc
34028 end

96 Fiber
19152 eoc
19022 wall

6 Fiber
34078 eoc
34520 end

(1) BURIED 12 STRAND NON ARMORED SINGLE MODE FIBER OPTIC CABLE AND LOCATE WIRE. INSIDE (1) 1 1/4" HDPE CONDUIT.

APPROVED
By Todd Ellsworth at 7:14 am, May 26, 2017


Drawing Name: Port of Lewiston		Drawn By: Ron Glessner 5-2-17	
RED LION LEWISTON			
SIZE	FSCMNO	DWG NO	REV
SCALE		SHEET 2	

REV.	DESCRIPTION	DATE	BY
1	Add Idaho st. overlash	5-10-17	RG
2	DESCRIPTION	DATE	BY
3	DESCRIPTION	DATE	BY
4	DESCRIPTION	DATE	BY
5	DESCRIPTION	DATE	BY


Contact Information		State: ID County: Nez Perce City: Lewiston	
Port of Lewiston Dave Doeringsfeld 208-743-5531 Outside Plant Maintenance, llc Ron Glessner 208-661-5648		Section: Township: Range: Legal:	



Joint use_G101153_20170509_145006

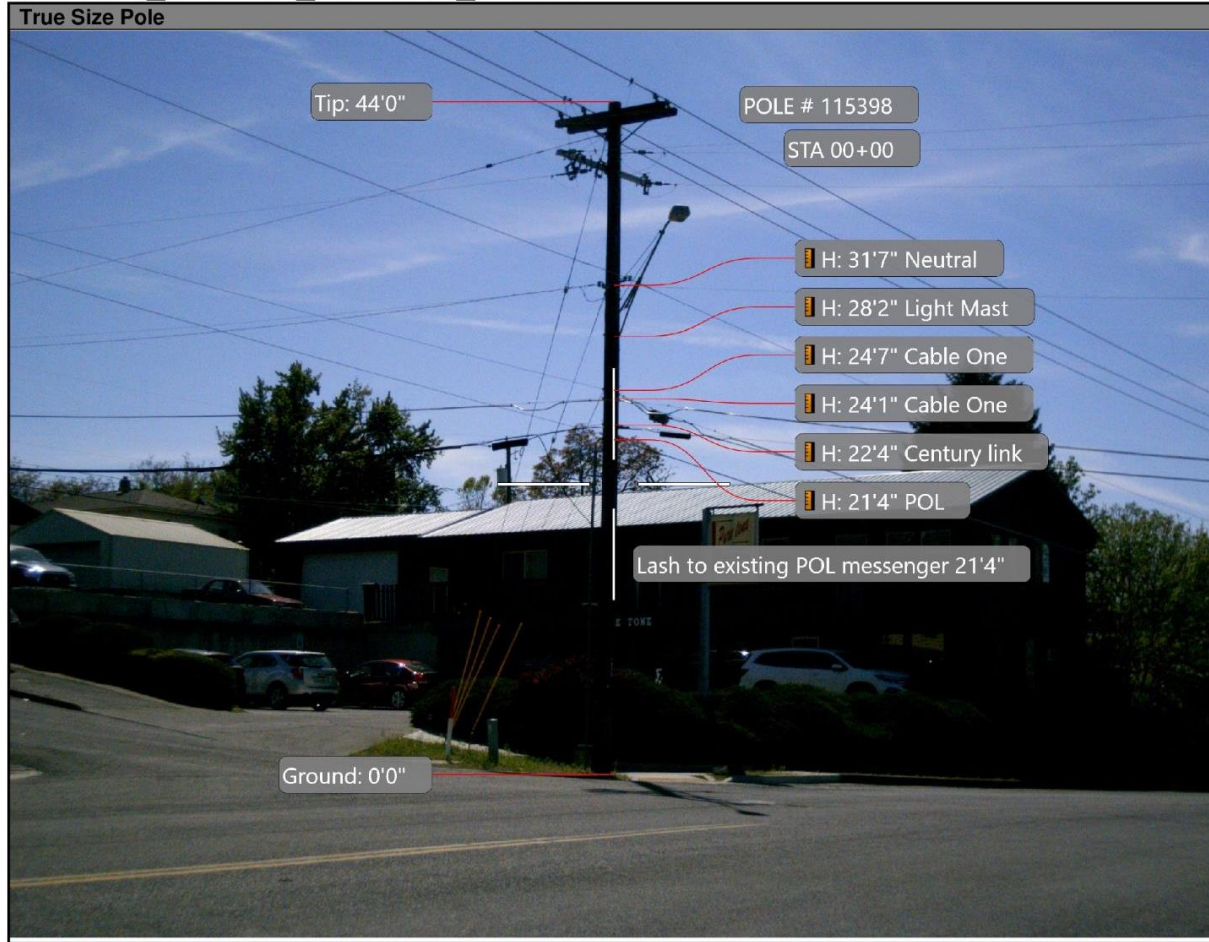

Joint use_G101153_20170509_144446

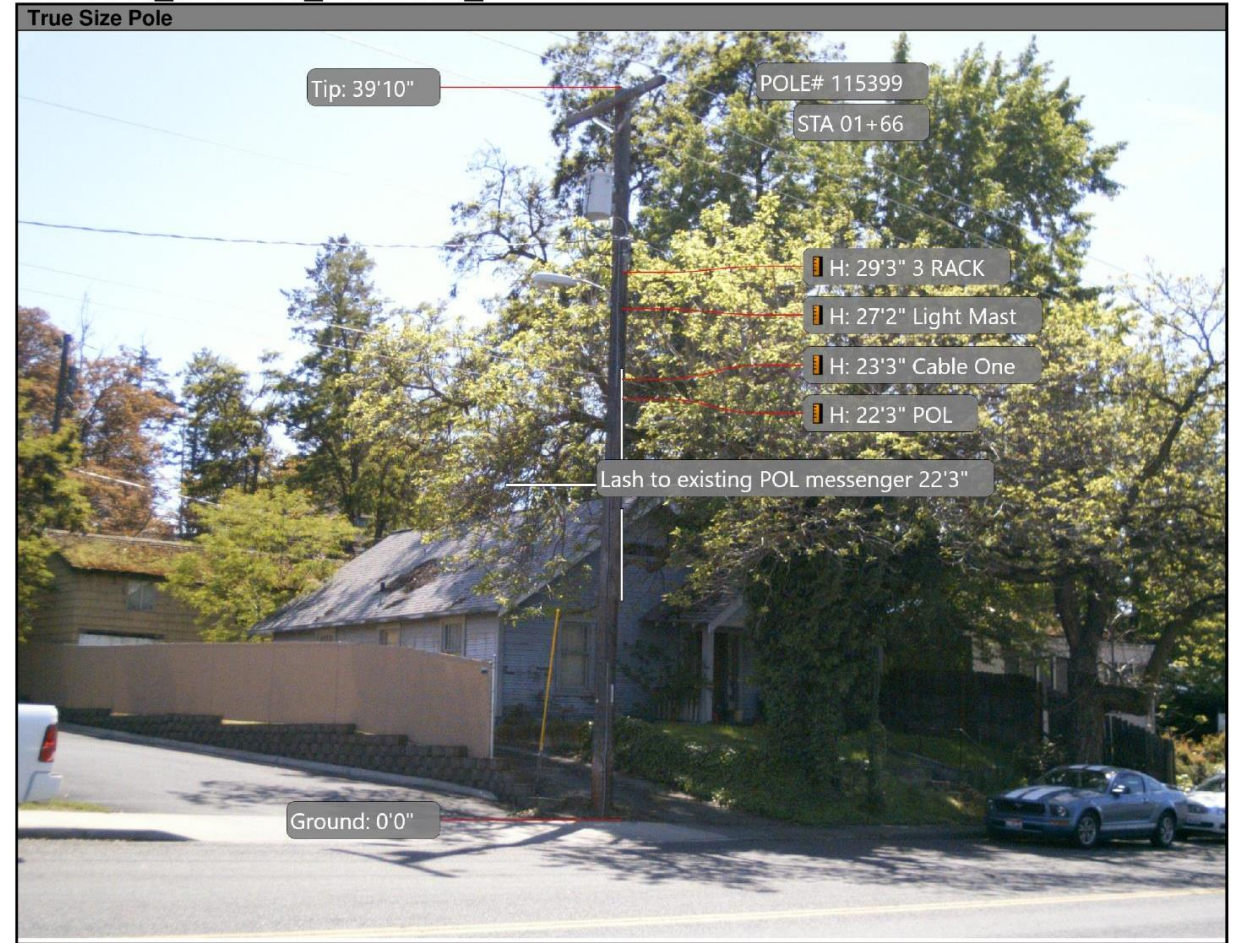


APPROVED
By Todd Ellsworth at 7:14 am, May 26, 2017


Drawing Name: Port of Lewiston	Drawn By: Ron Glessner 5-02-17				REV.	add over lash poles	5-10-17	RG	Contact Information Port of Lewiston Dave Doeringsfeld 208-743-5531 Outside Plant Maintenance, llc Ron Glessner 208-661-5648	State: ID County: Nez Perce City: Lewiston
	RED LION LEWISTON				REV.	DESCRIPTION	DATE	BY		
	SIZE	FSCMNO	DWG NO	REV	REV.	DESCRIPTION	DATE	BY	Section: Township: Range: Legal:	
	SCALE		SHEET 3		REV.	DESCRIPTION	DATE	BY		



Joint use_G101153_20170509_144131

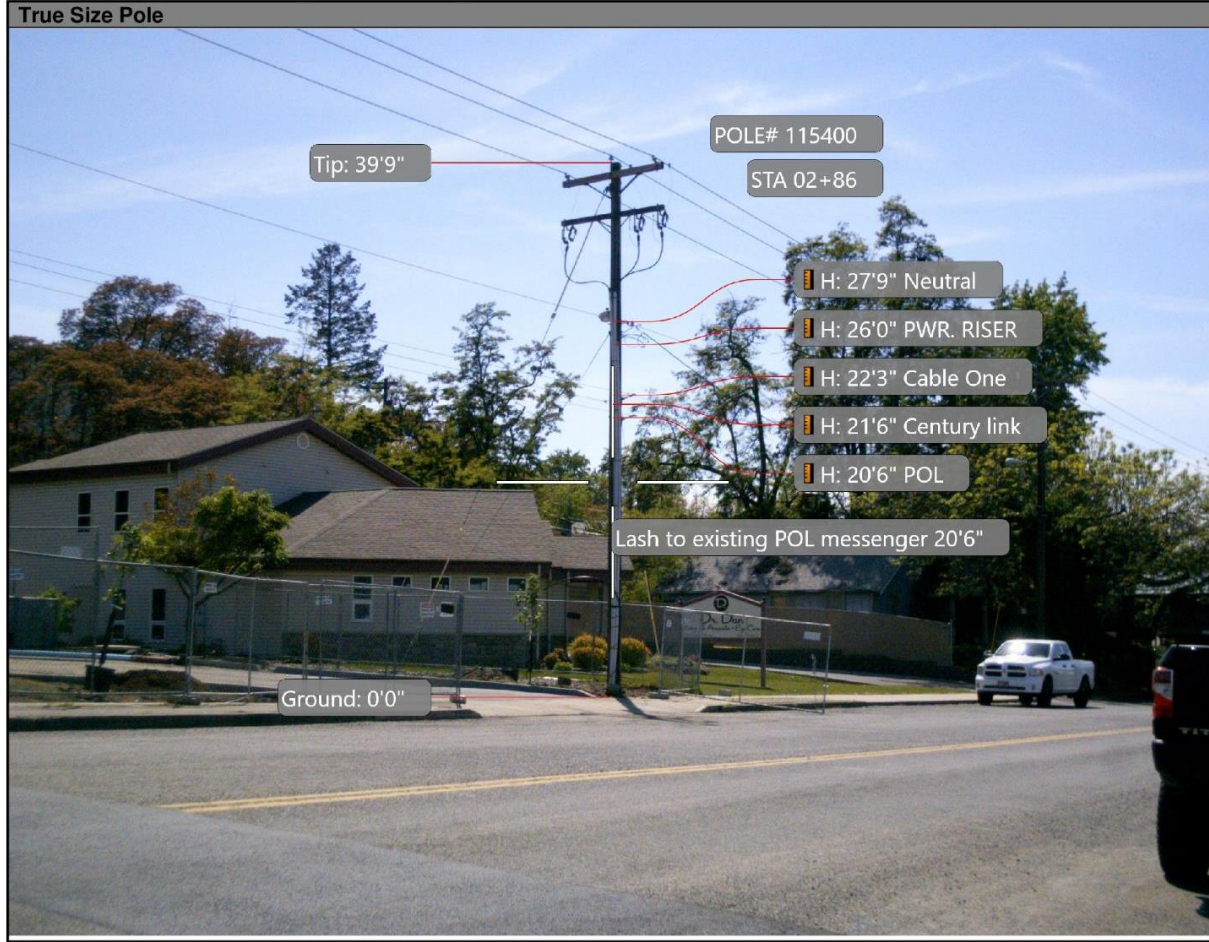

Joint use_G101153_20170509_143659

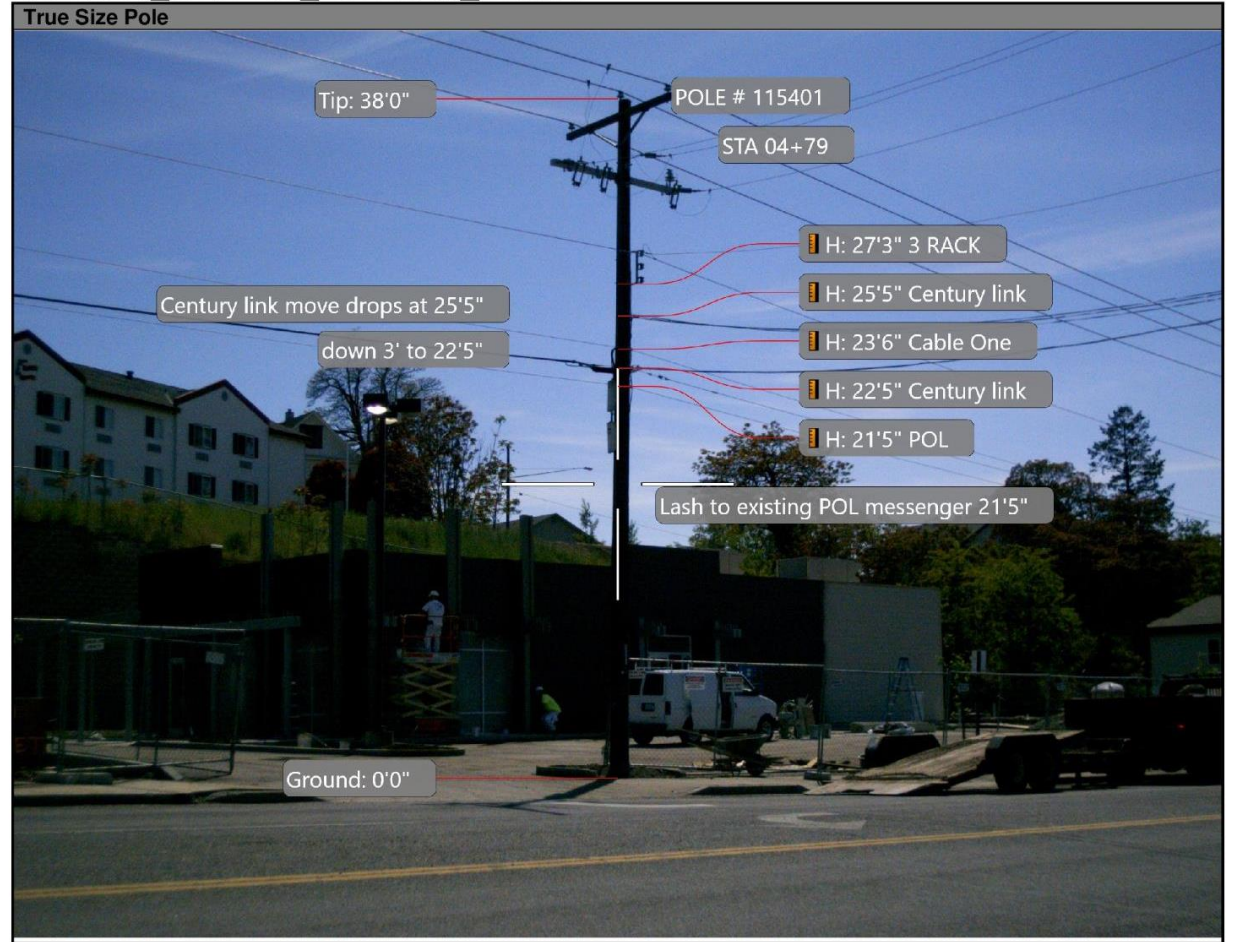

APPROVED
By Todd Ellsworth at 7:14 am, May 26, 2017

Drawing Name: Port of Lewiston	Drawn By: Ron Glessner 5-02-17				REV.	Add over lash poles	5-10-17	RG	Contact Information Port of Lewiston Dave Doeringsfeld 208-743-5531 Outside Plant Maintenance, llc Ron Glessner 208-661-5648	State: ID County: Nez Perce City: Lewiston
	RED LION LEWISTON				REV.	DESCRIPTION	DATE	BY		
	SIZE	FSCM NO	DWG NO	REV	REV.	DESCRIPTION	DATE	BY	Section: Township: Range: Legal:	
	SCALE		SHEET 4		REV.	DESCRIPTION	DATE	BY		



Joint use G101153 20170428 171537



APPROVED
By Todd Ellsworth at 7:14 am, May 26, 2017

Drawing Name: Port of Lewiston	Drawn By: Ron Glessner				REV.	Add over lash poles	5-10-17	RG	Contact Information Port of Lewiston Dave Doeringsfeld 208-743-5531 Outside Plant Maintenance, llc Ron Glessner 208-661-5648	State: ID County: Nez Perce City: Lewiston
	RED LION LEWISTON				REV.	DESCRIPTION	DATE	BY		
	SIZE	FSCMNO	DWG NO	REV	REV.	DESCRIPTION	DATE	BY	Section: Township: Range: Legal:	
	SCALE		SHEET 5		REV.	DESCRIPTION	DATE	BY		
					REV.	DESCRIPTION	DATE	BY		



APPROVED

By Todd Ellsworth at 7:14 am, May 26, 2017


Pull (1) 12 strand non armored fiber optic cable from new HH to server room.

Penetrate concrete exterior wall to mechanical room.

Attach 1¼" Sch 40 conduit to building exterior.

Pull fiber through existing conduit in mechanical room to server room.

Buried 1¼" HDPE conduit With locate wire.

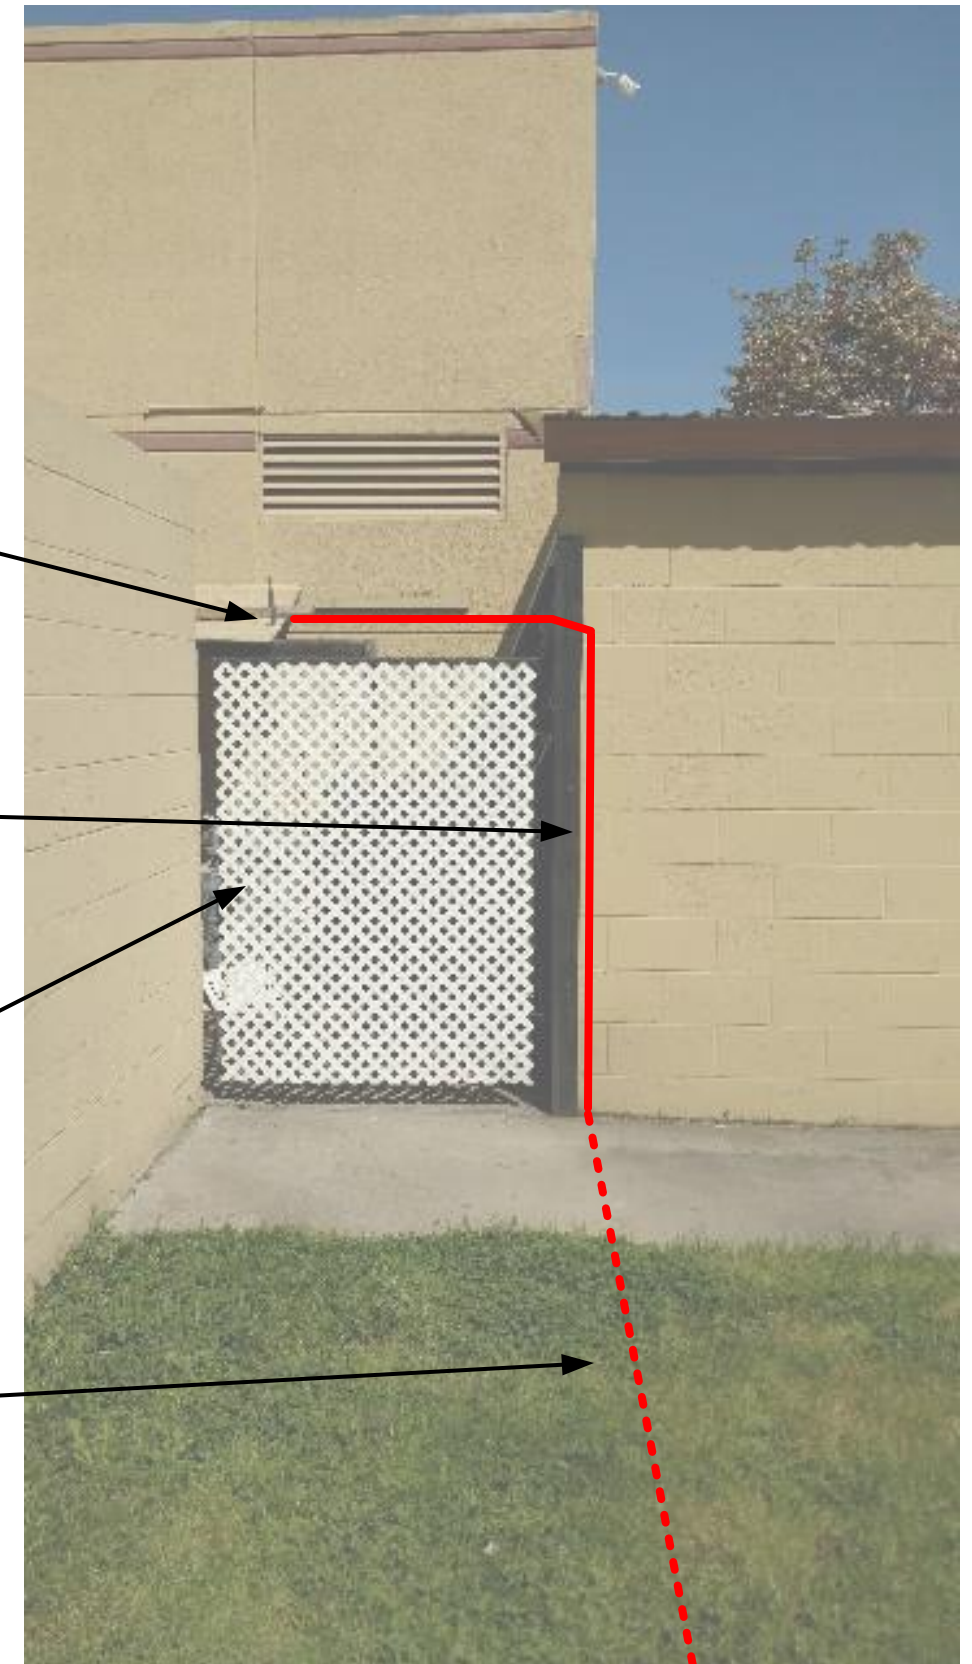

Drawing Name: Port of Lewiston		Drawn By: Ron Glessner			
RED LION LEWISTON					
SIZE	FSCM NO	DWG NO		REV	
SCALE		SHEET 6			

REV.	Add over lash poles	5-10-17	RG
REV.	DESCRIPTION	DATE	BY
REV.	DESCRIPTION	DATE	BY
REV.	DESCRIPTION	DATE	BY
REV.	DESCRIPTION	DATE	BY

Contact Information
 Port of Lewiston
 Dave Doeringsfeld
 208-743-5531
 Outside Plant Maintenance, llc
 Ron Glessner 208-661-5648

State: ID
 County: Nez Perce
 City: Lewiston
 Section:
 Township:
 Range:
 Legal:



Make Ready Summary	
Cable One	
Stationing	Description of work

Make Ready Summary	
Century Link	
Stationing	Description of Work
04+79	Move drops down 36" from 25'5" to 22'5"

Make Ready Summary	
X O Communications	
Stationing	Description of Work




Make Ready Summary	
Avista	
Stationing	Description of Work

Make Ready Summary	
Lewiston School District	
Stationing	Description of Work

APPROVED
By Todd Ellsworth at 7:14 am, May 26, 2017


Drawing Name: Port of Lewiston	5-10-2017				Revised	5-10-17	RG	Contact Information	State: ID County: Nez Perce City: Lewiston
	RED LION LEWISTON								
	SIZE	FSCM NO	DWG NO	REV	REV.	DESCRIPTION	DATE	BY	Port of Lewiston Dave Doeringsfeld 208-743-5531 Outside Plant Maintenance, LLC Ron Glessner 208-661-5648
	SCALE		Sheet 7		REV.	DESCRIPTION	DATE	BY	



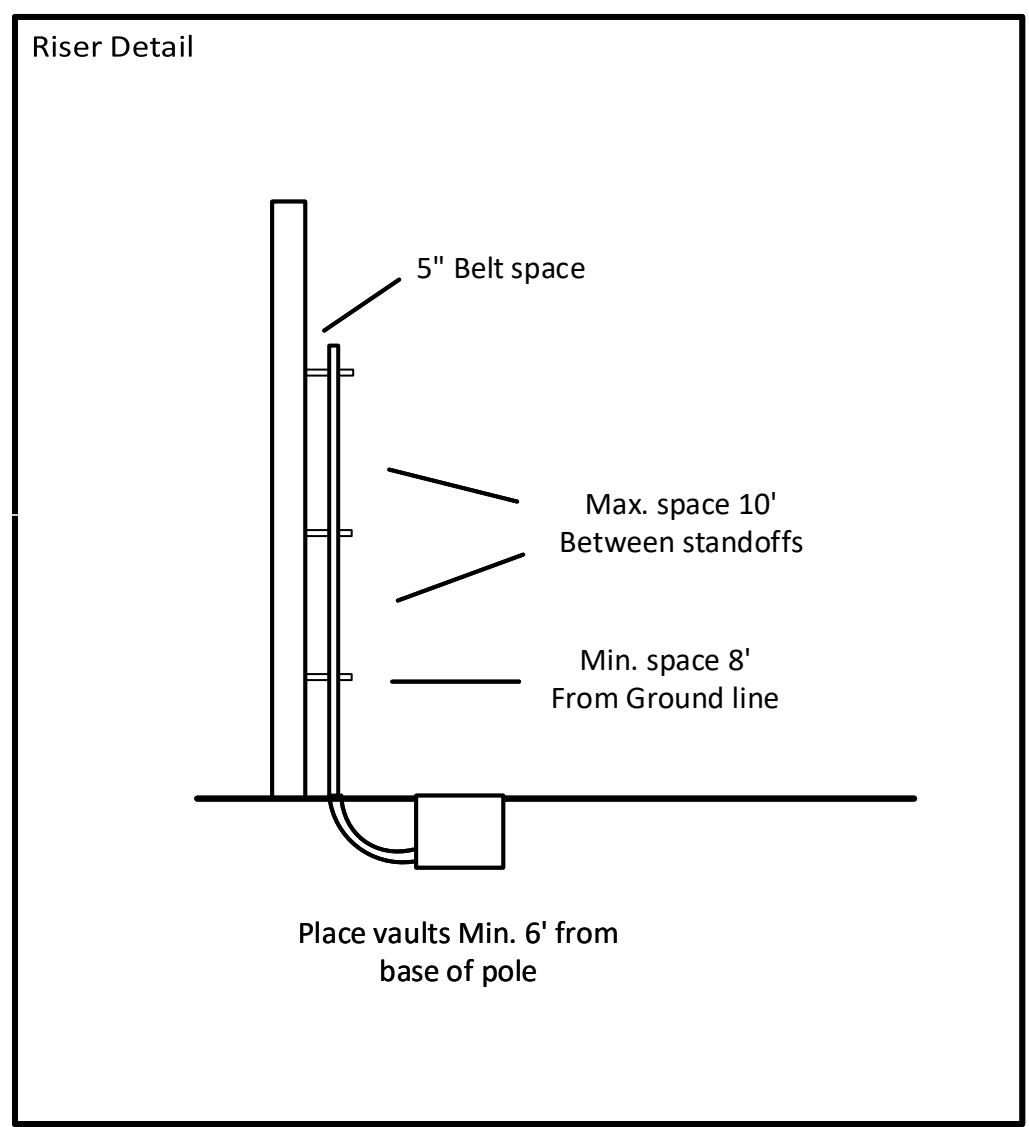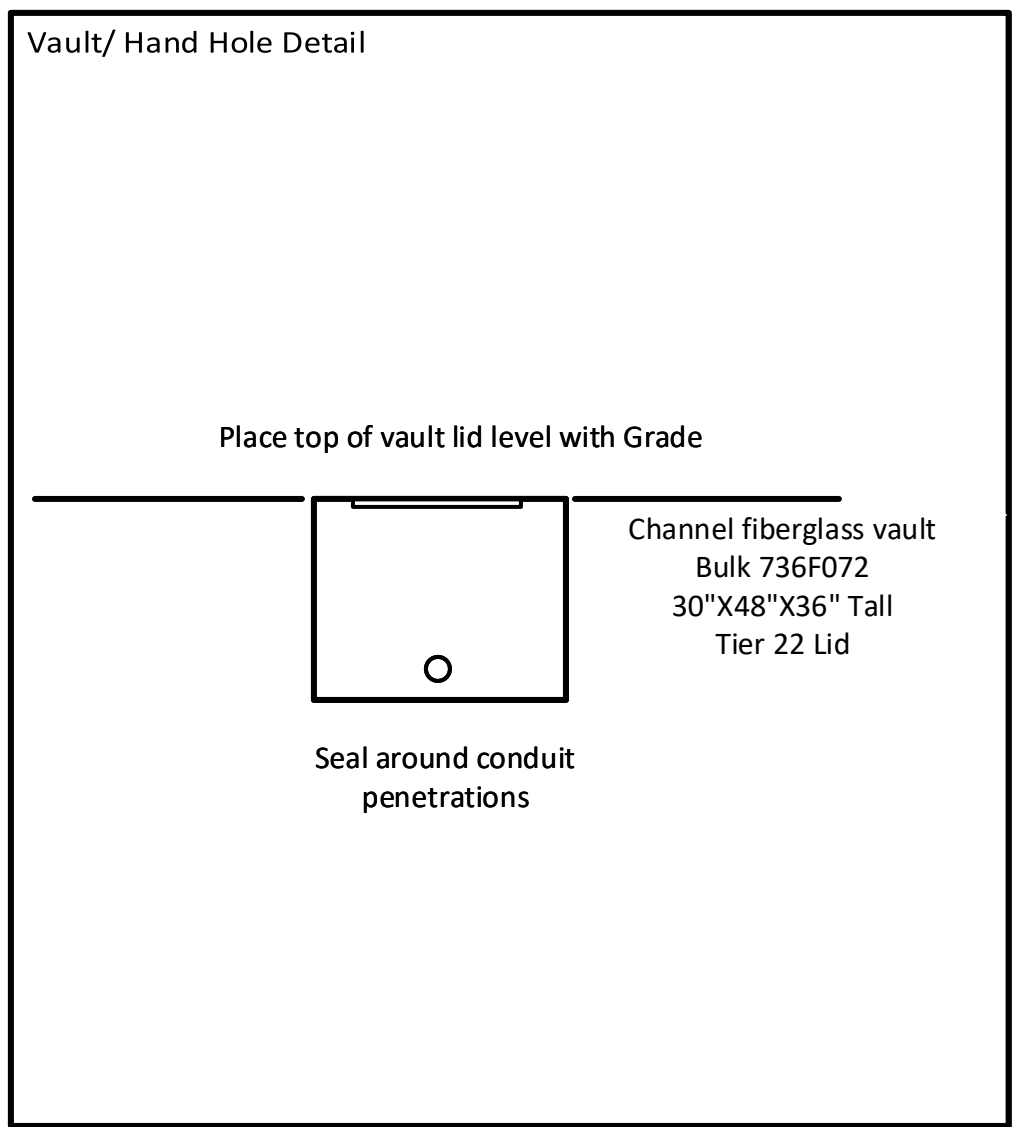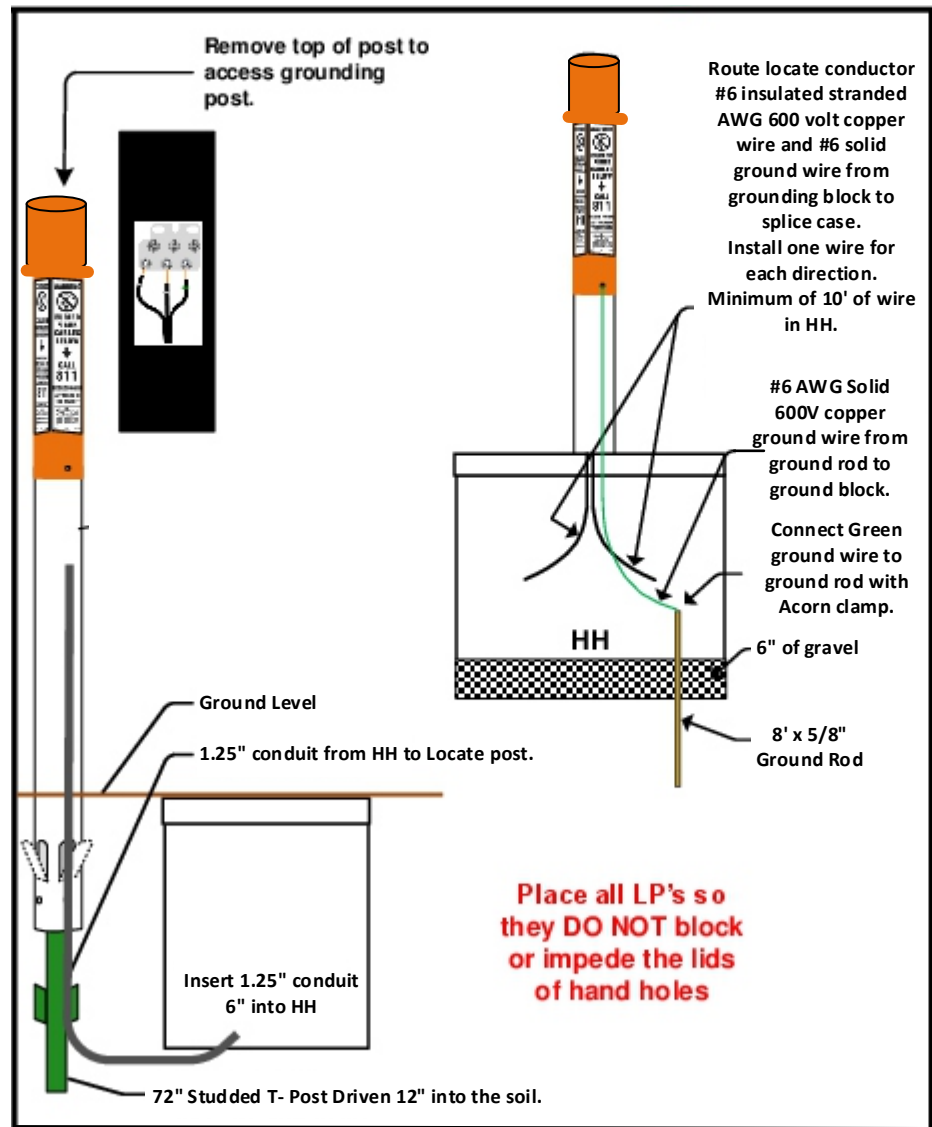

RUS Standards Directional Color Code Use colored tape or zip ties

ORANGE	= NORTH
GREEN	= EAST
BROWN	= SOUTH
SLATE	= WEST

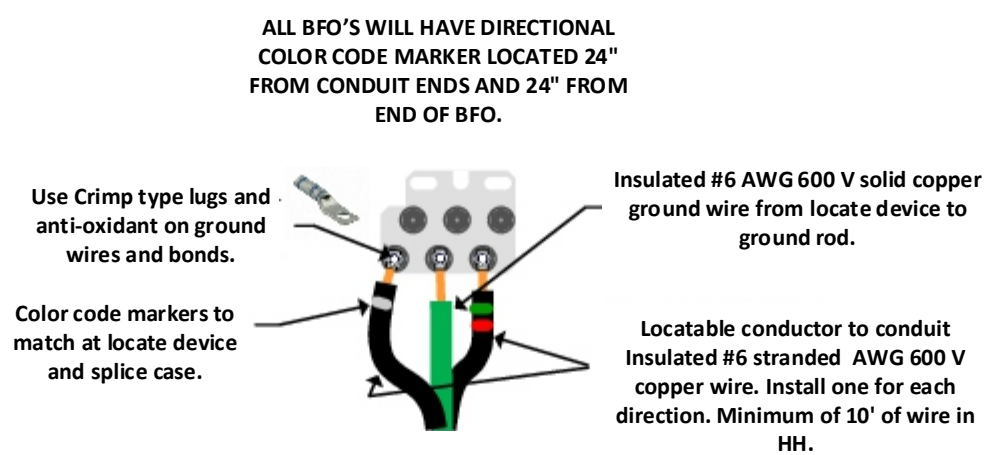

Drawn By: Ron Glessner			
RED LION LEWISTON			
SIZE	FSCM NO	DWG NO	REV
SCALE			SHEET 8

REV.	Revised	5-10-17	RG
REV.	DESCRIPTION	DATE	BY
REV.	DESCRIPTION	DATE	BY
REV.	DESCRIPTION	DATE	BY
REV.	DESCRIPTION	DATE	BY

Contact Information

Outside Plant Maintenance, llc
Ron Glessner 208-661-5648

State:
County:
City:

Section:
Township:
Range:
Legal:



GENERAL CONSTRUCTION NOTES

CONTRACTOR IS RESPONSIBLE FOR ALL PERMITS EXCEPT STATE HWY., COUNTY ROAD,RAILROAD OR WATER CROSSINGS.

RESTORATION OF ALL RIGHT OF WAY GROUND WILL BE RESTORED TO ORIGINAL CONDITION OR BETTER.

CONTRACTOR WILL COORDINATE WITH OSP MANAGER 24 HRS. PRIOR TO BEGINNING CONSTRUCTION.

OSP MANAGER WILL CONTACT BUILDING OWNER/TENANT 24 HRS. PRIOR TO BEGINNING CONSTRUCTION TO COORDINATE ACCESS TO BUILDINGS.


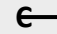





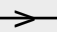



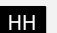

CONTRACTOR IS RESPONSIBLE FOR CALLING LOCATES AND IS RESPONSIBLE FOR REPAIR AND RESTORATION OF DAMAGED UTILITIES.

FOLLOW ALL NESC CONSTRUCTION GUIDELINES.

CONTRACTOR WILL HAVE ON SITE THE APPROVED DRAWINGS FROM THE UTILITY AND OR STATE,COUNTY,CITY,RAILROAD.

CONTRACTOR WILL PROVIDE CONDUIT , HAND HOLES , ANCHORS, AERIAL HARDWARE , LOCATE WIRE

PORT OF LEWISTON (POL) WILL PROVIDE , FIBER OPTIC CABLE , AERIAL MARKERS , AND LINE ROUTE MARKERS.

	JOINT USE POLE
	EXISTING ANCHOR
	AERIAL CABLE
	BURIED CABLE
	NEW ANCHOR
	SIDEWALK ANCHOR
	FIBER SLACK LOOP
	OVERHEAD GUY
	ATTACH TO POLE GROUND
	CABLE CHANGE
	BURIED ROUTE MARKER
	EXISTING HAND HOLE
	NEW HAND HOLE

Drawing Name:Port of Lewiston	Drawn By:Ron Glessner 5-02-17				REV.	Add over lash poles	5-10-17	RG	Contact Information Port of Lewiston Dave Doeringsfeld 208-743-5531 Outside Plant Maintenance,llc Ron Glessner208-661-5648	State:ID. County:Nez Perce City: Lewiston
	RED LION LEWISTON				REV.	DESCRIPTION	DATE	BY		
	SIZE	FSCMNO	DWG NO	REV	REV.	DESCRIPTION	DATE	BY	Section: Township: Range: Legal:	
	SCALE	No scale	SHEET 9		REV.	DESCRIPTION	DATE	BY		

