



<b>Drawing Name: Port of Lewiston</b>		Drawn By: Ron Glessner 03-01-17	
<b>CENTURY LINK CONDUIT</b>			
SIZE	FSCM NO	DWG NO	REV
SCALE	VICINITY		

REV.	Revised	4-11-17	RG
REV.	DESCRIPTION	DATE	BY
REV.	DESCRIPTION	DATE	BY
REV.	DESCRIPTION	DATE	BY
REV.	DESCRIPTION	DATE	BY


**Contact Information**

Port of Lewiston  
 Dave Doeringsfeld  
 208-743-5531  
 Outside Plant Maintenance, llc  
 Ron Glessner 208-661-5648

State: ID  
 County: Nez Perce  
 City: Lewiston


Section:  
 Township:  
 Range:  
 Legal:



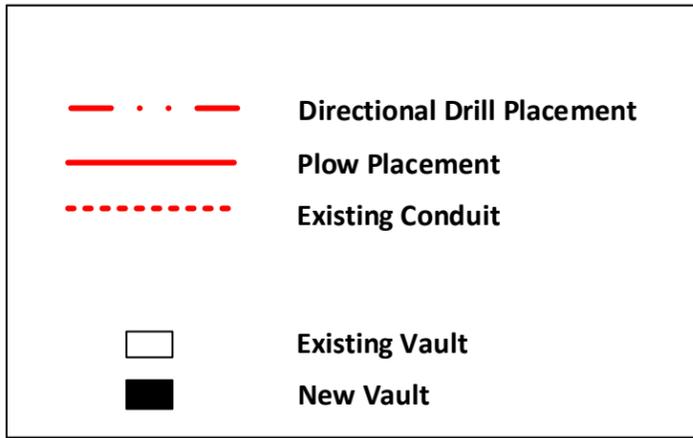


FIBER CONSTRUCTION	
UNIT DESCRIPTION	AMT
EXISTING 4" DUCT	2872'
New 1 1/4" Conduit	8726'
288 CT. FIBER OPTIC CABLE	3662'
NEW HAND HOLE	1

Vault/ Hand Hole Detail

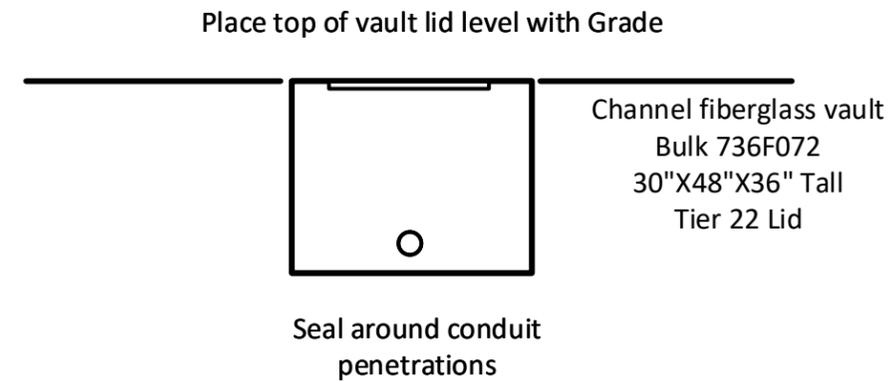

PLACE THREE 1 1/4" HDPE CONTINUOUS CONDUIT INSIDE 4" DUCT.

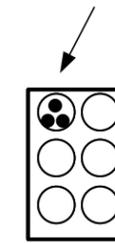

EXISTING CENTURY LINK DUCT BANK CONTAINING TWENTY (4") DUCTS.

GENERAL CONSTRUCTION NOTES

CONTRACTOR IS RESPONSIBLE FOR ALL PERMITS EXCEPT STATE HWY., COUNTY ROAD,RAILROAD OR WATER CROSSINGS.

RESTORATION OF ALL RIGHT OF WAY GROUND WILL BE RESTORED TO ORIGINAL CONDITION OR BETTER.

CONTRACTOR WILL COORDINATE WITH OSP MANAGER 24 HRS. PRIOR TO BEGINNING CONSTRUCTION.

OSP MANAGER WILL CONTACT BUILDING OWNER/TENANT 24 HRS. PRIOR TO BEGINNING CONSTRUCTION TO COORDINATE ACCESS TO BUILDINGS.


CONTRACTOR IS RESPONSIBLE FOR CALLING LOCATES AND IS RESPONSIBLE FOR REPAIR AND RESTORATION OF DAMAGED UTILITIES.

FOLLOW ALL NESC CONSTRUCTION GUIDELINES.


BURIED CONDUIT MUST CROSS UNDERNEATH ALL CITY UTILITIES

CONTRACTOR WILL HAVE ON SITE THE APPROVED DRAWINGS FROM THE UTILITY AND OR STATE,COUNTY,CITY,RAILROAD.

CONTRACTOR WILL PROVIDE CONDUIT AND HAND HOLES

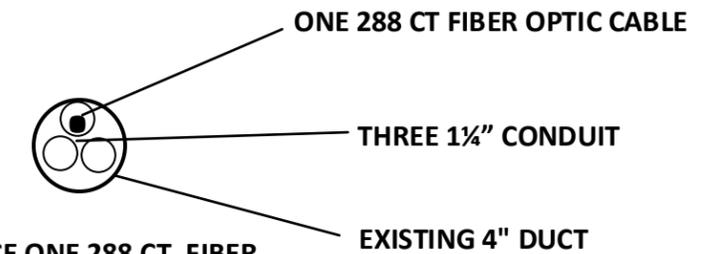

PLACE ONE 288 CT. FIBER OPTIC CABLE INSIDE ONE 1 1/4" CONDUIT

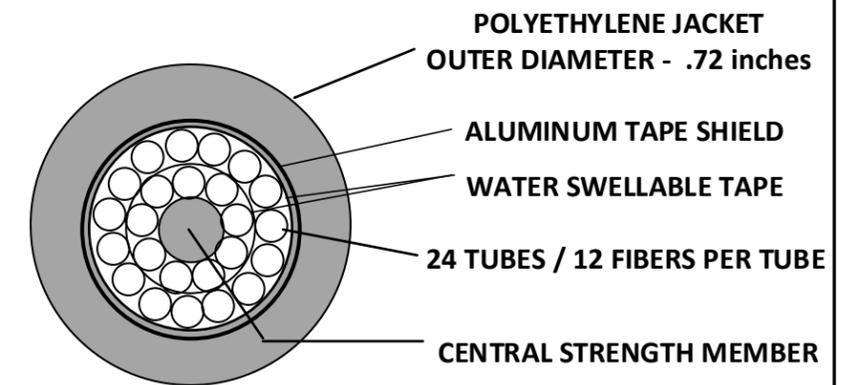


288 COUNT FIBER OPTIC CABLE  
NOMINAL WEIGHT = 152 lb./ 1000 FEET

Drawing Name:Port of Lewiston	Drawn By:Ron Glessner 03-01-17			
	<b>CENTURY LINK CONDUIT</b>			
SIZE	FSCM NO	DWG NO	REV	
SCALE				Construction notes

REV.	DESCRIPTION	DATE	BY

Contact Information	State: ID County: Nez Perce City: Lewiston
Port of Lewiston Dave Doeringsfeld 208-743-5531 Outside Plant Maintenance, llc Ron Glessner208-661-5648	Section: Township: Range: Legal:



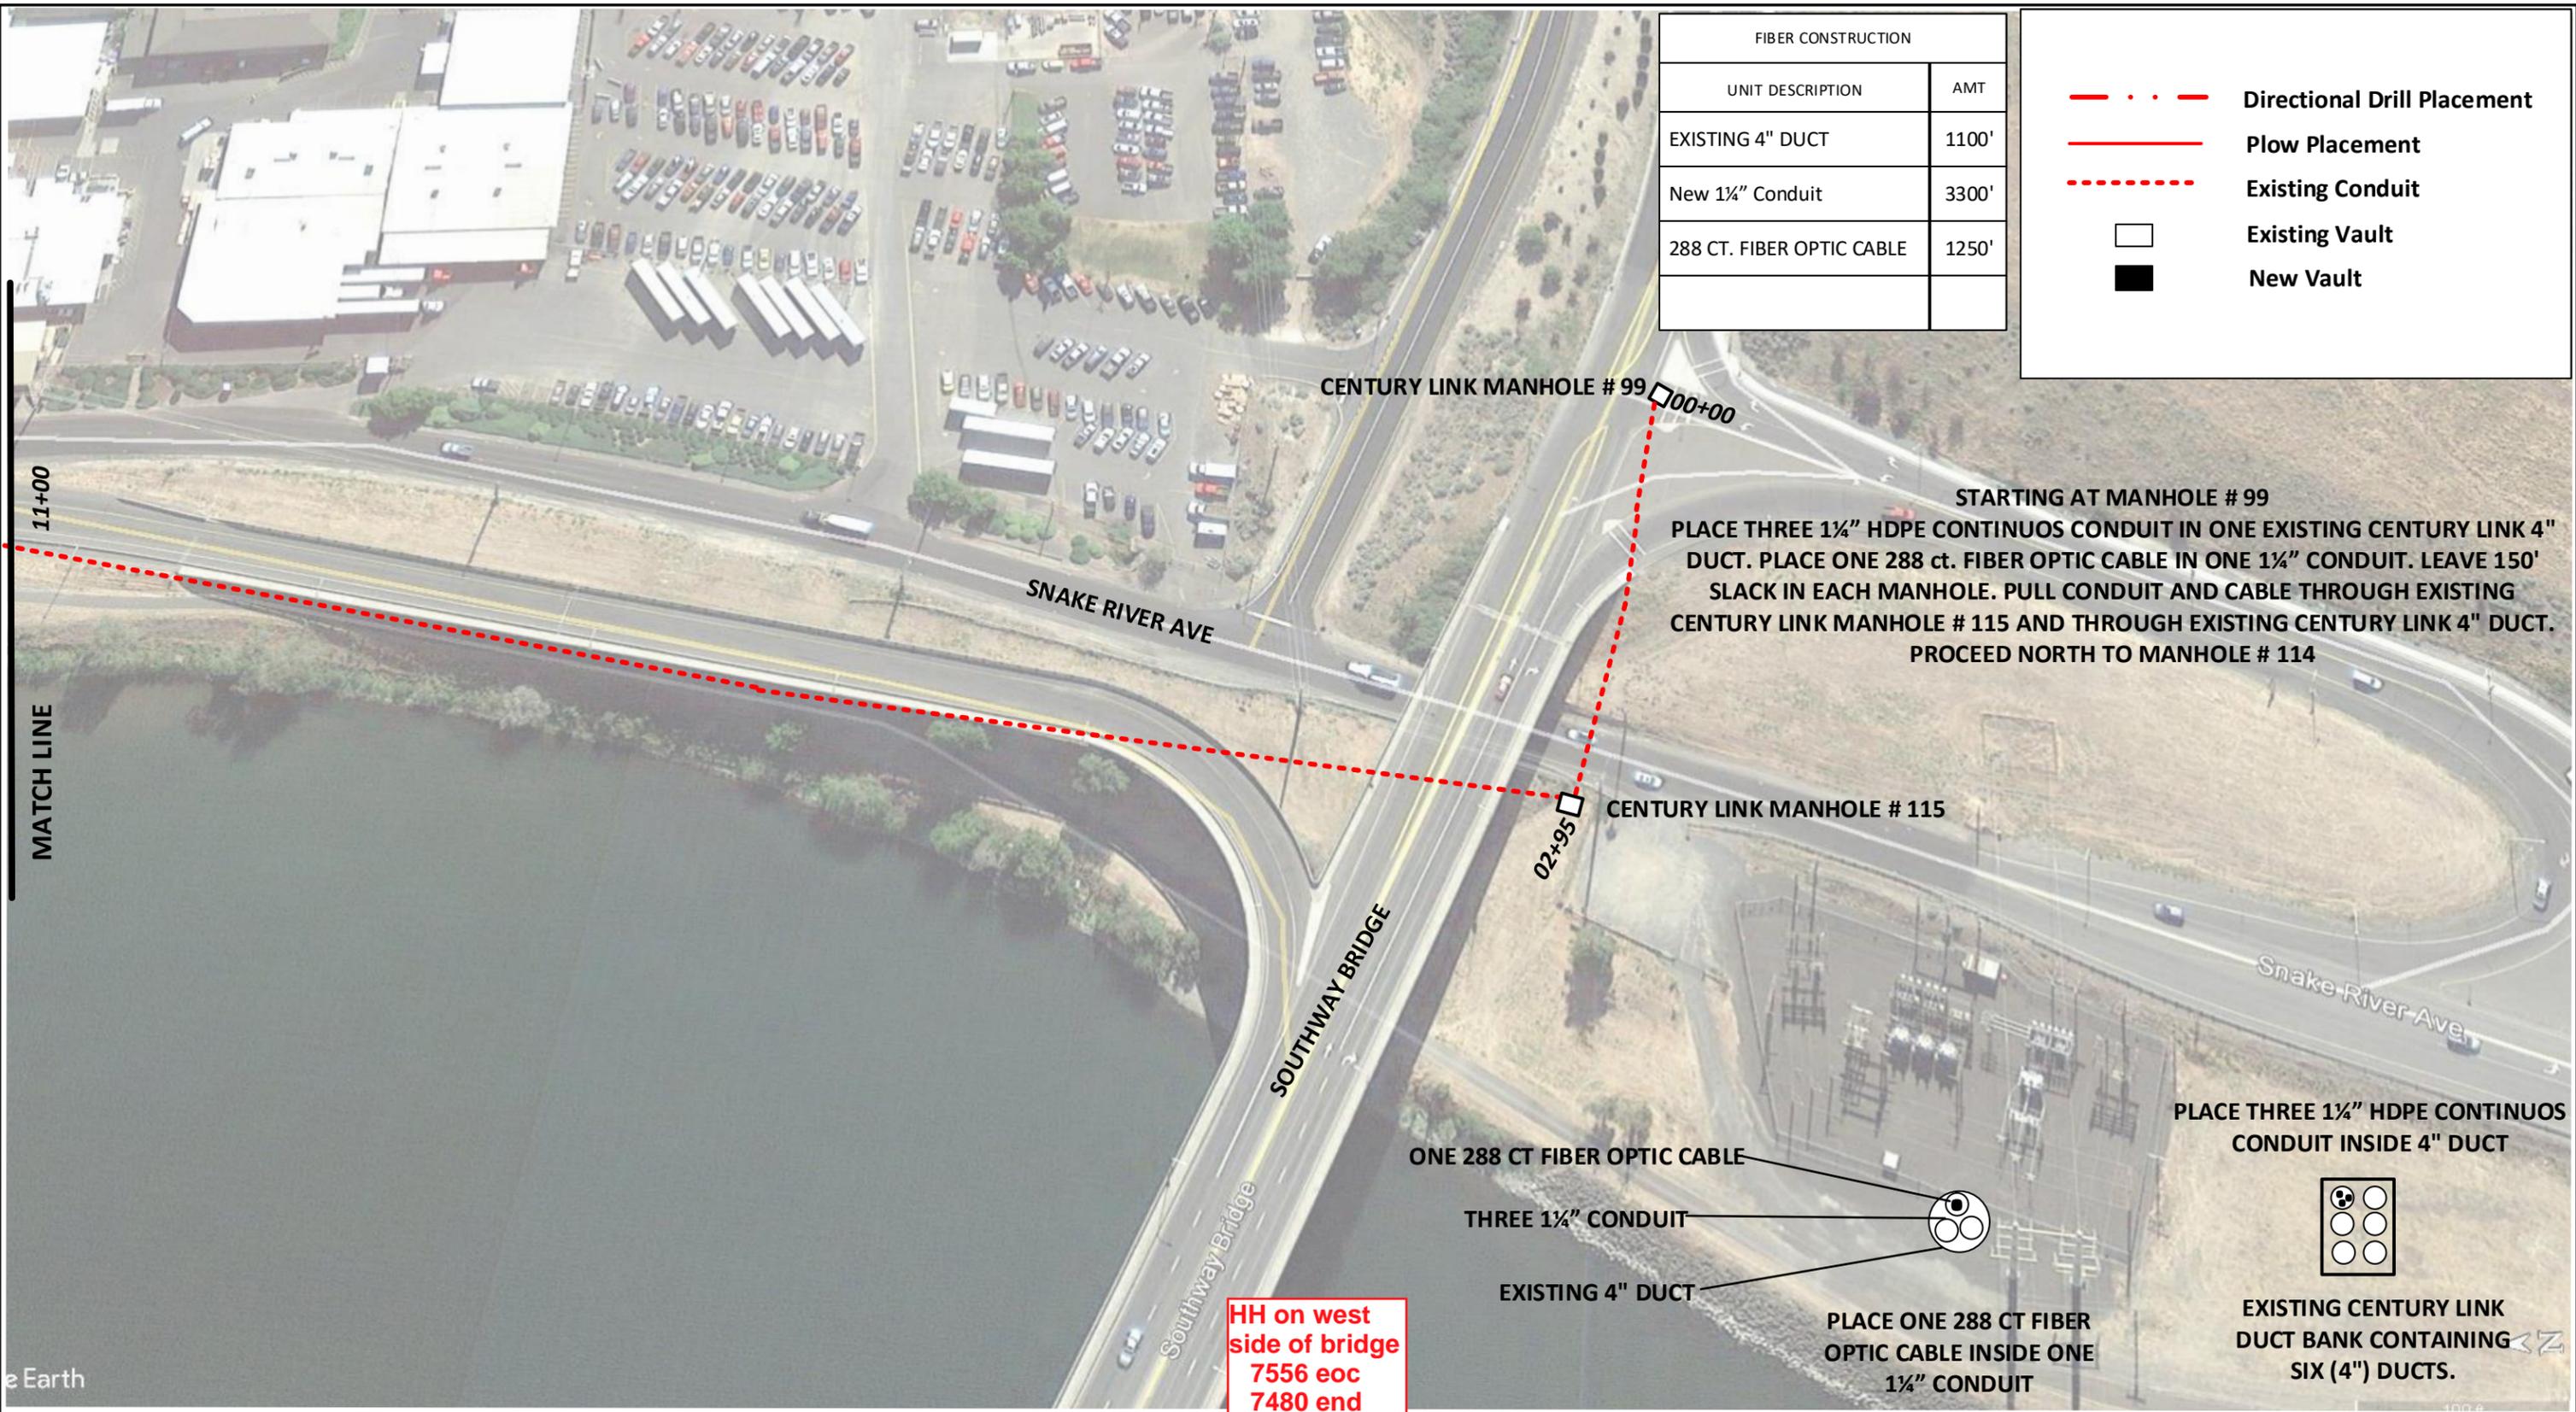


FIBER CONSTRUCTION	
UNIT DESCRIPTION	AMT
EXISTING 4" DUCT	1100'
New 1 1/4" Conduit	3300'
288 CT. FIBER OPTIC CABLE	1250'

**Legend:**

- . . - Directional Drill Placement
- Plow Placement
- - - - Existing Conduit
- Existing Vault
- New Vault

**STARTING AT MANHOLE # 99**  
 PLACE THREE 1 1/4" HDPE CONTINUOUS CONDUIT IN ONE EXISTING CENTURY LINK 4" DUCT. PLACE ONE 288 ct. FIBER OPTIC CABLE IN ONE 1 1/4" CONDUIT. LEAVE 150' SLACK IN EACH MANHOLE. PULL CONDUIT AND CABLE THROUGH EXISTING CENTURY LINK MANHOLE # 115 AND THROUGH EXISTING CENTURY LINK 4" DUCT. PROCEED NORTH TO MANHOLE # 114

PLACE THREE 1 1/4" HDPE CONTINUOUS CONDUIT INSIDE 4" DUCT

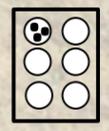

EXISTING CENTURY LINK DUCT BANK CONTAINING SIX (4") DUCTS.

ONE 288 CT FIBER OPTIC CABLE

THREE 1 1/4" CONDUIT

EXISTING 4" DUCT

PLACE ONE 288 CT FIBER OPTIC CABLE INSIDE ONE 1 1/4" CONDUIT


**HH on west side of bridge  
7556 eoc  
7480 end**

<b>Drawing Name: Port of Lewiston</b>			
Drawn By: Ron Glessner 03-01-17			
<b>CENTURY LINK CONDUIT</b>			
SIZE	FSCMNO	DWG NO	REV
SCALE	SHEET 1		

REV.	DESCRIPTION	DATE	BY
REV.	Revised	4-11-17	RG
REV.			
REV.	DESCRIPTION	DATE	BY
REV.	DESCRIPTION	DATE	BY
REV.	DESCRIPTION	DATE	BY

<b>Contact Information</b>	
Port of Lewiston Dave Doeringsfeld 208-743-5531 Outside Plant Maintenance, llc Ron Glessner 208-661-5648	
State: ID County: Nez Perce City: Lewiston	
Section: Township: Range: Legal:	



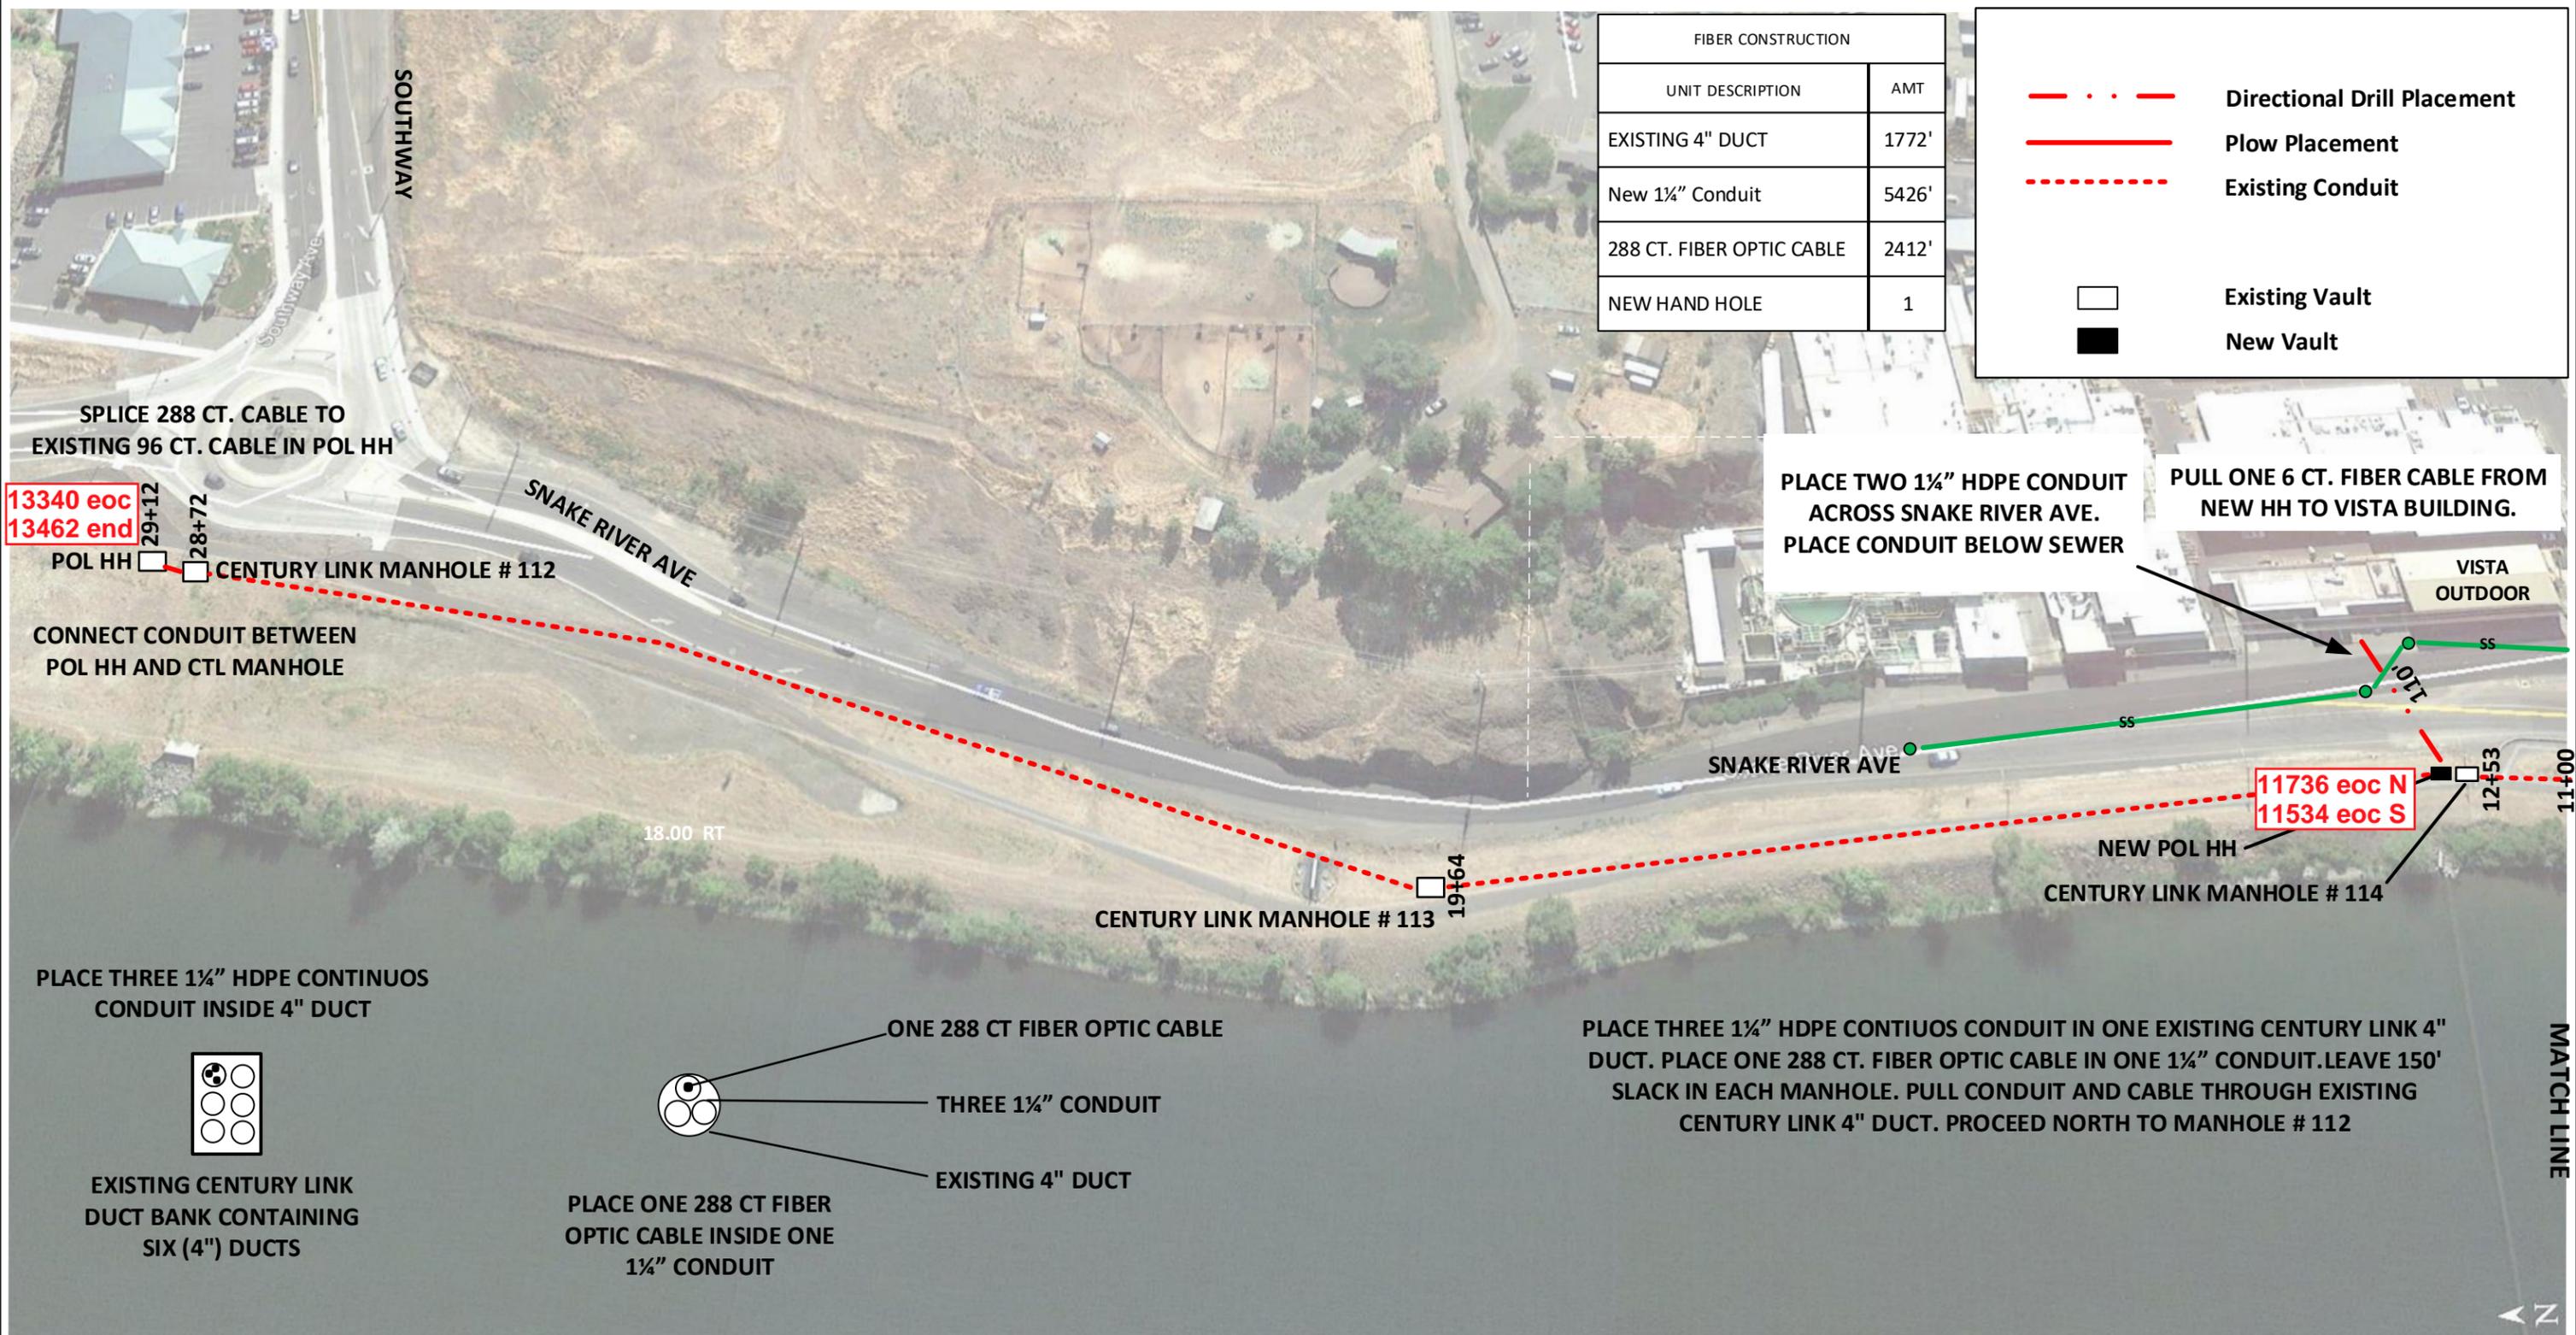


SPLICE 288 CT. CABLE TO EXISTING 96 CT. CABLE IN POL HH

13340 eoc  
13462 end


POL HH 29+12 28+72 CENTURY LINK MANHOLE # 112

CONNECT CONDUIT BETWEEN POL HH AND CTL MANHOLE

PLACE THREE 1 1/4" HDPE CONTINUOUS CONDUIT INSIDE 4" DUCT

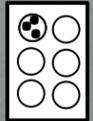

EXISTING CENTURY LINK DUCT BANK CONTAINING SIX (4") DUCTS

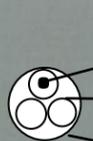

PLACE ONE 288 CT FIBER OPTIC CABLE INSIDE ONE 1 1/4" CONDUIT

- ONE 288 CT FIBER OPTIC CABLE
- THREE 1 1/4" CONDUIT
- EXISTING 4" DUCT

PLACE TWO 1 1/4" HDPE CONDUIT ACROSS SNAKE RIVER AVE. PLACE CONDUIT BELOW SEWER

PULL ONE 6 CT. FIBER CABLE FROM NEW HH TO VISTA BUILDING.

11736 eoc N  
11534 eoc S

NEW POL HH CENTURY LINK MANHOLE # 114

PLACE THREE 1 1/4" HDPE CONTINUOUS CONDUIT IN ONE EXISTING CENTURY LINK 4" DUCT. PLACE ONE 288 CT. FIBER OPTIC CABLE IN ONE 1 1/4" CONDUIT. LEAVE 150' SLACK IN EACH MANHOLE. PULL CONDUIT AND CABLE THROUGH EXISTING CENTURY LINK 4" DUCT. PROCEED NORTH TO MANHOLE # 112

MATCH LINE

Drawing Name: Port of Lewiston		Drawn By: Ron Glessner 03-01-17	
<b>CENTURY LINK CONDUIT</b>			
SIZE	FSCM NO	DWG NO	REV
SCALE	SHEET 2		

REV.	DESCRIPTION	DATE	BY
Revised		4-11-17	BRG
REV.	DESCRIPTION	DATE	BY
REV.	DESCRIPTION	DATE	BY
REV.	DESCRIPTION	DATE	BY
REV.	DESCRIPTION	DATE	BY

Contact Information  
  
Port of Lewiston  
Dave Doeringsfeld  
208-743-5531  
Outside Plant Maintenance, llc  
Ron Glessner 208-661-5648

State: ID  
County: Nez Perce  
City: Lewiston  
  
Section:  
Township:  
Range:  
Legal:

