



755 Crossover Ln. Memphis TN
38117
p: 901.241.5000 f: 901.374.5800



Jensen Fey
ARCHITECTURE & PLANNING
7730 LEARY WAY NE
REDMOND, WA 98052
TEL: 425.238.0338 FAX: 425.238.0329

KELTIC ENGINEERING, INC.
212 Adams Lane • Lewiston, Idaho 83501 • (208) 742-2125 • (208) 742-2130 fax
www.keltic-engineering.com • Email: info@keltic-engineering.com



ISSUE INFORMATION

ISSUE INFORMATION

DESCRIPTION	DATE
FOUNDATION PERMIT	02-02-15
BUILDING PERMIT	02-19-15

DRAWN: FML/TML

CHECKED: EFH

JOB NO: 14-0080

HILTON PROJECT NO: 5614


PLOT DATE: 2/17/15

SHT TITLE: GRADING & DRAINAGE


PROJECT INFORMATION

LEWISTON HAMPTON INN
2701 NEZ PERCE DRIVE
LEWISTON, ID 83501

SHT NO. **C7** OF **C14**

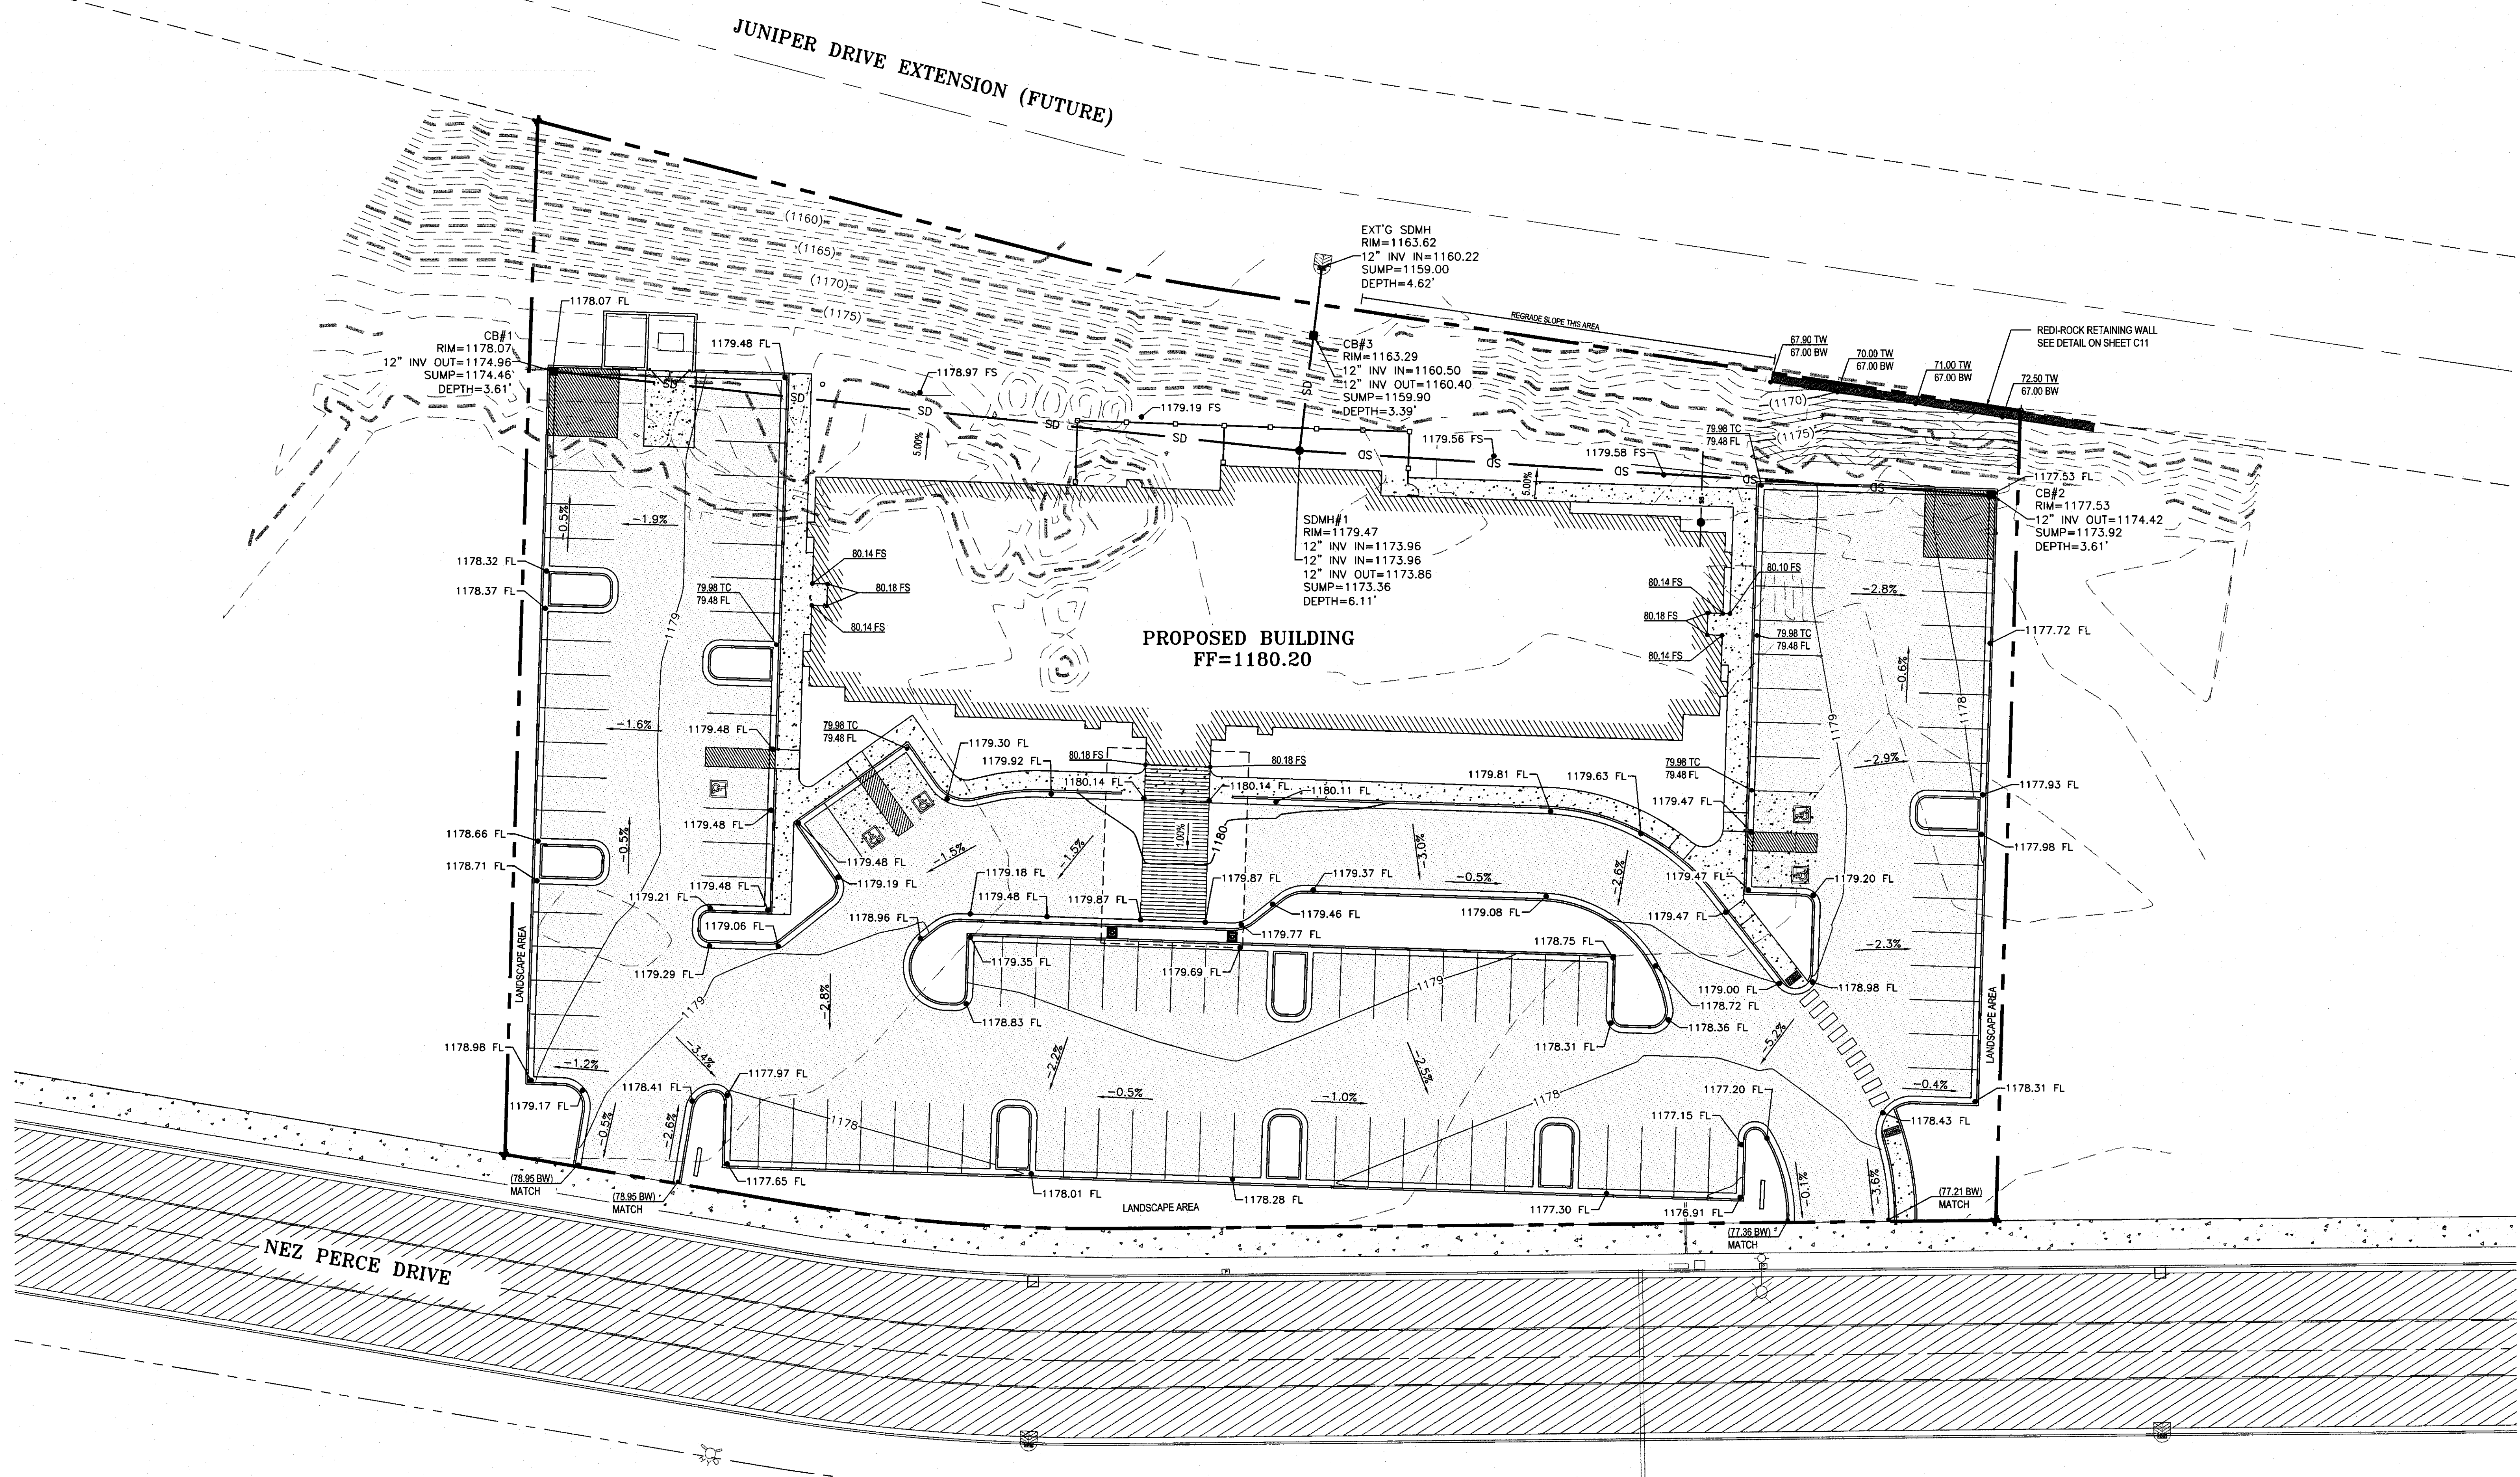

GRADING & DRAINAGE

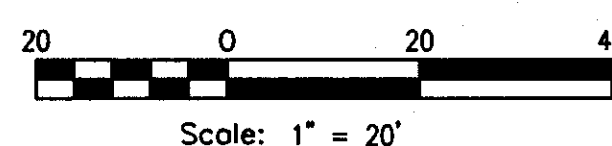

Know what's below.
Call before you dig.

CALL 2 BUSINESS DAYS IN ADVANCE BEFORE
YOU DIG, GRADE, OR EXCAVATE FOR THE
MARKING OF UNDERGROUND MEMBER
UTILITIES