

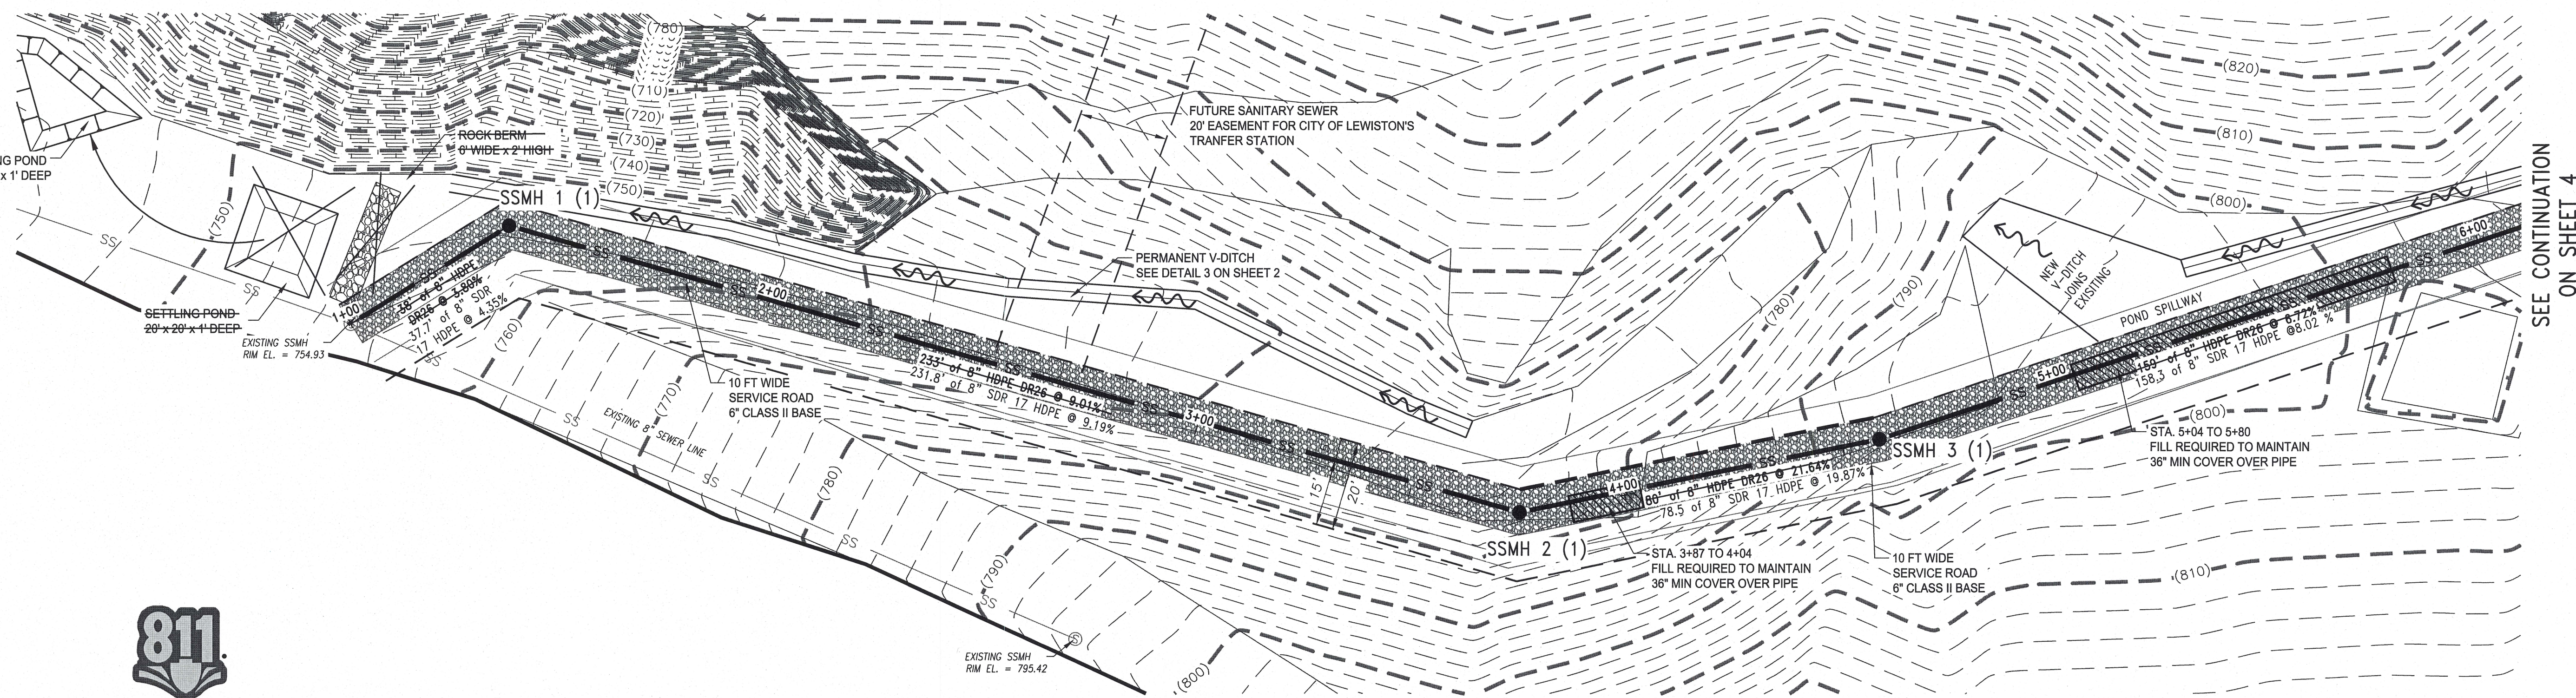


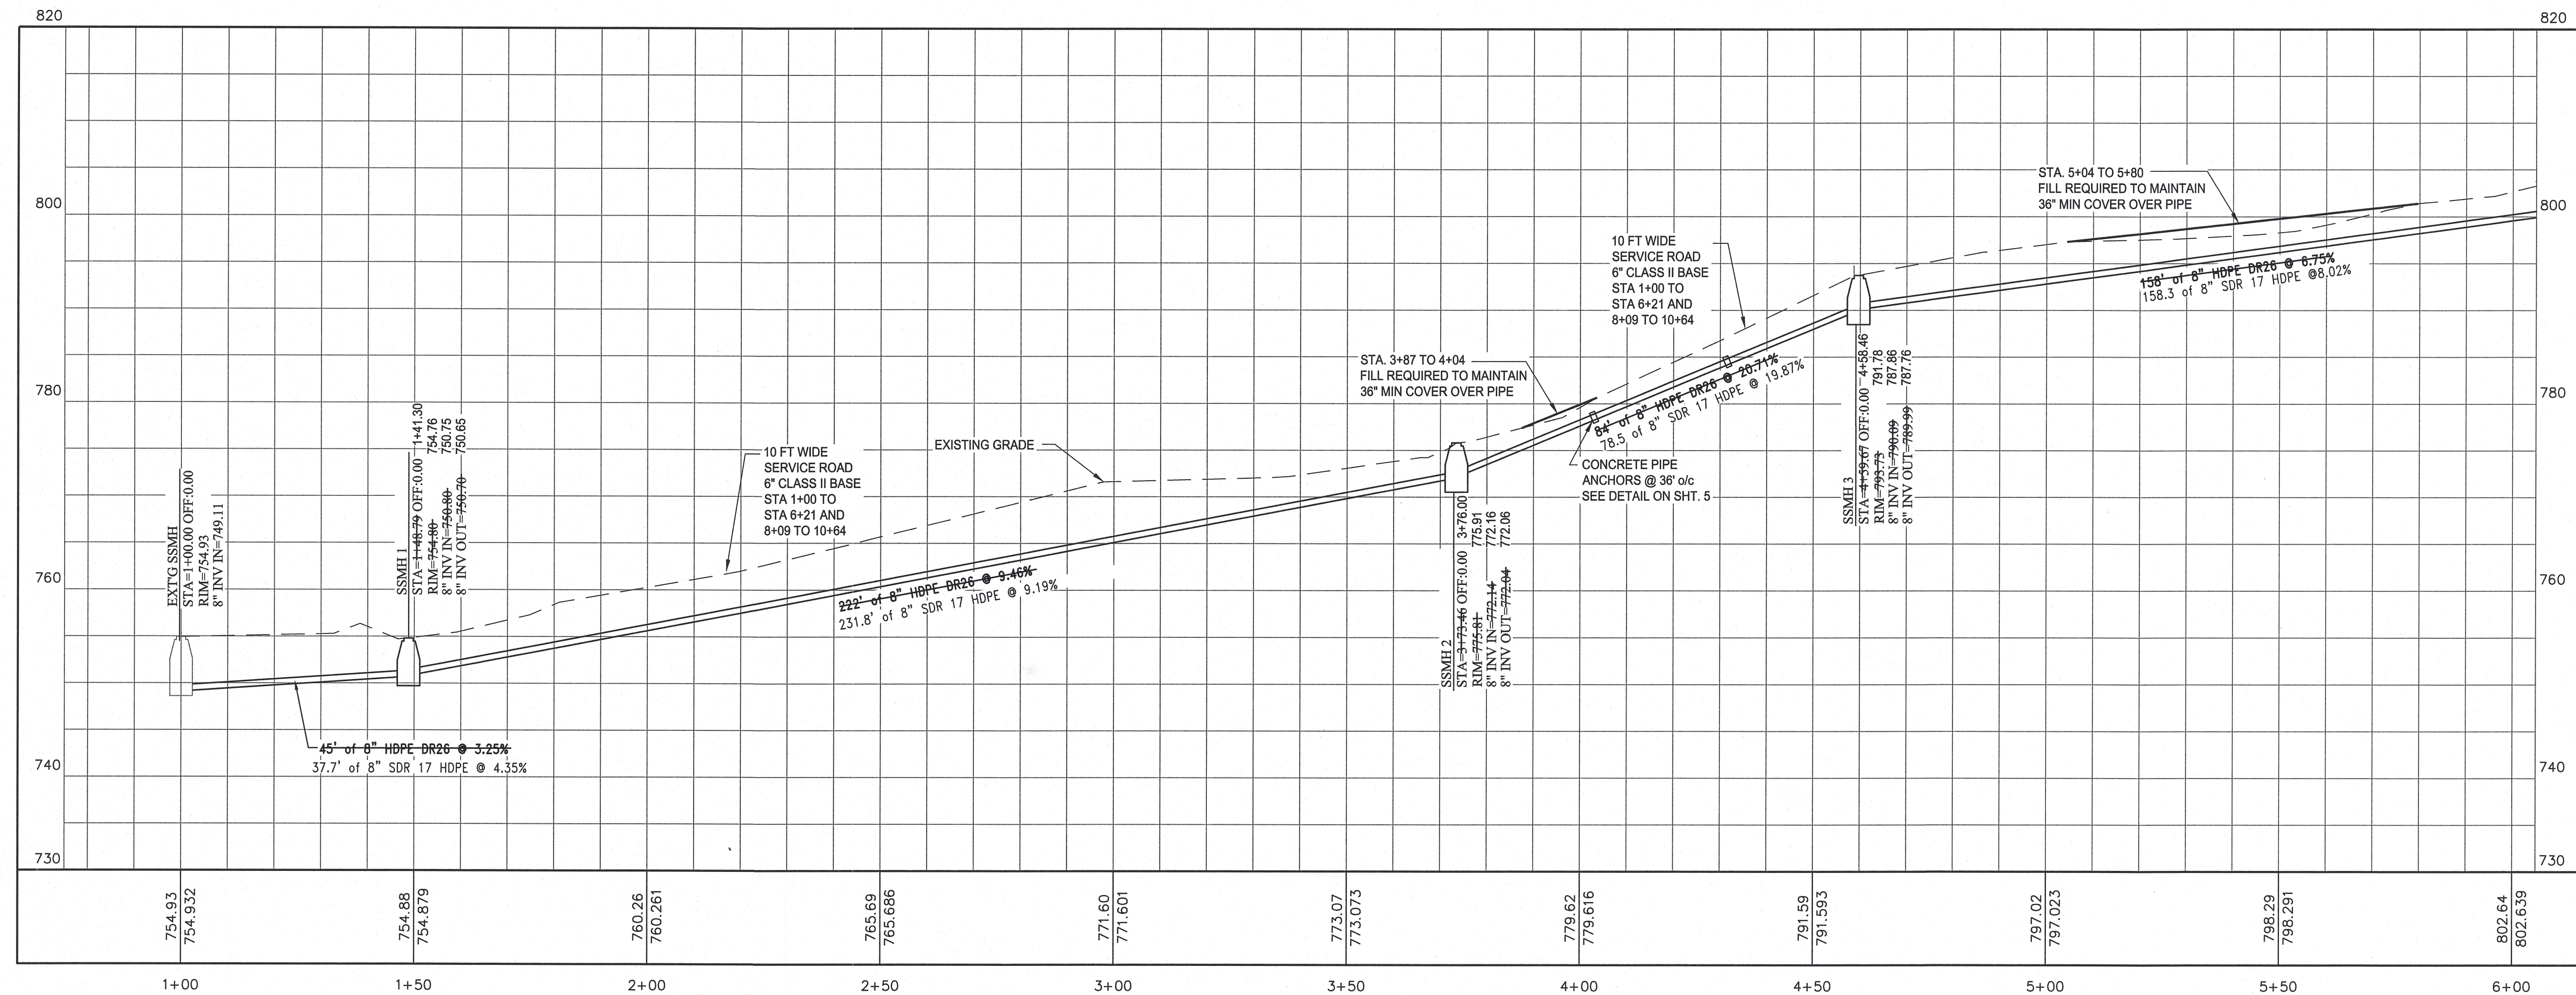

SANITARY SEWER - STA. 1+00 - 6+00

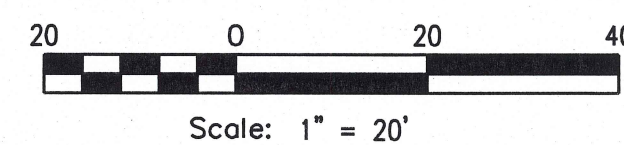


RECORD DRAWING 4-29-2015

DATE	BY	DESCRIPTION

SANITARY SEWER STA. 1+00 - 6+00
HARRY WALL SEWER MAIN EXTENSION
PORT OF LEWISTON, 1626 6TH AVE. N
LEWISTON, ID 83501

KELTIC ENGINEERING, INC.
315 Adams Lane • Lewiston, Idaho 83501 • (208) 743-2135 • (208) 743-2136 fax
9425 North Nevada Street, Ste 204 • Spokane, WA 99218 • (509) 464-3000 • (509) 464-3005 fax
• Development • Planning • Design • Construction Management

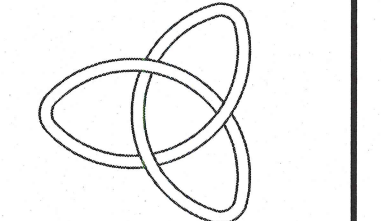

DRAWN BY:	JDM	CHECKED BY:	EFH
DESIGNED BY:	EFH		
DATE:	12-22-14		
LAST REV:	04-29-15 (FML)		
PROJECT NO.	14-1302		
SHEET NO.	3	OF	5



Know what's below.
Call before you dig.

CALL 2 BUSINESS DAYS IN ADVANCE BEFORE
YOU DIG, GRADE, OR EXCAVATE FOR THE
MARKING OF UNDERGROUND MEMBER
UTILITIES