

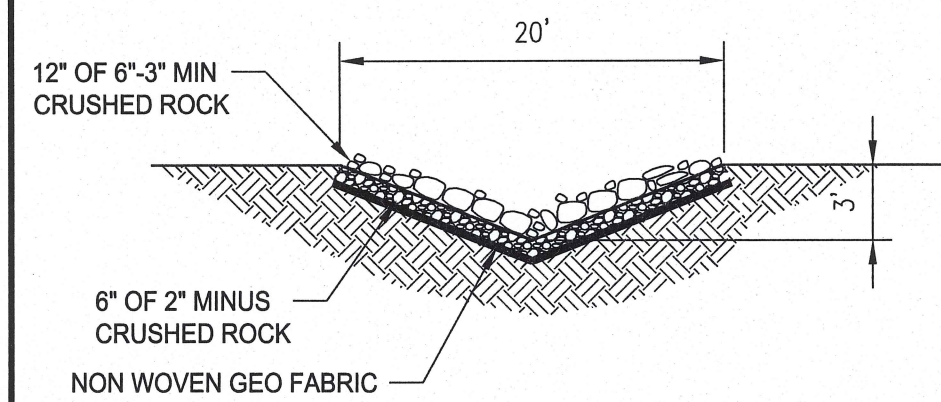


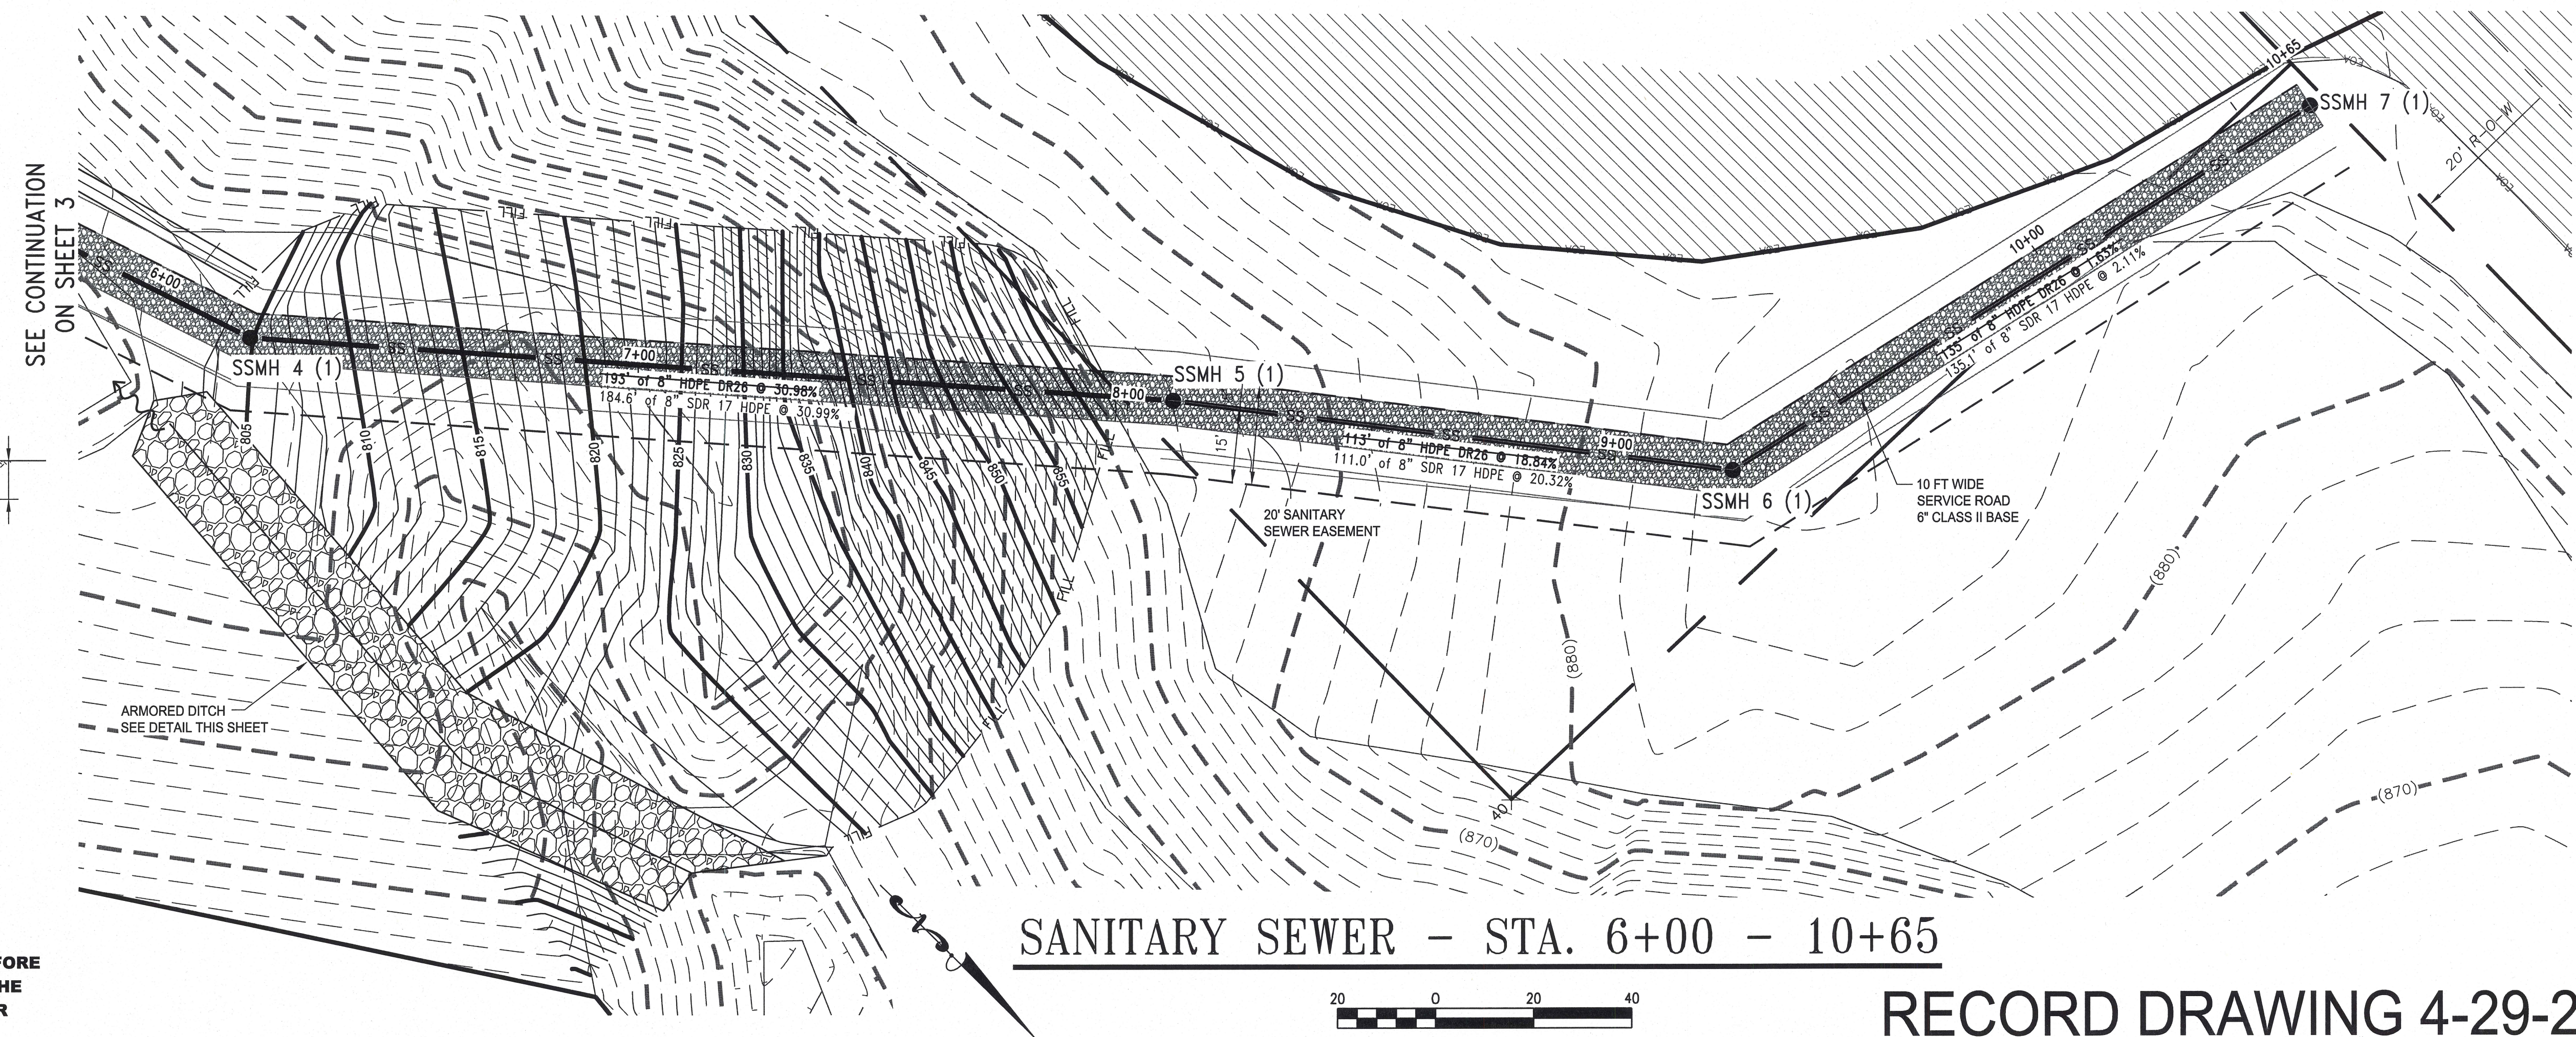


ARMORED V-DITCH
NTS

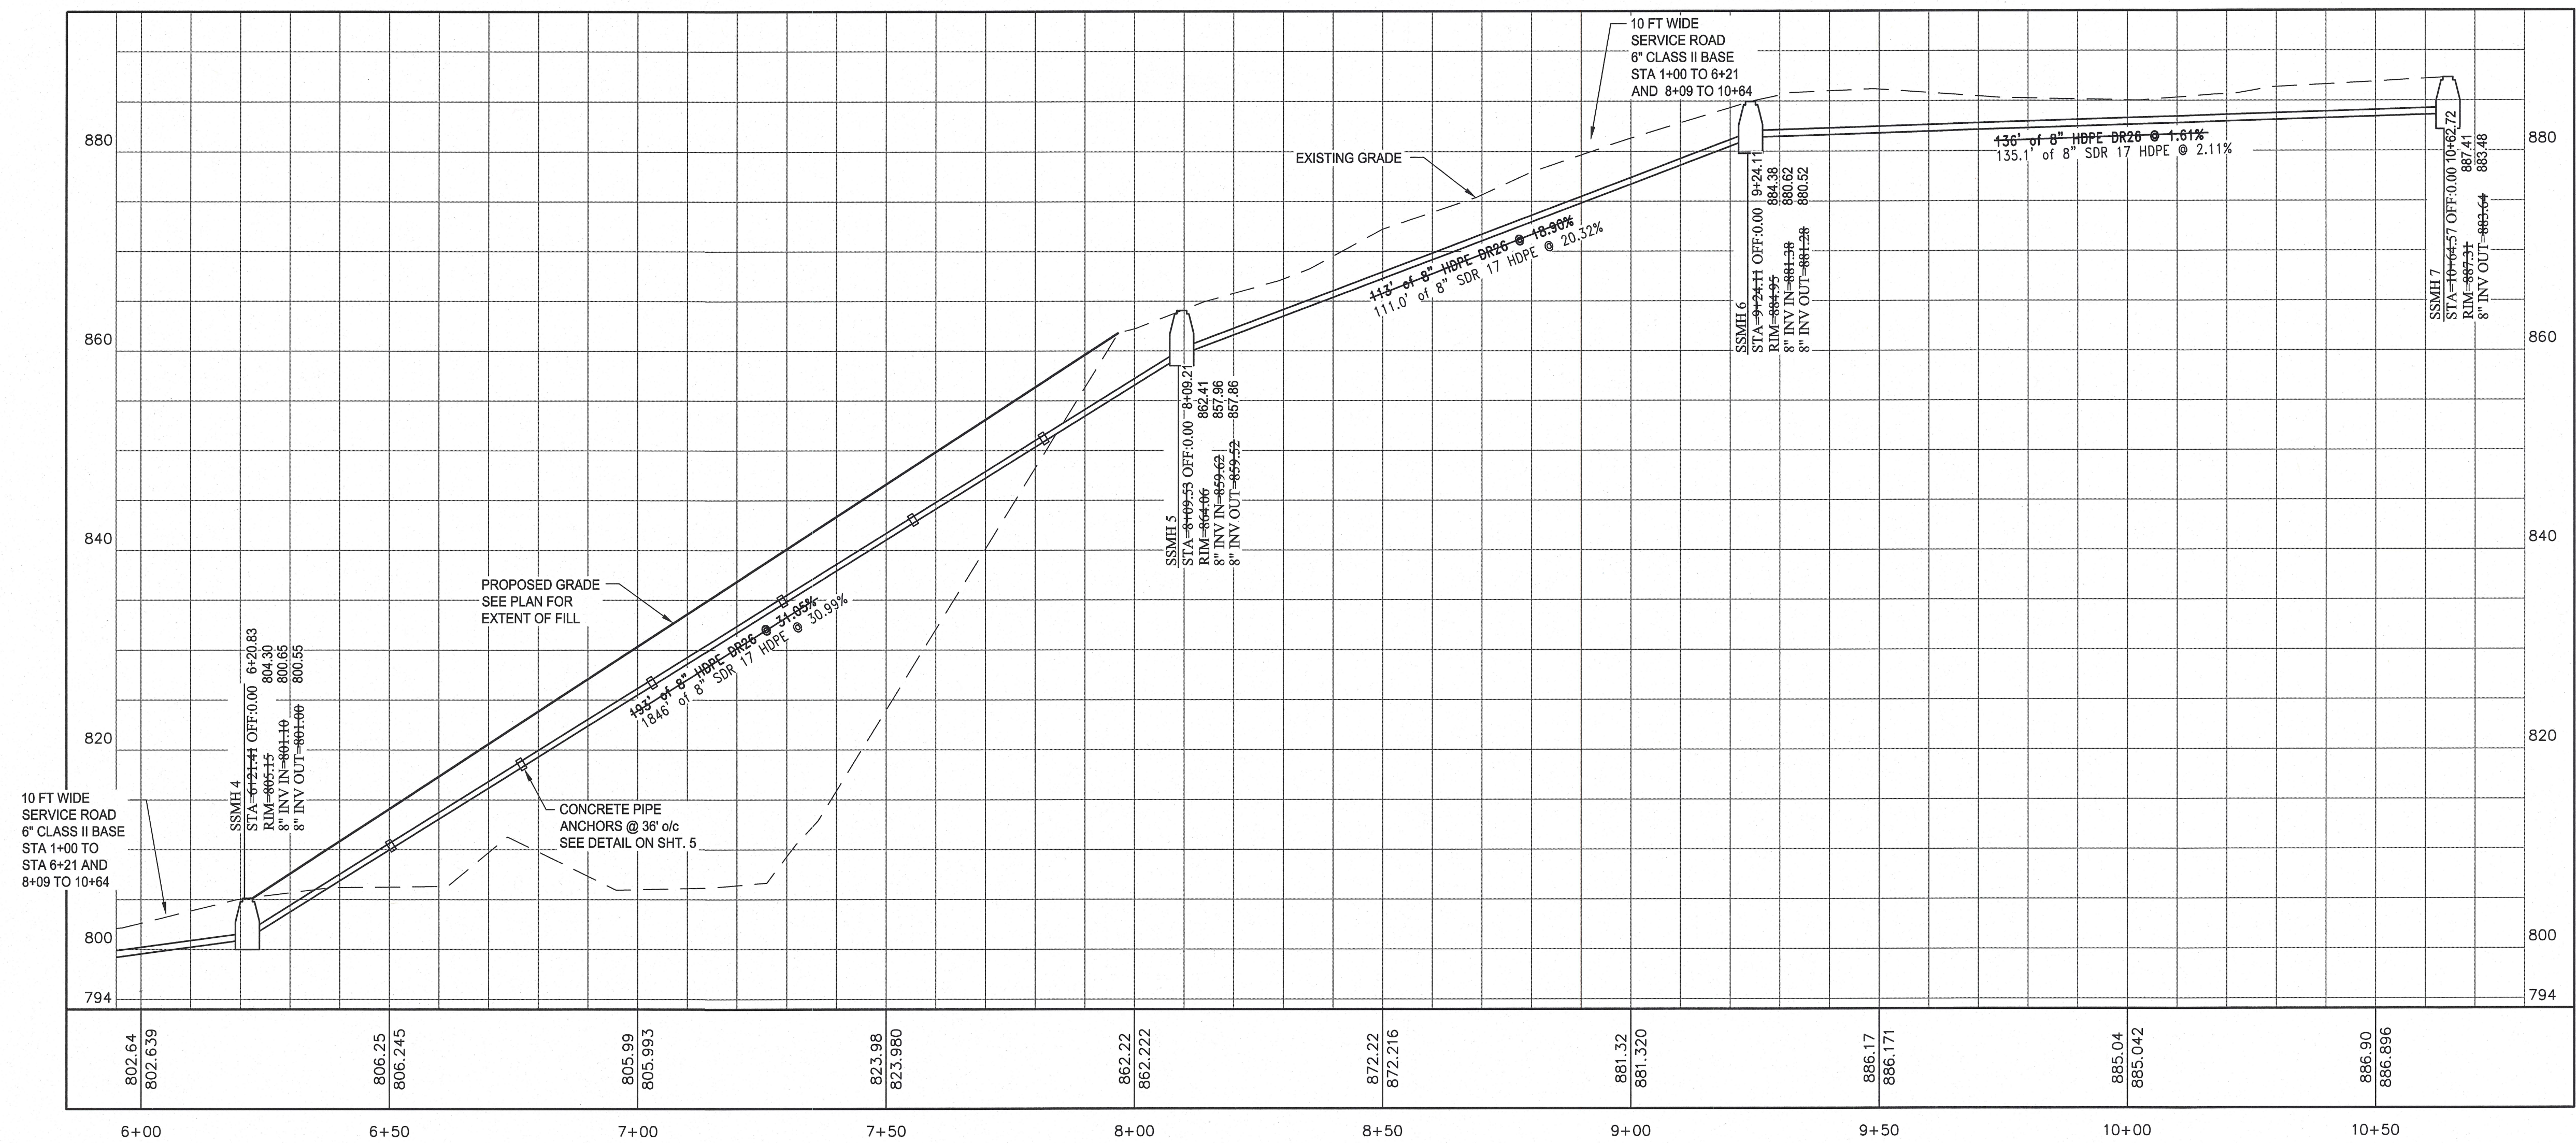

CALL 2 BUSINESS DAYS IN ADVANCE BEFORE YOU DIG, GRADE, OR EXCAVATE FOR THE MARKING OF UNDERGROUND MEMBER UTILITIES

SANITARY SEWER - STA. 6+00 - 10+65

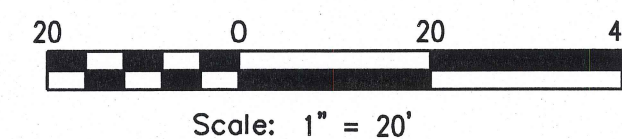

RECORD DRAWING 4-29-2015

No.	DATE	BY	DESCRIPTION

SANITARY SEWER STA. 6+00 - 10+65
HARRY WALL SEWER MAIN EXTENSION
PORT OF LEWISTON, 1626 6TH AVE. N
LEWISTON, ID 83501

KELTIC ENGINEERING, INC.
315 Adams Lane • Lewiston, Idaho 83501 • (208) 743-2135 • (208) 743-2136 fax
9423 North Nevada Street, Ste 204 • Spokane, WA 99218 • (509) 464-3000 • (509) 464-3005 fax
• Development • Planning • Design • Construction Management

DRAWN BY: JDM	CHECKED BY: EFH
DESIGNED BY: EFH	DATE: 12/22/14
LAST REV.: 04-29-15 (FML)	PROJECT NO.: 14-1302
SHEET NO.: 4	OF 5