

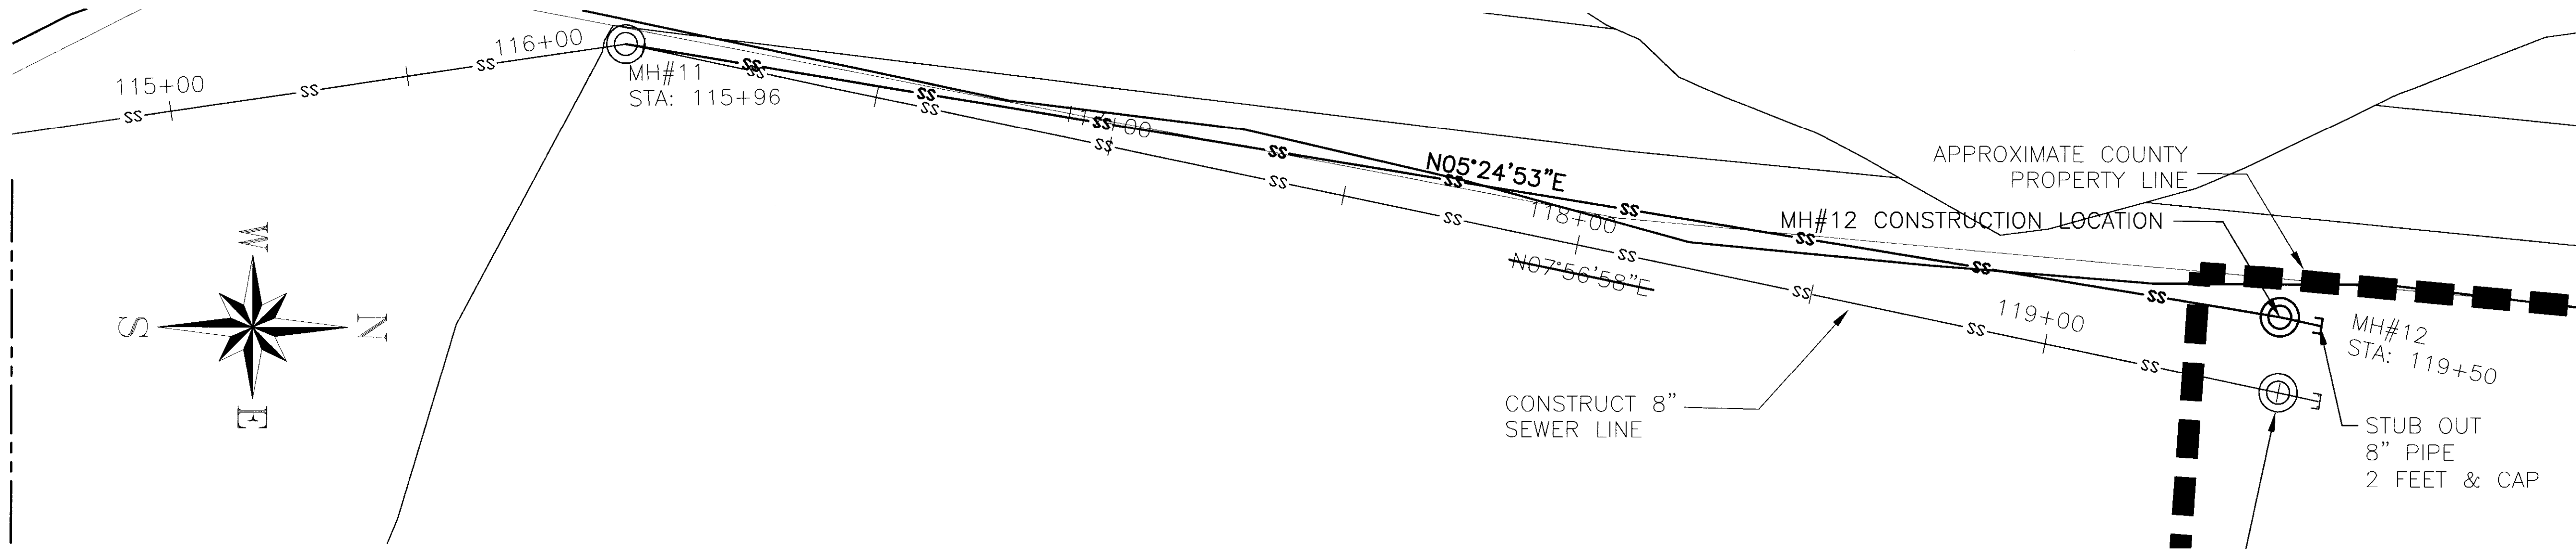



MATCH LINE - SEE SHEET 12

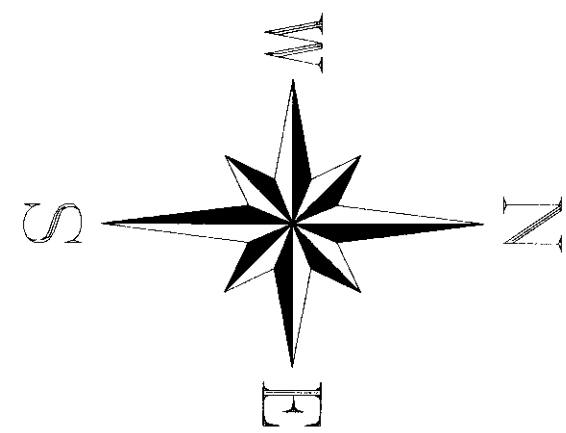

PLAN
SCALE: 1" = 40'

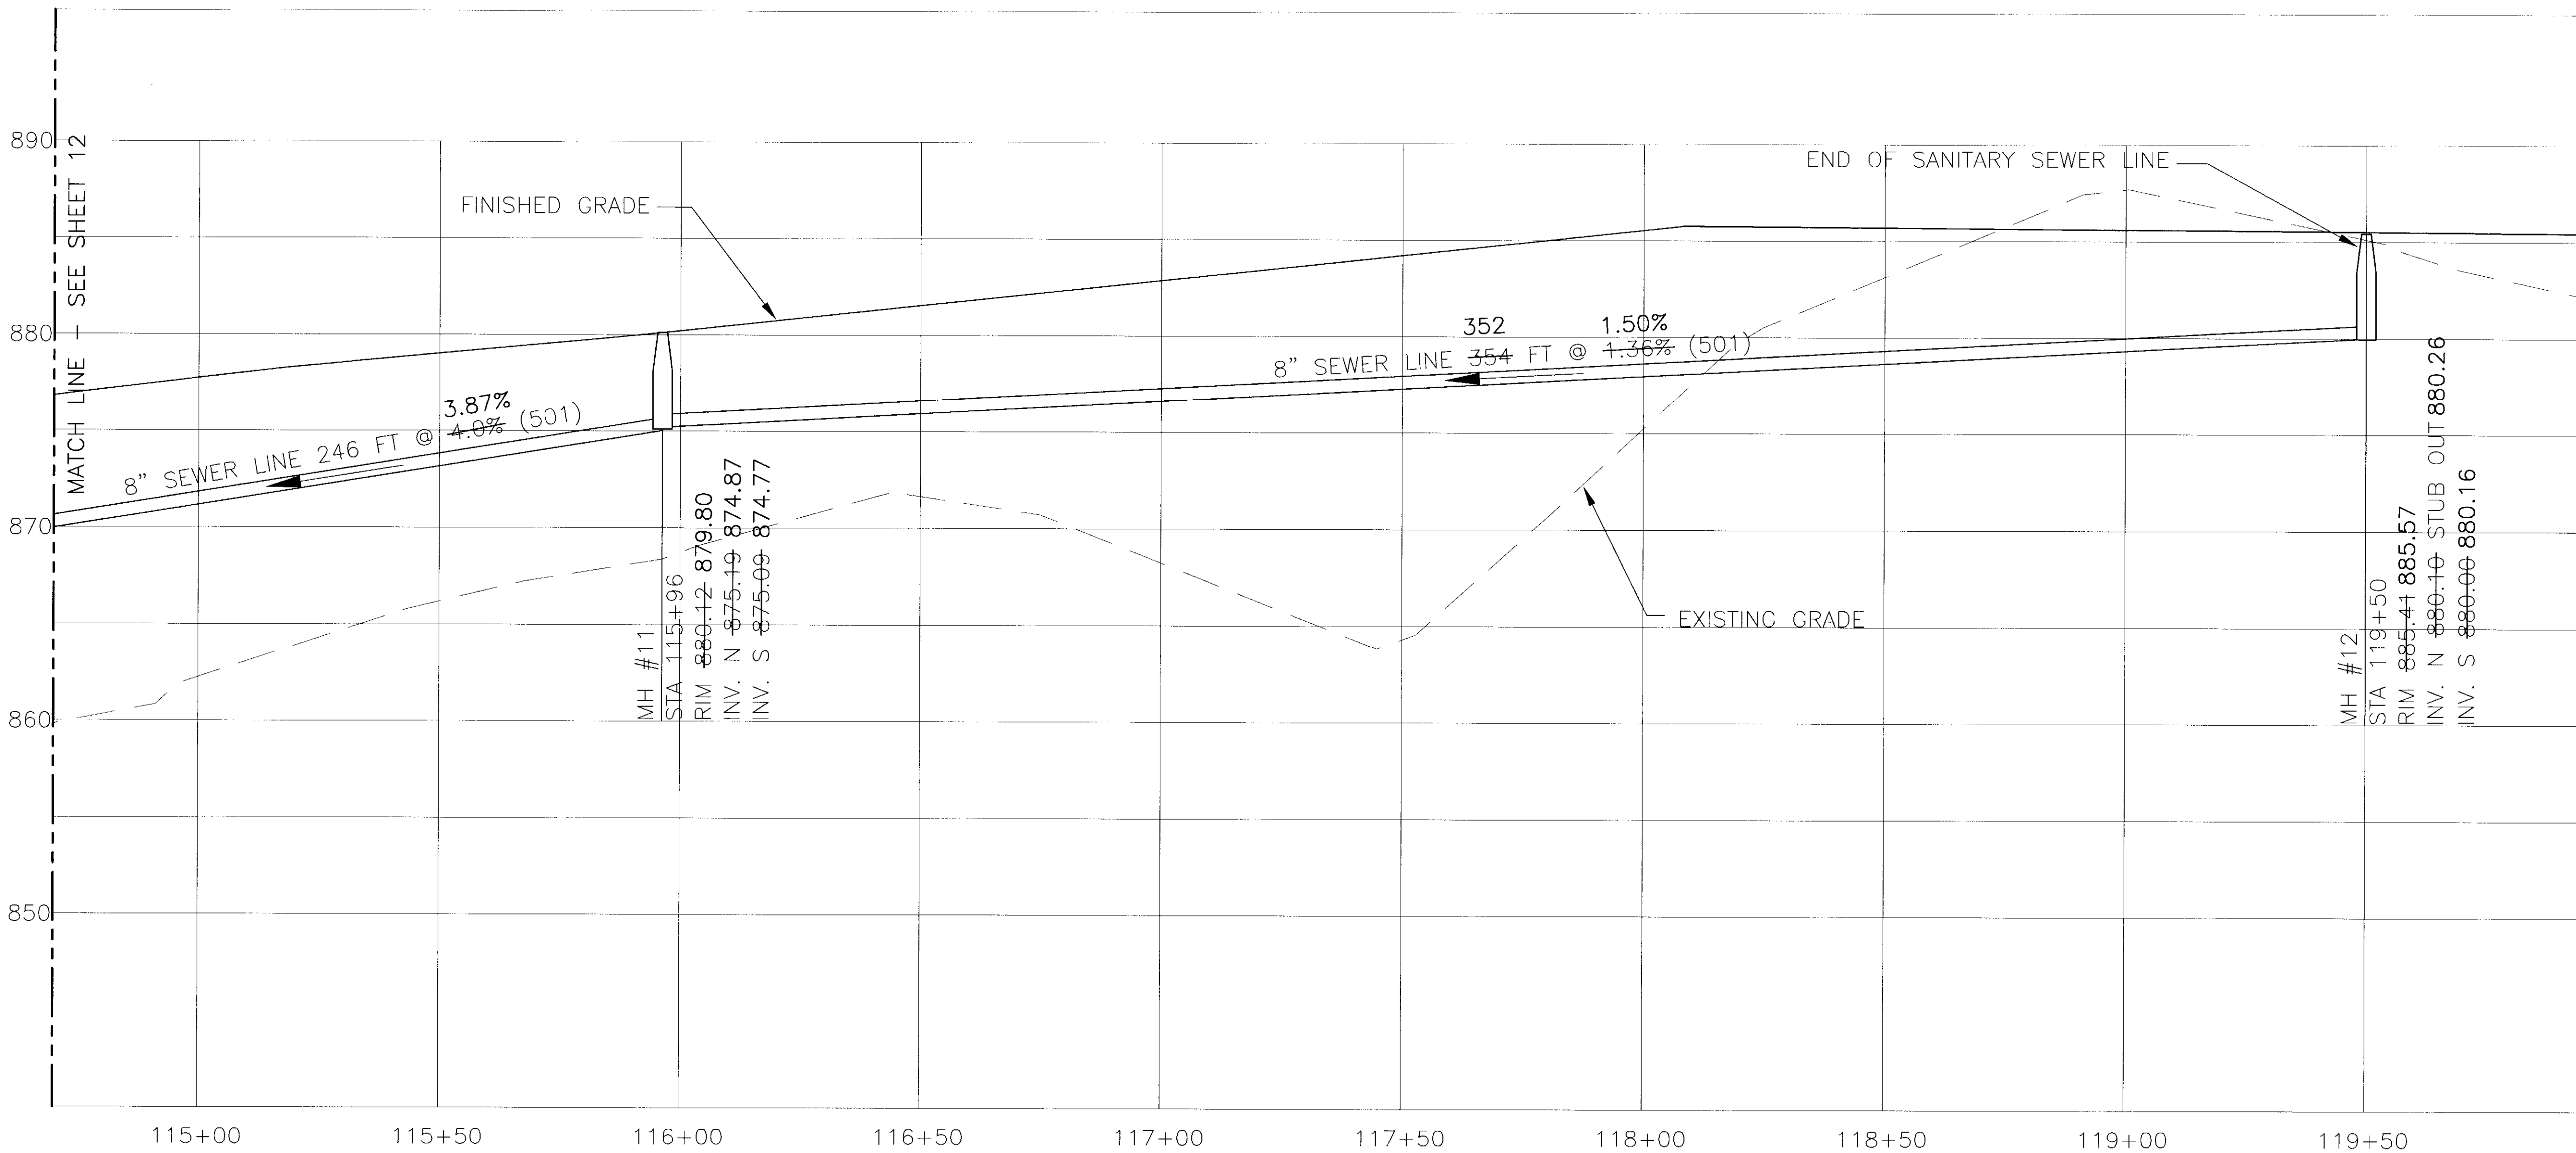

PROFILE
HORIZONTAL SCALE: 1" = 40'
VERTICAL SCALE: 1" = 10'

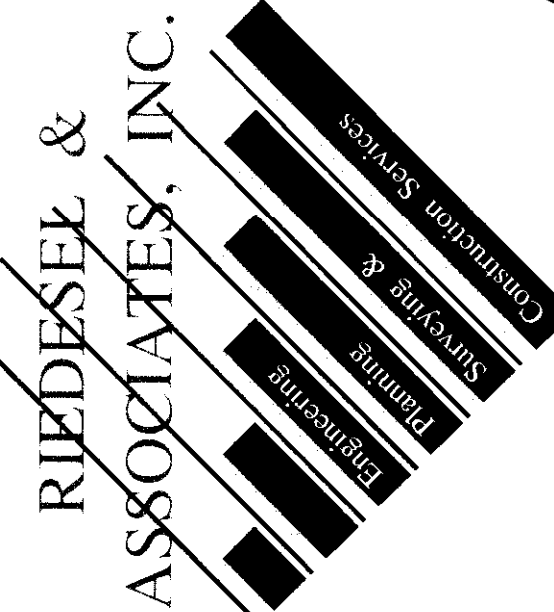

RIEDEL & ASSOCIATES, INC.

77 Southway, Suite C
Lewiston, Id. 83501
Phone: (208) 743-3818
Fax: (208) 743-3819

THIS DOCUMENT, AND THE IDEAS AND DESIGNS INCORPORATED HEREIN, AS AN INSTRUMENT OF PROFESSIONAL SERVICES, IS THE PROPERTY OF RIEDEL & ASSOCIATES, INC. AND IS NOT TO BE USED, IN WHOLE OR IN PART, FOR ANY OTHER PROJECT, OR THE EXTENSION OF THIS PROJECT, WITHOUT THE WRITTEN AUTHORIZATION OF RIEDEL & ASSOCIATES, INC.

PORT OF LEWISTON
HARRY WALL INDUSTRIAL PARK
LEWISTON, IDAHO

SANITARY SEWER PLAN & PROFILE

REVISIONS					
		NO.	DATE	BY	DESCRIPTION
		1	10/31/06	MKA	BID SET
		2	12/22/06	MKA	RELOCATE BUILDING SITE
		3	05/14/07	JPM	RECORD DRAWING
		4			
		5			
		6			
		7			
		8			

Original 11"x17" size plans
Stamped by: M. Kent Atkin
License Number: 10957
Date: 10/31/06
06/19/07