



No.	DATE	BY	DESCRIPTION
1	5-16-07	ECD	CITY OF LEWISTON REVIEW COMMENTS
2	5-16-07	ECD	PORT OF LEWISTON REVIEW COMMENTS

WALL STREET
NEZ PERCE COUNTY DETENTION FACILITY/SHERIFF'S OFFICE
1150 WALL STREET
LEWISTON, ID 83501

KELTIC ENGINEERING, INC.
315 Adams Lane • Lewiston, Idaho 83501 • (208) 743-2135 • (208) 743-2136 fax
1621 N Third Street, Ste 500 • Coeur d'Alene, Idaho 83814 • (208) 664-4836 • (208) 664-4897 fax
• Development • Planning • Design • Construction Management

DRAWN BY: ECD	CHECKED BY: EFT
DESIGNED BY: KMK	
DATE: 10/19/06	
LAST REV: 05/18/07	
PROJECT NO: 06-083	
SHEET NO: C8 OF C11	

RECORD DRAWING 10/17/08

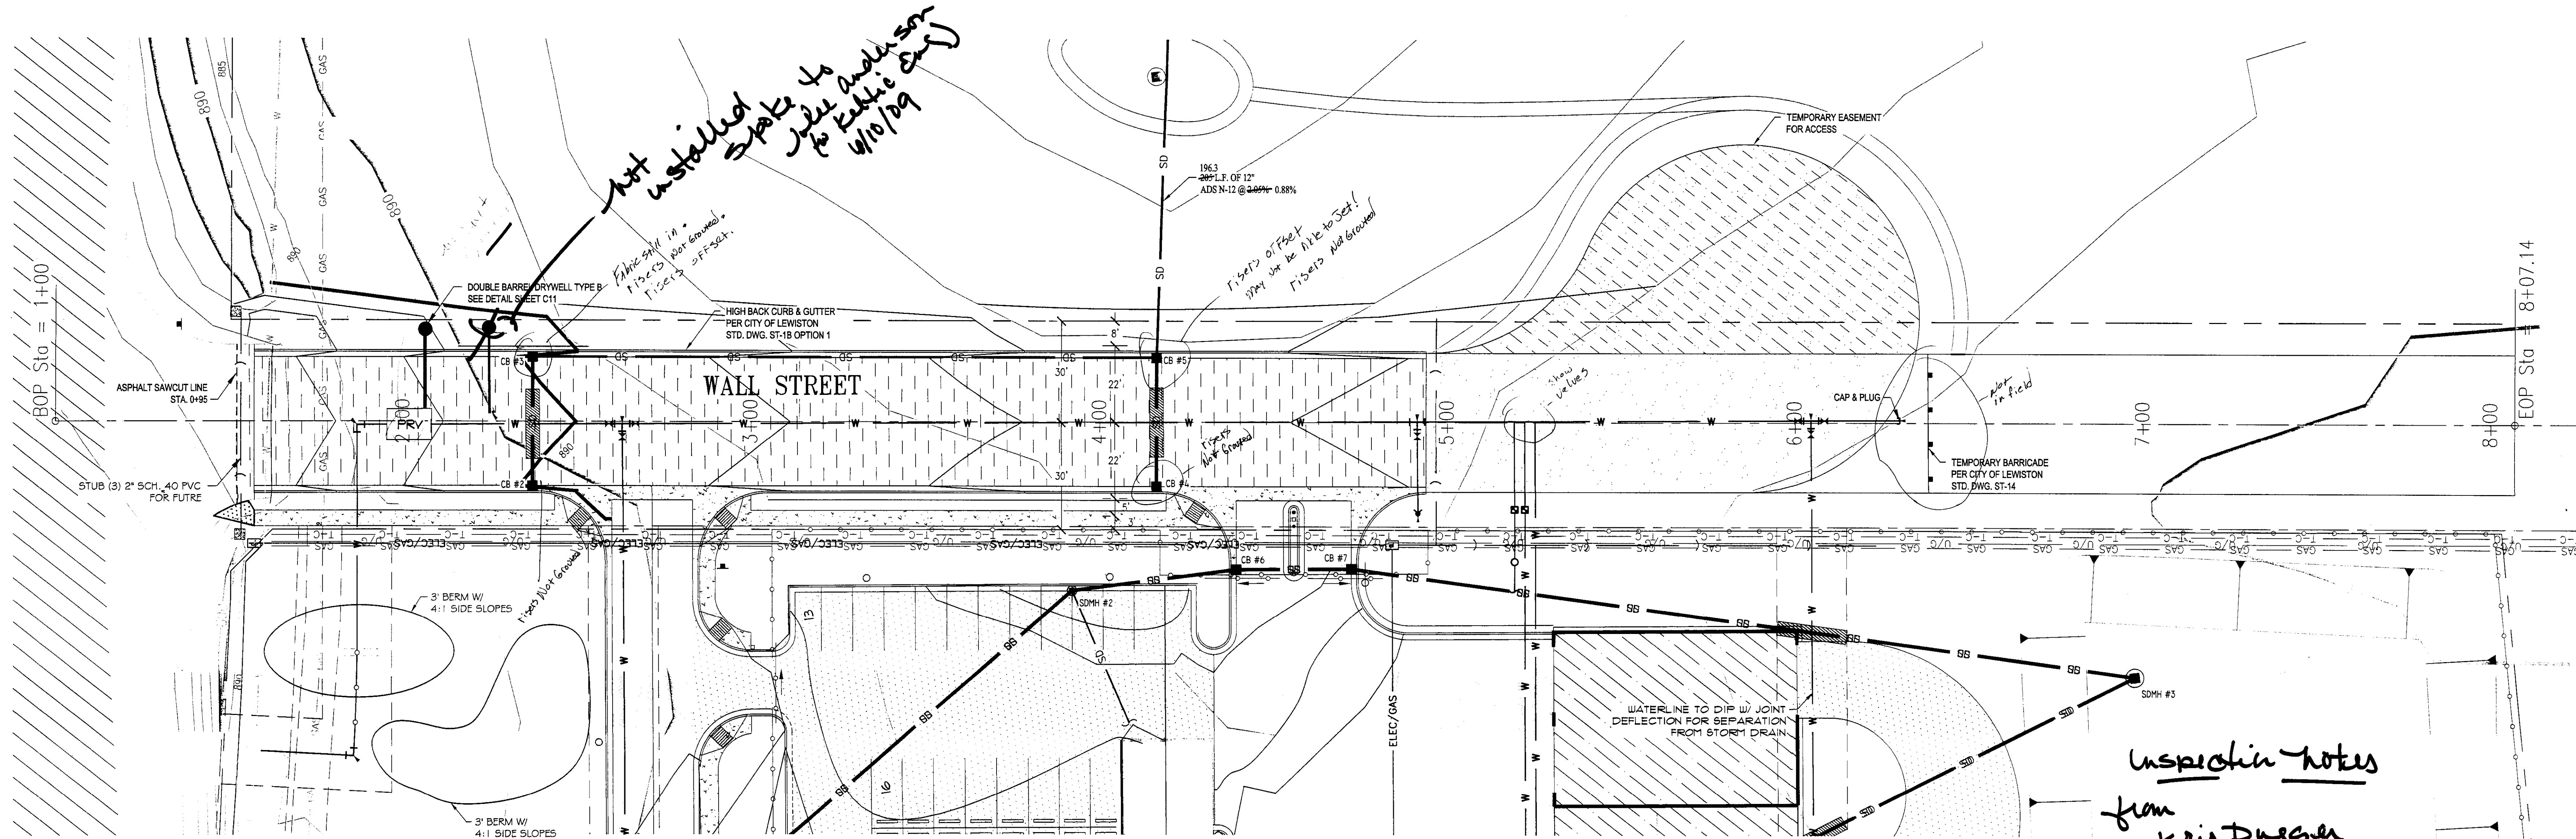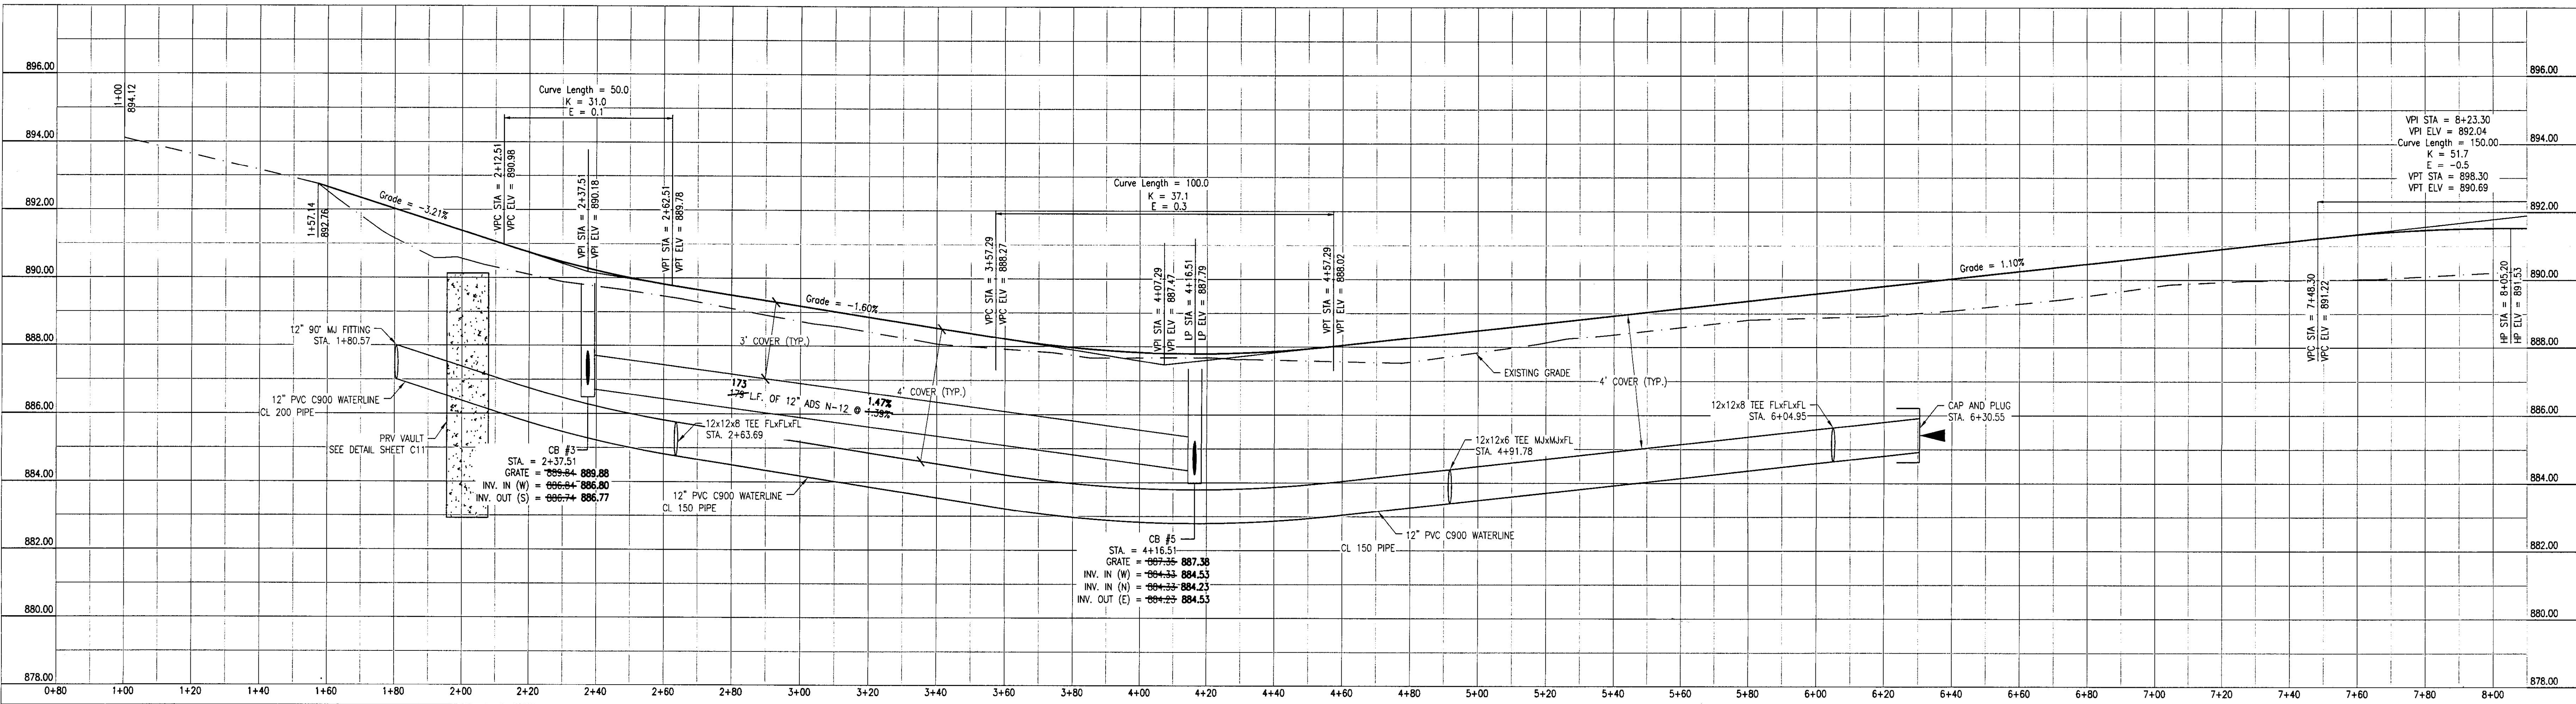

WALL STREET
Scale: 1" = 20'