






M:\Standards\2010-Standards\2-Concrete\General_Notes_Concrete.dwg

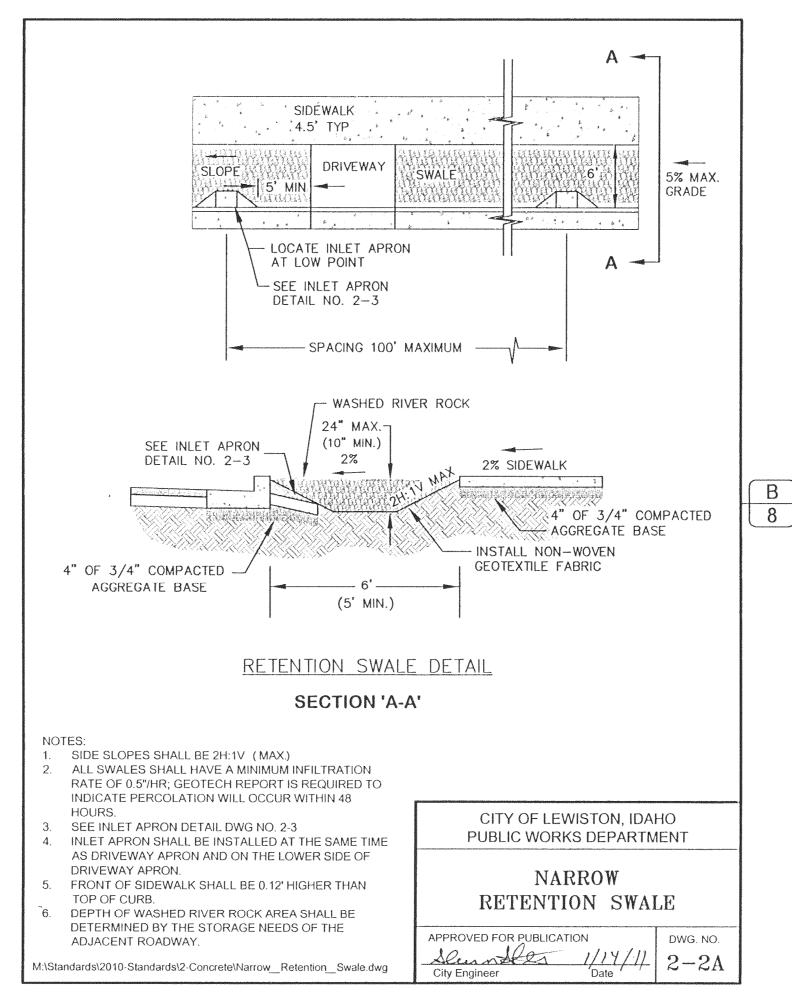

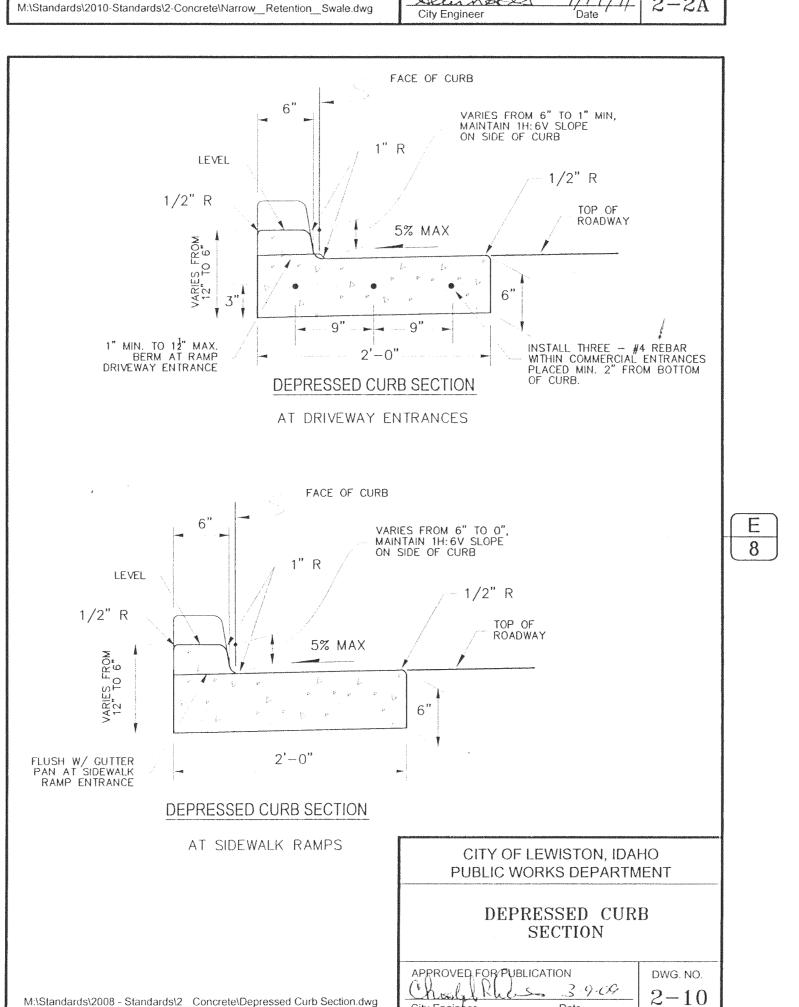

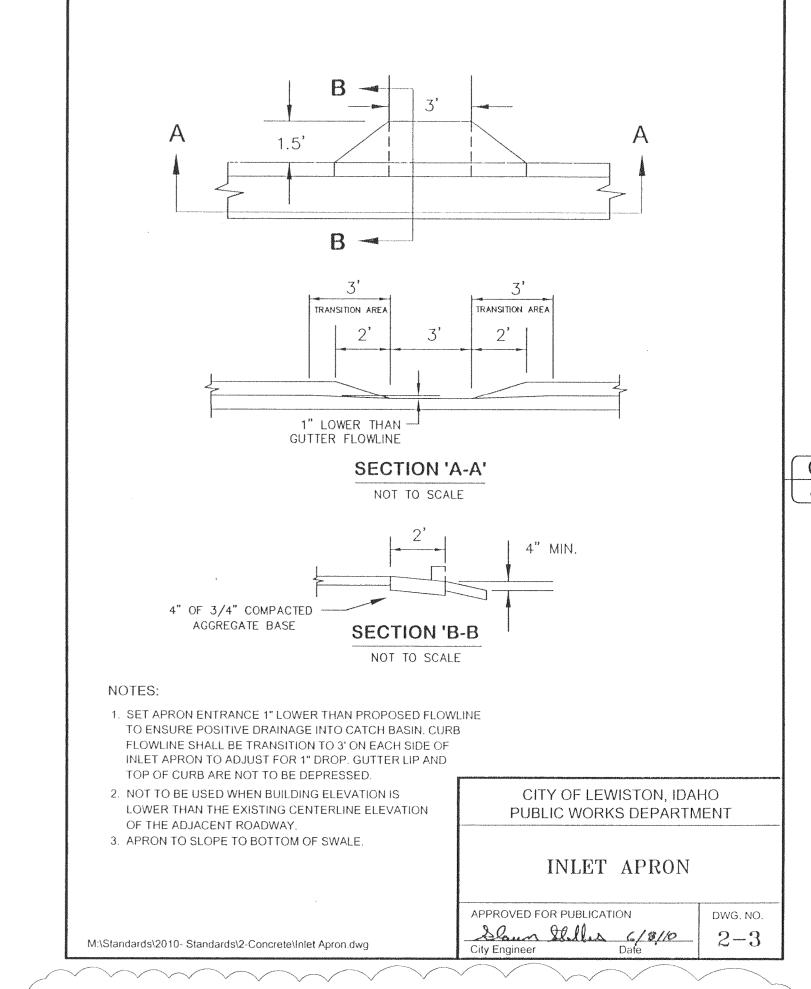

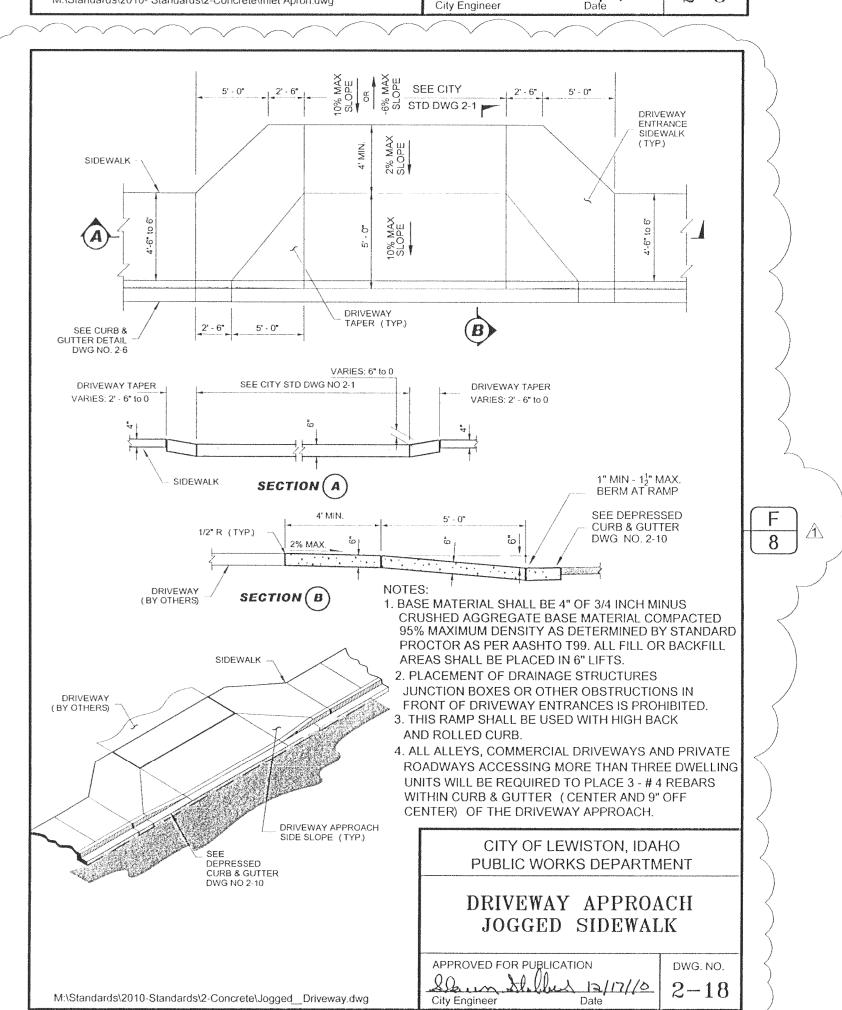

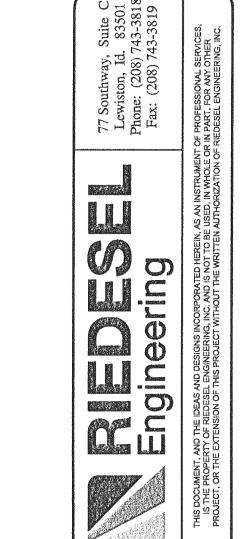

> PAR INDUSTRA RE EXTENSION 2013

ALL HARR' INFRA

DESIGNED BJW DESIGN CHECKED JRW/JPM DETAILED BJW DRAWING CHECKED JRW/JPM FILE NAME 2060-DETAILS .dwg

DRAWING DATE 1/4/13 DRAWING SCALE

AS SHOWN SHEET 8 OF 10