




City Engineer


Date


M:\Standards\2010-Standards\4-Water\Fire Hydrant.dwg

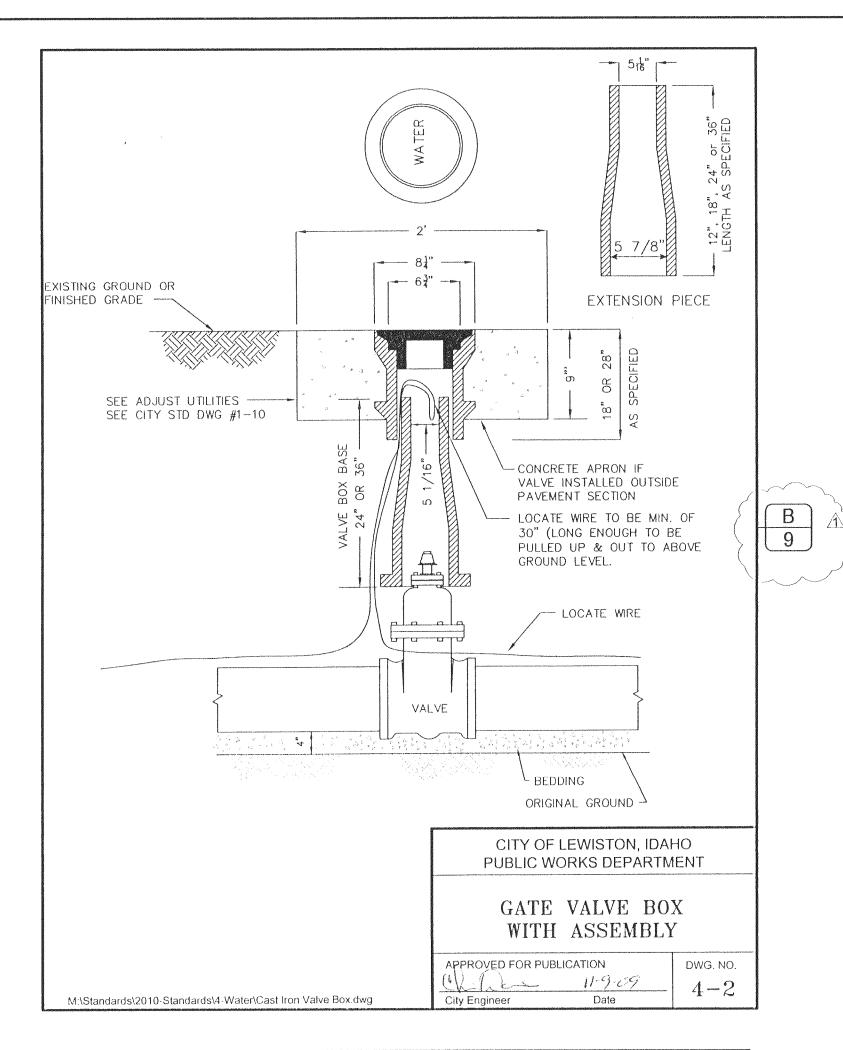

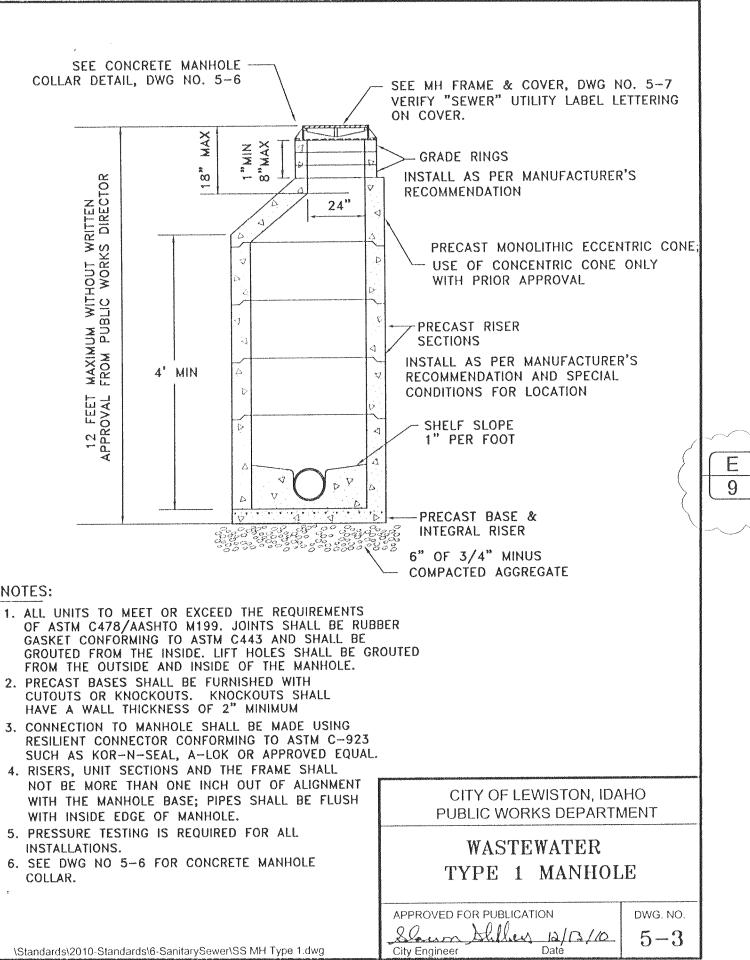

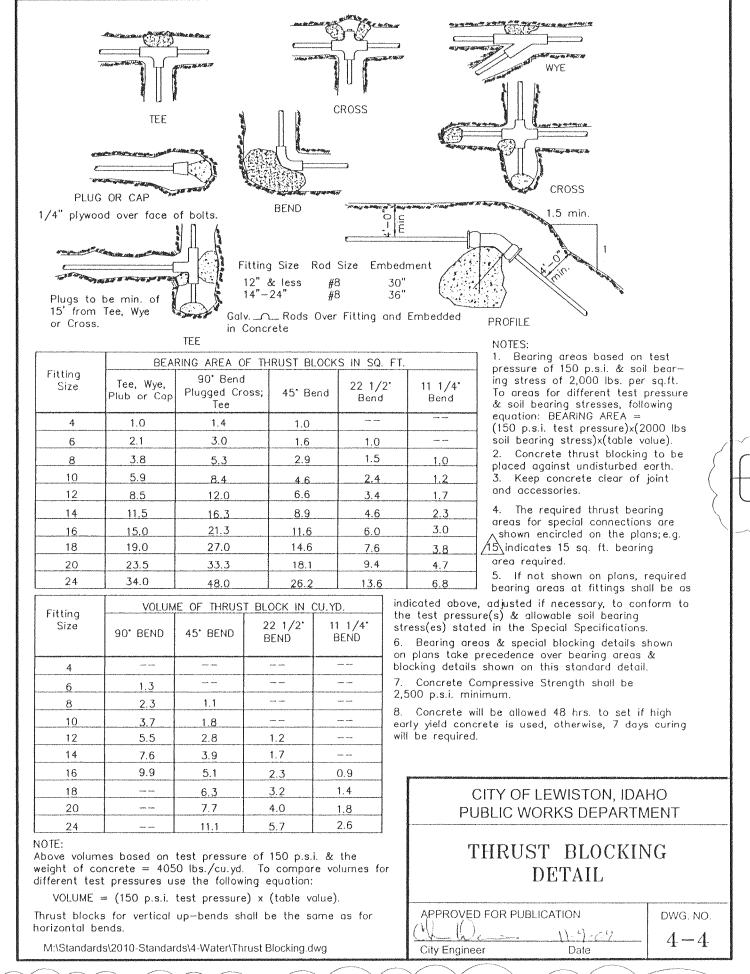

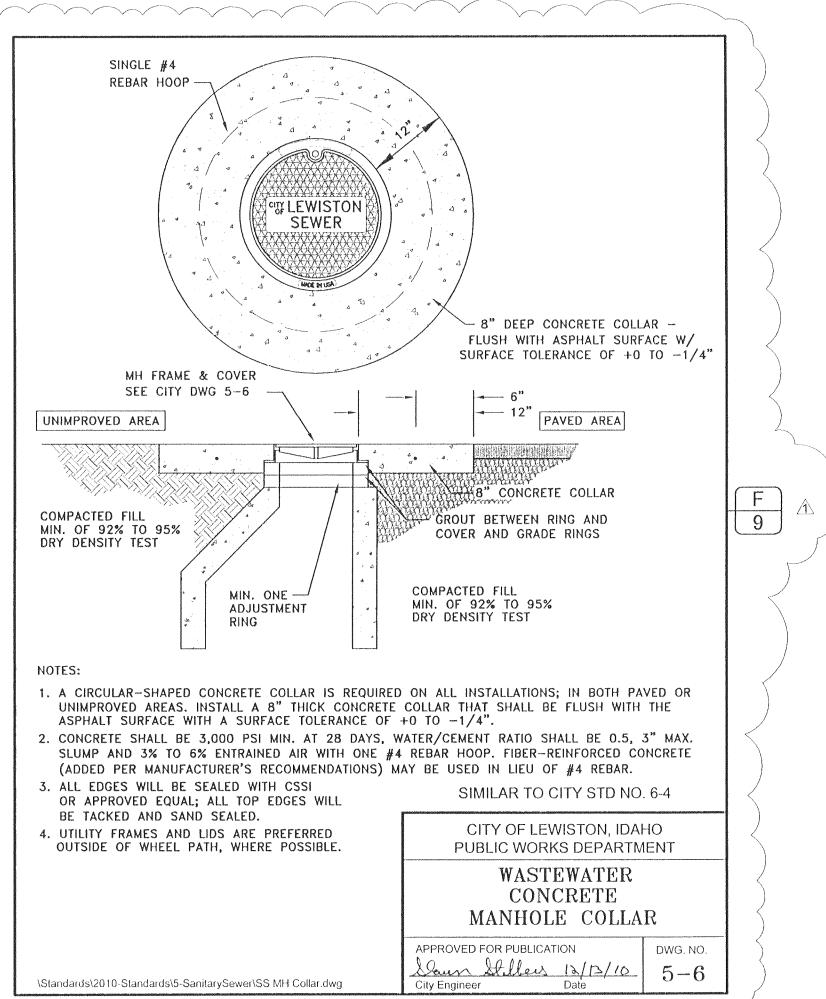

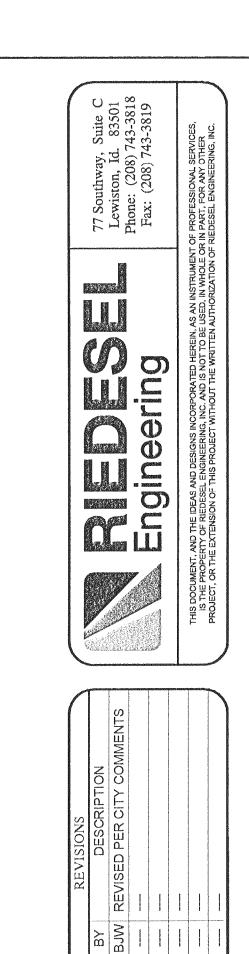

IAL PARI

VALL INDUSTRI UCTURE EXTENSION 2013

ARR

MILPME

DESIGNED

JRW/JPM

DETAILED

JRW/JPM

1/4/13

FILE NAME

AS SHOWN

DESIGN CHECKED

DRAWING CHECKED

2060-DETAILS .dwg

DRAWING DATE

DRAWING SCALE

SHEET 9 OF 10

13055